

State of Wisconsin
County of FOREST

} ss. ESTABLISHMENT OF QUARTER - QUARTER SECTION CORNER BETWEEN ORIGINAL GOVERNMENT SURVEY CORNERS.

I NEAL SPERHAKE, do hereby certify that on the THIRTIETH day of OCTOBER, 1963, I established the WEST ONE SIXTEENTH CORNER BETWEEN SECTIONS 1 AND 12, TOWNSHIP 34 NORTH, RANGE 13 EAST, Fourth Principal Meridian, as described hereon.

History: There is no record of this corner having ever been previously established.

Description of monument and accessories I established to perpetuate the location of this corner:


At the point determined for the location of the corner I emplaced a:

GALVANIZED IRON PIPE, THREE FEET LONG, ONE INCH IN DIAMETER, WITH AN ALUMINUM CAP DENOTED AS, "KIMBERLY-CLARK CORP. T34N W 1/16 BTWN. 1 & 12 R13E SPERHAKE RLS 463 10/30/63."

The pipe is witnessed by:

- Maple 10 N 17°E 50 links. (SCRIBED S 1 BT).
- Aspen 11 S 7°E 36½ links. (SCRIBED S12 BT).

Description as to how corner was located: The section corner ¼ mile west and the quarter corner ¼ mile east have been previously established with a distance of 39.35 chains between them. Thus, set the west one sixteenth corner 19.67½ chains from either corner and on a straight line between them.

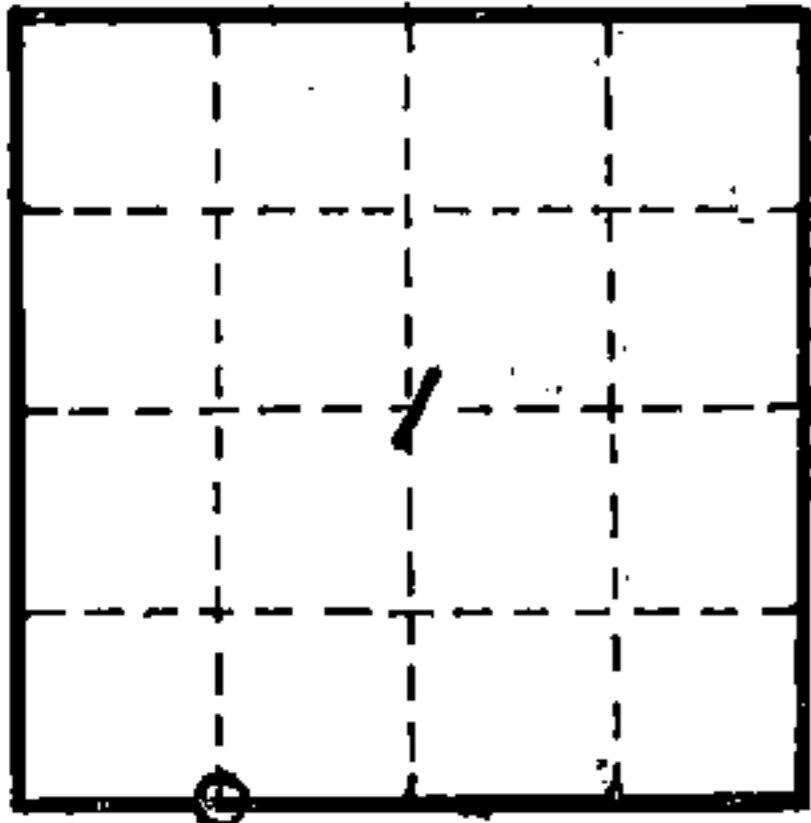

O = Corner monument restored

Subscribed & sworn to before me this 25 day of August 1964

Anna Peterson
Notary Public, Forest Co., Wis
Com. expires 10/31/65

88943

Resident witnesses _____

Dated at Grandon, Wisconsin, this 25 day of Aug, 1964.

Signature Neal Sperhake

Title Registered Land Surveyor Registration No. 463

Office of Reg. of Deeds County of Forest

I hereby certify that the within instrument was filed in this office for record, on the 25 day of August 1964, and was filed in Book No. _____ Page No. _____ of County Records.

Surveyor's Seal

Signature Anna Peterson Title Reg. of Deeds

43413010030

Index No. E-22
22