

State of Wisconsin
County of FOREST

ss. ESTABLISHMENT OF QUARTER - QUARTER SECTION CORNERS BETWEEN ORIGINAL GOVERNMENT SURVEY CORNERS.

I NEAL SPERHAKE, do hereby certify that on the SEVENTEENTH day of SEPTEMBER, 1964, I established the WEST ONE SIXTEENTH CORNER BETWEEN SECTIONS 2 AND 11, TOWNSHIP 34 NORTH, RANGE 13 EAST, Fourth Principal Meridian, as described hereon.

History: There is no record of this corner having ever been previously established.

Description of monument and accessories I established to perpetuate the location of this corner:


At the point determined for the location of the corner I emplaced a:

GALVANIZED IRON PIPE, THREE FEET LONG, ONE INCH IN DIAMETER, WITH ALUMINUM CAP DENOTED AS, "KIMBERLY CLARK CORP. T34N W 1/16 BTWN. 2 & 11 R13E SPERHAKE RLS 463 9/17/64."

The pipe is witnessed by:

- W. Pine 10 N 87°W 27 links. (SCRIBED S 2 BT).
- W. Birch 5 S 39°E 17 links. (SCRIBED S11 BT).


Description as to how corner was located: Since both the quarter section corner 1/4 mile east and the section corner 1/4 mile west have been previously established with a distance between them of 39.74 chains, the W 1/16 corner was set 19.87 chains from either corner and on a straight line between them.

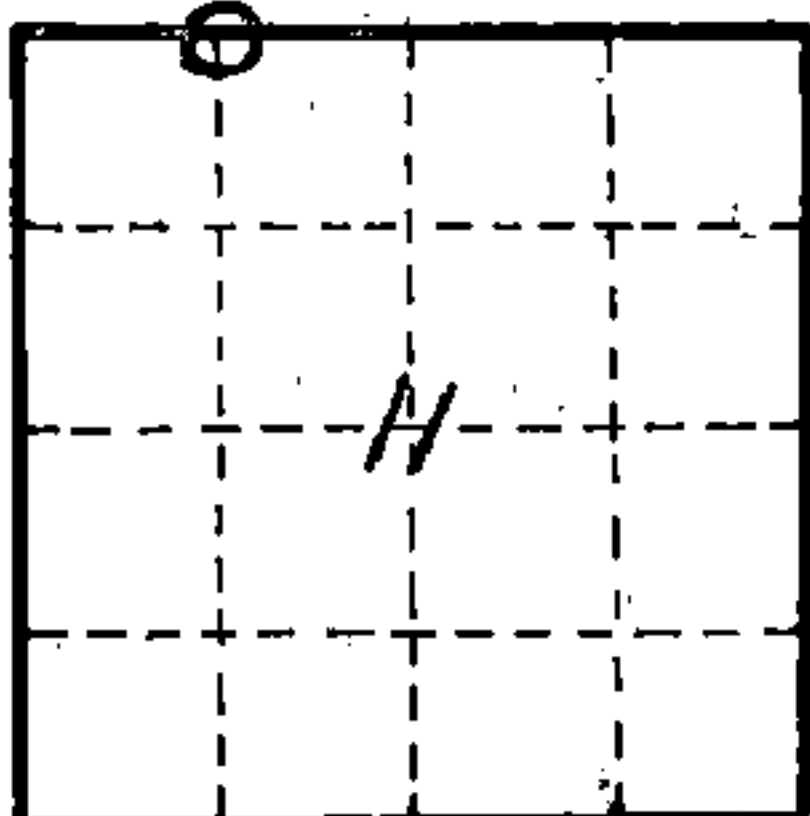

O = Corner monument restored

89569

REGISTERER'S OFFICE
FOREST COUNTY, WIS.

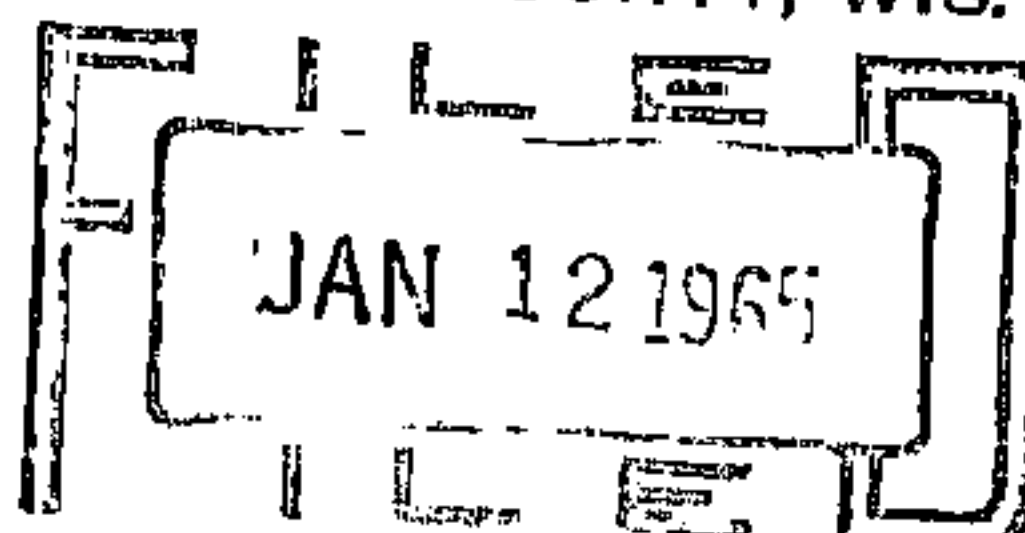

At 10 o'clock A.M.
Anna Peterson, Register of Deeds

Resident witnesses _____

Dated at Crandon, Wisconsin, this 12 day of January, 1965.

Signature Neal Sperhake

Title Registered Land Surveyor Registration No. 463

~~COPIES OF~~ ~~Copies of~~ signed & sworn to, I hereby certify that the within instrument was filed on the 12 day of Jan. 1965, and was filed in Book No. _____ Page No. _____ of County Records.

Surveyor's Seal

Signature Anna Peterson Title Notary Public

43413020030

Index No. E-18