

State of Wisconsin
County of FOREST

} ss. ESTABLISHMENT OF QUARTER - QUARTER SECTION CORNER BETWEEN ORIGINAL GOVERNMENT SURVEY CORNERS.

I NEAL SPERHAKE, do hereby certify that on the THIRTY-FIRST day of OCTOBER, 1963, I established the SOUTH ONE SIXTEENTH CORNER BETWEEN SECTIONS 1 AND 2, TOWNSHIP 34 NORTH, RANGE 13 EAST, Fourth Principal Meridian, as described hereon.

History: There is no record of this corner having ever been previously established.


Description of monument and accessories I established to perpetuate the location of this corner:

At the point determined for the location of the corner I emplaced a:
GALVANIZED IRON PIPE, THREE FEET LONG, ONE INCH IN DIAMETER, WITH AN ALUMINUM CAP DENOTED AS, "KIMBERLY-CLARK CORP. T34N S 1/16 BTWN. 1 & 2 R13E WC Corner is 20 Feet South WC."

The pipe is witnessed by:

- Aspen 6 N 54°W 33½ links. (SCRIBED S 2 WC BT).
- Maple 16 N 70°E 76 links. (SCRIBED S 1 WC BT).

Description as to how corner was located: The section corner ¼ mile south and the quarter corner ¼ mile north have been previously established with a distance of 39.97 chains between them. Thus, set the south one sixteenth corner 19.98½ chains from either corner and on a straight line between them.

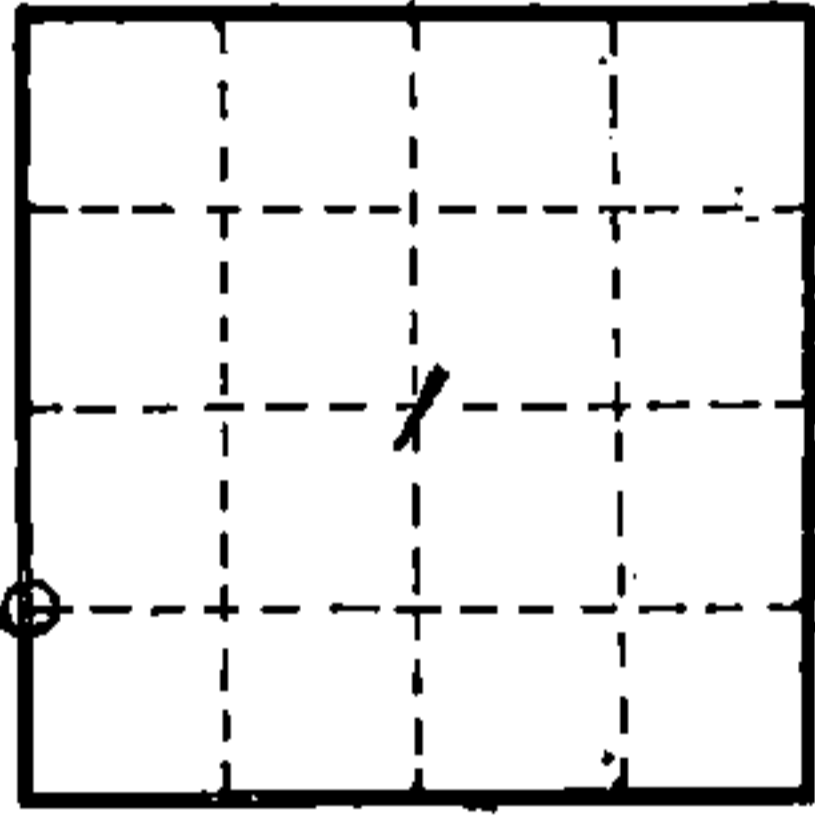

O = Corner monument restored

Subscribed & sworn to before me this 25 day of August 1964

Anna Peterson
Notary Public, Forest Co., Wis
Com. expires 10/31/65

Resident witnesses _____

Dated at Crandon, Wisconsin, this 25 day of August, 1964.

Signature Neal Sperhake

Title Registered Land Surveyor Registration No. 463

Office of Register of Deeds County of Forest

I hereby certify that the within instrument was filed in this office for record on the 25 day of August 1964, and was filed in Book No. _____ Page No. _____ of County Records.

Surveyor's Seal

Signature Anna Peterson Title Register of Deeds

4341302 1000

88940

Index No.

D-21
D-21