


State of Wisconsin }
County of FOREST } ss. ESTABLISHMENT OF QUARTER - QUARTER SECTION CORNER BETWEEN
ORIGINAL GOVERNMENT SURVEY CORNERS.

I NEAL SPERHAKE, do hereby certify that on the FOURTEENTH day of NOVEMBER, 19 63, I established the EAST ONE SIXTEENTH CORNER BETWEEN SECTIONS 3 AND 10, TOWNSHIP 34 NORTH, RANGE 13 EAST, Fourth Principal Meridian, as described hereon.

History: There is no record of this corner having ever been previously established.

Description of monument and accessories I established to perpetuate the location of this corner:
At the point determined for the location of the corner I emplaced a:
GALVANIZED IRON PIPE, THREE FEET LONG, ONE INCH IN DIAMETER, WITH ALUMINUM CAP DENOTED AS,
"KIMBERLY CLARK CORP. T34N E 1/16 BTWN. 3 & 10 R13E SPERHAKE RLS 463 11/14/63."
The pipe is witnessed by:
Oak 6 N 66°E 26 links. (SCRIBED S 3 BT).
W. Birch 5 S 10°W 07 links. (SCRIBED S10 BT).

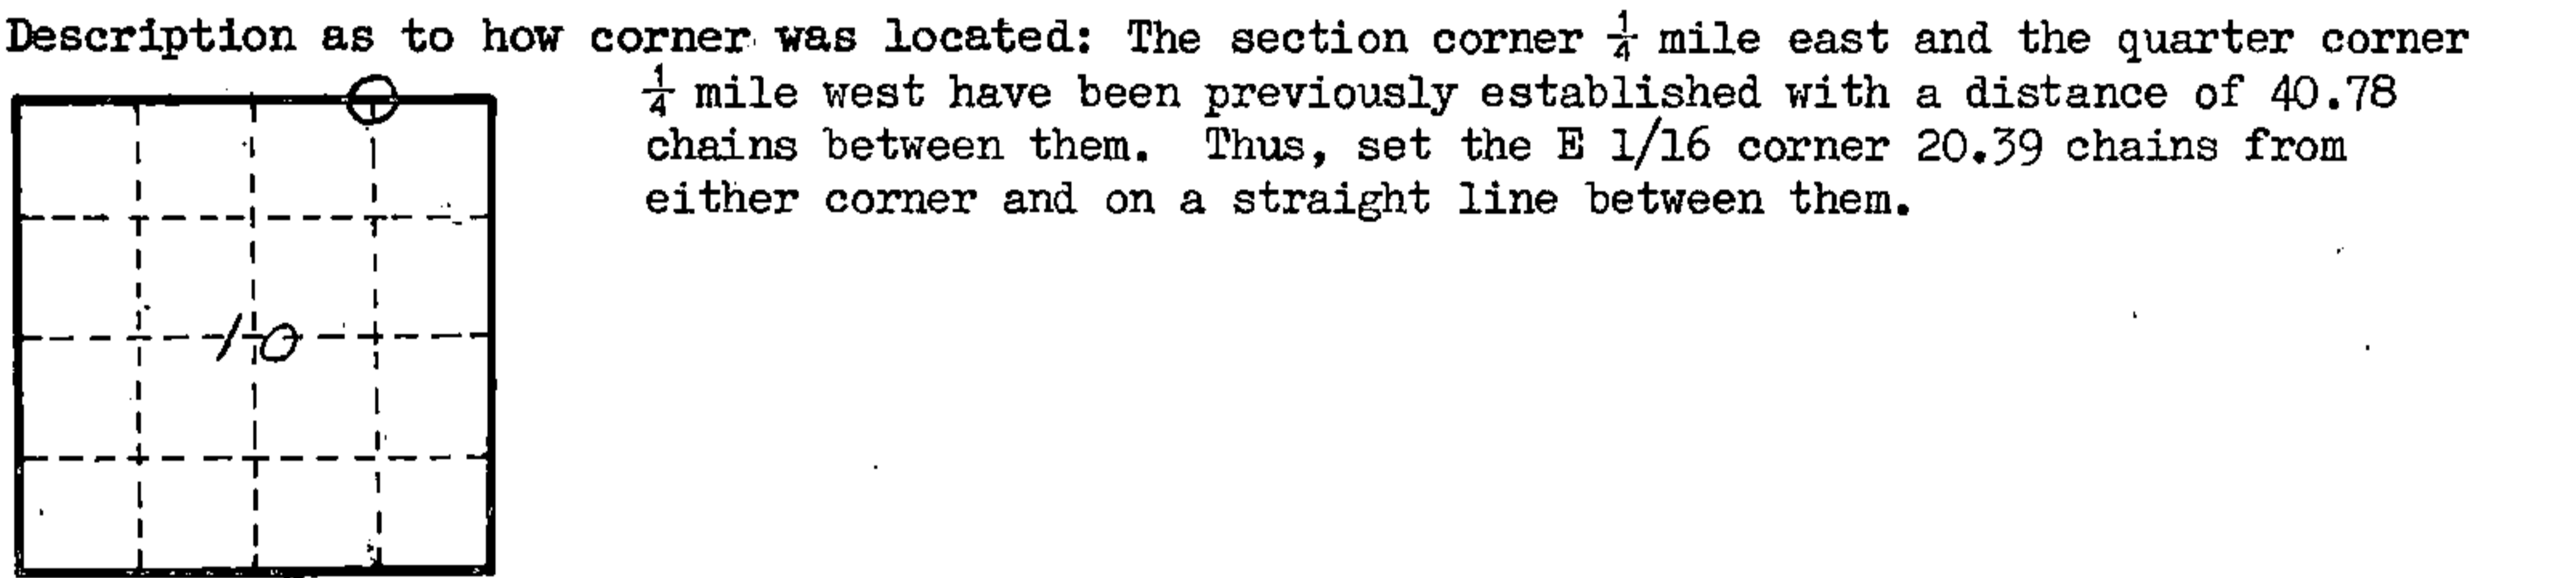

0 = Corner monument restored

Subscribed & sworn to before me this 25 day of August 1964

Anna Peterson
NOTARY PUBLIC-FOREST CO., WIS
COM. EXPIRES 10/31/65

88954

Resident witnesses _____
Dated at Crandon, Wisconsin, this 25 day of Aug, 19 64.
Signature Neal Sperhake
Title Registered Land Surveyor Registration No. 463
Office of Reg. of Deeds County of Forest
I hereby certify that the within instrument was filed in this office for record on the 25 day of Aug 19 64, and was filed in Book No. _____ Page No. _____ of County Records.

Surveyor's Seal

Signature Anna Peterson Title Reg. of Deeds

43413030010

Index No.:

43413030010