

State of Wisconsin

County of FOREST

ss. RESTORATION OF LOST ORIGINAL GOVERNMENT SURVEY CORNER.

I NEAL SPERHAKE, do hereby certify that on the TWENTY-FOURTH day of OCTOBER, 19 63, I established the NORTHWEST SECTION CORNER OF SECTION 10, TOWNSHIP 34 NORTH, RANGE 13 EAST, Fourth Principal Meridian, as described hereon.

History: This corner was established during the original survey of this township, as noted in the original field notes for the original survey of T34N-R13E, 4th. p.m.

Description of monument and accessories I established to perpetuate the location of this corner:


At the point determined for the location of the corner I emplaced a:

GALVANIZED IRON PIPE, THREE FEET LONG, ONE INCH IN DIAMETER, WITH ALUMINUM CAP DENOTED AS, "KIMBERLY CLARK CORP. T34N 3, 4, 9, 10 R13E SPERHAKE RLS 463 10/24/63."

The pipe is witnessed by:

- Maple 6 N 36°E 66 links. (SCRIBED S 3 NBT).
- W. Birch 14 N 44°W 18 links. (SCRIBED S 4 NBT).
- W. Birch 12 S 50°W 29 links. (SCRIBED S 9 NBT).
- W. Birch 8 S 30°E 72 links. (SCRIBED S10 NBT).

Description as to how corner was located: No evidence of the original corner is present. Previous work has indicated that though the general original survey of this town was erratic, the length of the top tier of sections is actually very close to the original noted distance. The length of the line between sections 1 and 2 is actually 5 links less than the recorded distance. Thus, I arbitrarily picked an actual length of the line between 3 and 4 as being 6 links less than the record distance. Thus, the north-south position of 3, 4, 9, 10, is 75.34 chains south of the town line corner of 3 and 4. For the east-west position: To the east the corner of 2, 3, 10, 11 had been previously determined. To the west, Ralph Cook, a resident of Arbutus Lake, and a logger in this general area, claimed the position of the corner of 4, 5, 8, 9, had been denoted by a post which was bulldozed out several years ago when a new woods road was built. Cook could only denote an approximate position for the post, but he could not remember exactly where it stood. In searching for any possible evidence of where this corner stood, a location poster denoting the section line between 4 and 5 was located about 2 or 3 chains north of where the corner should have been. Since this location poster, which was emplaced in 1940, must have been put up when the section corner was still present, I am confident that it denotes the east-west position of 4, 5, 8, 9, and although from this we do not know the exact position of the corner, we can use it for denoting the western limits of the line between 4 and 9. Thus, we were able to determine that the distance between 2, 3, 10, 11 and the east-west position of 4, 5, 8, 9, is 163.64 chains. The record distance of the line between (continued on back)

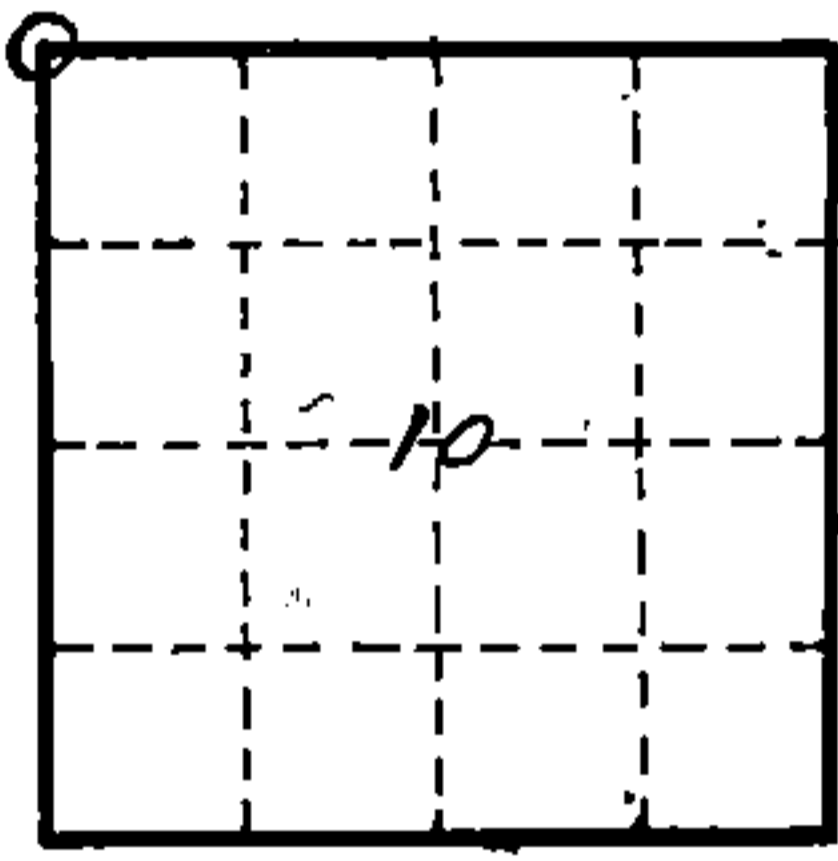

0 = Corner monument restored

Subscribed & sworn to before me this 25 day of Aug. 1964
Anna Peterson
NOTARY PUBLIC, FOREST CO., WIS.
COM. EXPIRES 10/31/65.

Resident witnesses _____

Dated at Crandon, Wisconsin, this 25 day of Aug, 19 64.

Signature *Neal Sperhake*

Title Registered Land Surveyor Registration No. 463

Office of Reg. of Deeds _____ County of Forest

I hereby certify that the within instrument was filed in this office for record on the 25 day of Aug 19 64, and was filed in Book No. _____ Page No. _____ of County Records.

Signature *Anna Peterson* Title Reg. of Deeds

43413040000

88918

Index No.: E-13
E-13

Surveyor's Seal

3 and 10 was 80.10 chains. Applying proportionate measurement, the actual length of the line from 2, 3, 10, 11, to 3, 4, 9, 10, should be 81.56 chains. Lacking any other evidence, I have accepted this for denoting the east-west position of 3, 4, 9, 10.

1110