

State of Wisconsin

County of FOREST

ss. RESTORATION OF LOST ORIGINAL GOVERNMENT SURVEY CORNER.

I NEAL SPERHAKE, do hereby certify that on the FOURTEENTH day of NOVEMBER, 19 63, I established the WEST QUARTER SECTION CORNER OF SECTION 3, TOWNSHIP 34 NORTH, RANGE 13 EAST, Fourth Principal Meridian, as described hereon.

History: This corner was established during the original survey of this township, as noted in the original field notes for the original survey of T34N-R13E, 4th. p.m.

Description of monument and accessories I established to perpetuate the location of this corner:


At the point determined for the location of the corner I emplaced a:

GALVANIZED IRON PIPE, THREE FEET LONG, ONE INCH IN DIAMETER, WITH ALUMINUM CAP DENOTED AS, "KIMBERLY-CLARK CORP. T34N 1/4 BTWN. 3 & 4 R13E SPERHAKE RLS 463 11/14/63."

The pipe is witnessed by:

- Maple 9 N 68°E 49 links. (SCRIBED 1/4 S 3 NBT).
- Maple 3 N 64°W 57 links. (SCRIBED 1/4 S 4 NBT).

Description as to how corner was located: No evidence of original corner present. Thus, set by proportionate measurement. The section corners 1/2 mile north and south have been previously established with a distance of 75.34 chains between them. The record distance was 75.40. The record length of the line between the corner of 3, 4, 9, 10 and the quarter section corner between sections 3 and 4 was 40.00 chains. Thus, set the quarter corner 39.97 chains north of the section corner common to sections 3, 4, 9 and 10 and 35.37 chains south of the section corner between sections 3 and 4 on the town line and on a straight line between them.

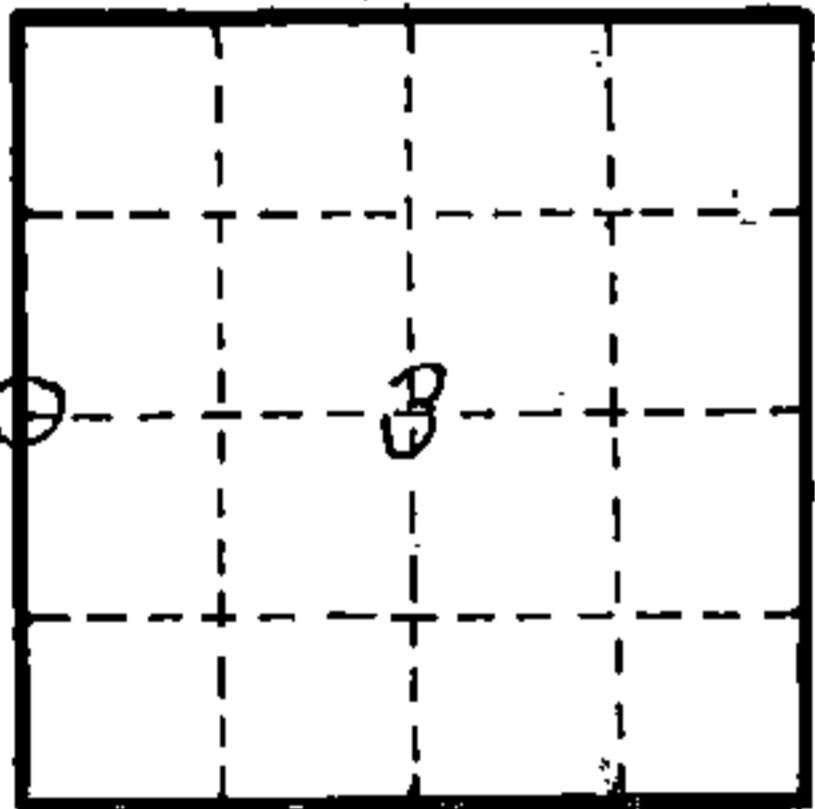

O = Corner monument restored

~~Received for record this 25 day of August 1964~~

Subscribed & sworn to before me this 25 day of Aug. 1964

Anna Peterson

Notary Public, Forest Co., Wis  
Com. expires 10/31/65

Resident witnesses \_\_\_\_\_

Dated at Crandon, Wisconsin, this 25 day of Aug, 19 64.

Signature Neal Sperhake

Title Registered Land Surveyor Registration No. 463

Office of Reg. of Deeds County of Forest

I hereby certify that the within instrument was filed in this office for record on the 25 day of Aug 19 64, and was filed in Book No. \_\_\_\_\_ Page No. \_\_\_\_\_ of County Records.

Surveyor's Seal

Signature Anna Peterson Title Reg. of Deeds

4341304 2000

88949

Index No.

6-13  
13