


CERTIFIED LAND CORNER RESTORATION

Index No. **E-5**

State of Wisconsin }
County of Forest } ss.

I Daniel K. Pleoger, do hereby certify that on the 24 day of July, 19 81, I found evidence of the Section corner of Sections 5-6-7-8 Township 34 North, Range 13 East, Fourth Principal Meridian, as described hereon; and that from this evidence I established a new monument and accessories as described hereon to perpetuate the original location of this corner.

Resident witnesses:

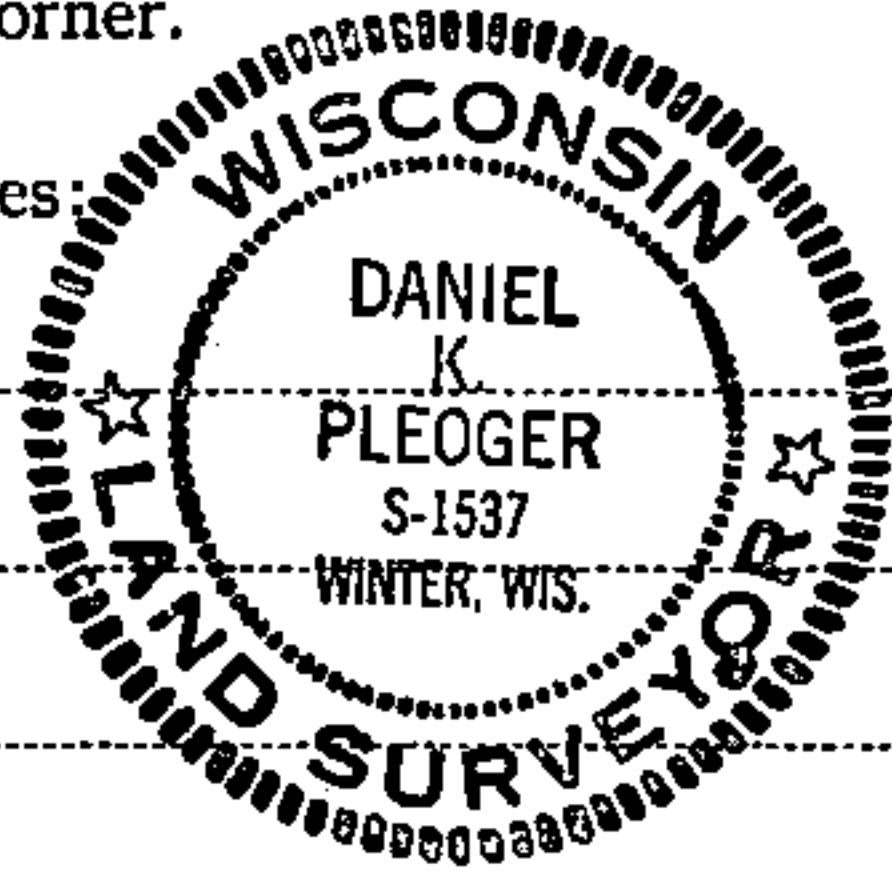

History of original corner establishment:

Original corner established by James L. Nowlin Gov. deputy surveyor in 1865 from which sugar 10" bears N58E 25 lks and sugar 12" bears N32W 80 lks.

Description of corner evidence found:

Recovered a 1 1/2" iron pipe - also a 5" squared cedar post alongside iron pipe.
Recovered O.B.T.s

Sugar 6" N75W 3.72 ft.
Scribed B.T.

Sugar 7" N48E 17.31 ft.
Scribed B.T.

Description of monument and accessories I established to perpetuate the original location of this corner.


Replaced iron pipe with a 2 1/2" aluminum A-1 Federal monument with alloy cap stamped:

Monument projects 8" above ground

Marked N.B.T.
Maple 16" S52E 18.50 ft.
Scribed S.C.-B.T.

T34N R13E
S.C. 6/5
7/8
S1537-1981

FORM 985 H. C. MILLER CO., MILWAUKEE

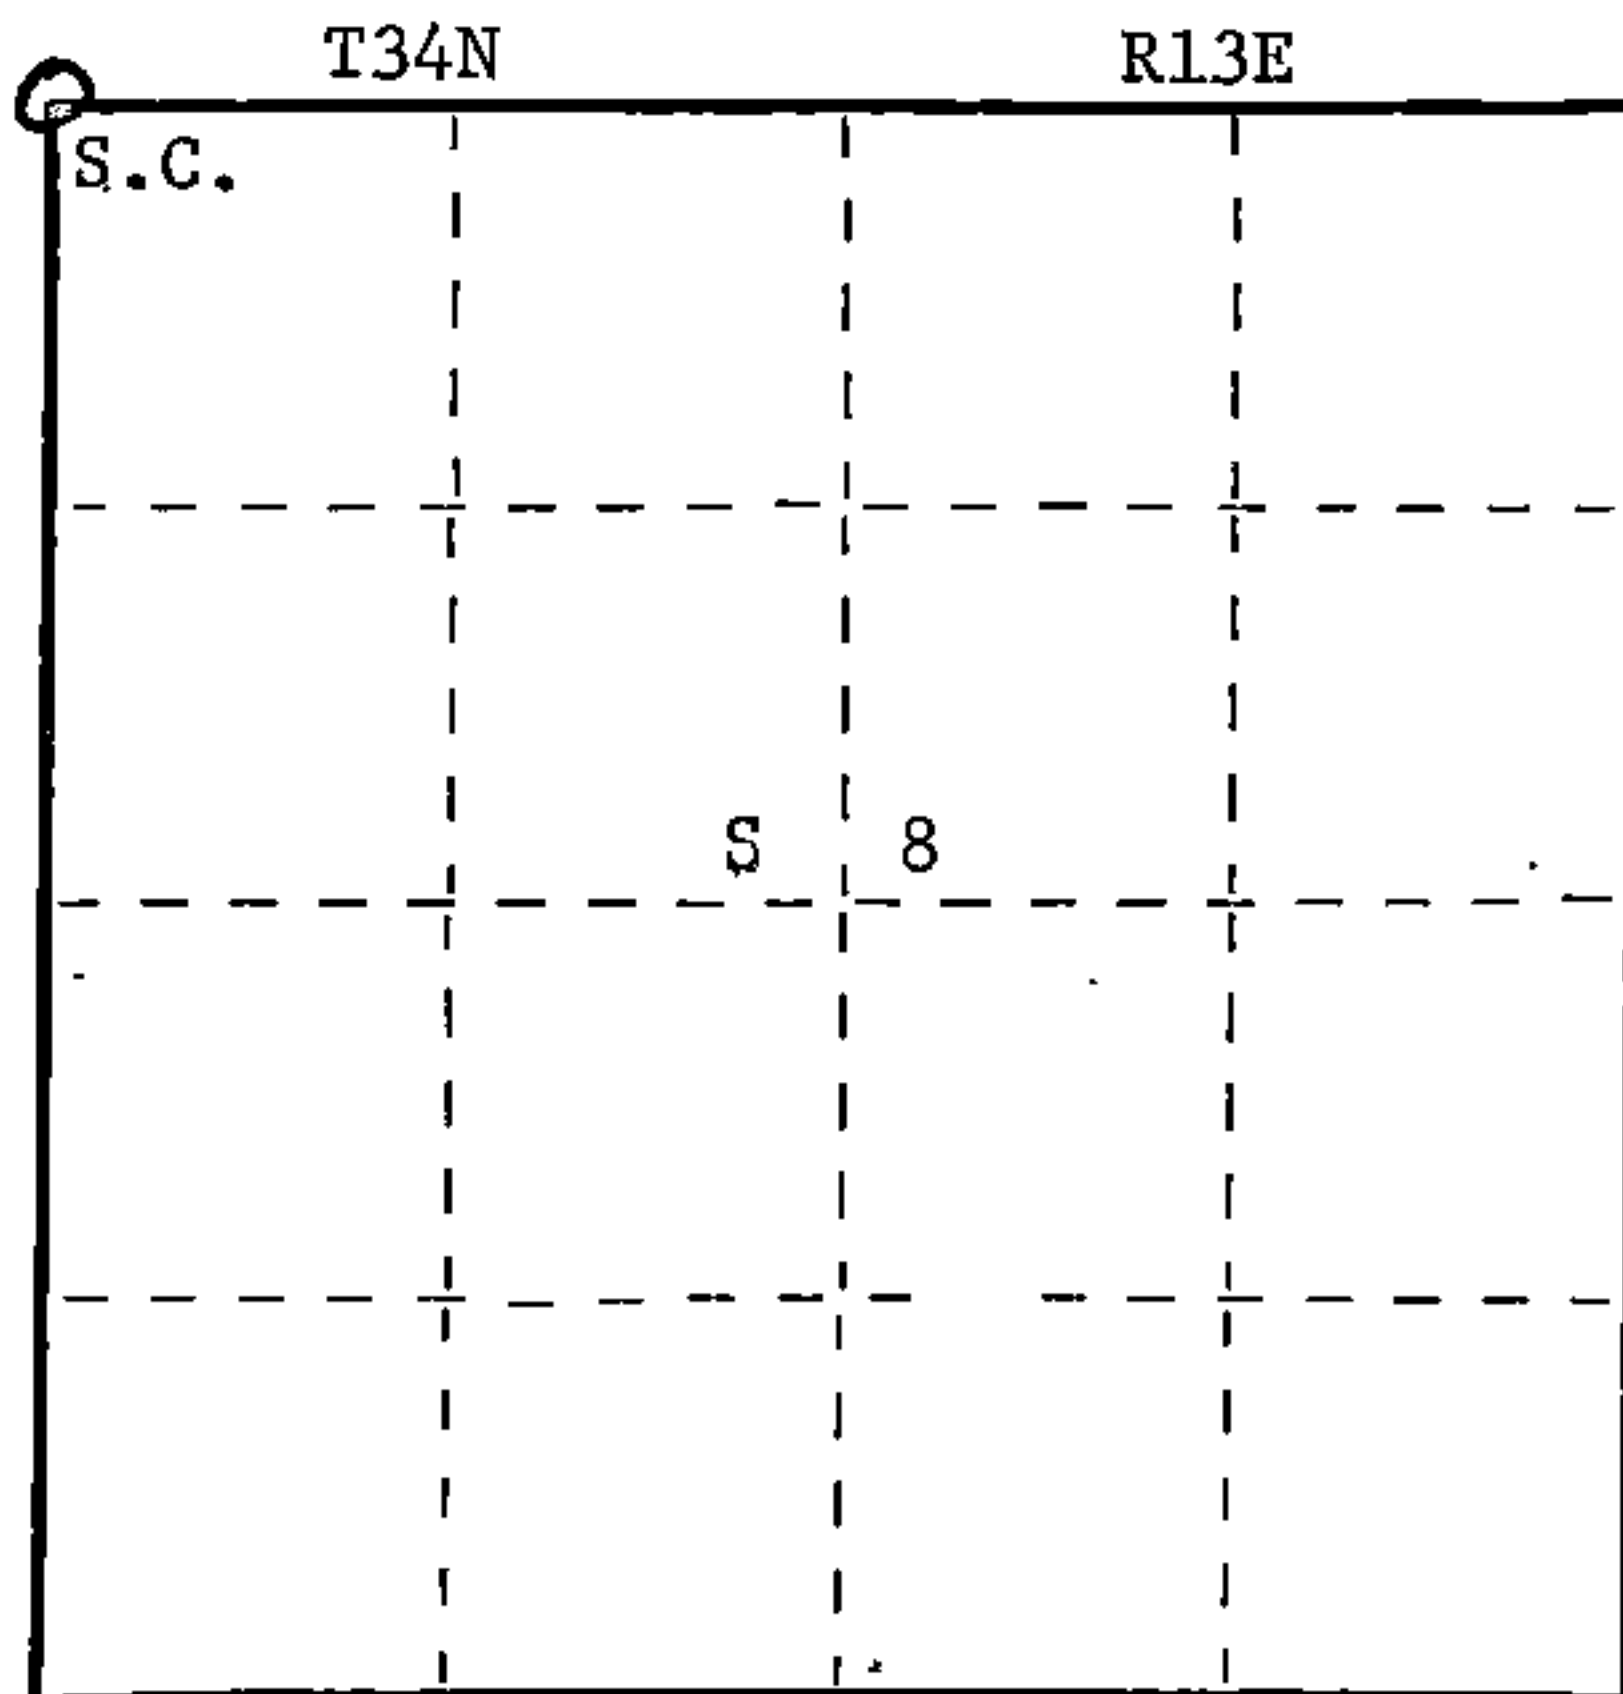

○ = Corner monument restored.

Dated at Rhineland, Wis., this 17 day of September, 19 81

Signature Daniel K. Pleoger Title Registered Land Surveyor Registration No. 1537
(County Surveyor, Registered Land Surveyor, or other duly authorized official)

Office of Register of Deeds, County of Forest, I hereby certify that the within instrument was filed in this office for record on the 25th day of September, 19 81 at 2:00 o'clock P. M.

Eugene Stegany (Register of Deeds)
By Deputy

DOCUMENT NO. 120516

43413060000