

State of Wisconsin

County of FOREST

ss. RESTORATION OF LOST ORIGINAL GOVERNMENT SURVEY CORNER.

I NEAL SPERHAKE, do hereby certify that on the SEVENTH day of OCTOBER 1964, I established the CENTER OF THE NORTHEAST QUARTER OF SECTION 7, TOWNSHIP 34 NORTH, RANGE 14 EAST, Fourth Principal Meridian, as described hereon.

History: There is no record of this corner having ever been previously established.

Description of monument and accessories I established to perpetuate the location of this corner:

At the point determined for the location of the corner I emplaced a:


GALVANIZED IRON PIPE, THREE FEET LONG, ONE INCH IN DIAMETER, WITH ALUMINUM CAP DENOTED AS, "KIMBERLY CLARK CORP. T34N CENTER NE $\frac{1}{4}$ S7 R14E SPERHAKE RLS 463 10/7/64."

The pipe is witnessed by:


Bass 4 N 81°W 56 links. (SCRIBED S7 BT).

Description as to how corner was located: The U. S. Forest Service owns the entire section 7, T34N-R14E, with the exception of government lots 1, 2 and 3, which are owned by the Kimberly-Clark Corporation. To determine the boundary line between forest service and corporation lands, it was agreed upon by Neal Sperhake, registered land surveyor and employee of the Kimberly-Clark Corporation, and David Seaberg, district ranger for the forest service, to do a straight line survey between the previously established north sixteenth corners on the east and west sides of section 7. The center of the northeast quarter was to be established on this east-west sixteenth line at a proportioned east-west distance. The expense of sub-dividing the entire section prohibited using this more proper method of determining the line and corner in question. The northeast and northwest section corners and the east quarter section and west quarter section corners of section 7 had been previously established. From them the north sixteenth between sections 7 and 8, and the north sixteenth between section 7, T34N-R14E, and section 12, T34N-R13E, were determined. The original length of the north side of section 7 was 82.18 chains. The original length of the south side of section 7 was 83.04 chains. The original distance between the east and west quarter section corners of section 7 would then have been assumed to be 82.61 chains, and the original distance between the two north sixteenth corners on the east and west boundaries of section 7 would have been assumed to be 82.39 $\frac{1}{2}$ chains. A straight line between the two north sixteenth corners was then run. It was agreed between the two representatives of the Forest service and the Kimberly-Clark Corporation that the south boundary of

(continued on back)

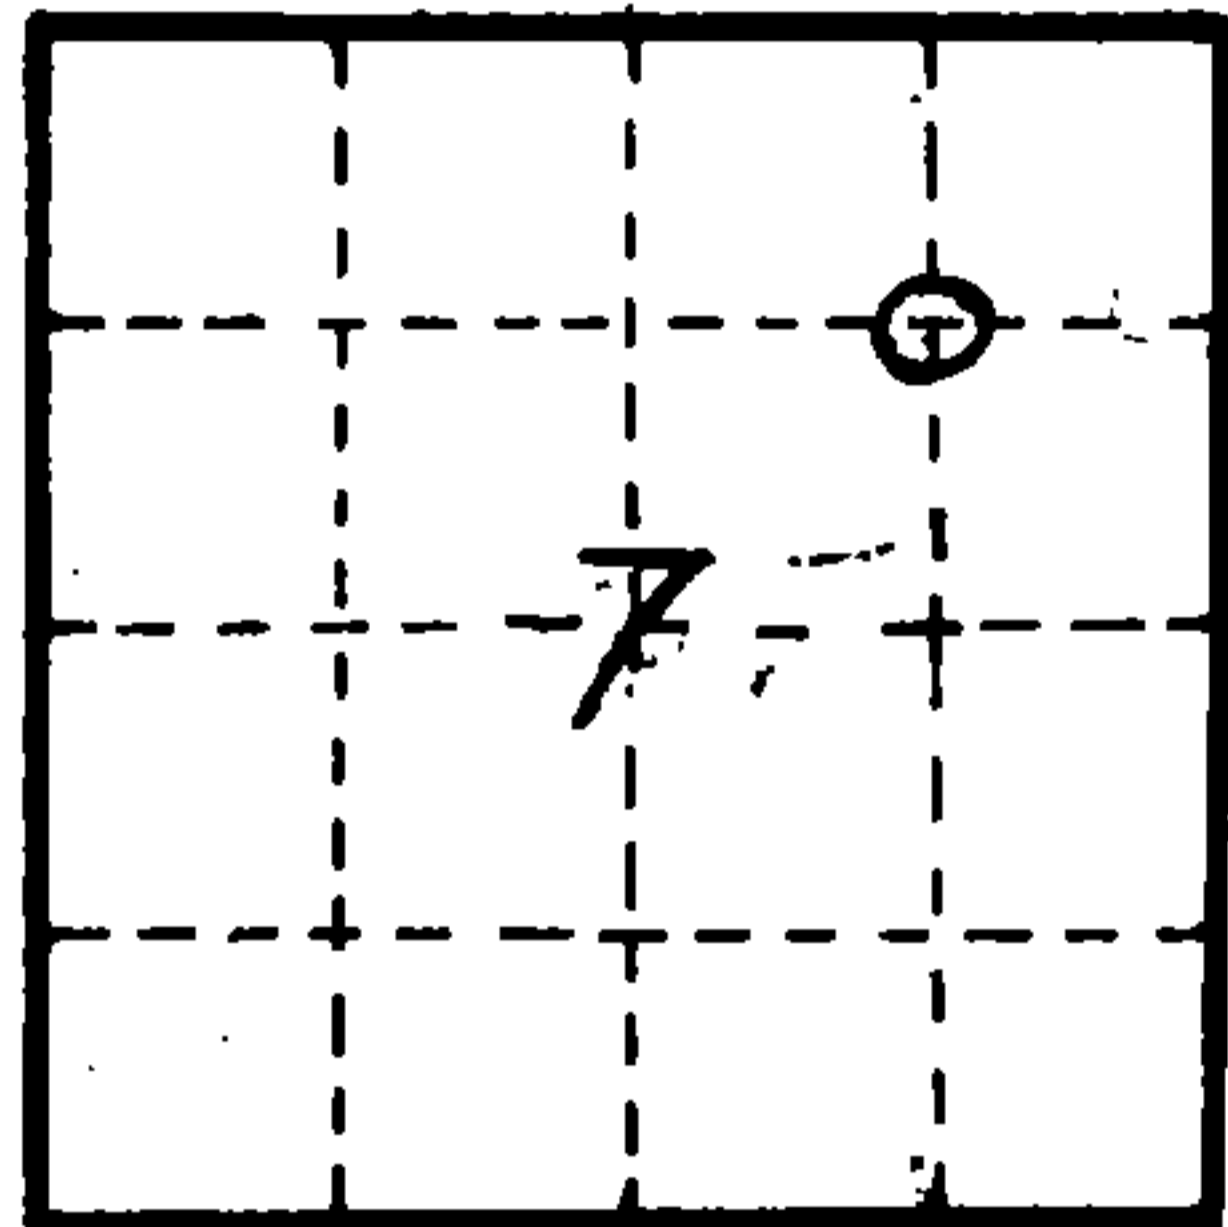

O = Corner monument restored

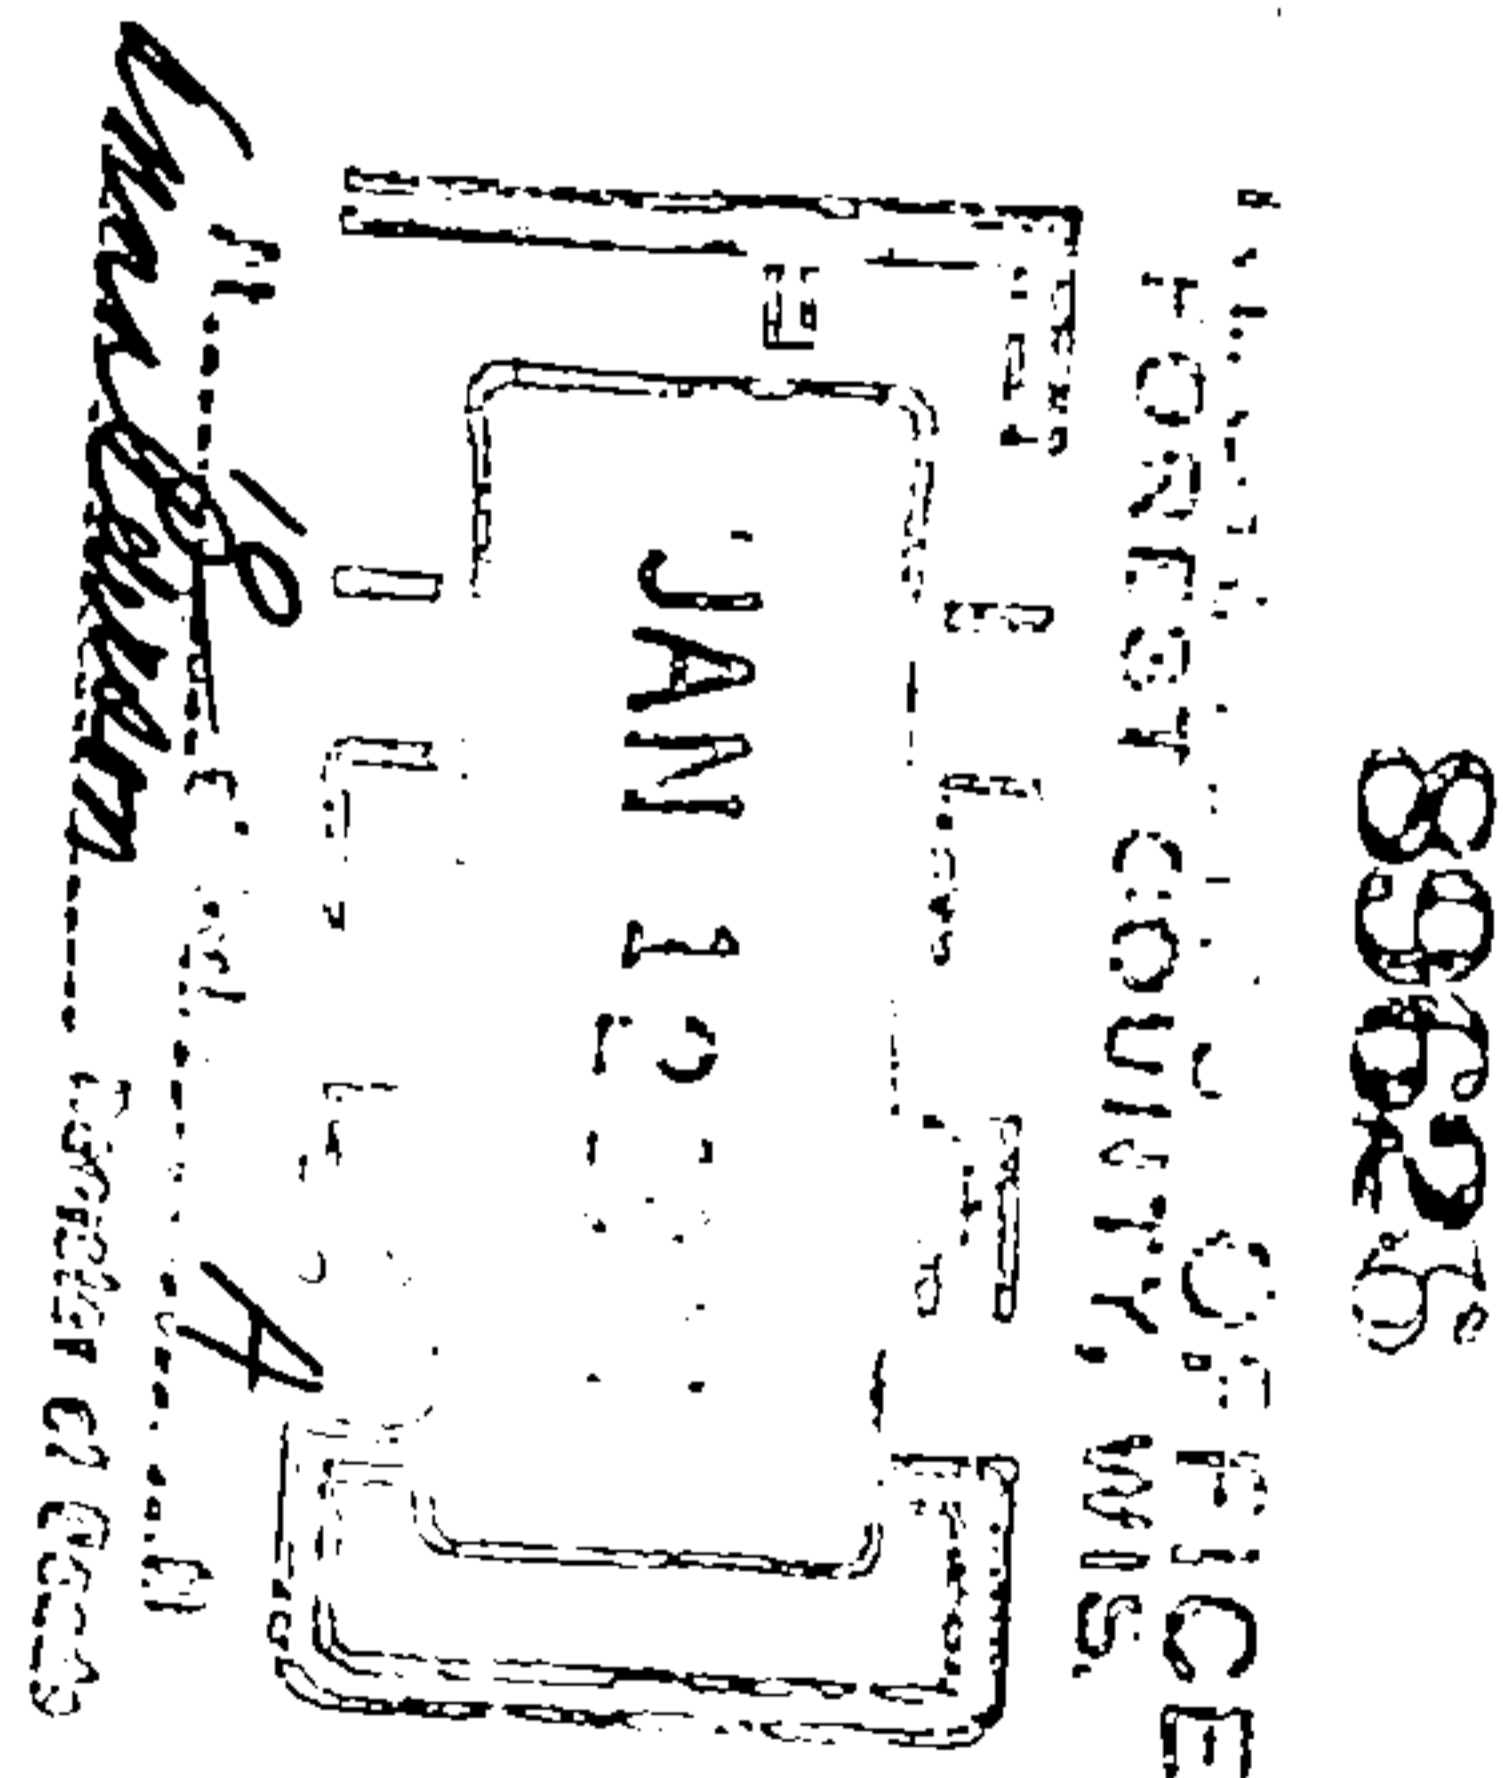

89625

Resident witnesses

Dated at Crandon, Wisconsin, this 12th day of January, 1965.

Signature Neal Sperhake
Title Registered Land Surveyor Registration No. 463

~~Office~~ Forest County ~~Wisconsin~~
I hereby certify that the within instrument was ~~filed in the~~
~~office for record~~ on the 12th day of January
19 65, and was ~~filed in Book No.~~ signed and ~~Page No.~~ sworn to
of ~~County Records~~. before me

Signature Anna Peterson Title Notary Public

43-113073010

Index No. 114