


CERTIFIED LAND CORNER RESTORATION

Index No. **H-88**


State of Wisconsin }
County of Forest } ss.

I Daniel K. Pleoger, do hereby
certify that on the 7 day
of July, 19 81, I
Est. ~~the~~ the SE 1/16
corner of Section 8
Township 34, North, Range
13 East, Fourth Principal Meridian,
as described hereon; and that from this evidence
I established a new monument and accessories
as described hereon to perpetuate the original
location of this corner.

Resident witnesses:

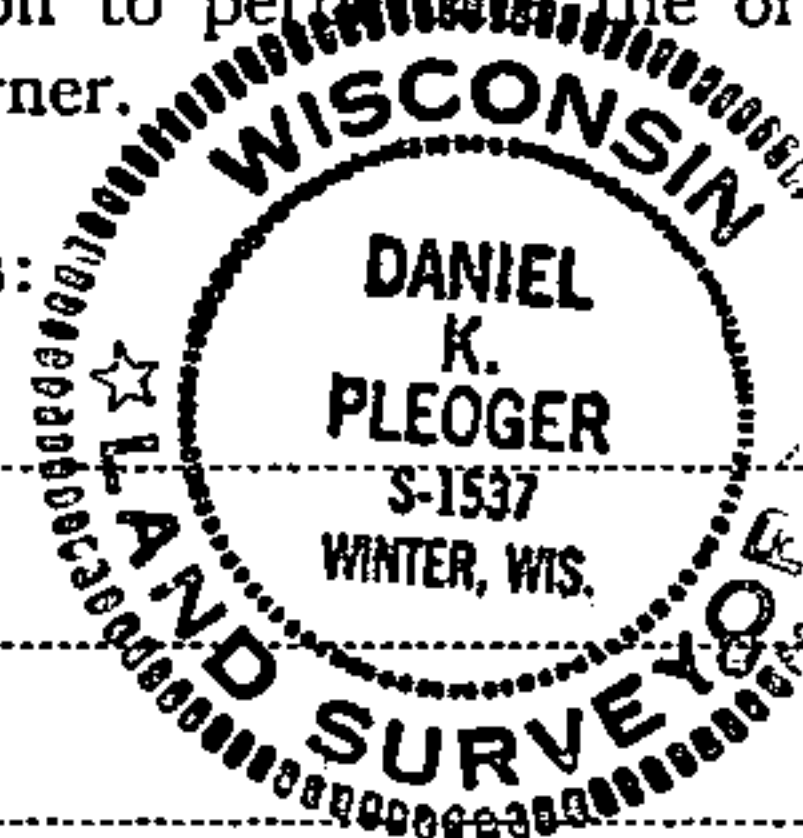

FORM 985 R. G. MILLER CO., MILWAUKEE

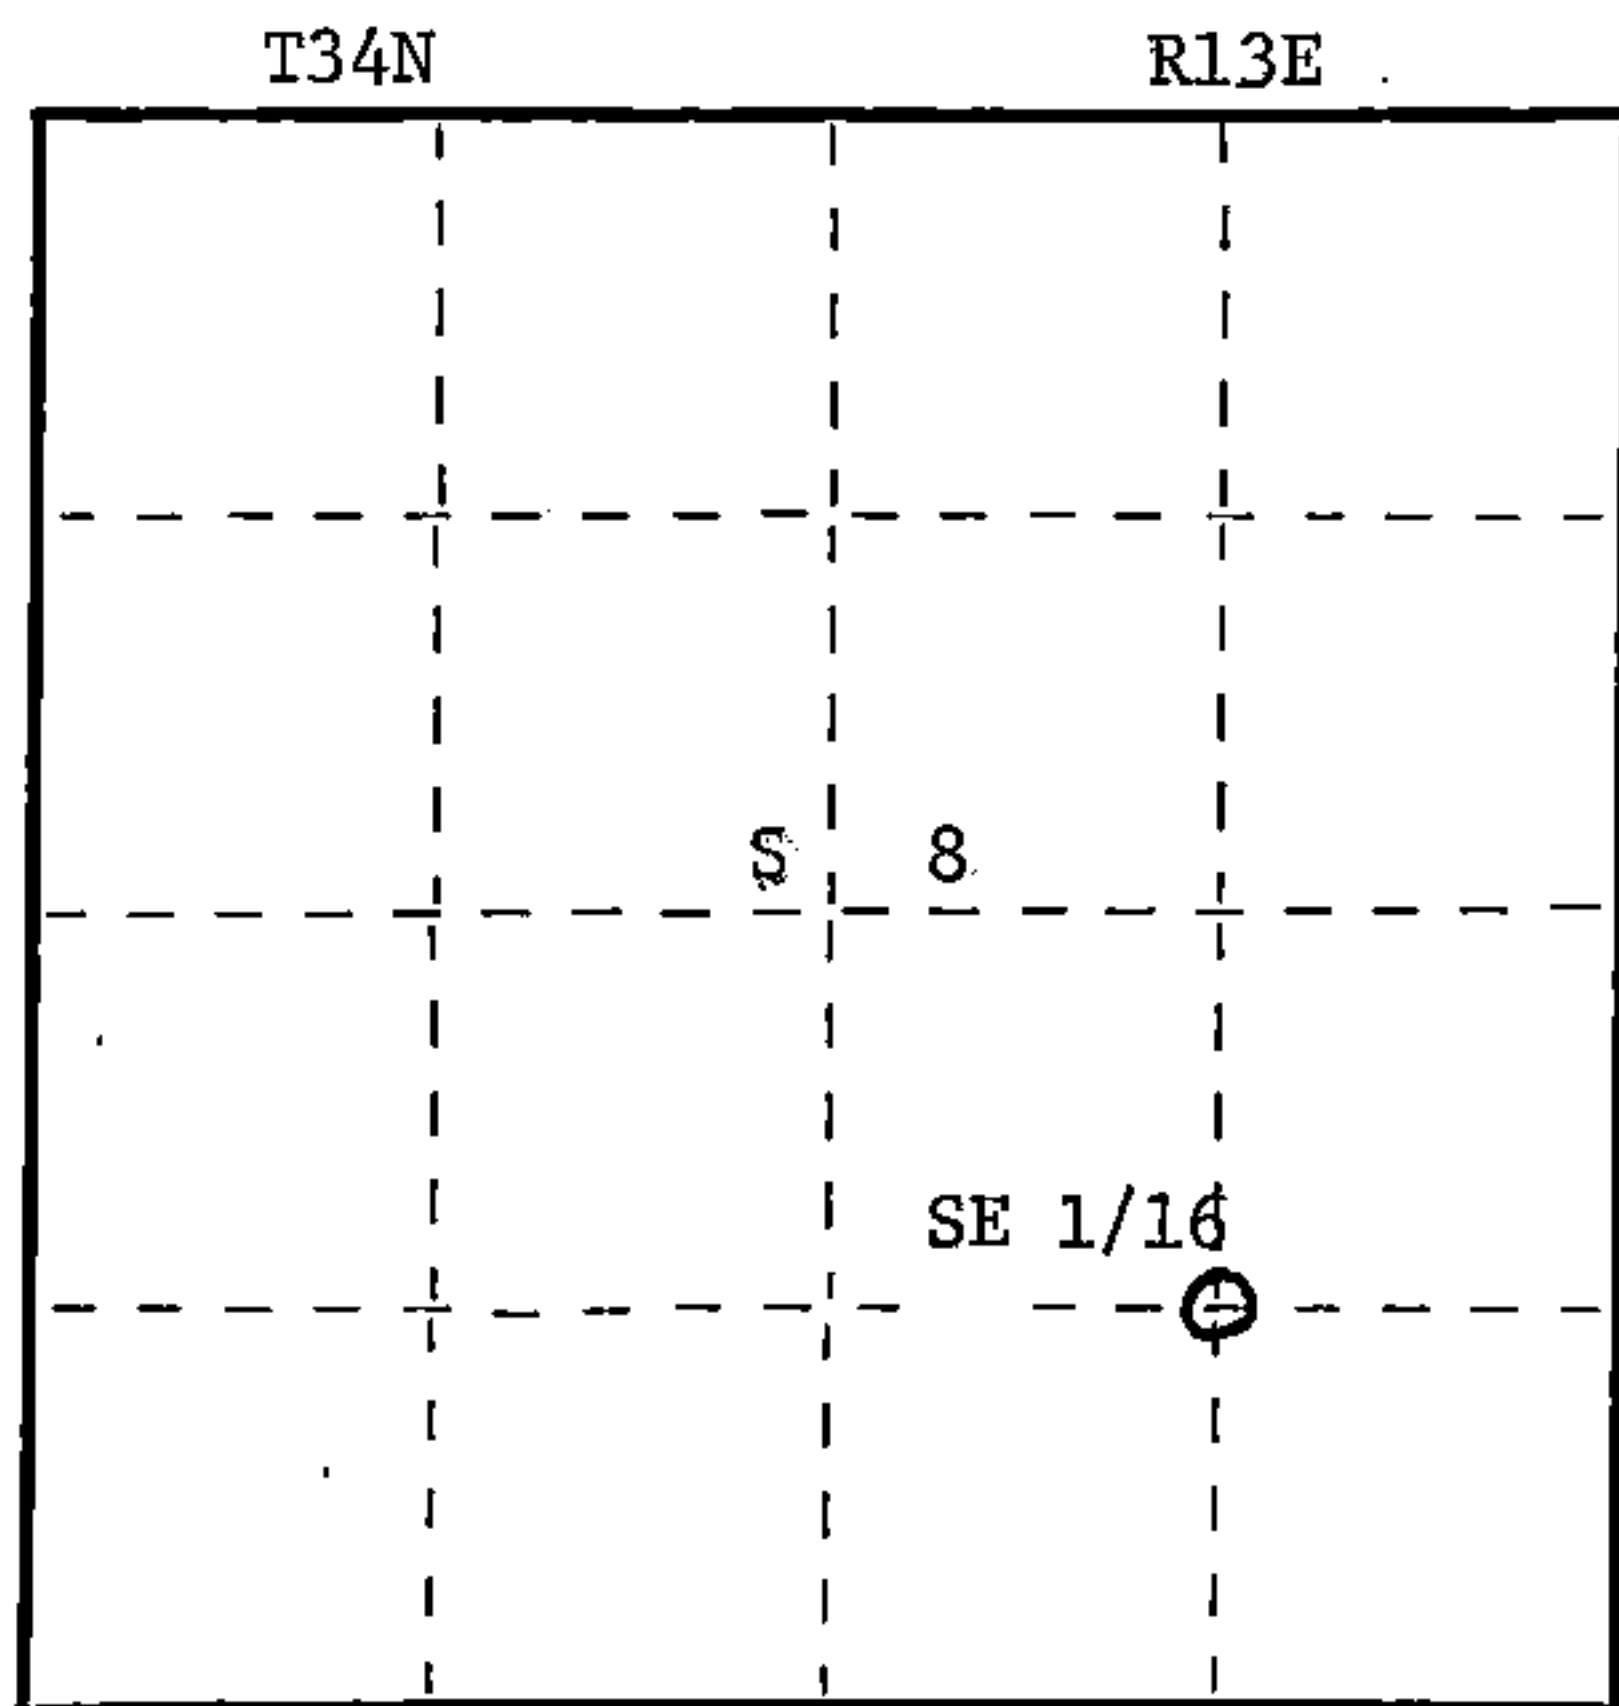

○ = Corner monument restored.

History of original corner establishment:

No evidence of any previous corner.

Description of corner evidence found:

Corner established by subdivision of the SE 1/4.
Location of SE 1/16 is N89-47-31E 1256.744 ft. of SC 1/16 and
S2-50-36W 1319.53 ft. of EC 1/16

Description of monument and accessories I established to perpetuate the original location of this corner.

Set a 1 1/2" iron pipe with a 2" diameter brass cap stamped:

Monument projects 24" above ground.

Marked NBTs

- Sugar 8" N5°W 7.75 ft.
- Twin sugar 8" N89W 14.88 ft.
- Scribed 1/16 - B.T.

S1537
T34N R13E
SE 1/16 S 8
C.P.I. - 1981

43413481010

Dated at Rhinelander, Wis., this 17 day of September, 1981

Signature *Daniel K. Pleoger* Title Registered Land Surveyor Registration No. 1537
(County Surveyor, Registered Land Surveyor, or other duly authorized official)

Office of Register of Deeds, County of Forest, I hereby certify that the within
instrument was filed in this office for record on the 25th day of September, 1981
at 2:00 o'clock P. M.

Eugene Stutzman
(Register of Deeds)
By _____ Deputy

DOCUMENT NO. 120522