



CERTIFIED LAND CORNER RESTORATION

Index No. **H-77**

State of Wisconsin }
County of Forest } ss.

I Daniel K. Pleoger, do hereby
certify that on the 13 day
of July, 19 81, I ~~found~~
Est. ~~evidence of~~ the SC 1/16
corner of Section 8
Township 34, North, Range
13 East, Fourth Principal Meridian,
as described hereon; and that from this evidence
I established a new monument and accessories
as described hereon to perpetuate the original
location of this corner.

Resident witnesses

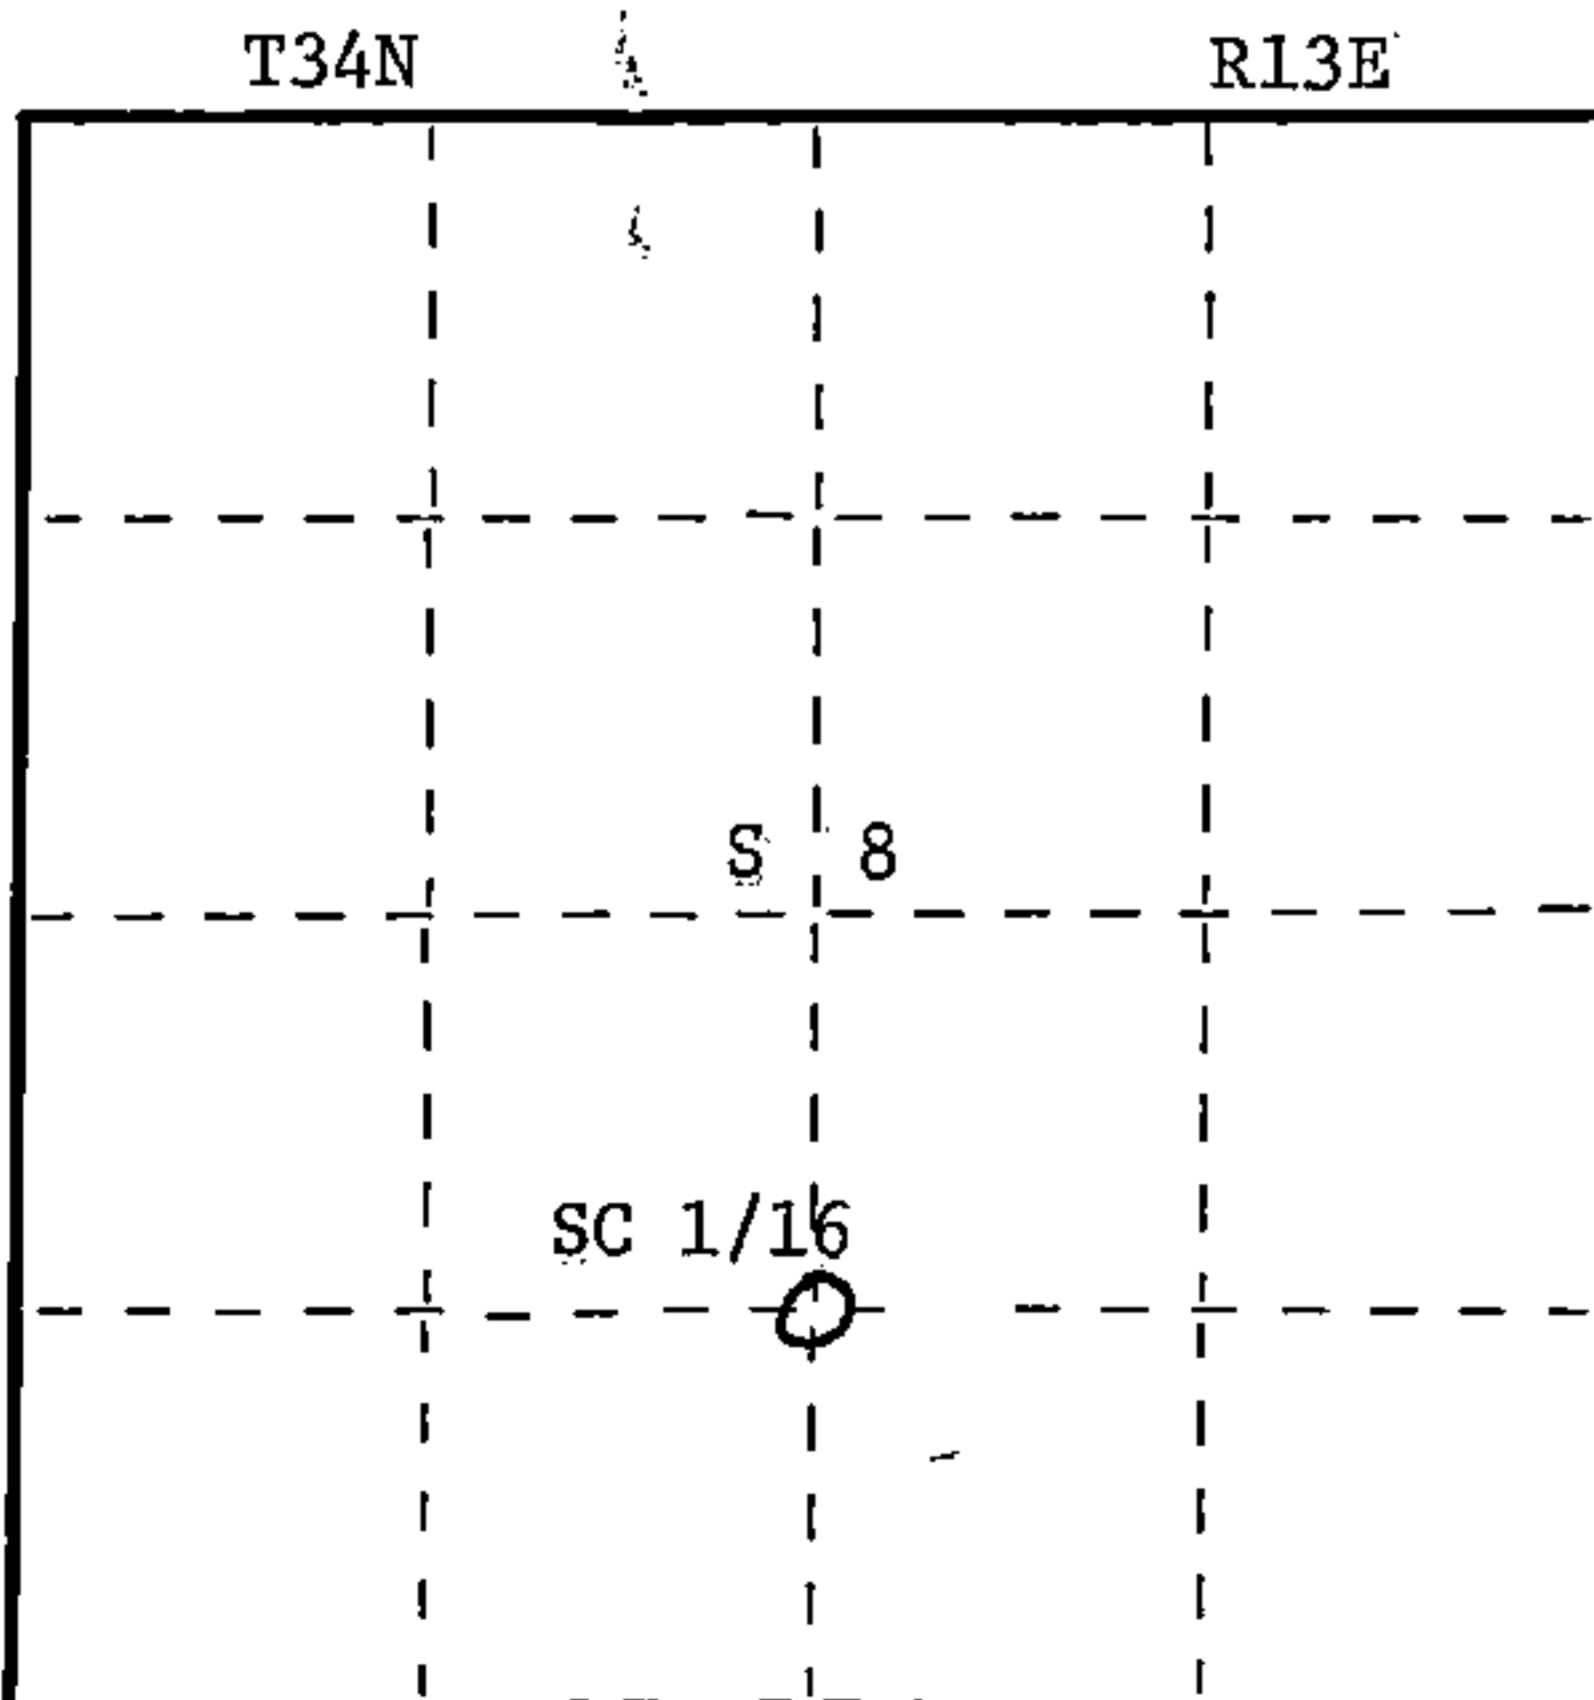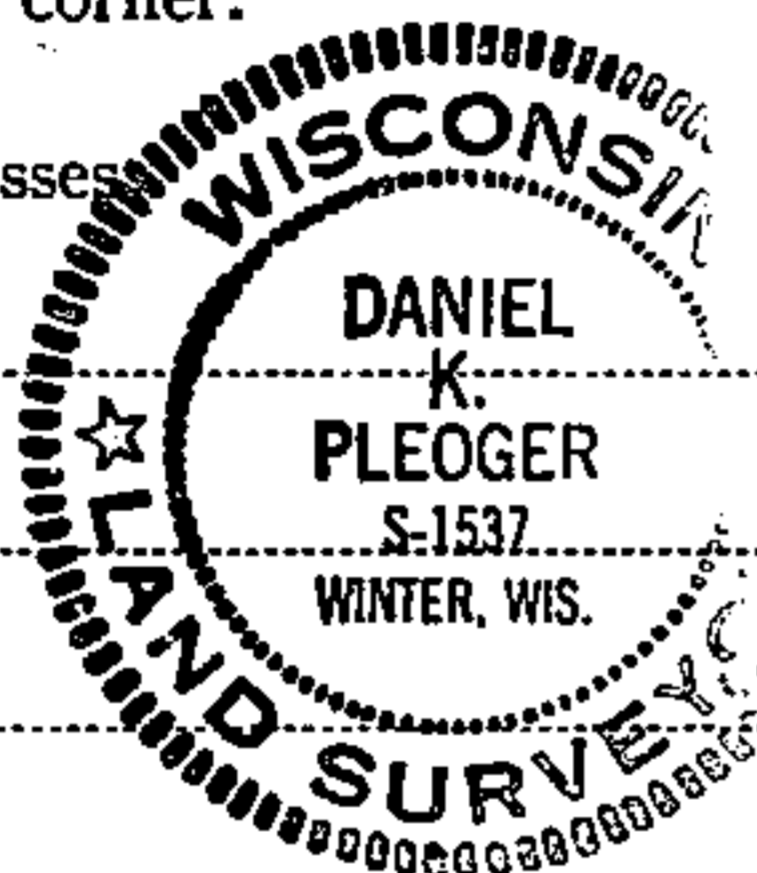

○ = Corner monument restored.

History of original corner establishment:

No evidence of any previous corner.

Description of corner evidence found:

Total distance from 1/4 corner between sections 8 & 17 to C 1/4 corner position is 2608.488 ft. of bearing N4-10-36-E

Set S.C. 1/16 1304.244 ft. intermediate.

Description of monument and accessories I established to perpetuate the original location of this corner.

Set a 1 1/2" iron pipe with alloy cap stamped:

Monument projects 24" above ground.

Marked NBTs

Sugar 9" N39W 44.55 ft. - Scriber 1/16 - B.T.
Sugar 8" N84E 51.39 ft.

S1537
T34N R13E
SC 1/16 S 8
C.P.I. - 1981

Dated at Rhineland, Wis., this 17 day of September, 19 81

Signature Daniel K. Pleoger Title Registered Land Surveyor Registration No. 1537
(County Surveyor, Registered Land Surveyor, or other duly authorized official)

Office of Register of Deeds, County of Forest, I hereby certify that the within
instrument was filed in this office for record on the 25th day of September, 19 81
at 2:00 o'clock P. M.

Eugene Stutzman
(Register of Deeds)
By _____ Deputy

DOCUMENT NO. **120521**

43413081020