

State of Wisconsin
County of FOREST

} ss. RESTORATION OF LOST ORIGINAL GOVERNMENT SURVEY CORNER.

I NEAL SPERHAKE, do hereby certify that on the TWENTY EIGHTH day of OCTOBER, 1963, I established the NORTHWEST SECTION CORNER OF SECTION 15, TOWNSHIP 34 NORTH, RANGE 13 EAST, Fourth Principal Meridian,
as described hereon.

History: This corner was established during the original survey of this township, as noted in the original field notes for the original survey of T34N-R13E, 4th. p.m.


Description of monument and accessories I established to perpetuate the location of this corner:
At the point determined for the location of the corner I emplaced a:

GALVANIZED IRON PIPE, THREE FEET LONG, ONE INCH IN DIAMETER, WITH ALUMINUM CAP DENOTED AS, "KIMBERLY CLARK CORP. T34N 9, 10, 15, 16 R13E SPERHAKE RLS 463 10/28/63."

The pipe is witnessed by:

- Aspen 11 N 57°E 26½ links. (SCRIBED S10 NBT).
- Aspen 7 S 50°E 16 links. (SCRIBED S15 NBT).
- Aspen 8 S 56°W 18 links. (SCRIBED S16 NBT).
- Aspen 10 N 67°W 19½ links. (SCRIBED S 9 NBT).

Description as to how corner was located: No evidence of the original corner is present. Thus, attempted to set the corner by double proportionate measurement. To the north the corner of 3, 4, 9, 10, and to the south the corner of 15, 16, 21, 22, had been previously set. The distance between them is 156.75 chains. Thus, the north-south position of 9, 10, 15, 16, would be 78.37½ chains from either previously set corner. To the east the corner of 10, 11, 14, 15, and to the west the corner of 8, 9, 16, 17, had been previously set, with a distance of 165.06 chains between them. Thus, the east-west position of 9, 10, 15, 16, would be 82.53 chains from either previously set corner. 81.06 chains north of 15, 16, 21, 22, and 78.74 chains east of 8, 9, 16, 17, is the junction of a blaze line running north and west. Ralph Cook, a resident and logger on Arbutus Lake, states that about thirty years ago at the junction of these blaze lines was a post which his father had told him was the accepted section corner for 9, 10, 15, 16. Experience in surveying in this area has taught us that the original survey was erratic here, and the proportionate measurement very rarely ever corresponded with the actual position of located original corners. In the course of this present retracement survey a post, accepted locally as the quarter section corner between 15 and 16, was located 40.53 chains north of the corner of 15, 16, 21, 22. A straight line projected northward between these two corners for exactly 40.53 chains ends up at the junction of the above noted blaze lines tentatively denoting the corner of 9, 10, 15, 16. Cook has also stated that the post marking the quarter section corner between 15 and 16 was set during the thirties by a Federal agency that was doing retracement survey work in this particular area as part of the public works programs of those days. It is his opinion, and it is
(continued on back)

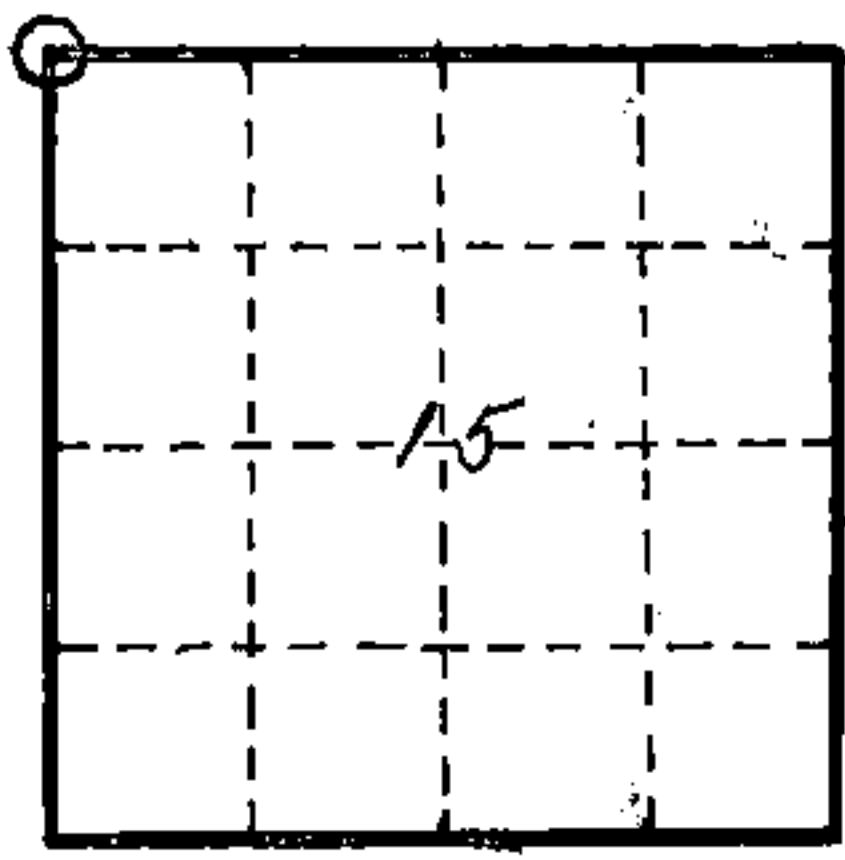

0 = Corner monument restored

Subscribed & sworn to before me this 25 day of Aug 1964
Anna Peterson
 NOTARY PUBLIC FOREST CO WIS
 COM. EXPIRES 10/31/65

Resident witnesses _____

Dated at Crandon, Wisconsin, this 25 day of Aug, 1964.

Signature *Neal Sperhake*

Title Reg. Land Surveyor Registration No. 463

Office of Reg. of Deeds County of Forest

I hereby certify that the within instrument was filed in this office for record on the 25 day of Aug 1964,^{2PM} and was filed in Book No. _____ Page No. _____ of County Records.

Surveyor's Seal

Signature *Anna Peterson* Title Reg. of Deeds

43413090000

88833

Index No.

3-113

so coincidental that I agree with it, that the corner of 9, 10, 15, 16 was present thirty years ago, and probably even witnessed yet by an original bearing tree. A straight line was run between it and the corner of 15, 16, 21, 22, and the quarter section corner of 15 and 16 set half way between them. Now that the post denoting the corner of 9, 10, 15, 16, is missing, I have replaced it by reversing the situation and prolonging a straight line northward between the corner of 15, 16, 21, 22 and the quarter section corner between 15 and 16, for a distance of 40.53 chains north of the quarter corner, thus accepting the location as denoted by the blaze lines and pointed out by Ralph Cook as the corner for 9, 10, 15, 16.

