

State of Wisconsin
County of FOREST

ss. RESTORATION OF LOST ORIGINAL GOVERNMENT SURVEY CORNER.

I NEAL SPERHAKE, do hereby certify that on the TWENTH-EIGHTH day of OCTOBER, 19 63, I established the NORTHWEST SECTION CORNER OF SECTION 14, TOWNSHIP 34 NORTH, RANGE 13 EAST, Fourth Principal Meridian,
as described hereon.

History: This corner was established during the original survey of this township, as noted in the original field notes for the original survey of T34N-R13E, 4th. p.m.


Description of monument and accessories I established to perpetuate the location of this corner:
At the point determined for the location of the corner I emplaced a:

GALVANIZED IRON PIPE, THREE FEET LONG, ONE INCH IN DIAMETER, WITH ALUMINUM CAP DENOTED AS, "KIMBERLY CLARK CORP. T34N 10, 11, 14, 15 R13E SPERHAKE RLS 463 10/28/63."

The pipe is witnessed by:

- Cedar 10 N 53°W 39 links. (SCRIBED S10 NBT).
- Cedar 7 N 6°E 20½ links. (SCRIBED S11 NBT).
- Cedar 10 S 78°E 36½ links. (SCRIBED S14 NBT).
- Y. Birch 9 S 57°W 26½ links. (SCRIBED S15 NBT).

Description as to how corner was located: No evidence of the original corner is present. Experience has proved that the original survey was so erratic in this area that proportionate measurement cannot be relied upon. Charles Borth of Elcho, Wisconsin, a retired forester for the State of Wisconsin, personally showed me an old cedar post which he claims he set in 1949 at the site of the original corner for 10, 11, 14, 15. From the post there is an old Blazed line, about 60 years old as determined by counting the rings on overgrown wound material, running to the north. Edges of swamps to the south and east check out exactly with the original field notes. I believe this post marks the site of the original corner. Thus, replaced the post with a pipe and cap as denoted above.

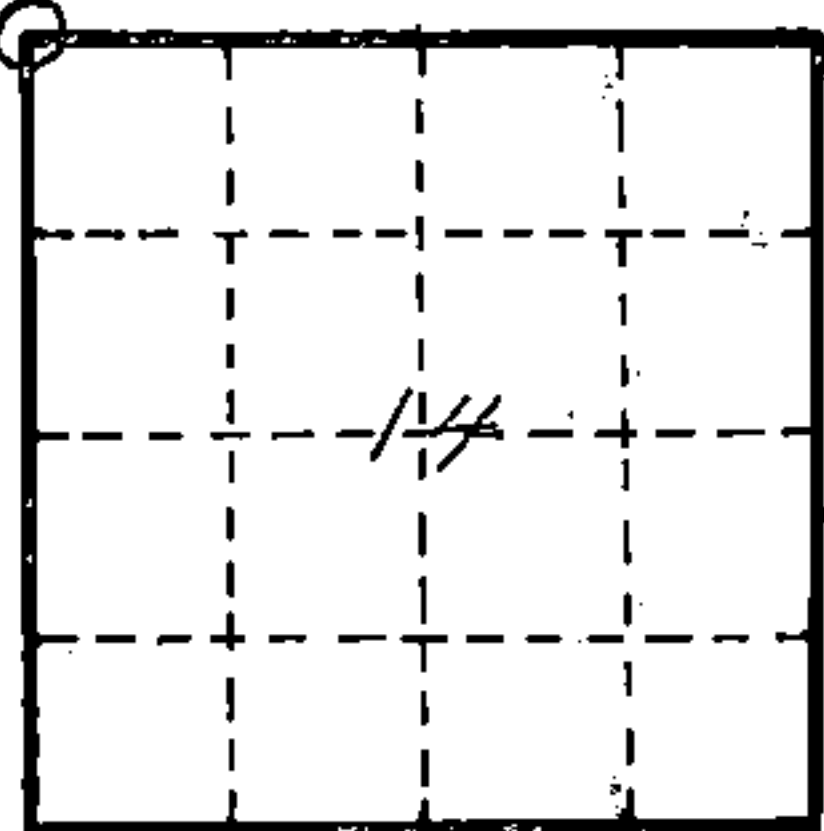

O = Corner monument restored

Subscribed & sworn to before me this 25 day of Aug 1964

Anna Peterson
NOTARY PUBLIC, FOREST CO., WIS
COM. EXPIRES 10/31/65

88957

Resident witnesses _____

Dated at Crandon, Wisconsin, this 25 day of Aug, 19 64.

Signature Neal Sperhake

Title Registered Land Surveyor Registration No. 463

Office of Reg. of Deeds County of Forest

I hereby certify that the within instrument was filed in this office for record on the 25 day of Aug 19 64, and was filed in Book No. _____ Page No. _____ of County Records.

Surveyor's Seal

Signature Anna Peterson Title Reg. of Deeds

43413100000

Index No. 5-17