

State of Wisconsin

County of FOREST

ss. RESTORATION OF LOST ORIGINAL GOVERNMENT SURVEY CORNER.

I NEAL SPERHAKE, do hereby certify that on the THIRTIETH day of OCTOBER, 1963, I established the WEST QUARTER SECTION CORNER OF SECTION 11, TOWNSHIP 34 NORTH, RANGE 13 EAST, Fourth Principal Meridian, as described hereon.

History: This corner was established during the original survey of this township, as noted in the original field notes for the original survey of T34N-R13E, 4th. p.m.

Description of monument and accessories I established to perpetuate the location of this corner:


At the point determined for the location of the corner I emplaced a:

GALVANIZED IRON PIPE, THREE FEET LONG, ONE INCH IN DIAMETER, WITH ALUMINUM CAP DENOTED AS, "KIMBERLY-CLARK CORP. T34N  $\frac{1}{4}$  BTWN. 11 & 10 R13E SPERHAKE RLS 463 10/30/63."

The pipe is witnessed by:

W. Birch 9 S 45°E 07 links. (SCRIBED  $\frac{1}{4}$ S 11 NBT).  
W. Birch 8 N 70°W 16 links. (SCRIBED  $\frac{1}{4}$ S 10 NBT).

Description as to how corner was located: No evidence of original corner present. Thus, set, by proportionate measurement. The section corners  $\frac{1}{2}$  mile north and south have been previously established with a distance of 77.41 chains between them. Thus, set the quarter corner 38.70 $\frac{1}{2}$  chains from either corner and on a straight line between them.

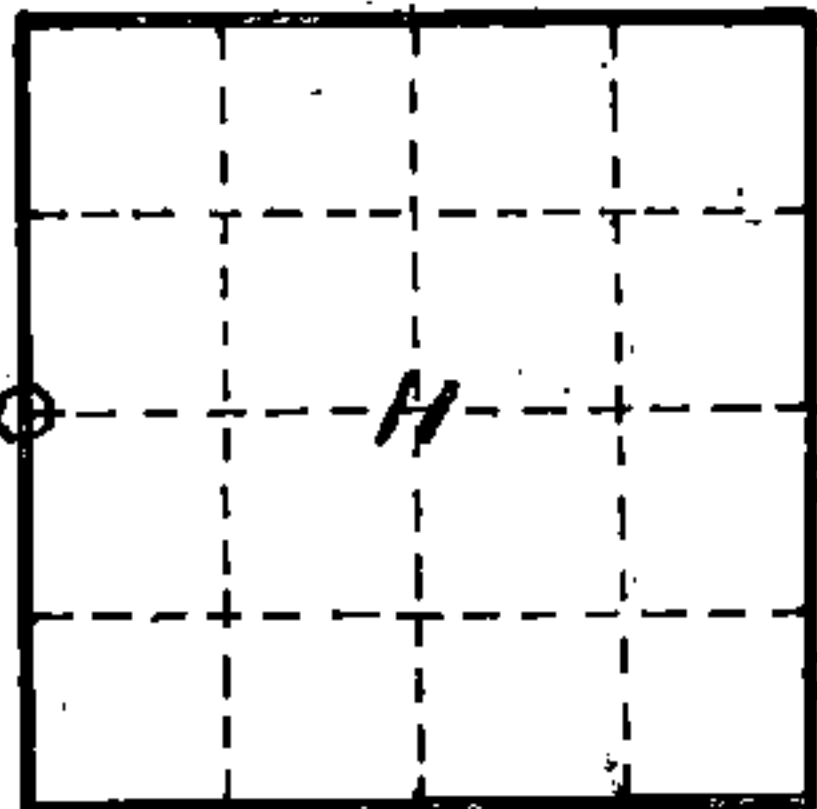

O = Corner monument restored

Subscribed & sworn to before me this 25 day of Aug 1964

Anna Peterson  
Notary Public, Forest Co., Wis  
Com. expires 10/31/65

Resident witnesses \_\_\_\_\_

Dated at Crandon, Wisconsin, this 25 day of Aug, 19 64.

Signature Neal Sperhake

Title Registered Land Surveyor Registration No. 463

Office of Reg. of Deeds County of Forest

I hereby certify that the within instrument was filed in this office for record on the 25 day of Aug 19 64<sup>2PM</sup>, and was filed in Book No. \_\_\_\_\_ Page No. \_\_\_\_\_ of County Records.

Surveyor's Seal

Signature Anna Peterson Title Reg. of Deeds

434131620000

88930

Index No:

G-17  
617