

State of Wisconsin }
County of FOREST } ss. ESTABLISHMENT OF QUARTER - QUARTER SECTION CORNER BETWEEN
ORIGINAL GOVERNMENT SURVEY CORNERS.

I NEAL SPERHAKE, do hereby certify that on the THIRTIETH day of OCTOBER,
19 63, I established the NORTH ONE SIXTEENTH CORNER BETWEEN SECTIONS 10 AND 11, TOWNSHIP 34
NORTH, RANGE 13 EAST, Fourth Principal Meridian,
as described hereon.

History: There is no record of this corner having ever been previously established.


Description of monument and accessories I established to perpetuate the location of this corner:

At the point determined for the location of the corner I emplaced a:
GALVANIZED IRON PIPE, THREE FEET LONG, ONE INCH IN DIAMETER, WITH ALUMINUM CAP DENOTED AS,
"KIMBERLY CLARK CORP. T34N N 1/16 BTWN. 10 & 11 R13E SPERHAKE RLS 463 10/30/63."

The pipe is witnessed by:

- Oak 12 N 64°E 56 1/2 links. (SCRIBED S11 BT).
- Oak 8 S 89°W 91 links. (SCRIBED S10 BT).

Description as to how corner was located: The section corner 1/4 mile north and the quarter corner
1/4 mile south have been previously established with a distance of 38.70 1/2
chains between them. Thus, set the N 1/16 corner 19.35 1/4 chains from
either corner and on a straight line between them.

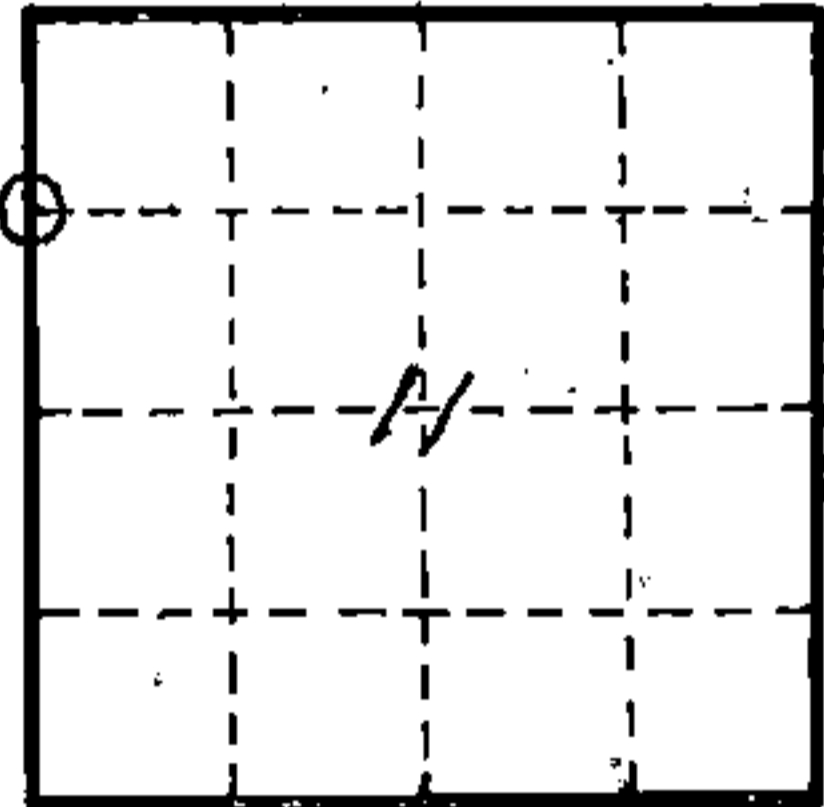

0 = Corner monument
restored

Subscribed & sworn to before me this 25 day of
Aug 1964
Anna Peterson
NOTARY PUBLIC, FOREST CO., WIS
COM. EXPIRES 10/31/65

88961

Resident witnesses _____

Dated at Grandon, Wisconsin, this 25
day of Aug, 19 64.

Signature Neal Sperhake

Title Registered Land Surveyor Registration No. 463

Office of Reg. of Deeds County of Forest

I hereby certify that the within instrument was filed in this
office for record on the 25 day of Aug
19 64, and was filed in Book No. _____ Page No. _____
of County Records.

Surveyor's Seal

Signature Anna Peterson Title Reg. of Deeds

43913103000

Index No. 17