

State of Wisconsin

County of FOREST

ss. RESTORATION OF LOST ORIGINAL GOVERNMENT SURVEY CORNER.

I NEAL SPERHAKE, do hereby certify that on the FIRST day of NOVEMBER, 19 63, I established the NORTH QUARTER SECTION CORNER OF SECTION 13, TOWNSHIP 34 NORTH, RANGE 13 EAST, Fourth Principal Meridian, as described hereon.

History: This corner was established during the original survey of this township, as noted in the original field notes for the original survey of T34N-R13E, 4th. p.m.

Description of monument and accessories I established to perpetuate the location of this corner:


At the point determined for the location of the corner I emplaced a:

GALVANIZED IRON PIPE, THREE FEET LONG, ONE INCH IN DIAMETER, WITH ALUMINUM CAP DENOTED AS, "KIMBERLY-CLARK CORP. T34N 1/4 BTWN. 12 & 13 R13E SPERHAKE RLS 463 11/1/63."

The pipe is witnessed by:

- Cherry 6 N 45°E 104 1/2 links. (SCRIBED 1/4 S 12 NBT).
- Cherry 4 S 38°E 79 links. (SCRIBED 1/4 S 13 NBT).

Description as to how corner was located: No evidence of original corner present. Thus, set by proportionate measurement. The section corners 1/2 mile east and west have been previously established with a distance of 77.43 chains between them. Thus, set the quarter corner 38.71 1/2 chains from either corner and on a straight line between them.

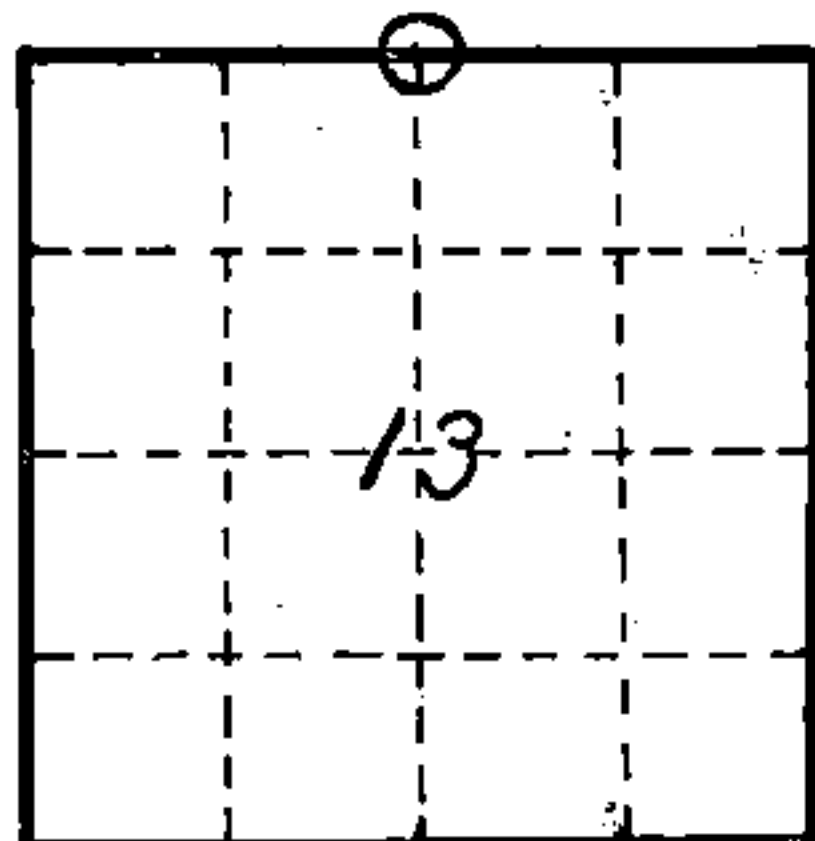

0 = Corner monument restored

89572

REGISTRARS OFFICE
FOREST COUNTY, WIS.

FILE

JAN 12 1965

10
Anna Peterson Register of Deeds

Resident witnesses _____

Dated at Crandon, Wisconsin, this 12 day of January, 1965.

Signature Neal Sperhake

Title Registered Land Surveyor Registration No. 463

~~Office of~~ ~~County of~~ signed & sworn to, I hereby certify that the within instrument was ~~filed in~~ ~~office for record~~ on the 12 day of Jan. 1965, and was filed in Book No. _____ Page No. _____ of County Records.

Surveyor's Seal

Signature Anna Peterson Title Notary Public

434 13120020

Index No. J-23
23