

CERTIFIED LAND CORNER RESTORATION

Index No. M-25  
**M 25**

State of Wisconsin }  
County of Forest } ss.

I, Glen Barker, do hereby certify that on the 14th day of September, 19 82, I found evidence of the S 1/16 corner of Sections 13 & 18 Township 34, North, Range 13, 14 East, Fourth Principal Meridian, as described hereon; and that from this evidence I established a new monument and accessories as described hereon to perpetuate the original location of this corner.


Resident witnesses:

Jim Claflin - RLS

H. Wagoner



FORM 985 R. C. MILLER CO., MILWAUKEE

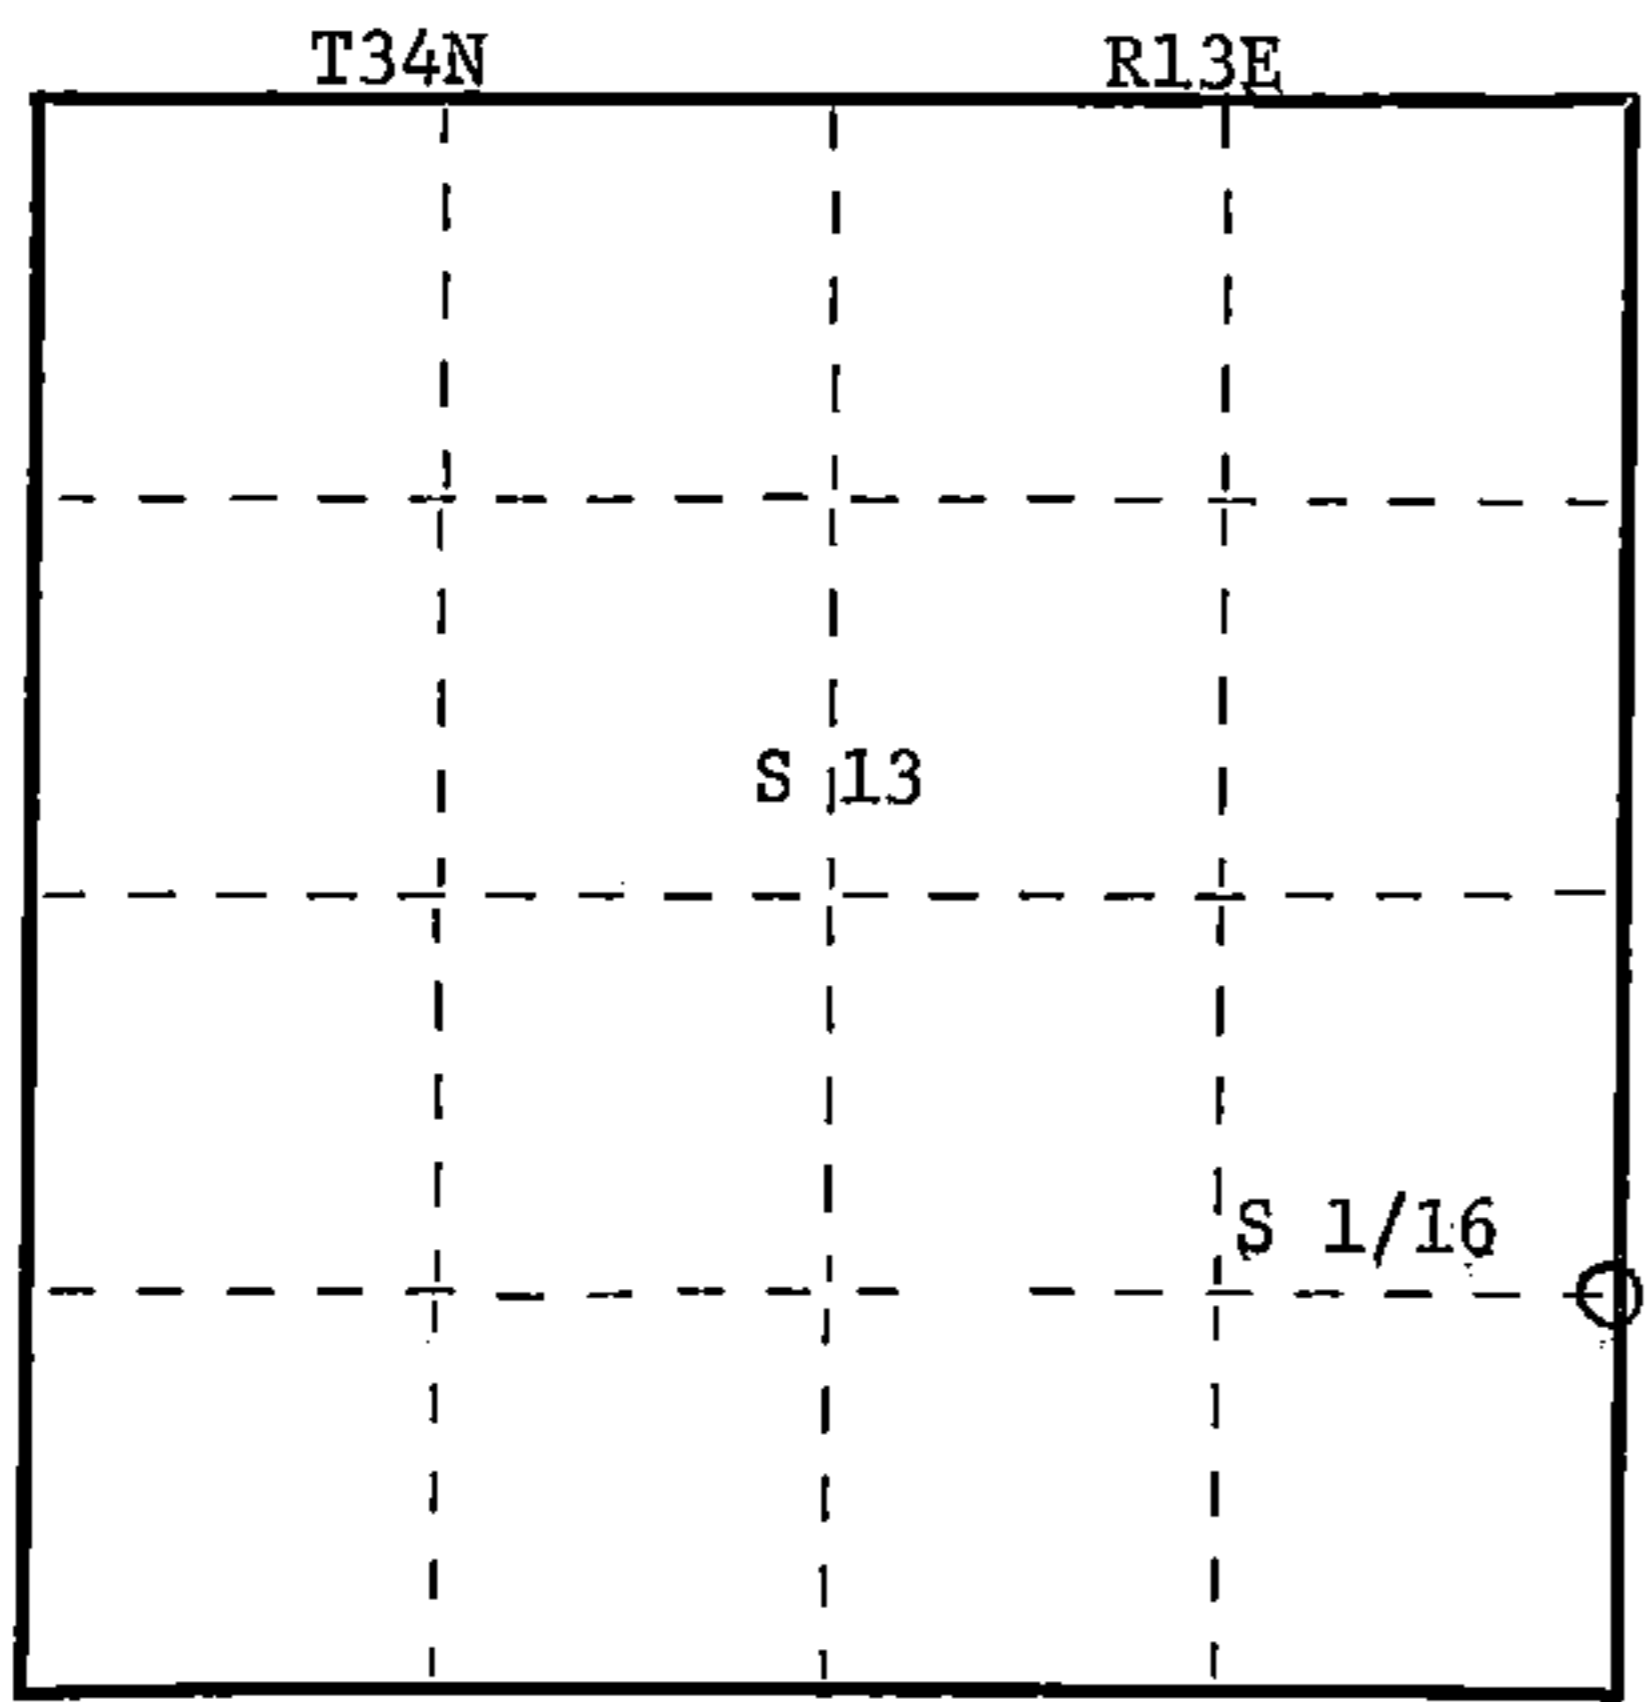

○ = Corner monument restored.

History of original corner establishment:  
No evidence of any previous corner.

Description of corner evidence found:

Total distance from section corner 13-24 & 18-19 T34N R13,14E to 1/4 corner between sections 13 & 18 is 2655.07 ft. at bearing S1-35-36W  
Set S 1/16 1327.54 Intermediate.

Description of monument and accessories I established to perpetuate the original location of this corner.

Set a 1" iron pipe with 2" diameter alloy cap stamped: S1682  
Monument projects 18" above ground. T34N R14E  
Marked NBTs: S 1/16 13 18  
Sugar 5" N14E 25.18 ft. R13E  
Sugar 7" S62E 25.08 ft. CPI - 1982  
Scribed 1/16 - B.T.

43413 131000

Dated at Rhineland, Wis., this 30th day of December, 19 82  
Signature Glen Barker Title Registered Land Surveyor Registration No. S1682  
(County Surveyor, Registered Land Surveyor, or other duly authorized official)

Office of Register of Deeds, County of Forest  
I hereby certify that the within instrument was filed in this office for record on the 16th day of February, 19 83  
at 10:30 o'clock A. M.

Eugene Steatman  
(Register of Deeds)  
By \_\_\_\_\_ Deputy

DOCUMENT NO. **122909**