

State of Wisconsin
County of FOREST

ss. ESTABLISHMENT OF QUARTER - QUARTER SECTION CORNER BETWEEN
ORIGINAL GOVERNMENT SURVEY CORNERS.


I NEAL SPERHAKE, do hereby certify that on the SEVENTH day of OCTOBER,
19 64, I established the SOUTH ONE SIXTEENTH CORNER ON THE NORTH-SOUTH QUARTER LINE OF SECTION
14, TOWNSHIP 34 NORTH, RANGE 13 EAST, Fourth Principal Meridian.
as described hereon.

History: There is no record of this corner having ever been previously established.


Description of monument and accessories I established to perpetuate the location of this corner:

At the point determined for the location of the corner I emplaced a:
GALVANIZED IRON PIPE, THREE FEET LONG, ONE INCH IN DIAMETER, WITH ALUMINUM CAP DENOTED AS,
"KIMBERLY CLARK CORP. T34N S 1/16 OF SEC. 14 R13E SPERHAKE RLS 463 10/7/64."
The pipe is witnessed by:
W. Birch 6 N 71°E 78½ links. (SCRIBED S14 BT).

Description as to how corner was located: The center of the section and the south quarter
section corner of section 14 have been previously established with
a distance between them of 38.24 chains. The south 1/16th. corner
was set 19.12 chains from either corner and on a straight line
between them.

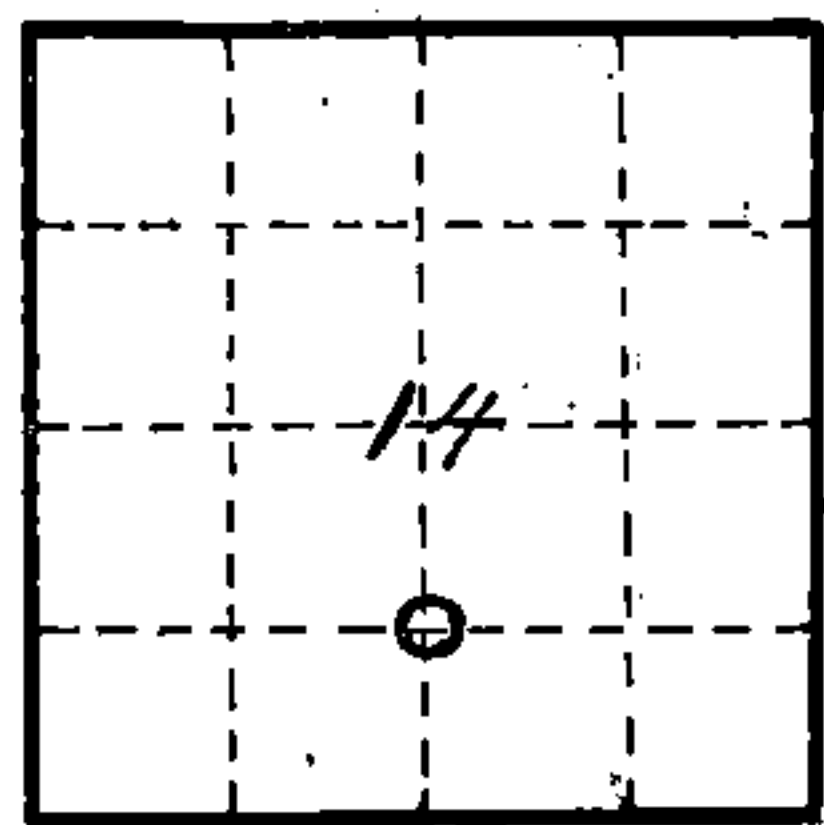

O = Corner monument
restored

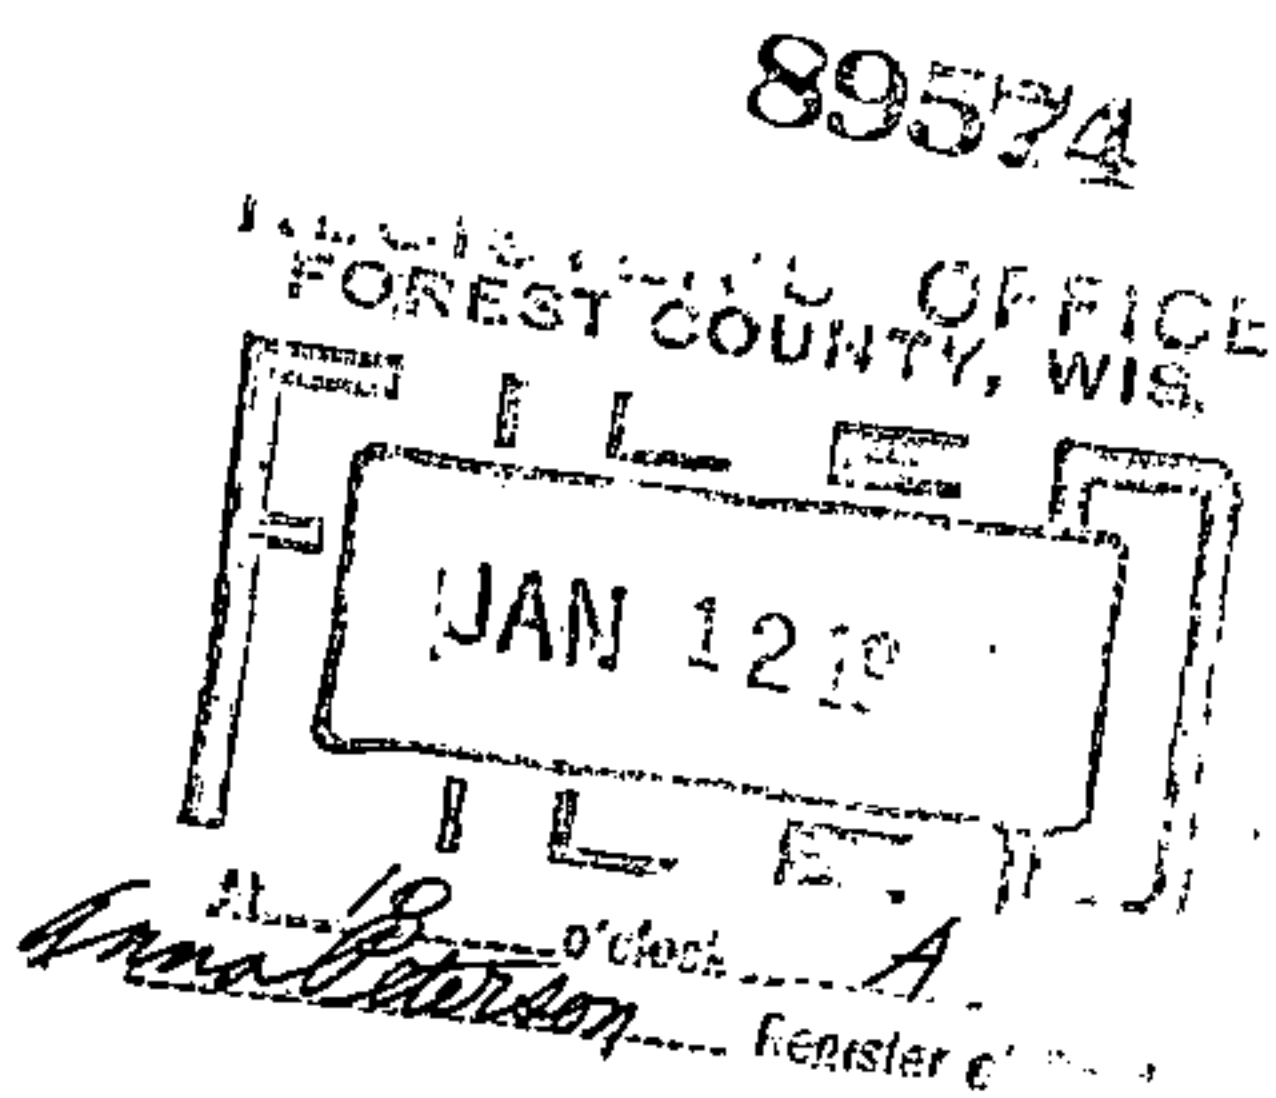

Resident witnesses _____

Dated at Crandon, Wisconsin, this 12
day of January, 19 65.

Signature Neal Sperhake
Title Registered Land Surveyor Registration No. 463

~~Office of~~ County of signed & sworn
I hereby certify that the within instrument was ~~filed in this~~
~~office for record~~ on the 12 day of Jan.
19 65, and was filed in Book No. xxxxxx Page No. xxxxxx
of ~~County Records~~

Surveyor's Seal

Signature Anna Peterson Title Notary Public

43413141010

Index No. M-19
6119