


State of Wisconsin }
County of FOREST } ss.

I NEAL SPERHAKE, do hereby
certify that on the FIFTEENTH day
of NOVEMBER, 1961, I found
evidence of the SOUTHWEST SECTION
corner of SECTION 15
Township 34, North, Range
13 EAST, Fourth Principal Meridian,
as described hereon; and that from this evidence
I established a new monument and accessories
as described hereon to perpetuate the original
location of this corner.

Resident witnesses:

Richard Piontek - Waubesa

David Pichotta - Waubesa

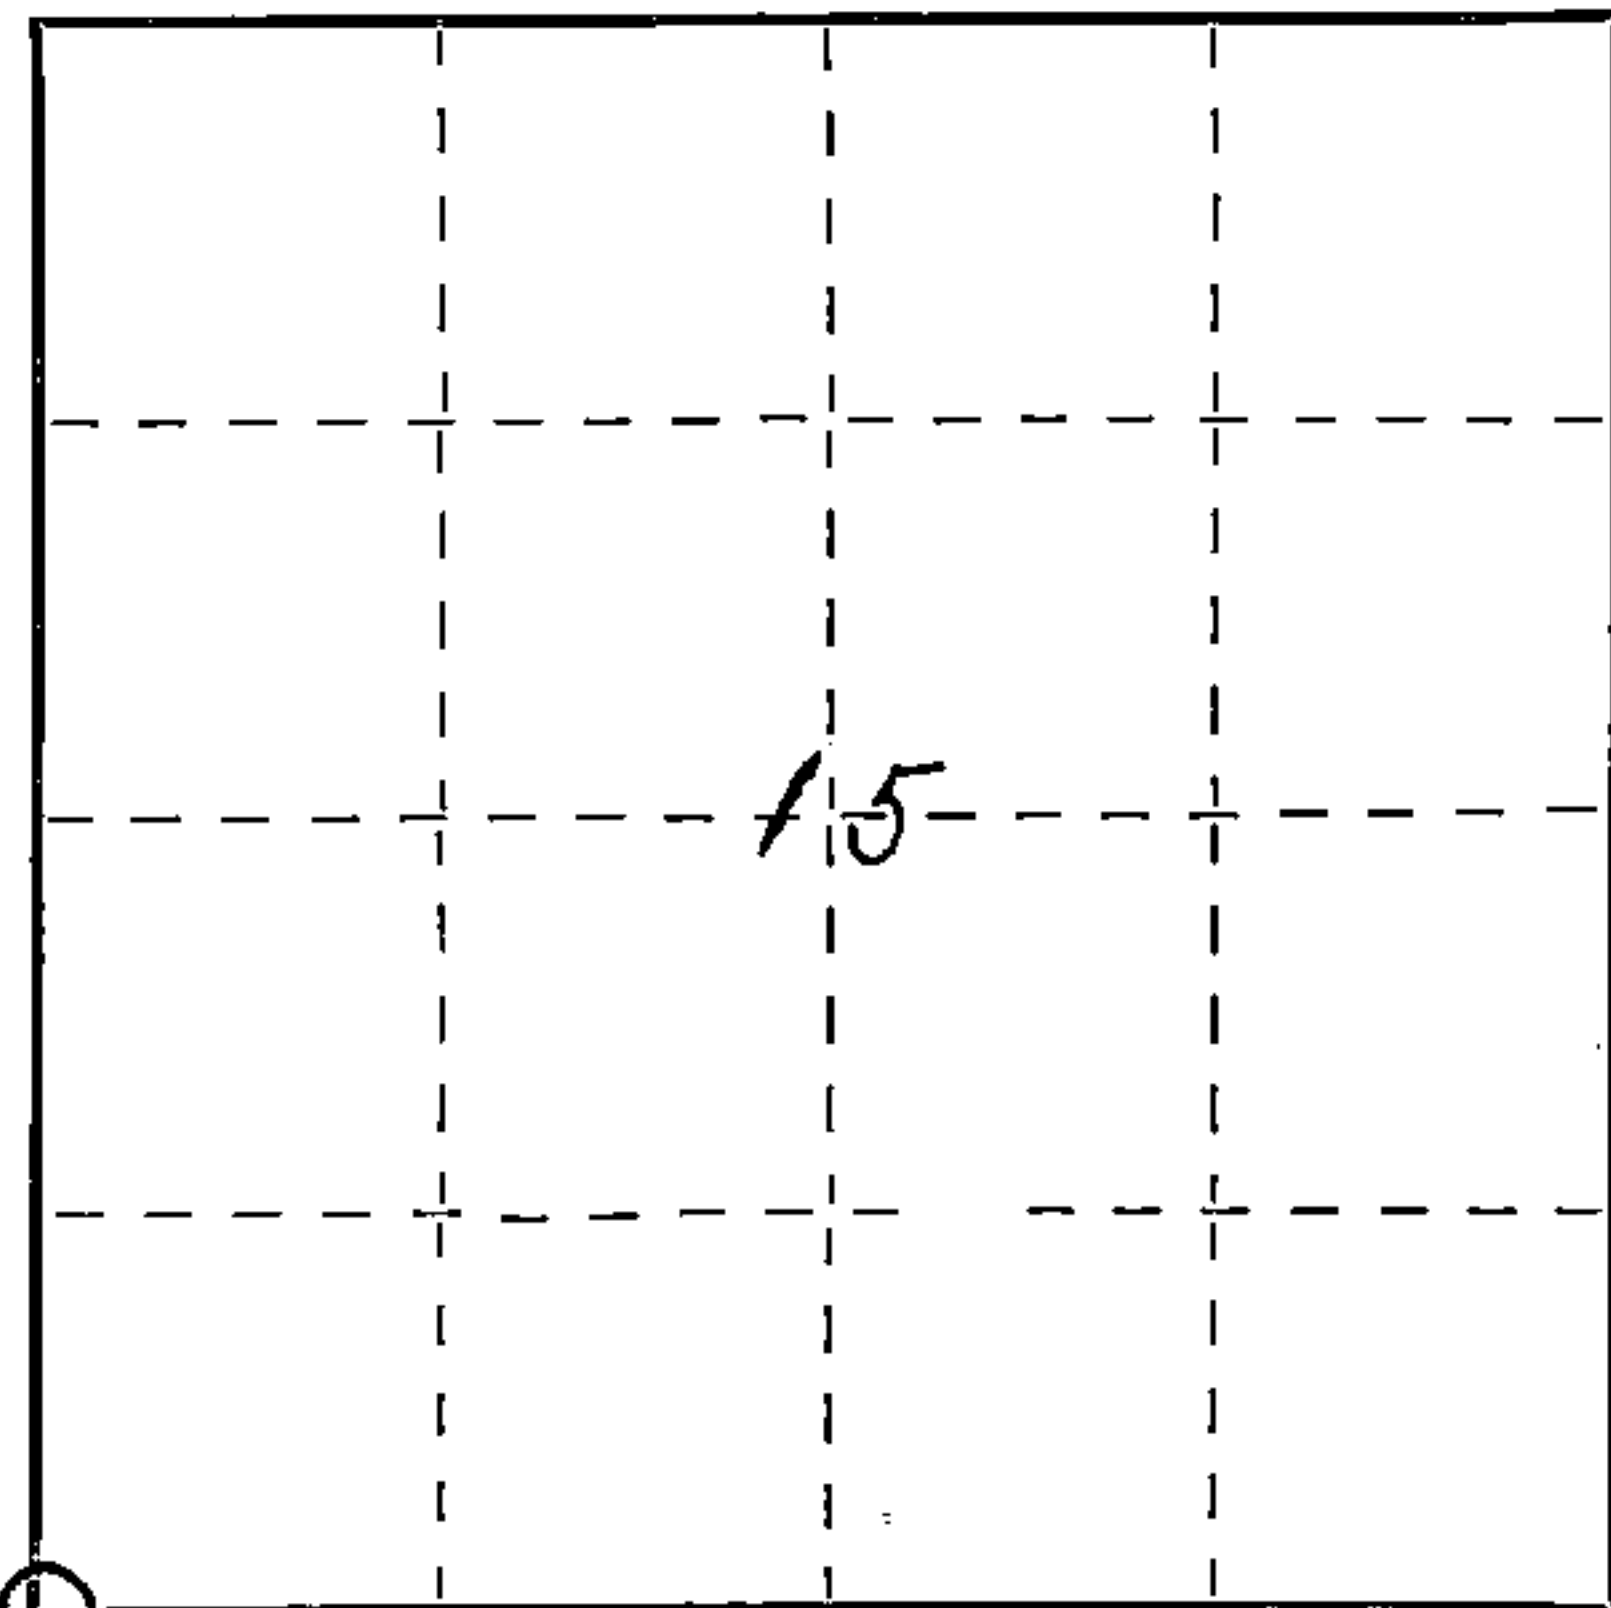

○ = Corner monument restored.

CERTIFIED LAND CORNER RESTORATION

Index No.

N=13

N13

History of original corner establishment:

This corner can also be described as: THE SECTION CORNER COMMON TO SECTIONS
15, 16, 21, 22, T34N-R13E, 4th P.M.

This corner was established during the original survey of this township, as noted
in the Original Field Notes for the Original Survey of T34N-R13E, 4th P.M.

Description of corner evidence found:

The original bearing tree, described in the original field notes as,

"Tamarack 12 N31E 27 links"

is still present at this date, with a portion of the original scribe marks still visible.

Description of monument and accessories I established to perpetuate the original location of this corner.

At the site of this original post, as determined from the existing original bearing
tree noted above, I emplaced a "GALVANIZED IRON PIPE, THREE FEET LONG, ONE INCH IN
DIAMETER, WITH AN ALUMINUM CAP DENOTED AS, 'KIMBERLY-CLARK CORP T34N
15, 16, 21, 22, R13E SPERHAKE RLS 463 11-15-61".

The pipe is witnessed by:

W. Pine 8 N80°E 21 links. (Scribed S15 NBT).
Spruce 6 N41°W 52 links. (Scribed S16 NBT).
Tamarack 2 S55°W 40½ links. (Scribed S21 NBT).
Tamarack 4 S62E 29 links. (Scribed S22 NBT).

Dated at Crandon Wis., this 11th day of Feb., 1963

Signature [Signature] Title Registered Land Surveyor Registration No. S-463
(County Surveyor, Registered Land Surveyor, or other duly authorized official)

Office of Register of Deeds, County of Forest, I hereby certify that the within
instrument was filed in this office for record on the 11th day of Feb., 1963
at 10 o'clock A M.

Anna Peterson 86842
(Register of Deeds)

SUBSCRIBED & SWORN TO BEFORE ME THIS
11TH DAY OF FEB. 1963

Anna Peterson
Notary Public, Forest Co., Wis
Comm. expires 10/31/65

By _____ Deputy

Surveyor's Seal

43413160000