

CERTIFIED LAND CORNER RESTORATION

Index No. N-100

State of Wisconsin }
County of Forest } ss.


History of original corner establishment:
No evidence of any previous corner.

I Glen Barker, do hereby certify that on the 17th day of May, 19 83, I ~~found~~ found evidence of the W 1/16 corner of Sections 16 & 21 Township 34, North, Range 13 East, Fourth Principal Meridian, as described hereon; and that from this evidence I established a new monument and accessories as described hereon to perpetuate the original location of this corner.

Resident witnesses:


J. Claflin - R.

H. Wagoner

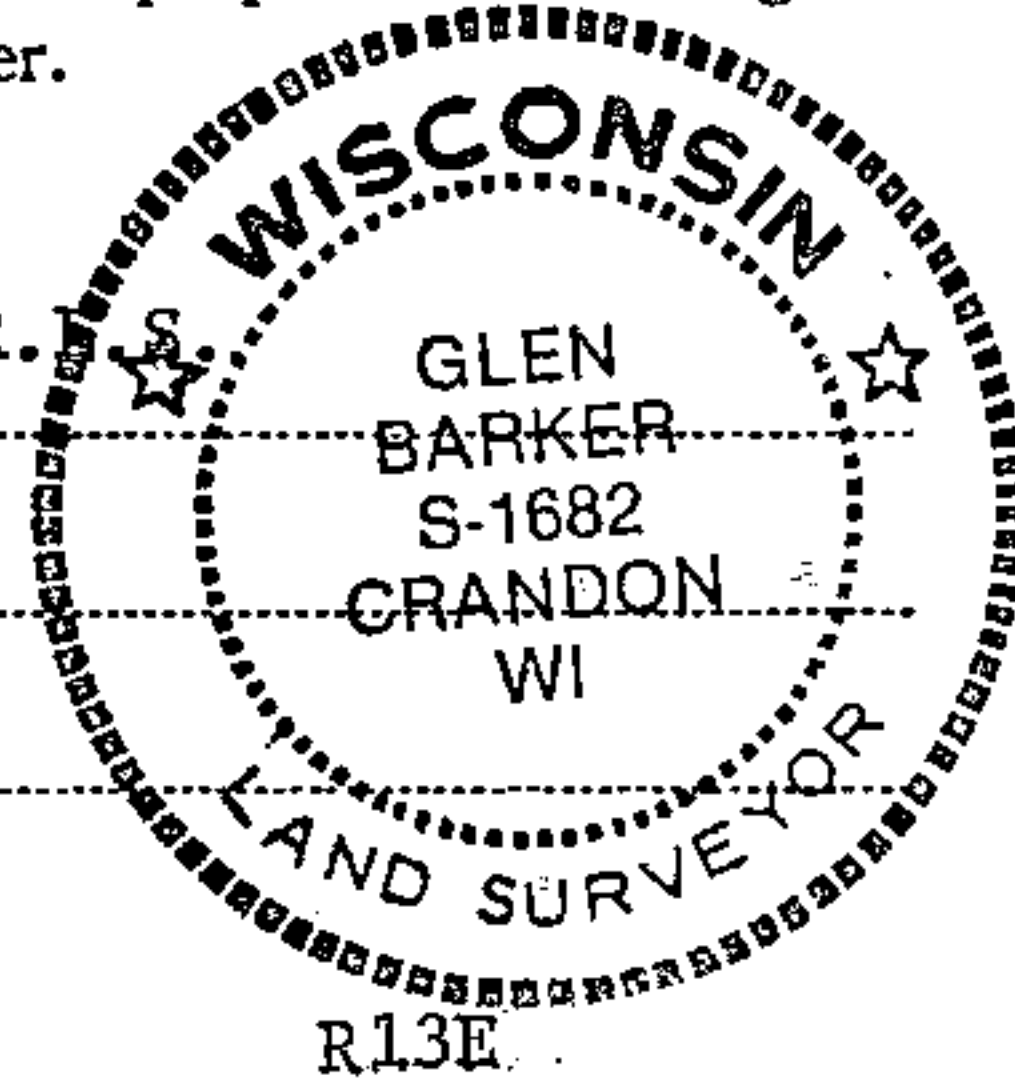

T34N.

R13E.

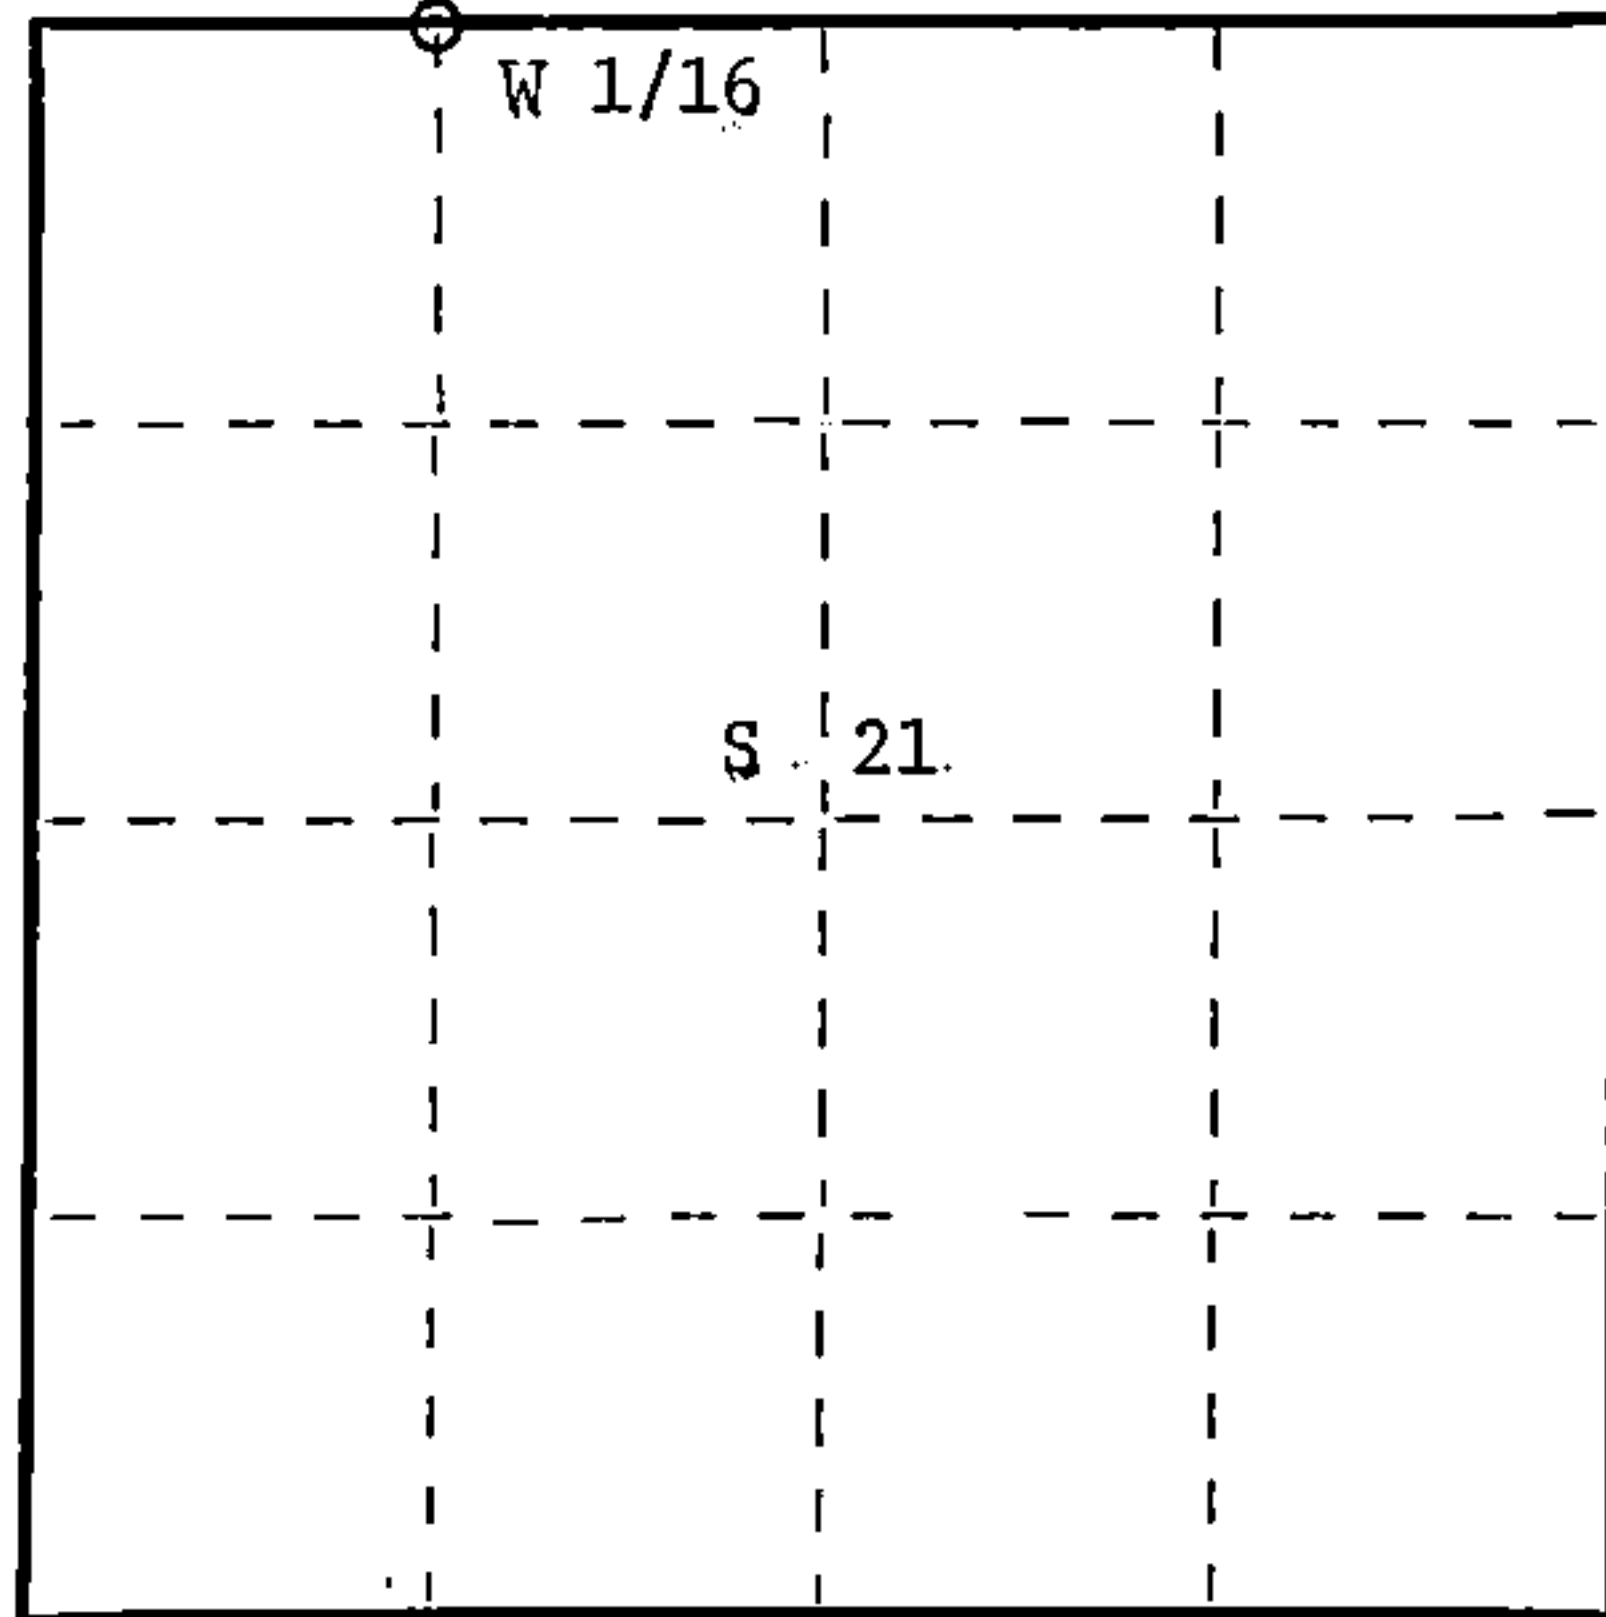

○ = Corner monument restored.

Description of corner evidence found:

Total distance from recovered section corner 16-17-20-21 to previously established 1/4 corner between sections 16 & 21 is 2647.80 ft.
Set W 1/16 1323.90 ft. intermediate.

Description of monument and accessories I established to perpetuate the original location of this corner.

Set a 1" iron pipe with 2" diameter alloy cap stamped:

S1682

Monument projects 18" above ground.

T34N R13E

Marked NBTs

Sugar 6" S38E 31.07 ft.

W 1/16 S 16

Sugar 7" S23W 33.68 ft.

S 21

Scribed 1/16 B.T.

CPI - 1983

Dated at Rhineland, Wis., this 9th day of June, 19 83

Signature Glen Barker Title Registered Land Surveyor Registration No. S1682
(County Surveyor, Registered Land Surveyor, or other duly authorized official)

Office of Register of Deeds, County of Forest, I hereby certify that the within instrument was filed in this office for record on the 15th day of June, 19 83 at 2:00 o'clock P. M.

Eugene Staszny
(Register of Deeds)
By..... Deputy

DOCUMENT NO. **123605**

Stock No. 26272

McMillan Company

FORM 985

43413160030