

State of Wisconsin

County of FOREST

ss. RESTORATION OF LOST ORIGINAL GOVERNMENT SURVEY CORNER.

I NEAL SPERHAKE, do hereby certify that on the FIFTEENTH day of NOVEMBER, 19 63, I established the NORTHWEST SECTION CORNER OF SECTION 26, TOWNSHIP 34 NORTH, RANGE 13 EAST, Fourth Principal Meridian, as described hereon.

History: This corner was established during the original survey of this township, as noted in the original field notes for the original survey of T34N-R13E, 4th. p.m.

Description of monument and accessories I established to perpetuate the location of this corner:


At the point determined for the location of the corner I emplaced a:

GALVANIZED IRON PIPE, THREE FEET LONG, ONE INCH IN DIAMETER, WITH ALUMINUM CAP DENOTED AS, "KIMBERLY-CLARK CORP. T34N 22, 23, 26, 27 R13E. SPERHAKE RLS 463 11/15/63."

The pipe is witnessed by:

- W. Birch 4 N 60°W 12½ links. (SCRIBED S22 NBT).
- W. Birch 7 N 20°E 208 links. (SCRIBED S23 NBT).
- W. Pine 15 S 11°E 70 links. (SCRIBED S26 NBT).
- W. Birch 4 S 40°W 14 links. (SCRIBED S27 NBT).

Description as to how corner was located: A fence running north between 26 and 27 junctions with a fence running east between 23 and 26. This point is 85.88 chains north of the corner of 26, 27, 34, 35, and 78.69 chains south of the corner of 14, 15, 22, 23 and 39.60 chains west of the quarter section corner between 23 and 26, and 81.53 chains east of the corner of 21, 22, 27, 28. Judging from the chainages the fence corner would not be marking the section corner of 22, 23, 26, 27. However, the original survey was so erratic in this area that proportionate measurement cannot be used. Of importance to note is the fact that at this junction this fence is extremely well constructed, and very straight. In addition, a pine with a scarred face, though too badly burned to positively identify as a bearing tree, does lie in the exact position of a bearing tree noted in the original field notes as "W. Pine 18 N 60°E 25". The other tree was a "W. Pine 22 S 8°E 20". At exactly this bearing and distance from the fence junction is a large depression in the ground typical of those often formed when a large tree blows over and the roots pull up out of the ground. The rest of the form of the tree is identifiable where it fell onto the ground. It is too badly decomposed to identify scars on it. I feel that it is not coincidence that such a well constructed fence would be built several chains away from the section lines, and that two trees, comparable to the original bearing trees, would also be in just a coincidental position as denoted from the original field notes. I believe the fence junction marks the site of the original corner, and the fact that the fence was built over thirty years ago provides the probability that at least one of the original bearing trees was decipherable at that time.

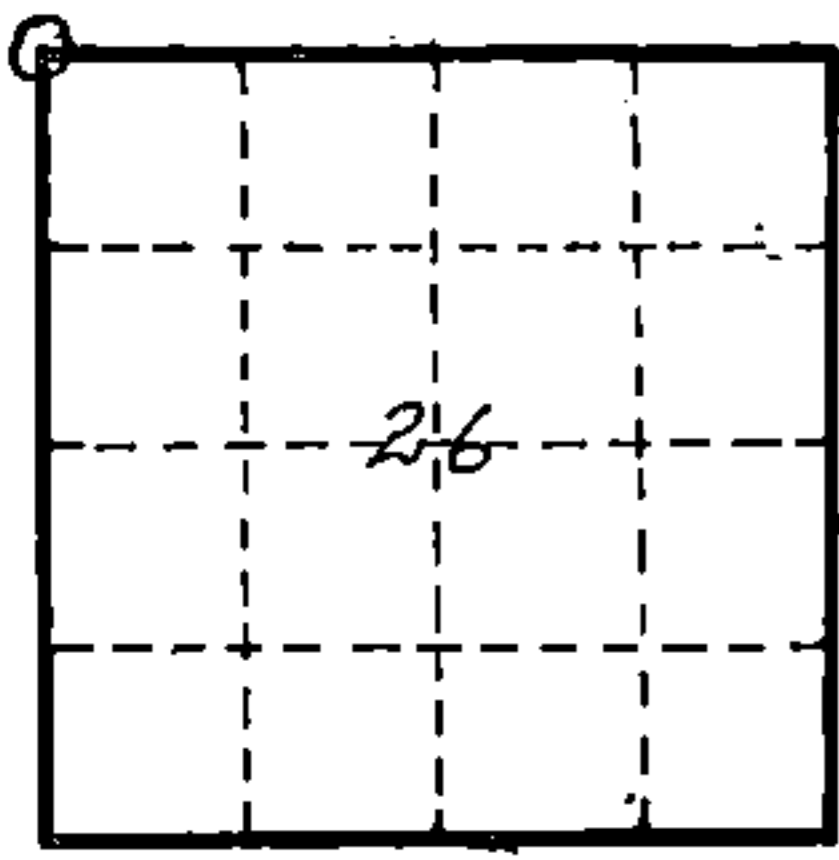

O = Corner monument restored

Subscribed & sworn to before me
 this 25 day of Aug 1964
Anna Peterson
 NOTARY PUBLIC, FOREST CO., WIS
 COM. EXPIRES 10/31/65

Resident witnesses _____

Dated at Grandon, Wisconsin, this 25 day of Aug, 19 64.

Signature *Neal Sperhake*

Title Registered Land Surveyor Registration No. 463

Office of Reg. of Deeds County of Forest

I hereby certify that the within instrument was filed in this office for record on the 25 day of Aug 19 64, and was filed in Book No. _____ Page No. _____ of County Records.

Signature *Anna Peterson* Title Reg. of Deeds

43413 220000

88987

Index No:

R-17
R17

Surveyor's Seal