

State of Wisconsin

County of FOREST

ss. RESTORATION OF LOST ORIGINAL GOVERNMENT SURVEY CORNER.

I NEAL SPERHAKE, do hereby certify that on the FIFTEENTH day of NOVEMBER, 1963, I established the WEST QUARTER SECTION CORNER OF SECTION 23, TOWNSHIP 34 NORTH, RANGE 13 EAST, Fourth Principal Meridian,

as described hereon.

History: This corner was established during the original survey of this township, as noted in the original field notes for the original survey of T34N-R13E, 4th. p.m.

Description of monument and accessories I established to perpetuate the location of this corner:


At the point determined for the location of the corner I emplaced a:

GALVANIZED IRON PIPE, THREE FEET LONG, ONE INCH IN DIAMETER, WITH ALUMINUM CAP DENOTED AS, "KIMBERLY-CLARK CORP. T34N 1/4 BTWN. 22 & 23 R13E SPERHAKE RLS 463 11/15/63."

The pipe is witnessed by:

- W. Birch 9 S 34°W 35 1/2 links. (SCRIBED 1/4 S 22 NBT).
- W. Birch 6 S 53°E 5 links. (SCRIBED 1/4 S 23 NBT).

Description as to how corner was located: No evidence of original corner present. Thus, set by proportionate measurement. The section corner 1/2 mile south and the witness corner to the section corner 1/2 mile north have been previously established with a distance of 78.69 chains between them. Thus, set the quarter corner 39.34 1/2 chains from either corner and on a straight line between them.

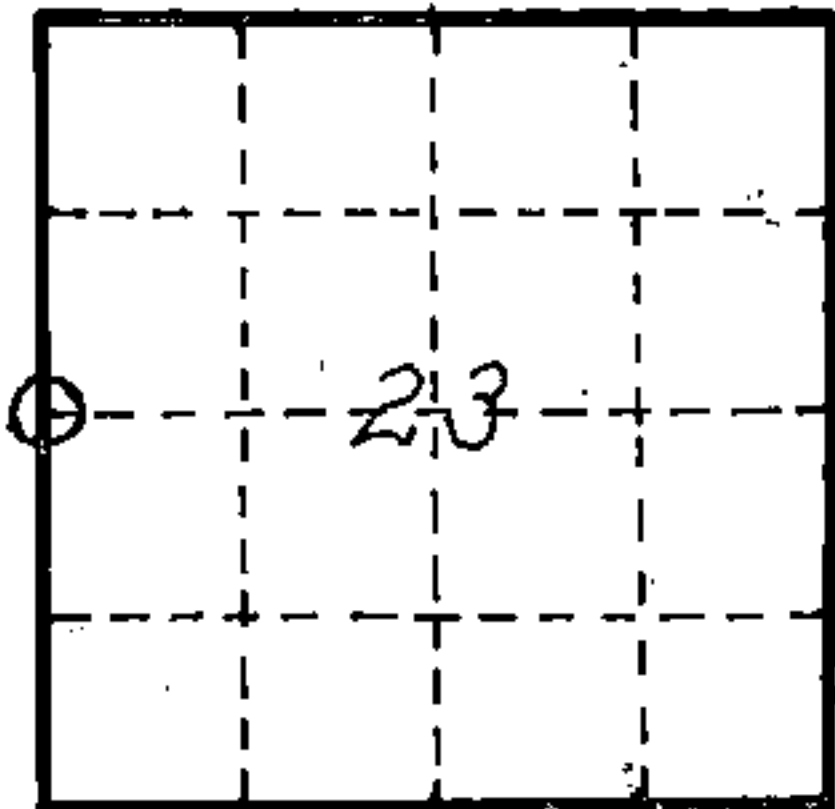

○ = Corner monument restored

Subscribed & sworn to before me this 25 day of Aug 1964

Anna Peterson  
NOTARY PUBLIC, FOREST CO., WIS  
COM. EXPIRES 10/31/65

88989

Resident witnesses \_\_\_\_\_

Dated at Crandon, Wisconsin, this 25 day of Aug, 1964.

Signature Neal Sperhake

Title Registered Land Surveyor Registration No. 463

Office of Reg. of Deeds County of Forest

I hereby certify that the within instrument was filed in this office for record on the 25 day of Aug 1964, and was filed in Book No. \_\_\_\_\_ Page No. \_\_\_\_\_ of County Records.

Surveyor's Seal

Signature Anna Peterson Title Reg. of Deeds

43413222000

Index No.

P-17  
P-17