

State of Wisconsin

County of FOREST

} ss. RESTORATION OF LOST ORIGINAL GOVERNMENT SURVEY CORNER.

I NEAL SPERHAKE, do hereby certify that on the THIRTY-FIRST day of OCTOBER, 19 63, I established the NORTHWEST SECTION CORNER OF SECTION 25, TOWNSHIP 34 NORTH, RANGE 13 EAST, Fourth Principal Meridian, as described hereon.

History: This corner was established during the original survey of this township, as noted in the original field notes for the original survey of T34N-R13E, 4th. p.m.

Description of monument and accessories I established to perpetuate the location of this corner:


At the point determined for the location of the corner I emplaced a:

GALVANIZED IRON PIPE, THREE FEET LONG, ONE INCH IN DIAMETER, WITH ALUMINUM CAP DENOTED AS, "KIMBERLY-CLARK CORP. T34N 24, 23, 25, 26 R13E SPERHAKE RLS 463 10/31/63."

The pipe is witnessed by:

- Maple 16 N 22°W 72 links. (SCRIBED S 23 NBT).
- Hemlock 22 N 88°E 42 links. (SCRIBED S 24 NBT).
- Elm 8 S 34°W 91 links. (SCRIBED S 26 NBT).

Description as to how corner was located: No evidence of the original corner present. The east-west position: The Soo Line Railroad survey map shows the location of the section corner to be 150 feet east of the center line of the railroad track. Mr. C. E. Jones, a 91 year old resident of Antigo, Wisconsin, operated a logging company in this area around 1900. He recalls the corner was in at that time and showed us, as best as he could recall, approximately where the corner was set, which was within a 25 foot radius of where the railroad survey map denotes it. There is an old blazed line running east and west from the spot that Jones claims was the corner. Therefore, I have accepted the old blazed line as marking the north-south position of the corner and the railroad map figure as marking the east-west position of the corner. Thus, I set the corner 150 feet east of the center line of the railroad track and on an east-west blazed line. It is 79.82 chains north to the corner of 13, 14, 23, 24; 79.07 chains east to the corner of sections 24 and 25 on the range line; 80.41 chains south to the corner of 25, 26, 35, 36 and 39.27 chains west to the quarter corner between sections 23 and 26.

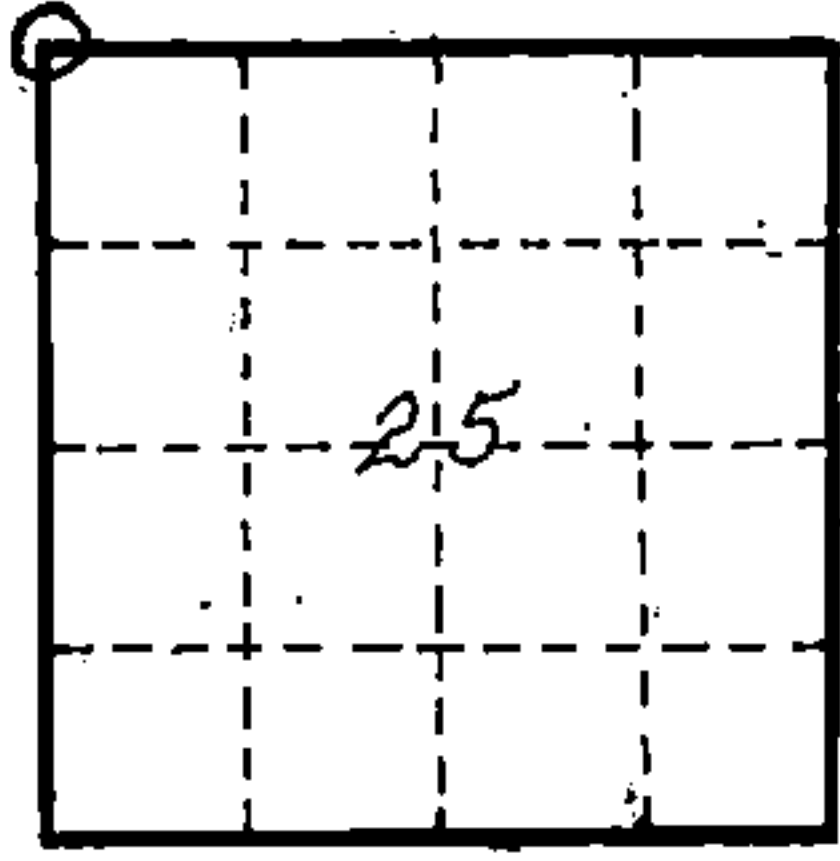

0 = Corner monument restored

Subscribed & sworn to before me this 25 day of Aug 1964

Anna Peterson  
 NOTARY PUBLIC, FOREST CO., WIS  
 COM. EXPIRES 10/31/65

Resident witnesses \_\_\_\_\_

Dated at Crandon, Wisconsin, this 25 day of Aug, 19 64.

Signature Neal Sperhake

Title Registered Land Surveyor Registration No. 463

Office of Reg. of Deeds County of Forest

I hereby certify that the within instrument was filed in this office for record on the 25 day of Aug 19 64, and was filed in Book No. \_\_\_\_\_ Page No. \_\_\_\_\_ of County Records.

Surveyor's Seal

Signature Anna Peterson Title Reg. of Deeds

43413 230000

88982

Index No.

P-21  
R-21