


86978

STATE OF WISCONSIN

I NEAL SPERHAKE, do hereby certify that on the FIFTEENTH day of NOVEMBER, 1962, I restored the SOUTHEAST SECTION CORNER of SECTION 24, TOWNSHIP 34 NORTH, RANGE 13 EAST, Fourth Principal Meridian, as described hereon.


Resident Witnesses:

Richard Piontek - Waubesa
David Pichotta - Waubesa

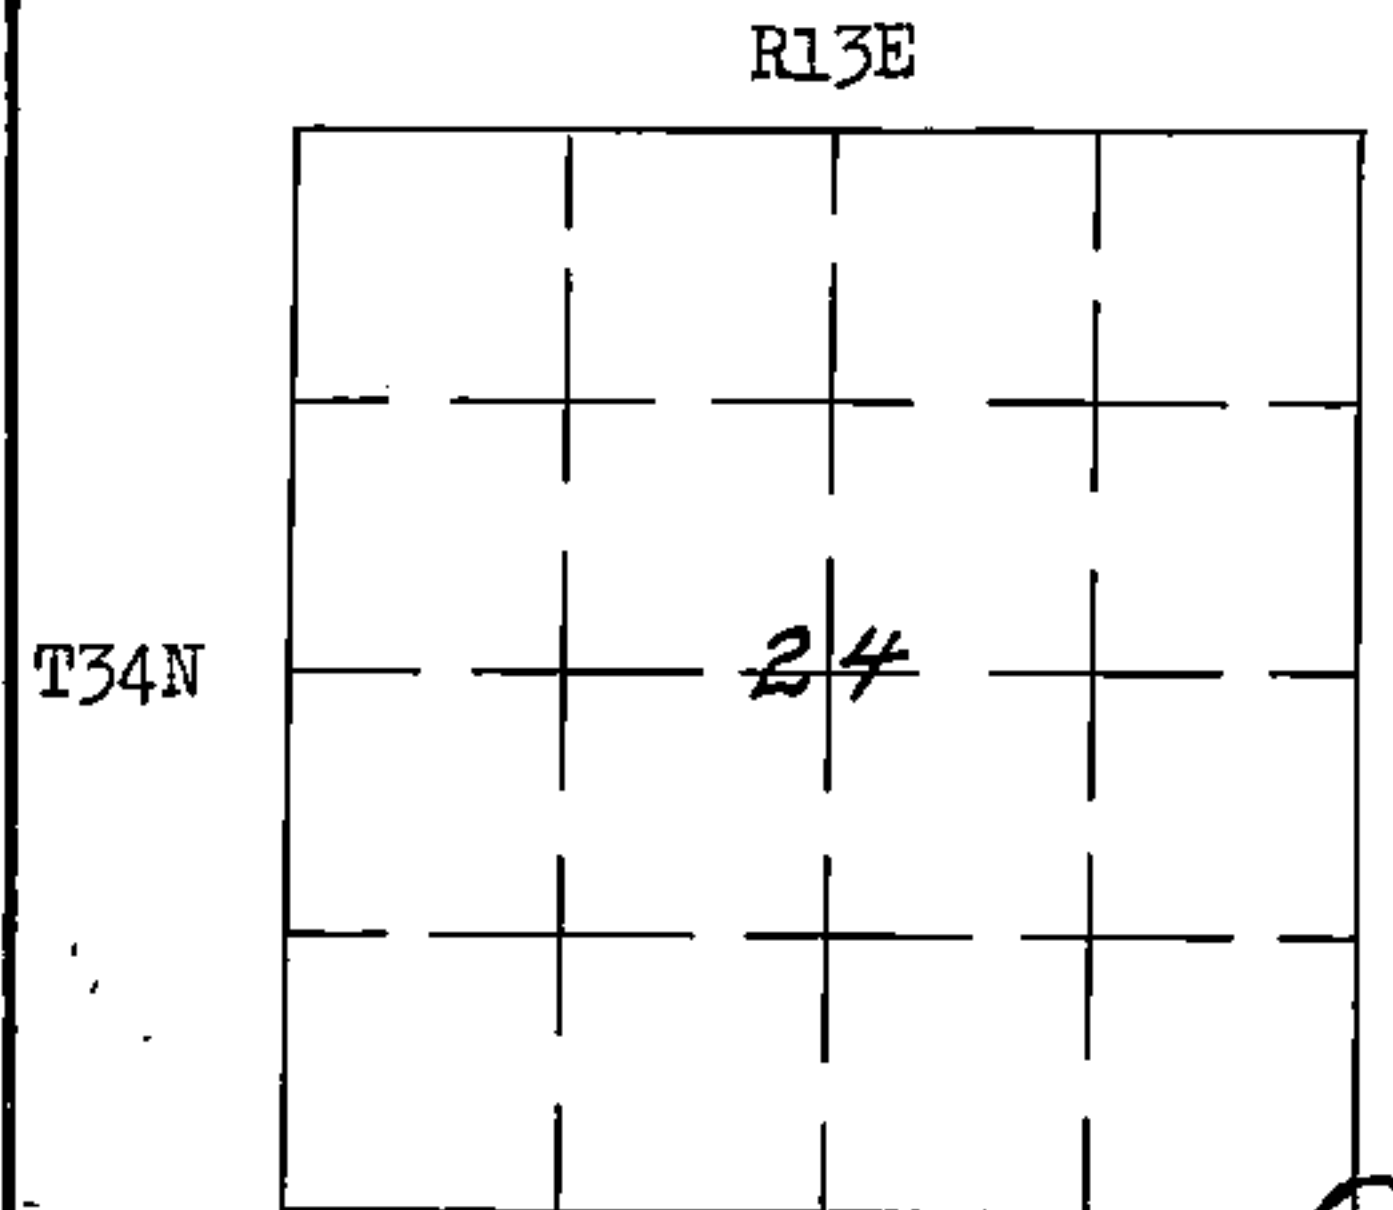

O = Corner Monument Restored

REGISTER'S OFFICE
FOREST COUNTY, WIS.

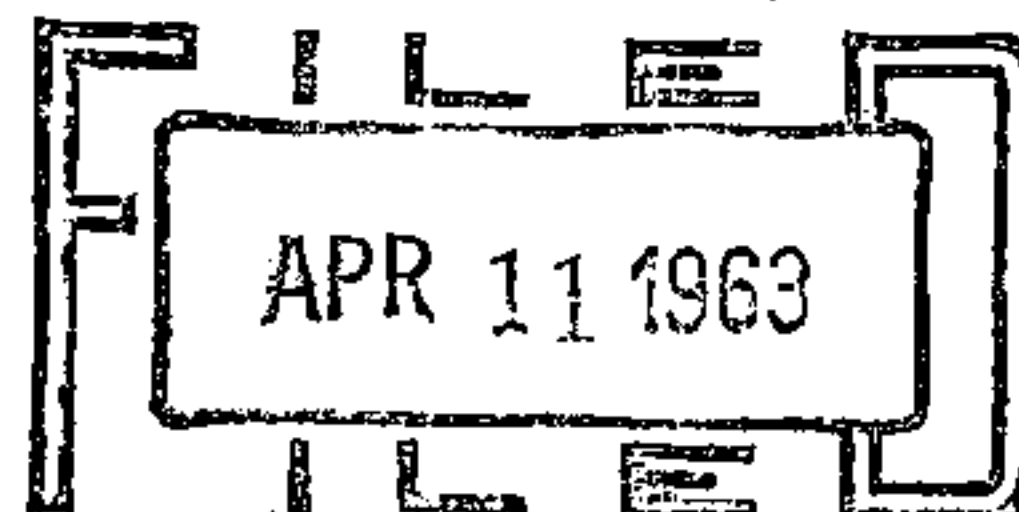

At 2 o'clock P. M.
Karl A. Unger Register of Deeds

RESTORATION OF LOST ORIGINAL GOVERNMENT SURVEY CORNER

Index No.

R-25
R25

History of original corner establishment:

This corner can also be described as: THE SECTION CORNER COMMON TO SECTIONS 24 AND 25, T34N-R13E, AND, 19 AND 30, T34N-R14E, 4TH. P.M.

This corner was established during the original survey of this township, as noted in the Original Field Notes for the Original Survey of T34N-R13E, 4th p.m.

Description of monument and accessories I established to perpetuate the location of this corner.

At the point determined for the location of the corner I emplaced a:

"GALVANIZED IRON PIPE, THREE FEET LONG, ONE INCH IN DIAMETER, WITH AN ALUMINUM CAP DENOTED AS, 'KIMBERLY-CLARK CORP T34N 24, 25, 19, 30, R13-14E SPERHAKE RLS 463 11-15-62".

The pipe is witnessed by:

Elm 5 N30°W 21 links. (Scribed S24 NBT).
 Elm 7 N12°E 13½ links. (Scribed S19 NBT).
 Maple 5 S46°E 8½ links. (Scribed S30 NBT).
 Elm 5 S64°W 23 links. (Scribed S25 NBT).

Description as to how corner was located:

No evidence of original corner present. Thus, set by proportionate measurement between the previously established corner of 13, 24, 18, 19, and the town corner of 34-13, 34-14, 33-13 and 33-14, (or, the corner of sections 36, 31, 1, 6). The distance between these corners is 240.75 chains. Thus, I set the corner of 24, 25, 19, 30, 160.50 chains north of the township corner, and on a straight line between the known corners.

Dated at Crandon, Wis., the 11th day of April, 19 63Signature Neal Sperhake Title Registered Land Surveyor Registration No. S-463

~~Notary of Forest County, Wis.~~ County of Forest, I hereby certify that the within

instrument was ~~signed and sworn to~~ signed and sworn to on the 11th day of April, 19 63

at xxxblock xx

Adeline De Noble
 Notary ~~(Register of Deeds)~~ Public
 Forest County, Wisconsin My Commission Expires

By My commission expires February 6, 1966 ~~Deputy~~

Surveyor's Seal

SRS AT T34 R14

43413240000


U. S. PUBLIC LAND SURVEY MONUMENT RECORD

INSTRUCTIONS: This record shall show the location of the corner and shall include all of the following nine elements (a through i).

- (a) Identify the corner by reference to the U.S. public land survey system.

○ = Corner monument restored.

Section corner common to Sections 19 and 30, T.34N., R.14E., and Sections 24 and 25, T.34N., R.13E.

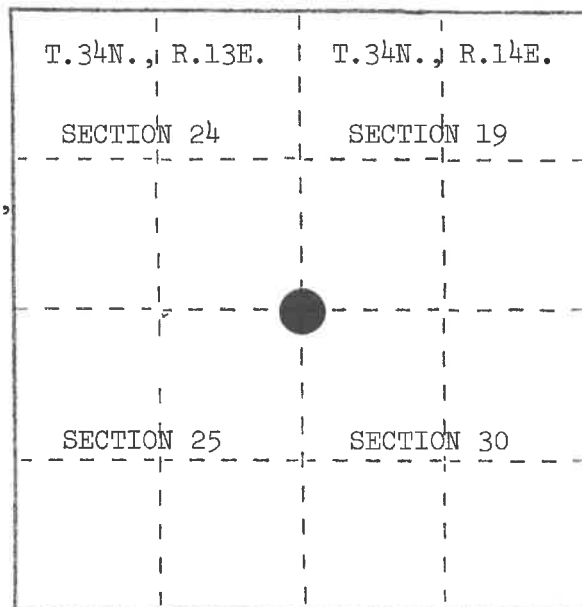


- (b) Describe any record evidence, monument evidence, occupational evidence, testimonial evidence or any other material evidence you considered, and whether the monument was found or placed.

Found fallen post and post point supported by remains of the original bearing trees from Alfred Millard's survey of 1857.

- (c) In the plan view drawing below, provide reference ties to at least 4 witness monuments, or, if the location is within a municipality, to at least 2 witness monuments. (Witness monuments shall be made of concrete, natural stone, iron or other equally durable material.) Describe witness monuments.

- (d) Show a plan view drawing depicting the relevant monuments and reference ties which is sufficient in detail to enable accurate relocation of the corner monument if the corner monument is disturbed. Indicate north.

1. Sugar Maple, 6", N.60°E., 9.41 feet
2. Sugar Maple, 6", S.60°E., 9.66 feet
3. Sugar Maple, 6", S.50°W., 22.27 feet
4. Sugar Maple, 8", N.80°W., 16.55 feet
5. Steel Sign Post, North, 2.80 feet
6. Kimberly Clark Monument, N.81°24'33"E., 72.80 feet

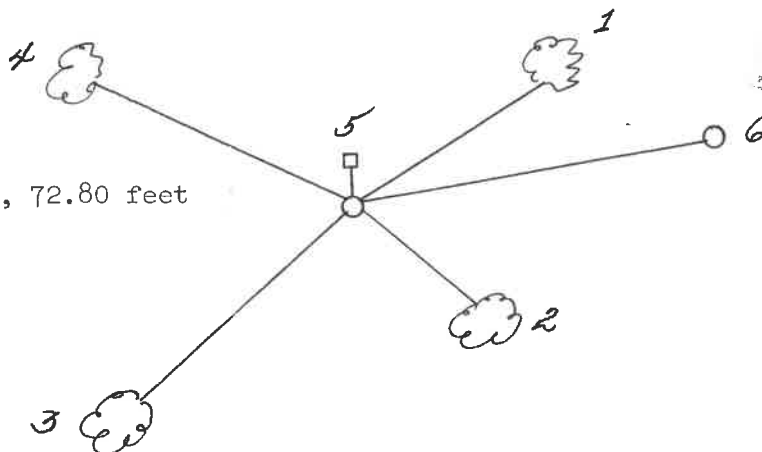

REGISTER'S OFFICE }
Forest County, Wis. }

Received for record this...16th...day
of...January...A.D., 1985 at
...2:30...o'clock...P....M. and

recorded in Vol...CORNER RESTORATIONS
on page R-1...

Paul Aschenbrenner
REGISTER

43413240000

ALSO SEE R25 T34 R13

R-1

R-1

- (e) Describe any material discrepancy between the location of the corner as restored or reestablished and the location of that corner as previously restored or reestablished by distance and direction. Show the discrepancy on the plan view drawing under (d), above. Show the distances between the corner as previously restored or reestablished and (1) the corner as restored or reestablished, and (2) to at least 2 of the witness monuments shown on the drawing in (d), above.

This corner is restored from the remains of the original bearing trees of Alfred Millard's survey of 1857. Neal Sperhake's monument bears N.81°24'33"E., 72.80 feet.

- (f) Was the corner restored through acceptance of (1) an obliterated evidence location, or, (2) a found perpetuated location?

An obliterated evidence location.

- (g&h) Was the corner reestablished through lost corner proportionate methods? If so, show the method, including the directions and distances to other public land survey corners used as evidence or used for proportioning in determining the corner location?

- (i) I, Milo E. Stefan
(type or print name) certify that the corner location shown on this record was determined by me or under my direction and control and that this U.S. Public Land Survey Monument Record is correct and complete to the best of my knowledge and belief.

Milo E. Stefan
Signature

3/21/84
Date

