

State of Wisconsin

County of FOREST

ss. RESTORATION OF LOST ORIGINAL GOVERNMENT SURVEY CORNER.

I NEAL SPERHAKE, do hereby certify that on the EIGHTEENTH day of NOVEMBER, 1963, I established the NORTHWEST SECTION CORNER OF SECTION 36, TOWNSHIP 34 NORTH, RANGE 13 EAST, Fourth Principal Meridian, as described hereon.

History: This corner was established during the original survey of this township, as noted in the original field notes for the original survey of T34N-R13E, 4th. p.m.

Description of monument and accessories I established to perpetuate the location of this corner:


At the point determined for the location of the corner I emplaced a:

GALVANIZED IRON PIPE, THREE FEET LONG, ONE INCH IN DIAMETER, WITH ALUMINUM CAP DENOTED AS, "KIMBERLY CLARK CORP. T34N 25, 26, 35, 36 R13E WC - Corner is North 25 Feet - WC."

The pipe is witnessed by:

- Elm 6 N 21°W 98½ links. (SCRIBED S 26 WC BT).
- Elm 5 N 34°E 102 links. (SCRIBED S 25 WC BT).
- Aspen 4 S 50°W 63 links. (SCRIBED S 35 WC BT).
- Basswood 7 S 53°E 51½ links. (SCRIBED S 36 WC BT).

Description as to how corner was located: No evidence of the original corner is present. The county highway DD at this point is considered by the local people to straddle the east-west section line. The Soo Line Railroad Survey map, which has proved accurate with relation to all of the section and quarter section corners north of this point up to the town line, also shows the county highway center line as being the section line. I have, therefore, accepted the center line of county highway DD as marking the north-south position of the section corner of 25, 26, 35, 36. For east-west position: The Soo Line Railroad Survey map shows the section corner as being 220 feet west of the center line of the railroad track. 227 feet west of the centerline of the track is a north-south fence that comes up from the quarter section corner between 35 and 36. The local residents have always used this fence line as the section line between 35 and 36. Since there is only this seven foot difference between the map and the fence, I have accepted the fence as denoting the east-west position of the line between sections 35 and 36. I have set a witness corner to the section corner 25 feet south of the center line of the county highway, on the north-south fence line, and 227 feet west of the center line of the railroad track. Thus, the corner of 25, 26, 35, 36 is 79.56 chains west of the range line corner of 25 and 36, and 40.04 chains north of the quarter section corner between 35 and 36.

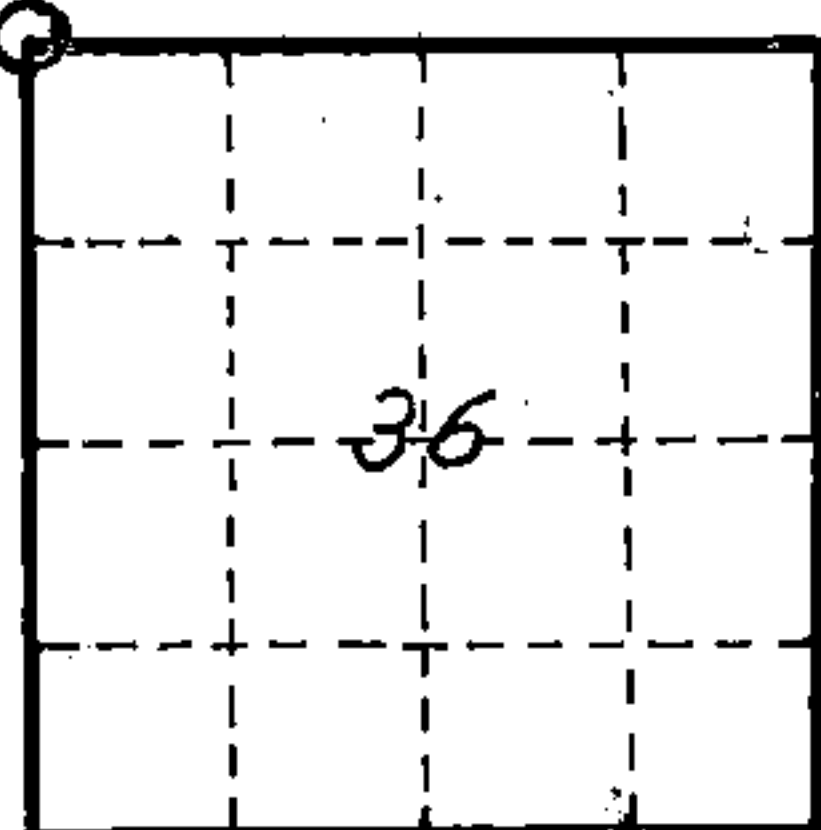

O = Corner monument restored

Subscribed & sworn to before me
 this 25 day of Aug 1964
Anna Peterson
 NOTARY PUBLIC, FOREST CO., WIS
 COM. EXPIRES 10/31/65

Resident witnesses _____

Dated at Crandon, Wisconsin, this 25 day of Aug., 1964.

Signature *Neal Sperhake*

Title Registered Land Surveyor Registration No. 463

Office of Reg. of Deeds County of Forest

I hereby certify that the within instrument was filed in this office for record on the 25 day of Aug 1964, and was filed in Book No. _____ Page No. _____ of County Records.

Signature *Anna Peterson* Title Reg. of Deeds

43413260000

88997

Index No.

V-21
127

Surveyor's Seal