

State of Wisconsin

County of FOREST

ss. RESTORATION OF LOST ORIGINAL GOVERNMENT SURVEY CORNER.

I NEAL SPERHAKE, do hereby certify that on the TWENTY-SECOND day of OCTOBER, 19 63, I established the NORTHWEST SECTION CORNER OF SECTION 34, TOWNSHIP 34 NORTH, RANGE 13 EAST, Fourth Principal Meridian, as described hereon.

History: This corner was established during the original survey of this township, as noted in the original field notes for the original survey of T34N-R13E, 4th. p.m.

Description of monument and accessories I established to perpetuate the location of this corner:


At the point determined for the location of the corner I emplaced a:

GALVANIZED IRON PIPE, THREE FEET LONG, ONE INCH IN DIAMETER, WITH ALUMINUM CAP DENOTED AS, "KIMBERLY CLARK CORP. T34N 27, 28, 33, 34 R13E SPERHAKE RLS 463 10/22/63."

The pipe is witnessed by:

- W. Birch 7 N 68°E 99 links. (SCRIBED S 27 NBT).
- B. Cherry 5 N 34°W 119 links. (SCRIBED S 28 NBT).
- W. Birch 6 S 72°W 36½ links. (SCRIBED S 33 NBT).
- W. Birch 4 S 37°E 42½ links. (SCRIBED S 34 NBT).

Description as to how corner was located: No evidence of original corner present. Thus, set by proportionate measurement. For North-South position: The quarter corner ½ mile south has been previously established and the section corner one mile north has been previously established with a distance of 120.41 chains between them. For East-West position: The quarter corner ½ mile east and the meander corner on the shore of Pickeral Lake have been previously established with a distance of 134.79 chains between them. Thus, set the section corner by double proportionate measurement 40.14 chains north of the quarter corner between sections 33 and 34 and 39.79 chains west of the quarter corner between sections 27 and 34.

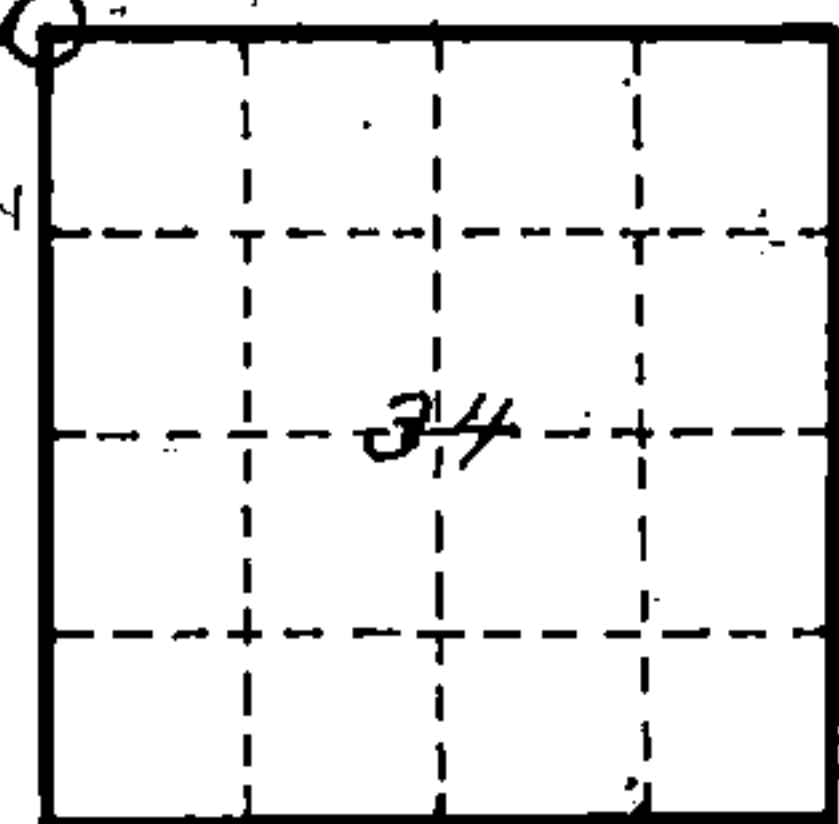

O = Corner monument restored

Subscribed & sworn to before me this 25 day Aug. 1964

Anna Peterson

NOTARY PUBLIC, FOREST CO., WIS
COM. EXPIRES 10/31/65

89003

Resident witnesses _____

Dated at Crandon, Wisconsin, this 25 day of Aug, 1964.

Signature Neal Sperhake

Title Registered Land Surveyor Registration No. 463

Office of Reg. of Deeds County of Forest

I hereby certify that the within instrument was filed in this office for record on the 25 day of Aug 19 64, and was filed in Book No. _____ Page No. _____ of County Records.

Surveyor's Seal

Signature Anna Peterson Title Reg. of Deeds.

4341328000

Index No.

4341328000