

State of Wisconsin

County of FOREST

ss. RESTORATION OF LOST ORIGINAL GOVERNMENT SURVEY CORNER.

I NEAL SPERHAKE, do hereby certify that on the TWENTY-SECOND day of OCTOBER, 19 63, I established the NORTH QUARTER SECTION CORNER OF SECTION 33, TOWNSHIP 34 NORTH, RANGE 13 EAST, Fourth Principal Meridian, as described hereon.

History: This corner was established during the original survey of this township, as noted in the original field notes for the original survey of T34N-R13E, 4th. p.m.

Description of monument and accessories I established to perpetuate the location of this corner:


At the point determined for the location of the corner I emplaced a:

GALVANIZED IRON PIPE, THREE FEET LONG, ONE INCH IN DIAMETER, WITH ALUMINUM CAP DENOTED AS, "KIMBERLY-CLARK CORP. T34N 1/4 BTWN. 28 & 33 R13E SPERHAKE RLS 463 10/22/63."

The pipe is witnessed by:

Oak 7 N 19°W 43 links. (SCRIBED S28 NBT).
W. Birch 8 S 51°E 18 1/2 links. (SCRIBED S33 NBT).

Description as to how corner was located: No evidence of original corner present. Thus, set by proportionate measurement. The section corner 1/2 mile east has been set and the meander corner on the east shore of Pickeral Lake between sections 29 and 32 has been previously established. The distance between these corners is 95.00 chains. Thus, set the quarter corner by proportionate measurement 39.76 chains west of the corner common to sections 27, 28, 33 and 34 and 55.24 chains east of the meander corner on the east shore of Pickeral lake and on a straight line between them.

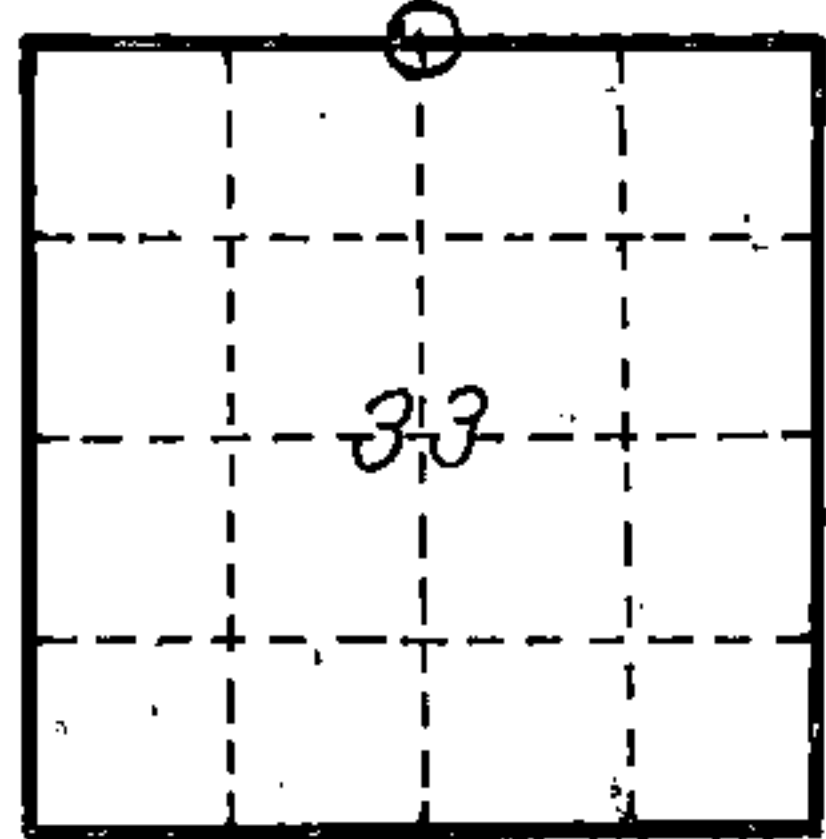

0 = Corner monument restored

Subscribed & sworn to before me this 25 day Aug. 1964

Anna Peterson
NOTARY PUBLIC, FOREST CO., WIS
COM. EXPIRES 10/31/65

89006

Resident witnesses _____

Dated at Crandon, Wisconsin, this 25 day of Aug, 19 64.

Signature Neal Sperhake

Title Registered Land Surveyor Registration No. 463

Office of Reg. of Deeds County of Forest

I hereby certify that the within instrument was filed in this office for record on the 25 day of Aug, 19 64, and was filed in Book No. _____ Page No. _____ of County Records.

Surveyor's Seal

Signature Anna Peterson Title Reg. of Deeds

43413280020

Index No.