

CERTIFIED LAND CORNER RESTORATION

Index No. VV2 8


State of Wisconsin }
County of Forest } ss.

I Thomas R. Arnott, do hereby certify that on the 11th day of September, 1975, I found evidence of the M.C. corner of sections 29 & 32 Township 34, North, Range 13 E, Fourth Principal Meridian, as described hereon; and that from this evidence I established a new monument and accessories as described hereon to perpetuate the original location of this corner.

Resident witnesses:

Herbert Wagoner

FORM 985 M. C. MILLER CO., MILWAUKEE

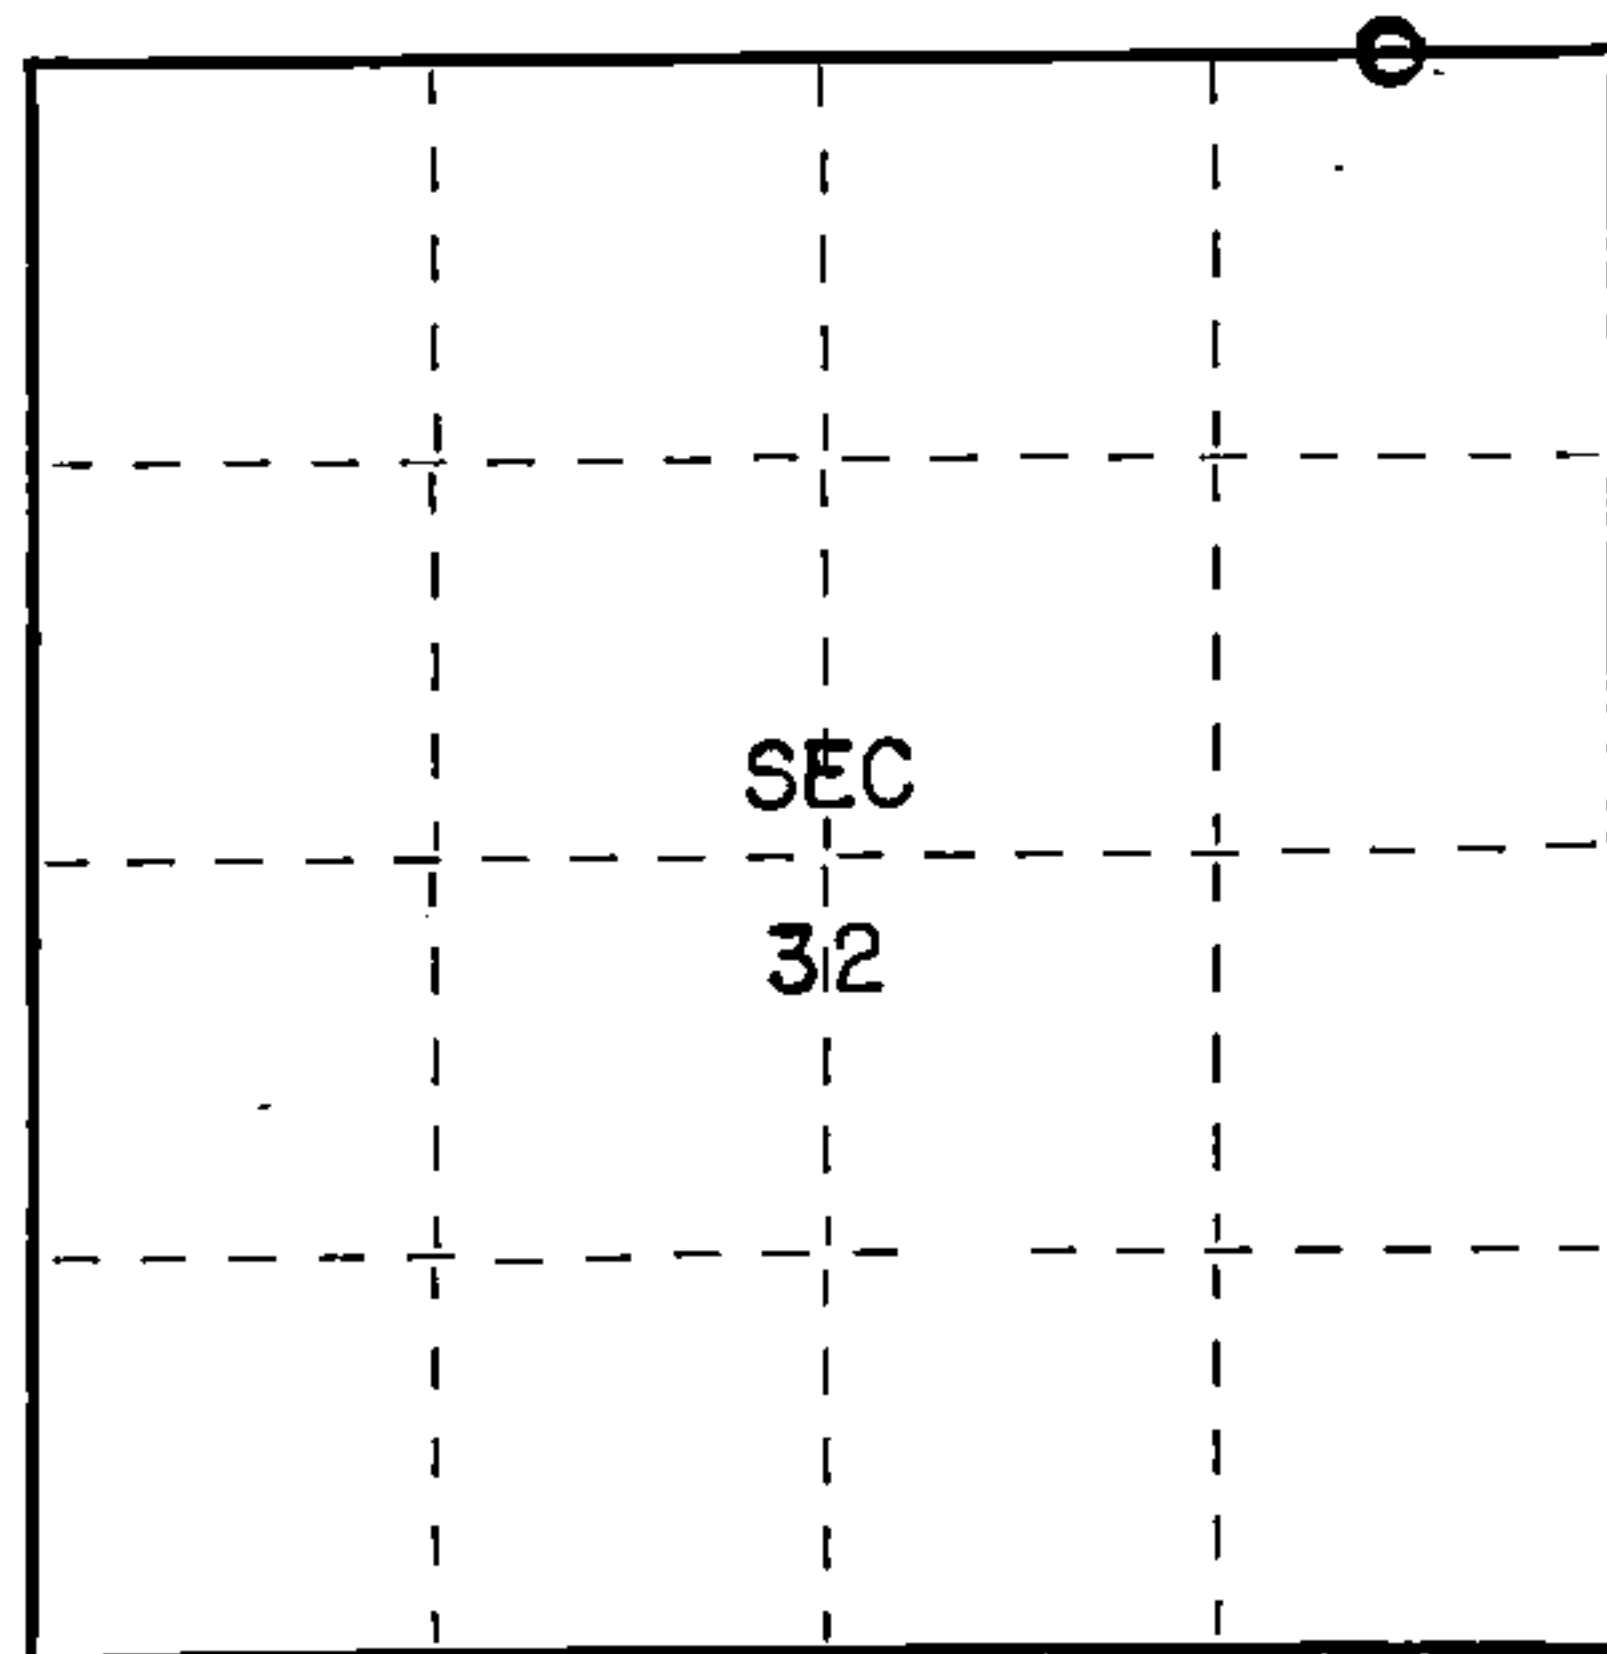

○ = Corner monument restored.

History of original corner establishment:

Original subdivision by James L. Nowlin Oct. 3 - Oct. 16, 1865

Y. Pine 16 N53E 16 Lks.
Hemlock 8 S3W 20 Lks.

Description of corner evidence found:

1" iron pipe found



4341329 opps

Description of monument and accessories I established to perpetuate the original location of this corner.

reset iron pipe with a new Forest County aluminum monument

Ties:

R. Pine 14 N45W 3.56 feet (lawn tree no BT blaze)
SW cor. house foudation N52E 64.83 feet

Dated at Crandon, Wis., this 11th day of November, 1975.

Signature Thomas R. Arnott Title Land Surveyor Registration No. S-887
(County Surveyor, Registered Land Surveyor, or other duly authorized official)

Office of Register of Deeds, County of Forest, I hereby certify that the within instrument was filed in this office for record on the 11th day of November, 1975 at 4 o'clock P. M.

Eugene Stutzman Document Number 108210
(Register of Deeds)

By..... Deputy