

CERTIFIED LAND CORNER RESTORATION

89013

Index No. ~~X=9~~

State of Wisconsin }
County of FOREST } ss.

History of original corner establishment: This corner can also be described as: "THE QUARTER SECTION CORNER BETWEEN SECTIONS 32 AND 33, T34N-R13E, 4th. p.m.

I NEAL SPERHAKE, do hereby certify that on the TWENTY-FIRST day of OCTOBER, 1963, I found evidence of the WEST QUARTER SECTION corner of SECTION 33 Township 34 North, Range 13 EAST, Fourth Principal Meridian, as described hereon; and that from this evidence I established a new monument and accessories as described hereon to perpetuate the original location of this corner.

This corner was established during the original survey of this township, as noted in the Original Field Notes for the Original Survey of T34N-R13E, 4th. p.m.

Description of corner evidence found:

The stump of the original bearing tree, described in the original field notes as:

"Hemlock 20 N 34°W 20 links."


is still present at this date, with a portion of the original scribe marks still visible.

Description of monument and accessories I established to perpetuate the original location of this corner.

At the site of the original post, as determined from the existing original bearing tree noted above, I emplaced a "Galvanized iron pipe, three feet long, one inch in diameter, with aluminum cap denoted as, 'Kimberly-Clark Corp. T34N 1/4 BTWN. 32 & 33 R13E SPERHAKE RLS 463 10/21/63."

The pipe is witnessed by:

Maple 4 S 60°W 28 1/2 links. (SCRIBED 1/4 S32 NBT).
Maple 3 N 40°E 30 links. (SCRIBED 1/4 S33 NBT).

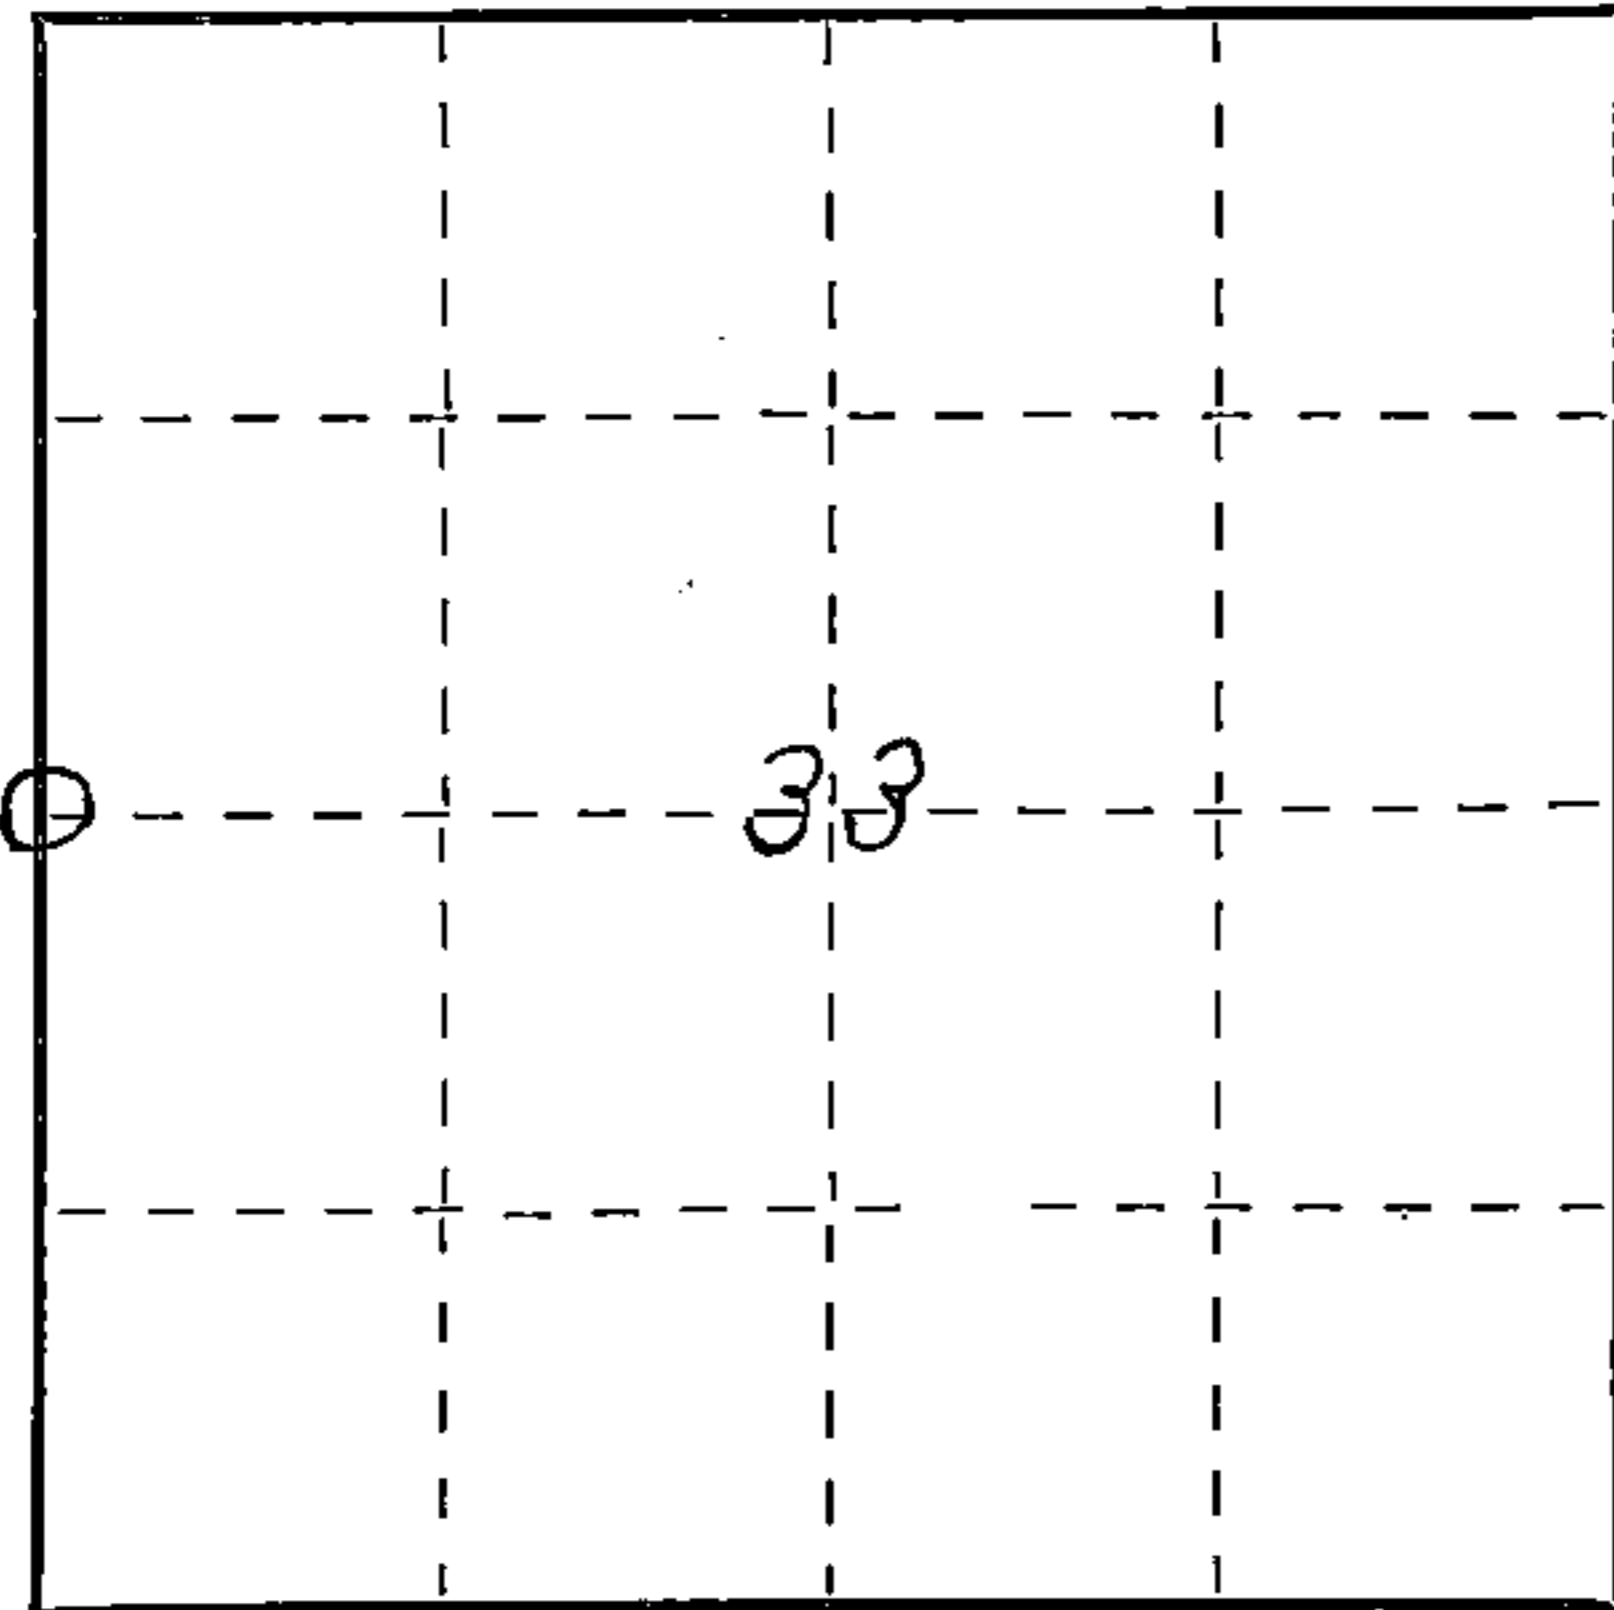

○ = Corner monument restored.

FORM 985 H. C. MILLER CO., MILWAUKEE

43413322000

Surveyor's Seal

Dated at Crandon, Wis., this 25 day of Aug., 1964

Signature: *Neal Sperhake* Title: Registered Land Surveyor Registration No. 463
(County Surveyor, Registered Land Surveyor, or other duly authorized official)

Office of Register of Deeds, County of Forest, I hereby certify that the within instrument was filed in this office for record on the 25 day of Aug., 1964 at 2 o'clock P. M.

Anna Peterson
(Register of Deeds) Subscribed & sworn to before me this 25 day Aug 1964

By: _____ Deputy Notary Public, Forest Co., Wis
Com. expires 10/31/65

~~Received for record this 25 day August 1964~~