

State of Wisconsin

County of FOREST

ss. RESTORATION OF LOST ORIGINAL GOVERNMENT SURVEY CORNER.

I NEAL SPERHAKE, do hereby certify that on the TWENTY-SECOND day of OCTOBER, 1963, I established the WEST QUARTER SECTION CORNER OF SECTION 34, TOWNSHIP 34 NORTH, RANGE 13 EAST, Fourth Principal Meridian, as described hereon.

History: This corner was established during the original survey of this township, as noted in the original field notes for the original survey of T34N-R13E, 4th. p.m.

Description of monument and accessories I established to perpetuate the location of this corner:


At the point determined for the location of the corner I emplaced a:

GALVANIZED IRON PIPE, THREE FEET LONG, ONE INCH IN DIAMETER, WITH ALUMINUM CAP DENOTED AS, "KIMBERLY-CLARK CORP. T34N 1/4 BTWN. 33 & 34 R13E SPERHAKE RLS 463 10/22/63."

The pipe is witnessed by:

Cedar 5 S 66°E 60 1/2 links. (SCRIBED 1/4 S 34 NBT).

Description as to how corner was located: No evidence of the original corner is present.

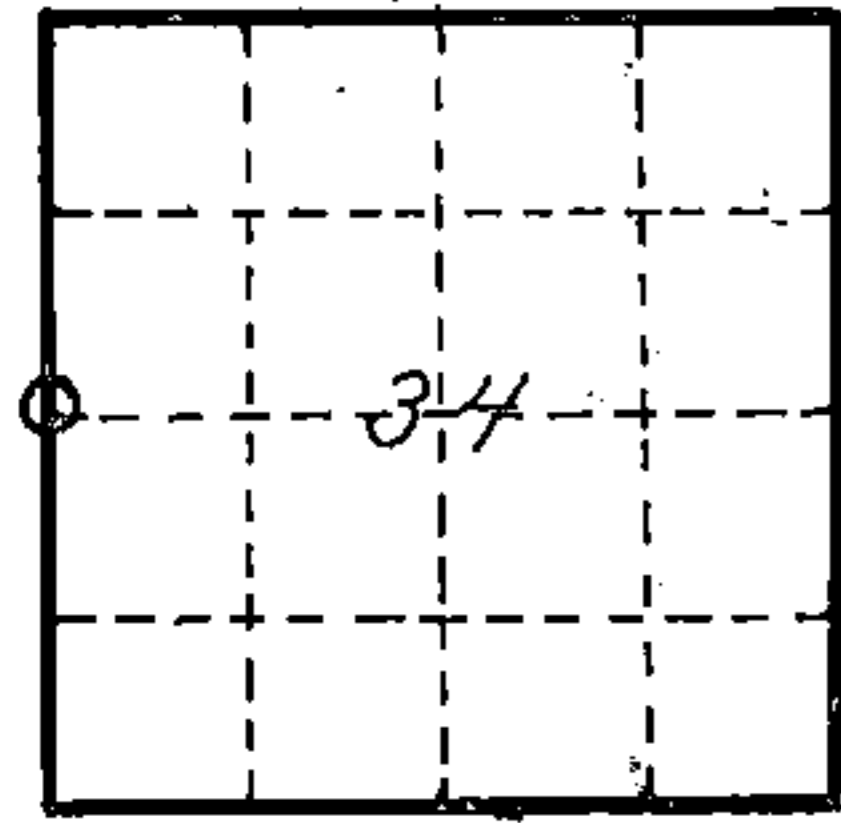

O = Corner monument restored

Previous survey work has proved that the lines between 35 and 36, and 34 and 35 are 82.00 chains long. If the position of the corner of 27, 28, 33, 34, is 82.00 chains north of the town line corner of 33, 34, it is possible to intersect Arbutus Lake on the line between 27 and 28 at the original chainage north of 27, 28, 33, 34. Thus, it is apparent that the line between 33 and 34 is 82.00 chains long. The quarter section corner between 32 and 33 was located with an original bearing tree still present. The length of the southern half mile of 32 and 33 is 41.80 chains. The distance between the town line corner of 35 and 36 to the quarter corner between 35 and 36 is exactly 42.00 chains. Thus, it is apparent that the southern half mile of the south tier of sections is close to 42.00 chains long. Original field notes for going north between 33 and 34 state that at 36.50 chains "enter swamp". This is a well defined swamp, and the actual chainage to the south edge of the swamp is 38.50 chains. Thus, I believe that this section is 42.00 chains long between the town line corner of 33 and 34 and the quarter section corner between 33 and 34. Therefore, I set the corner at this chainage, and on a straight line between the town line corner of 33 and 34 and the corner of 27, 28, 33, 34.

Subscribed & sworn to before me this 25 day Aug. 1964

Anna Peterson  
NOTARY PUBLIC, FOREST CO., WIS  
COM. EXPIRES 10/31/65

Resident witnesses \_\_\_\_\_

Dated at Crandon, Wisconsin, this 25 day of Aug, 19 64.

Signature Neal Sperhake

Title Registered Land Surveyor Registration No. 463

Office of Reg. of Deeds County of Forest

I hereby certify that the within instrument was filed in this office for record on the 25 day of Aug 19 64, and was filed in Book No. \_\_\_\_\_ Page No. \_\_\_\_\_ of County Records.

Surveyor's Seal

Signature Anna Peterson Title Reg. of Deeds

43413332000

89010

Index No.

X  
13  
W  
3