

CERTIFIED LAND CORNER RESTORATION

Index No. W-11

State of Wisconsin }  
County of Forest } ss.

History of original corner establishment:  
No evidence of any previous corner.

W 11

I Glen Barker, do hereby certify that on the 30th day of April, 1982, I found ~~found~~ est. ~~evidence of the~~ NC 1/16 corner of Section 33 Township 34, North, Range 13 East, Fourth Principal Meridian, as described hereon; and that from this evidence I established a new monument and accessories as described hereon to perpetuate the original location of this corner.

Description of corner evidence found:  
Total distance from 1/4 corner between sections 28 & 33 to C 1/4 corner section 33, is 2690.92 ft. at bearing S 1-30-33W. Set W 1/16 1345.46 ft. intermediate.

Resident witnesses:

James D. Claflin, R  
Herb Wagoner



Description of monument and accessories I established to perpetuate the original location of this corner.

Set a 1" iron pipe with 2" diameter alloy cap stamped:

Monument projects 18" above ground.

Marked NBTs:

Sugar 5" S62W 25.09 ft.

Sugar 5" S44E 29.95 ft.

Scribed 1/16 - B.T.

S1682


T36N R14E

NC 1/16 S 33

CPI - 1982

FORM 985 H. C. MILLER CO., MILWAUKEE

T34N

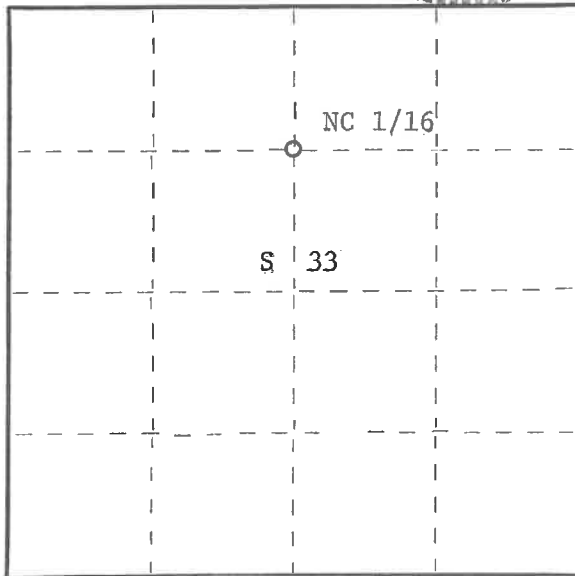

○ = Corner monument restored.

Dated at Rhineclander, Wis., this 18th day of May, 1982

Signature Glen Barker Title Registered Land Surveyor Registration No. S-1682  
(County Surveyor, Registered Land Surveyor, or other duly authorized official)

Office of Register of Deeds, County of Forest, I hereby certify that the within instrument was filed in this office for record on the 15th day of June, 1982 at 10:00 o'clock A. M.

Eugene Staszny

(Register of Deeds)

DOCUMENT NO.

**121685**

By Sharon Mueller Deputy

4341333020