

State of Wisconsin

County of FOREST

ss. RESTORATION OF LOST ORIGINAL GOVERNMENT SURVEY CORNER.

I NEAL SPERHAKE, do hereby certify that on the FIFTEENTH day of NOVEMBER, 1963, I established the WEST QUARTER SECTION CORNER OF SECTION 35, TOWNSHIP 34 NORTH, RANGE 13 EAST, Fourth Principal Meridian, as described hereon.

History: This corner was established during the original survey of this township, as noted in the original field notes for the original survey of T34N-R13E, 4th. p.m.

Description of monument and accessories I established to perpetuate the location of this corner:


At the point determined for the location of the corner I emplaced a:

GALVANIZED IRON PIPE, THREE FEET LONG, ONE INCH IN DIAMETER, WITH ALUMINUM CAP DENOTED AS, "KIMBERLY-CLARK CORP. T34N 1/4 BTWN. 34 & 35 R13E SPERHAKE RLS 463 11/15/63."

The pipe is witnessed by:

Maple 5 S 62°W 21 1/2 links. (SCRIBED 1/4 S 34 NBT).
Basswood 8 N 45°E 25 links. (SCRIBED 1/4 S 35 NBT).

Description as to how corner was located: No evidence of the original corner present. The section corners 1/2 mile south and 1/2 mile north have been previously established with a distance of 82.37 chains between them. Recent survey work in this township shows that the southern tier of sections are 82 chains long instead of the recorded 80 chains. Further work shows that the quarter corners were set 42 chains north of the section corners. (see record of quarter corners, between sections 33 and 34 and 35 and 36) Thus, set the quarter corner 42.00 chains north of the section corner between sections 34 and 35 on the town line and on a straight line between it and the section corner one mile north.

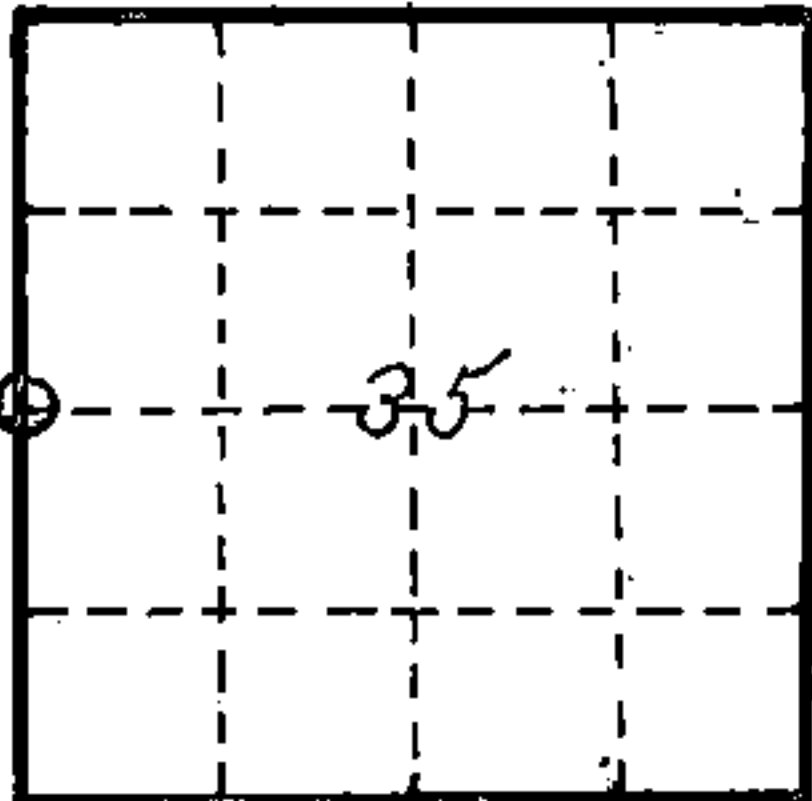

O = Corner monument restored

Subscribed & sworn to before me this 25 day Aug. 1964

Anna Peterson
Notary Public, Forest Co., Wis
Com. expires 10/31/65

60088

Resident witnesses _____

Dated at Crandon, Wisconsin, this 25 day of Aug, 19 64.

Signature Neal Sperhake

Title Registered Land Surveyor Registration No. 463

Office of Reg. of Deeds County of Forest

I hereby certify that the within instrument was filed in this office for record on the 25 day of Aug 19 64, and was filed in Book No. _____ Page No. _____ of County Records.

Surveyor's Seal

Signature Anna Peterson Title Reg. of Deeds

43A1339 2000

Index No. X-117