

ESTABLISHMENT OF QUARTER - QUARTER SECTION CORNER BETWEEN ORIGINAL GOVERNMENT SURVEY CORNERS
86998

Index No. 7-18
718

STATE OF WISCONSIN

I NEAL SPERHAKE, do hereby certify that on the FIFTEENTH day of NOVEMBER, 1962, I established the WEST ONE SIXTEENTH CORNER BETWEEN SECTIONS 2, TOWNSHIP 33 NORTH, RANGE 13 EAST, AND, 35, TOWNSHIP 34 NORTH, RANGE 13 EAST, Fourth Principal Meridian as described hereon.

Resident Witnesses:
Richard Piontek - Waubeno.

This corner can also be described as either the "WEST 1/8 TH OR THE WEST QUARTER-QUARTER SECTION CORNER BETWEEN SECTIONS 2, T33N-R13E, AND, 35, T34N-R13E, 4TH P.M."

History:
There is no record of this corner having ever been previously established.

Description of monument and accessories I established to perpetuate the location of this corner:

At the point determined for the location of the corner I emplaced a:
"GALVANIZED IRON PIPE, THREE FEET LONG, ONE INCH IN DIAMETER, WITH AN ALUMINUM CAP DENOTED AS, 'KIMBERLY-CLARK CORP T33-34N W 1/16 BTWN 2 & 35 R13E SPERHAKE RLS 463 11-15-62".

The pipe is witnessed by:
Maple 4 S46°E 11 links. (Scribed S 2 BT).
Maple 3 N 3°W 27 links. (Scribed S35 BT).

Description as to how corner was located:

Since both the quarter-section corner one quarter mile east, and the section corner one quarter mile west have been previously established, with a distance between them of 40.03 chains, the 1/16th corner was set 20.01½ chains from either corner, on a straight line between them.


Dated at Crandon Wis., this 11th day of April, 19 63

Signature Neal Sperhake Title Registered Land Surveyor Registration No. S-463

~~Office of Register of Deeds~~, County of Forest, I hereby certify that the within instrument was ~~signed and sworn to~~ signed and sworn to on the 11th day of April, 19 63


~~at~~ at ~~at~~ at ~~at~~ at

Adeline Denoble
Notary (~~Register of Deeds~~) Public
Forest County, Wisconsin
By My commission expires ~~My Commission Expires~~ February 6, 1966

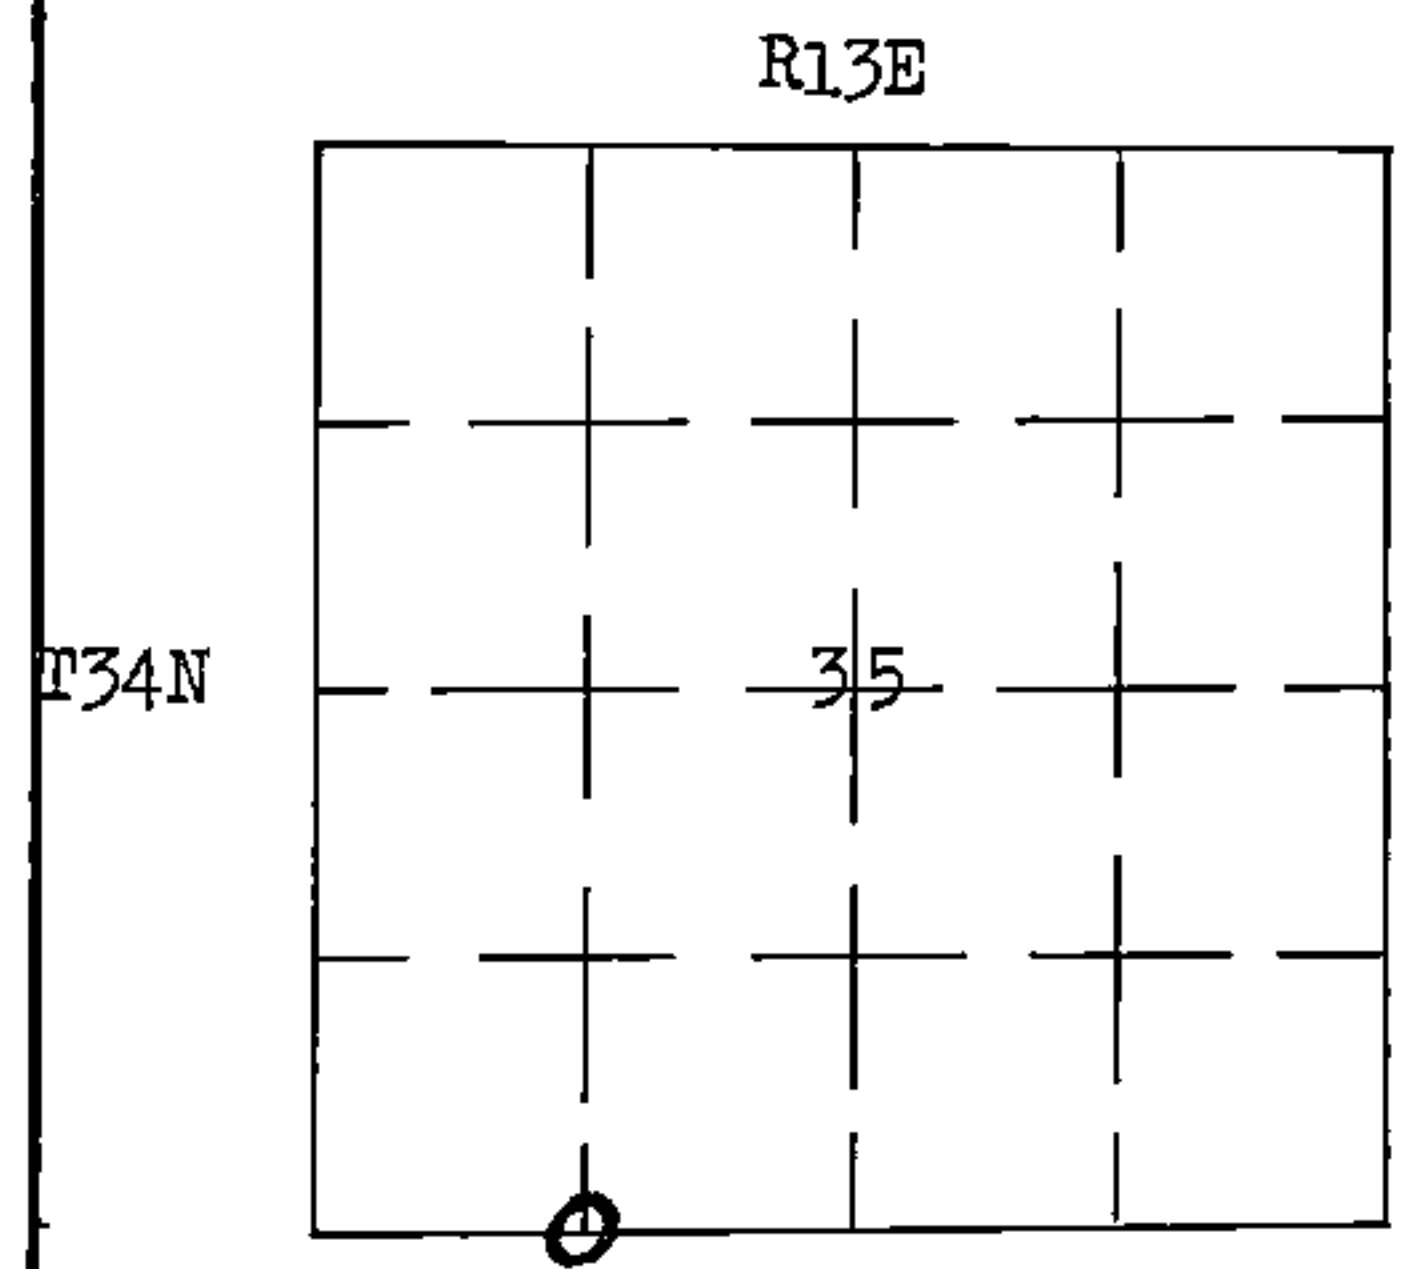

0 = Corner monument established

REGISTER'S OFFICE
FOREST COUNTY, WIS.

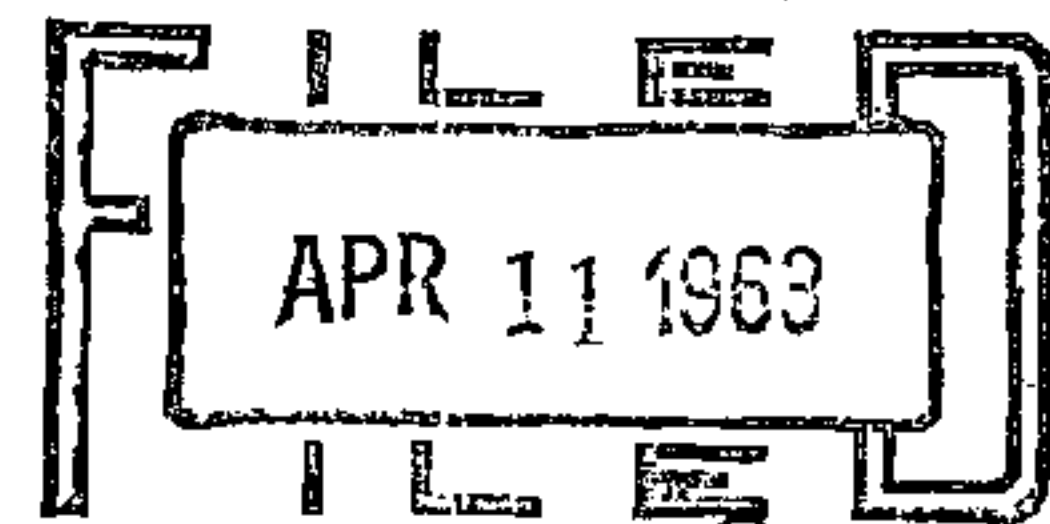

At 7 o'clock P
Karl A. Meyer Register of Deeds

Surveyor's Seal

43413350030