


U. S. PUBLIC LAND SURVEY MONUMENT RECORD

INSTRUCTIONS: This record shall show the location of the corner and shall include all of the following nine elements (a through i).

- (a) Identify the corner by reference to the U.S. public land survey system.
- = Corner monument restored.

Corner to Sections 3, 4, 9, and 10, T.34N., R.14E.

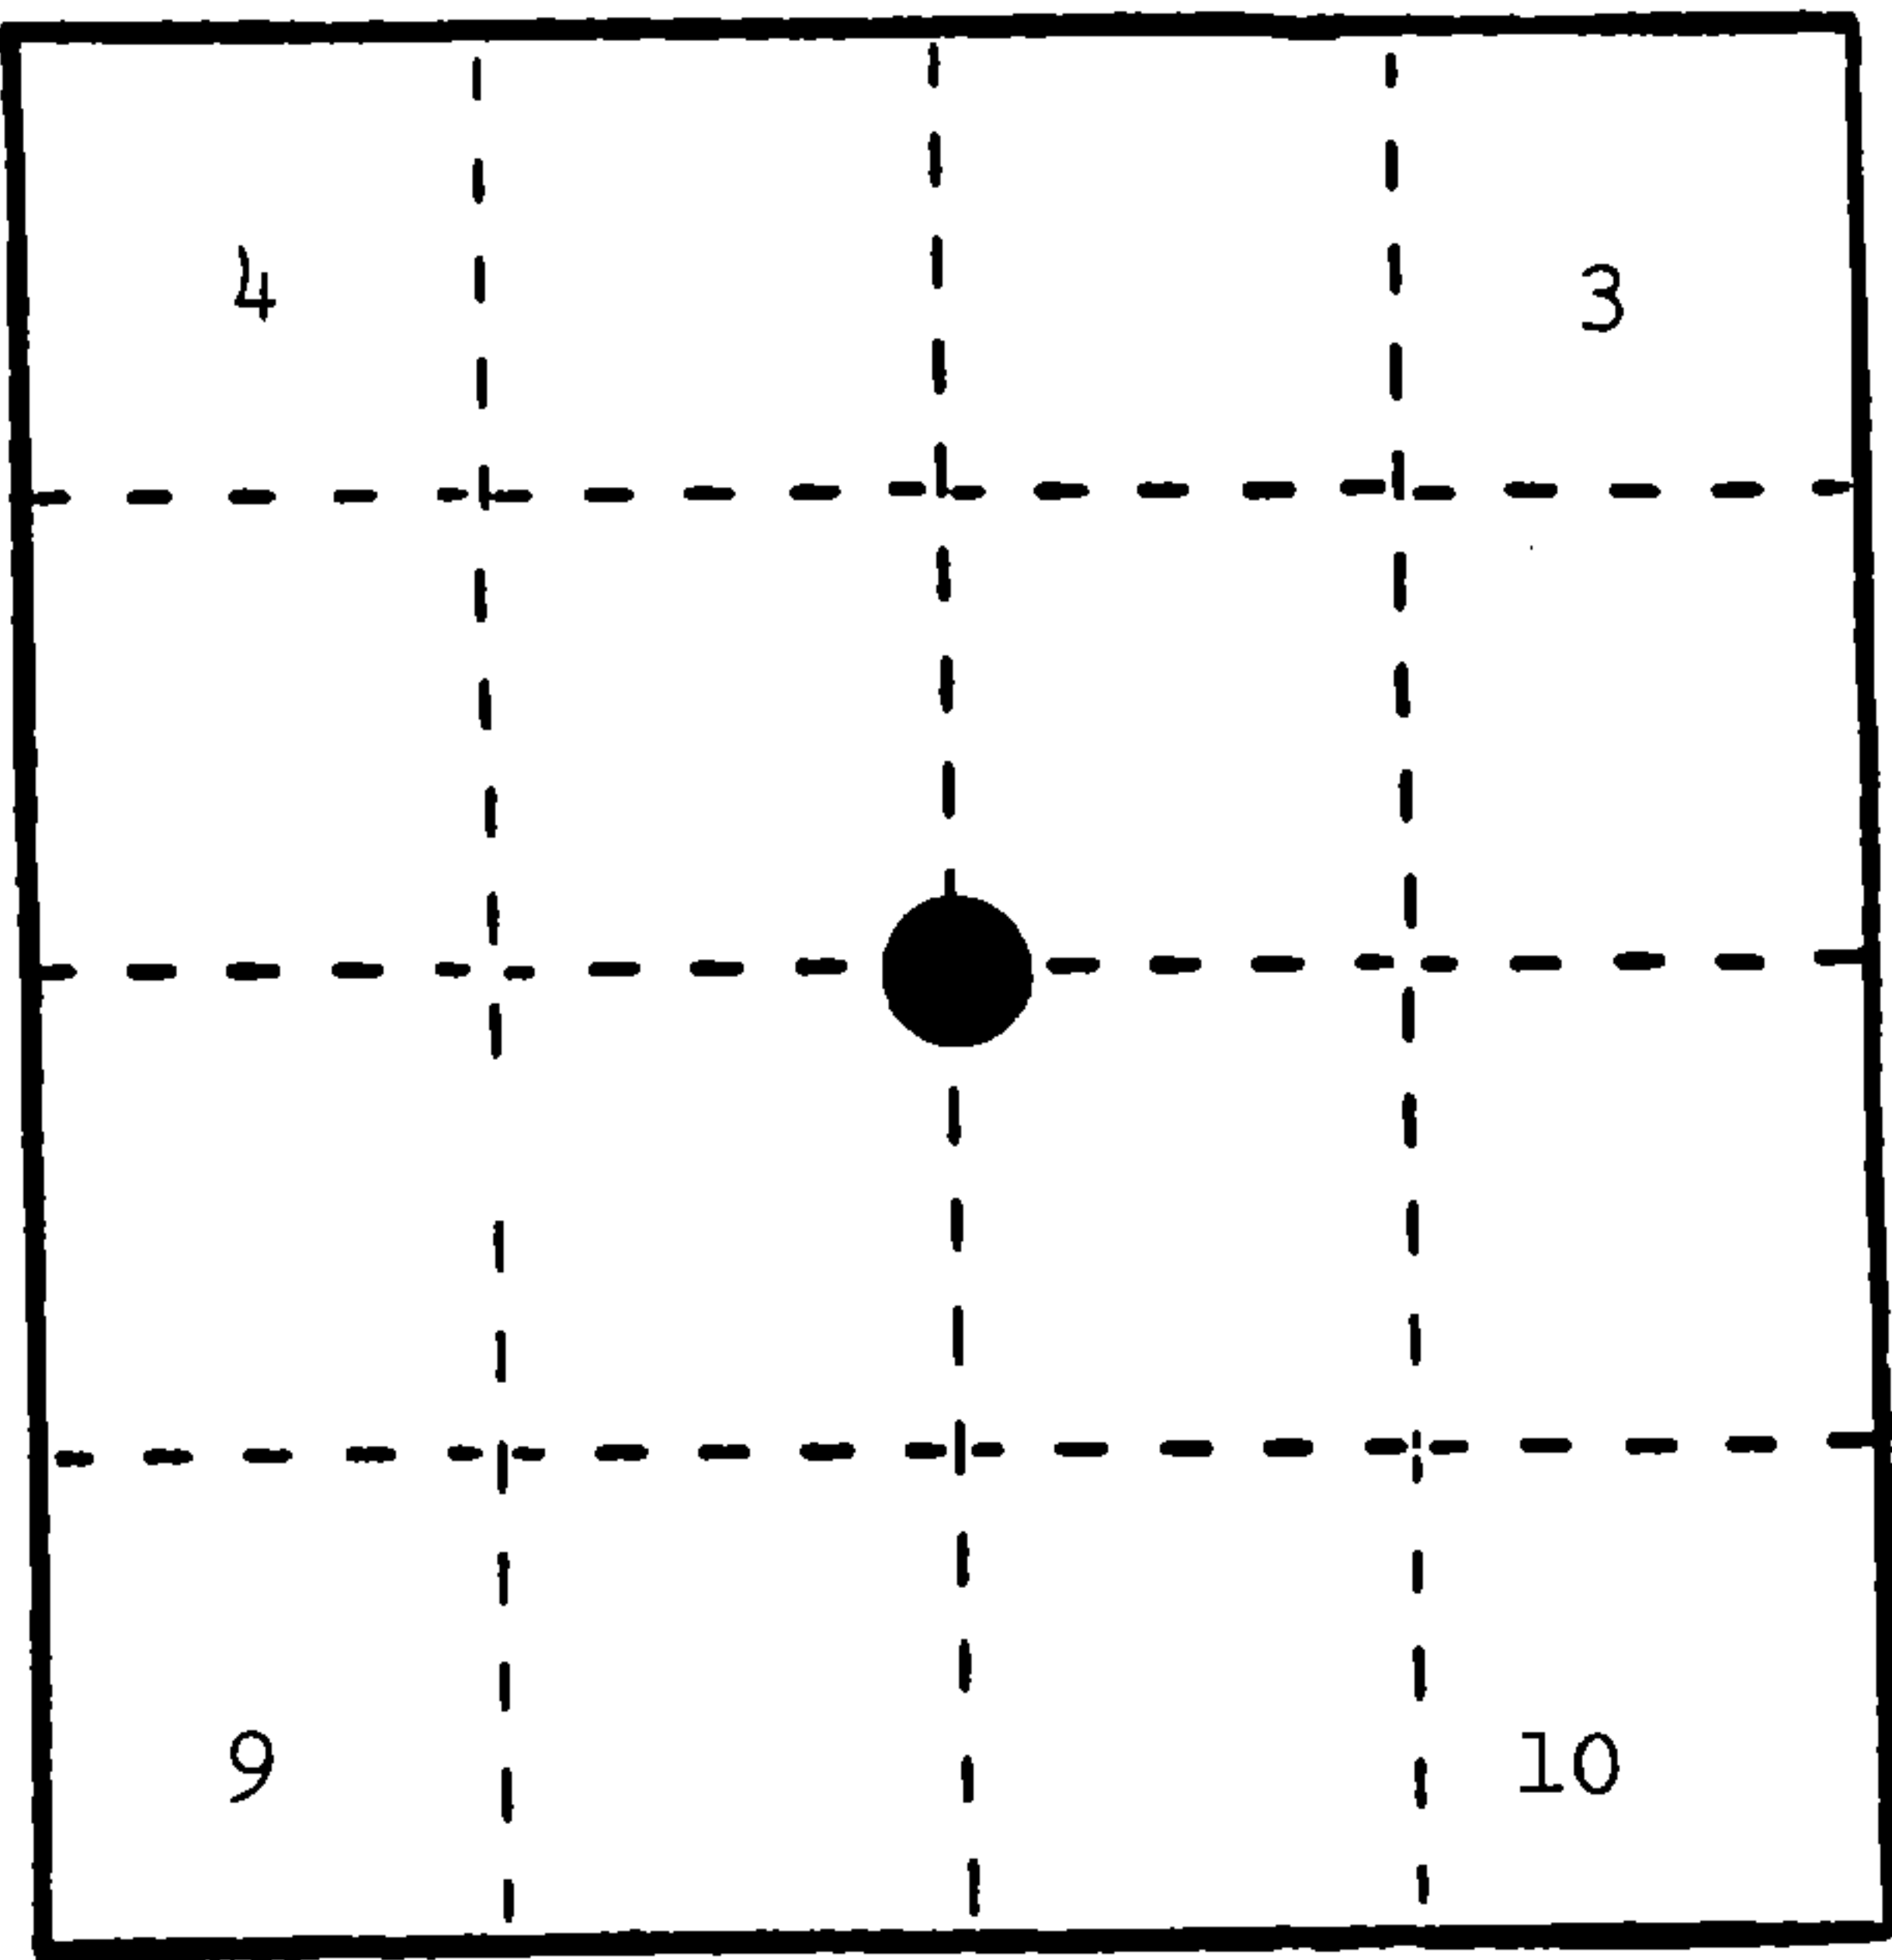

- (b) Describe any record evidence, monument evidence, occupational evidence, testimonial evidence or any other material evidence you considered, and whether the monument was found or placed.

In 1859, James McBride set wood post and made the following BTs: Birch, 24", N.66°W., 18 links; Birch, 30", N.64°E., 72 links; Birch, 20", S.57°E., 54 links; Birch, 10", S.34°W., 7 links.

In 1912, N. Smith found corner and made new BTs: Hemlock, 26", N.50°45'E., 91 links; Sugar, 14", S.19°30'W., 81 links.

In 1961, Jean Resvick found location tag from CCCs.


In 1982, Milo Stefan found what was thought to be Smith's corner and monumented same.

In 1986, Alan Harrison--retracement of Smith's 1912 survey of north line of Section 9 from N 1/4 through E 1/16 corner indicates location 5 feet south of a Sugar found with location poster at base. Because of positive identification of N 1/4 and E 1/16 on north line of Section 9, I accept the above as the best location of this corner. Milo Stefan has verbally approved of this change in corner location.

- (c) In the plan view drawing below, provide reference ties to at least 4 witness monuments, or, if the location is within a municipality, to at least 2 witness monuments. (Witness monuments shall be made of concrete, natural stone, iron or other equally durable material.) Describe witness monuments.

- (d) Show a plan view drawing depicting the relevant monuments and reference ties which is sufficient in detail to enable accurate relocation of the corner monument if the corner monument is disturbed. Indicate north.

- 1. 2" x 36" aluminum monument stamped to identify the corner location.
- 2. Sugar, 7", N.25°E., 59.14 feet
- 3. Red Maple, 5", S.88°E., 10.48 feet
- 4. Sugar, 8", S.3°W., 16.61 feet
- 5. Sugar, 7", N.40°W., 42.93 feet
- 6. Steel Sign Post, Southwest, 1.02 feet

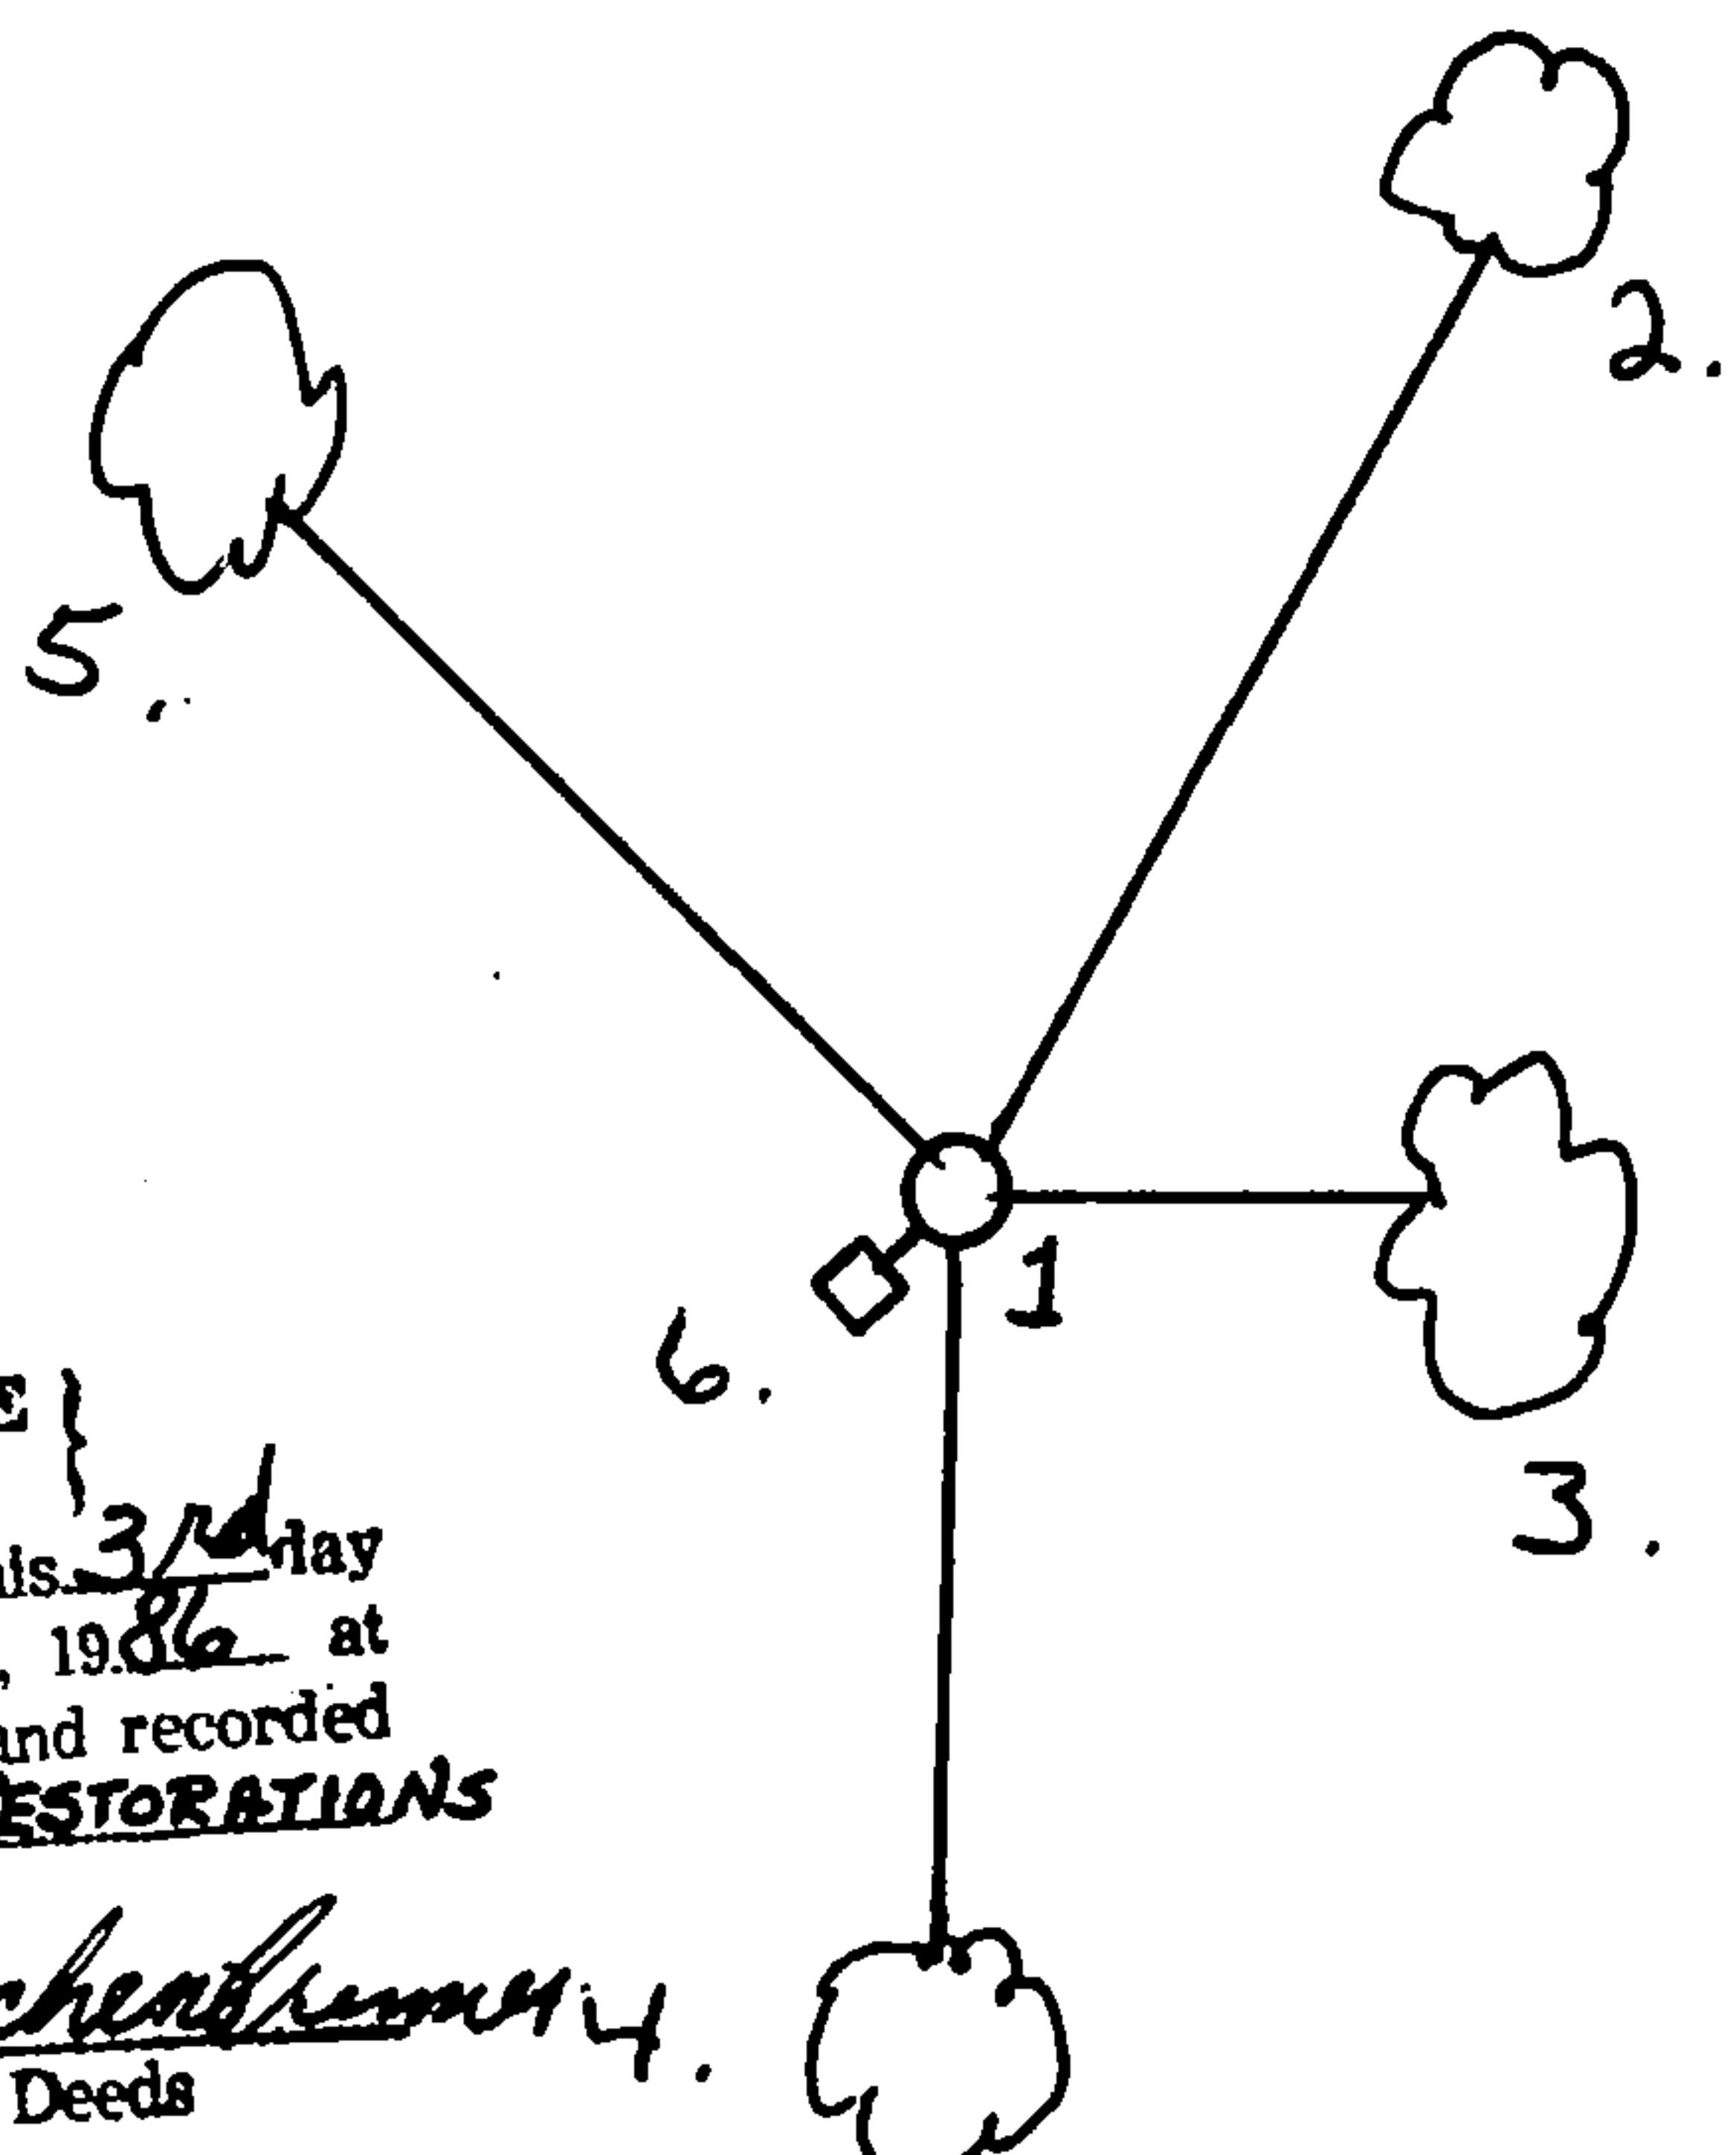

REGISTER'S OFFICE
Forest County, Wis.
Received for record this 3rd day
of December A.D., 1986 at
1:30 o'clock P.M. and recorded
in Vol. CORNER RESTORATIONS
page E-13
Paul Aschenbrenner
Register of Deeds

(e) Describe any material discrepancy between the location of the corner as restored or reestablished and the location of that corner as previously restored or reestablished by distance and direction. Show the discrepancy on the plan view drawing under (d), above. Show the distances between the corner as previously restored or reestablished and (1) the corner as restored or reestablished, and (2) to at least 2 of the witness monuments shown on the drawing in (d), above.

Yes. Corner location set by Milo Stefan, R.L.S., S.2°50'E., 122.06' (removed).

(f) Was the corner restored through acceptance of (1) an obliterated evidence location, or, (2) a found perpetuated location?

(1) an obliterated evidence location.

(g&h) Was the corner reestablished through lost corner proportionate methods? If so, show the method, including the directions and distances to other public land survey corners used as evidence or used for proportioning in determining the corner location?


No.

(i) I, Alan D. Harrison
(type or print name) certify that the corner location shown on this record was determined by me or under my direction and control and that this U.S. Public Land Survey Monument Record is correct and complete to the best of my knowledge and belief.

Signature

Date

11/14/86

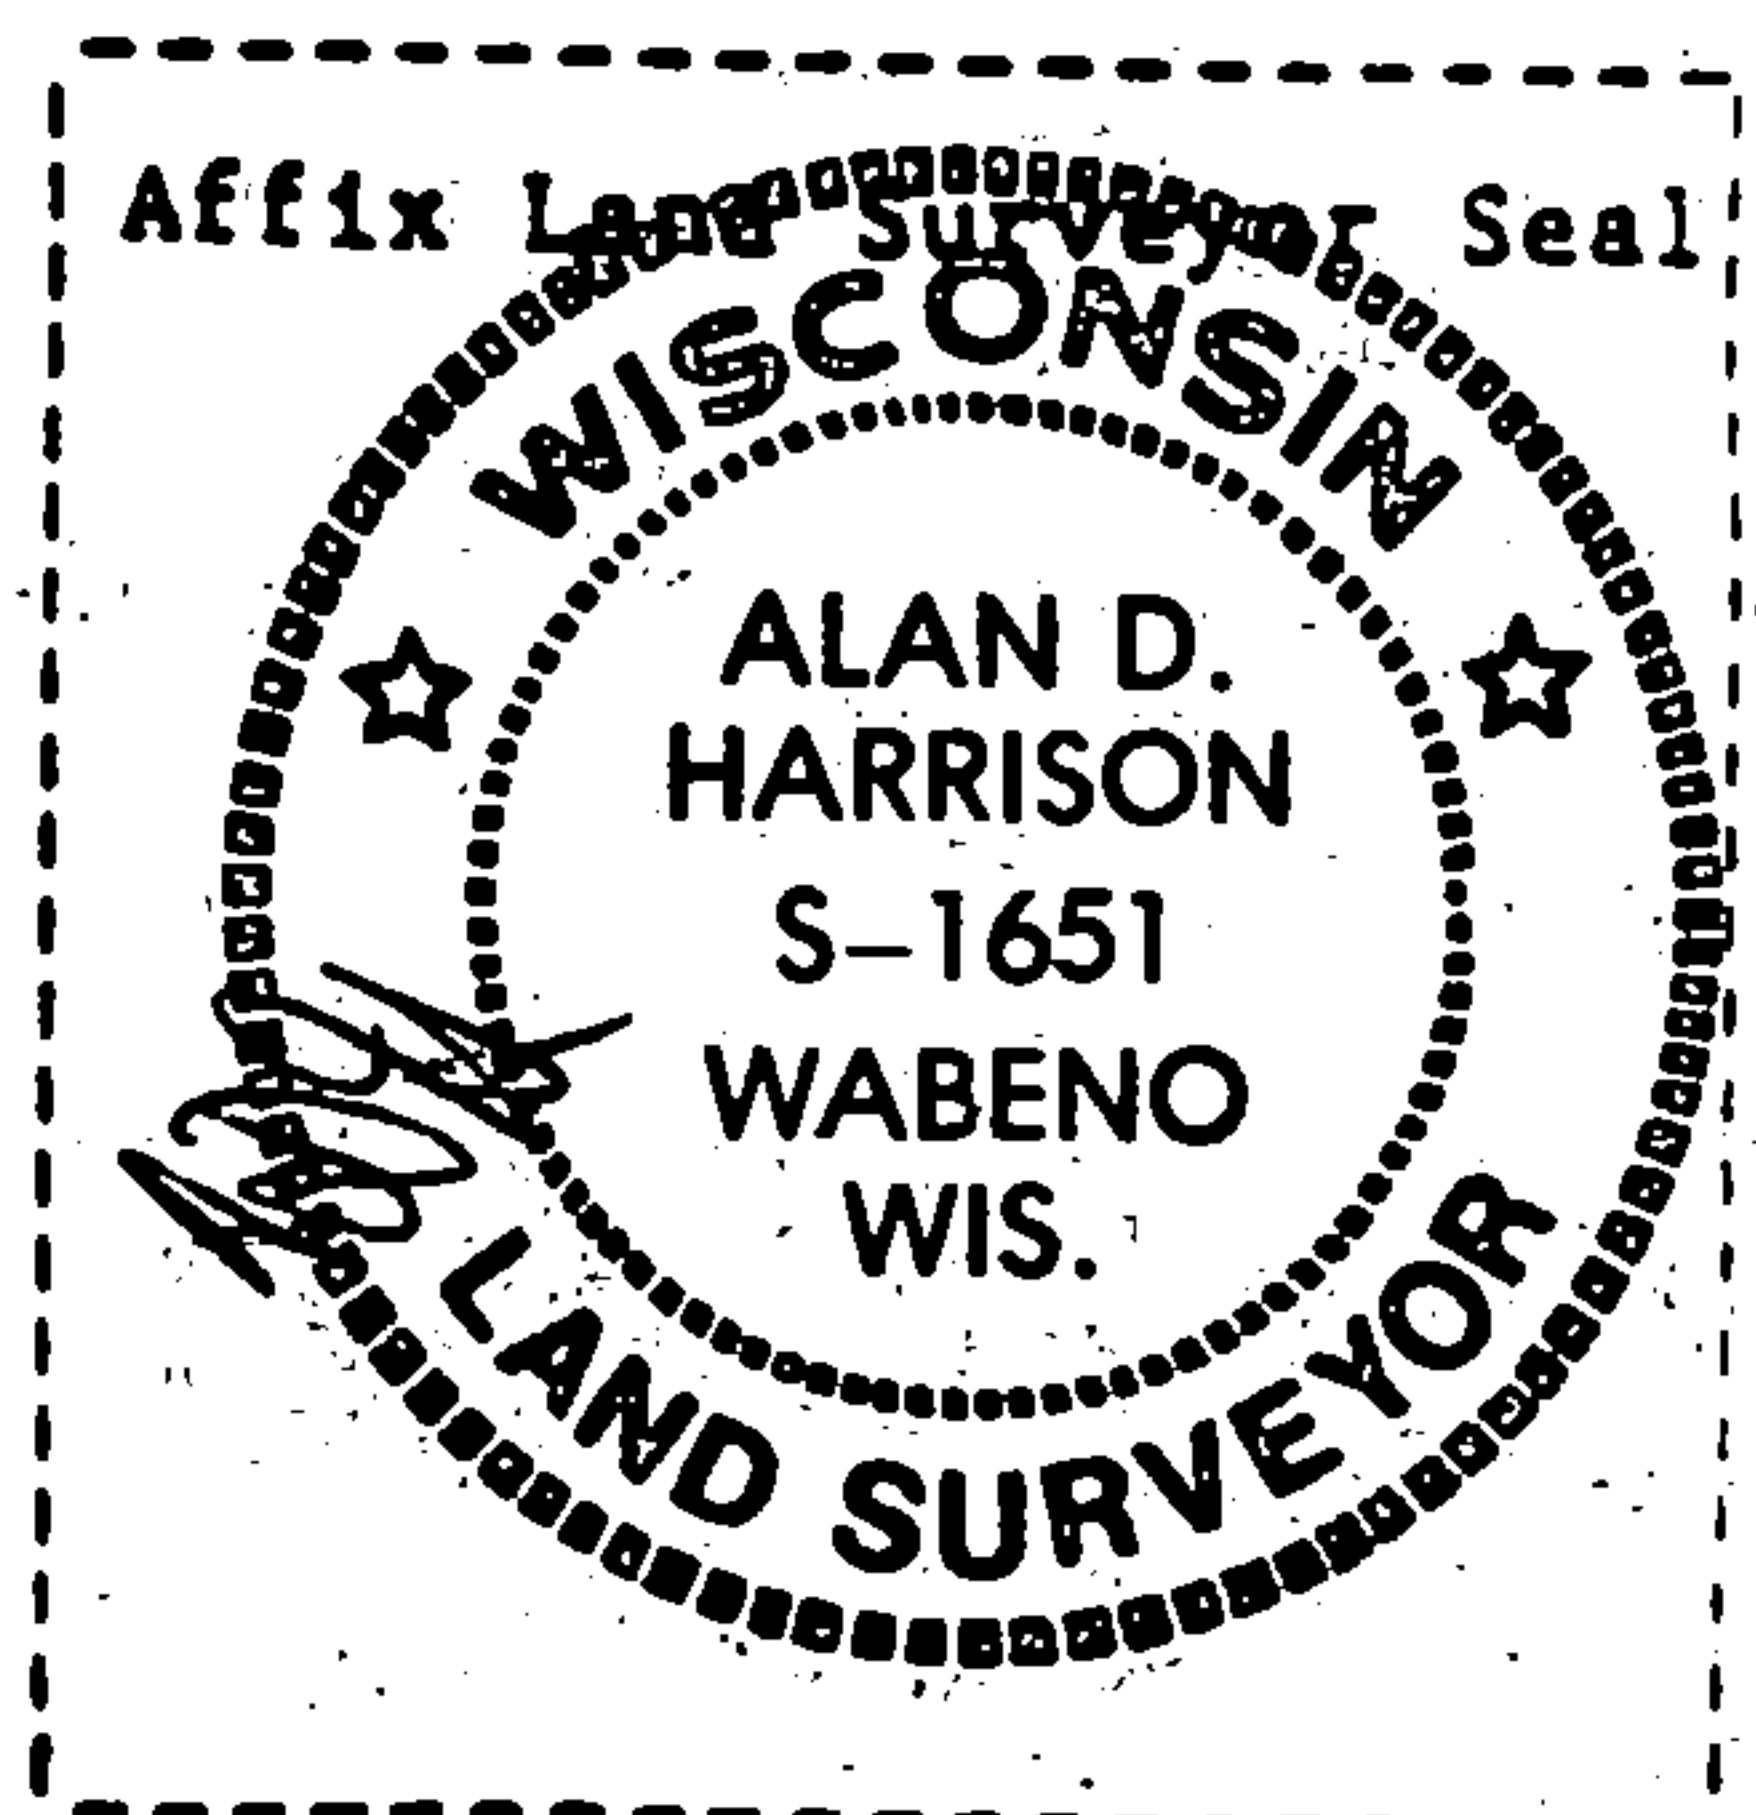


U. S. PUBLIC LAND SURVEY MONUMENT RECORD

INSTRUCTIONS: This record shall show the location of the corner and shall include all of the following nine elements (a through i).

- (a) Identify the corner by reference to the U.S. public land survey system.

○ = Corner monument restored.

Section corner to Sections 3, 4, 9, and 10,
T.34N., R.14E.

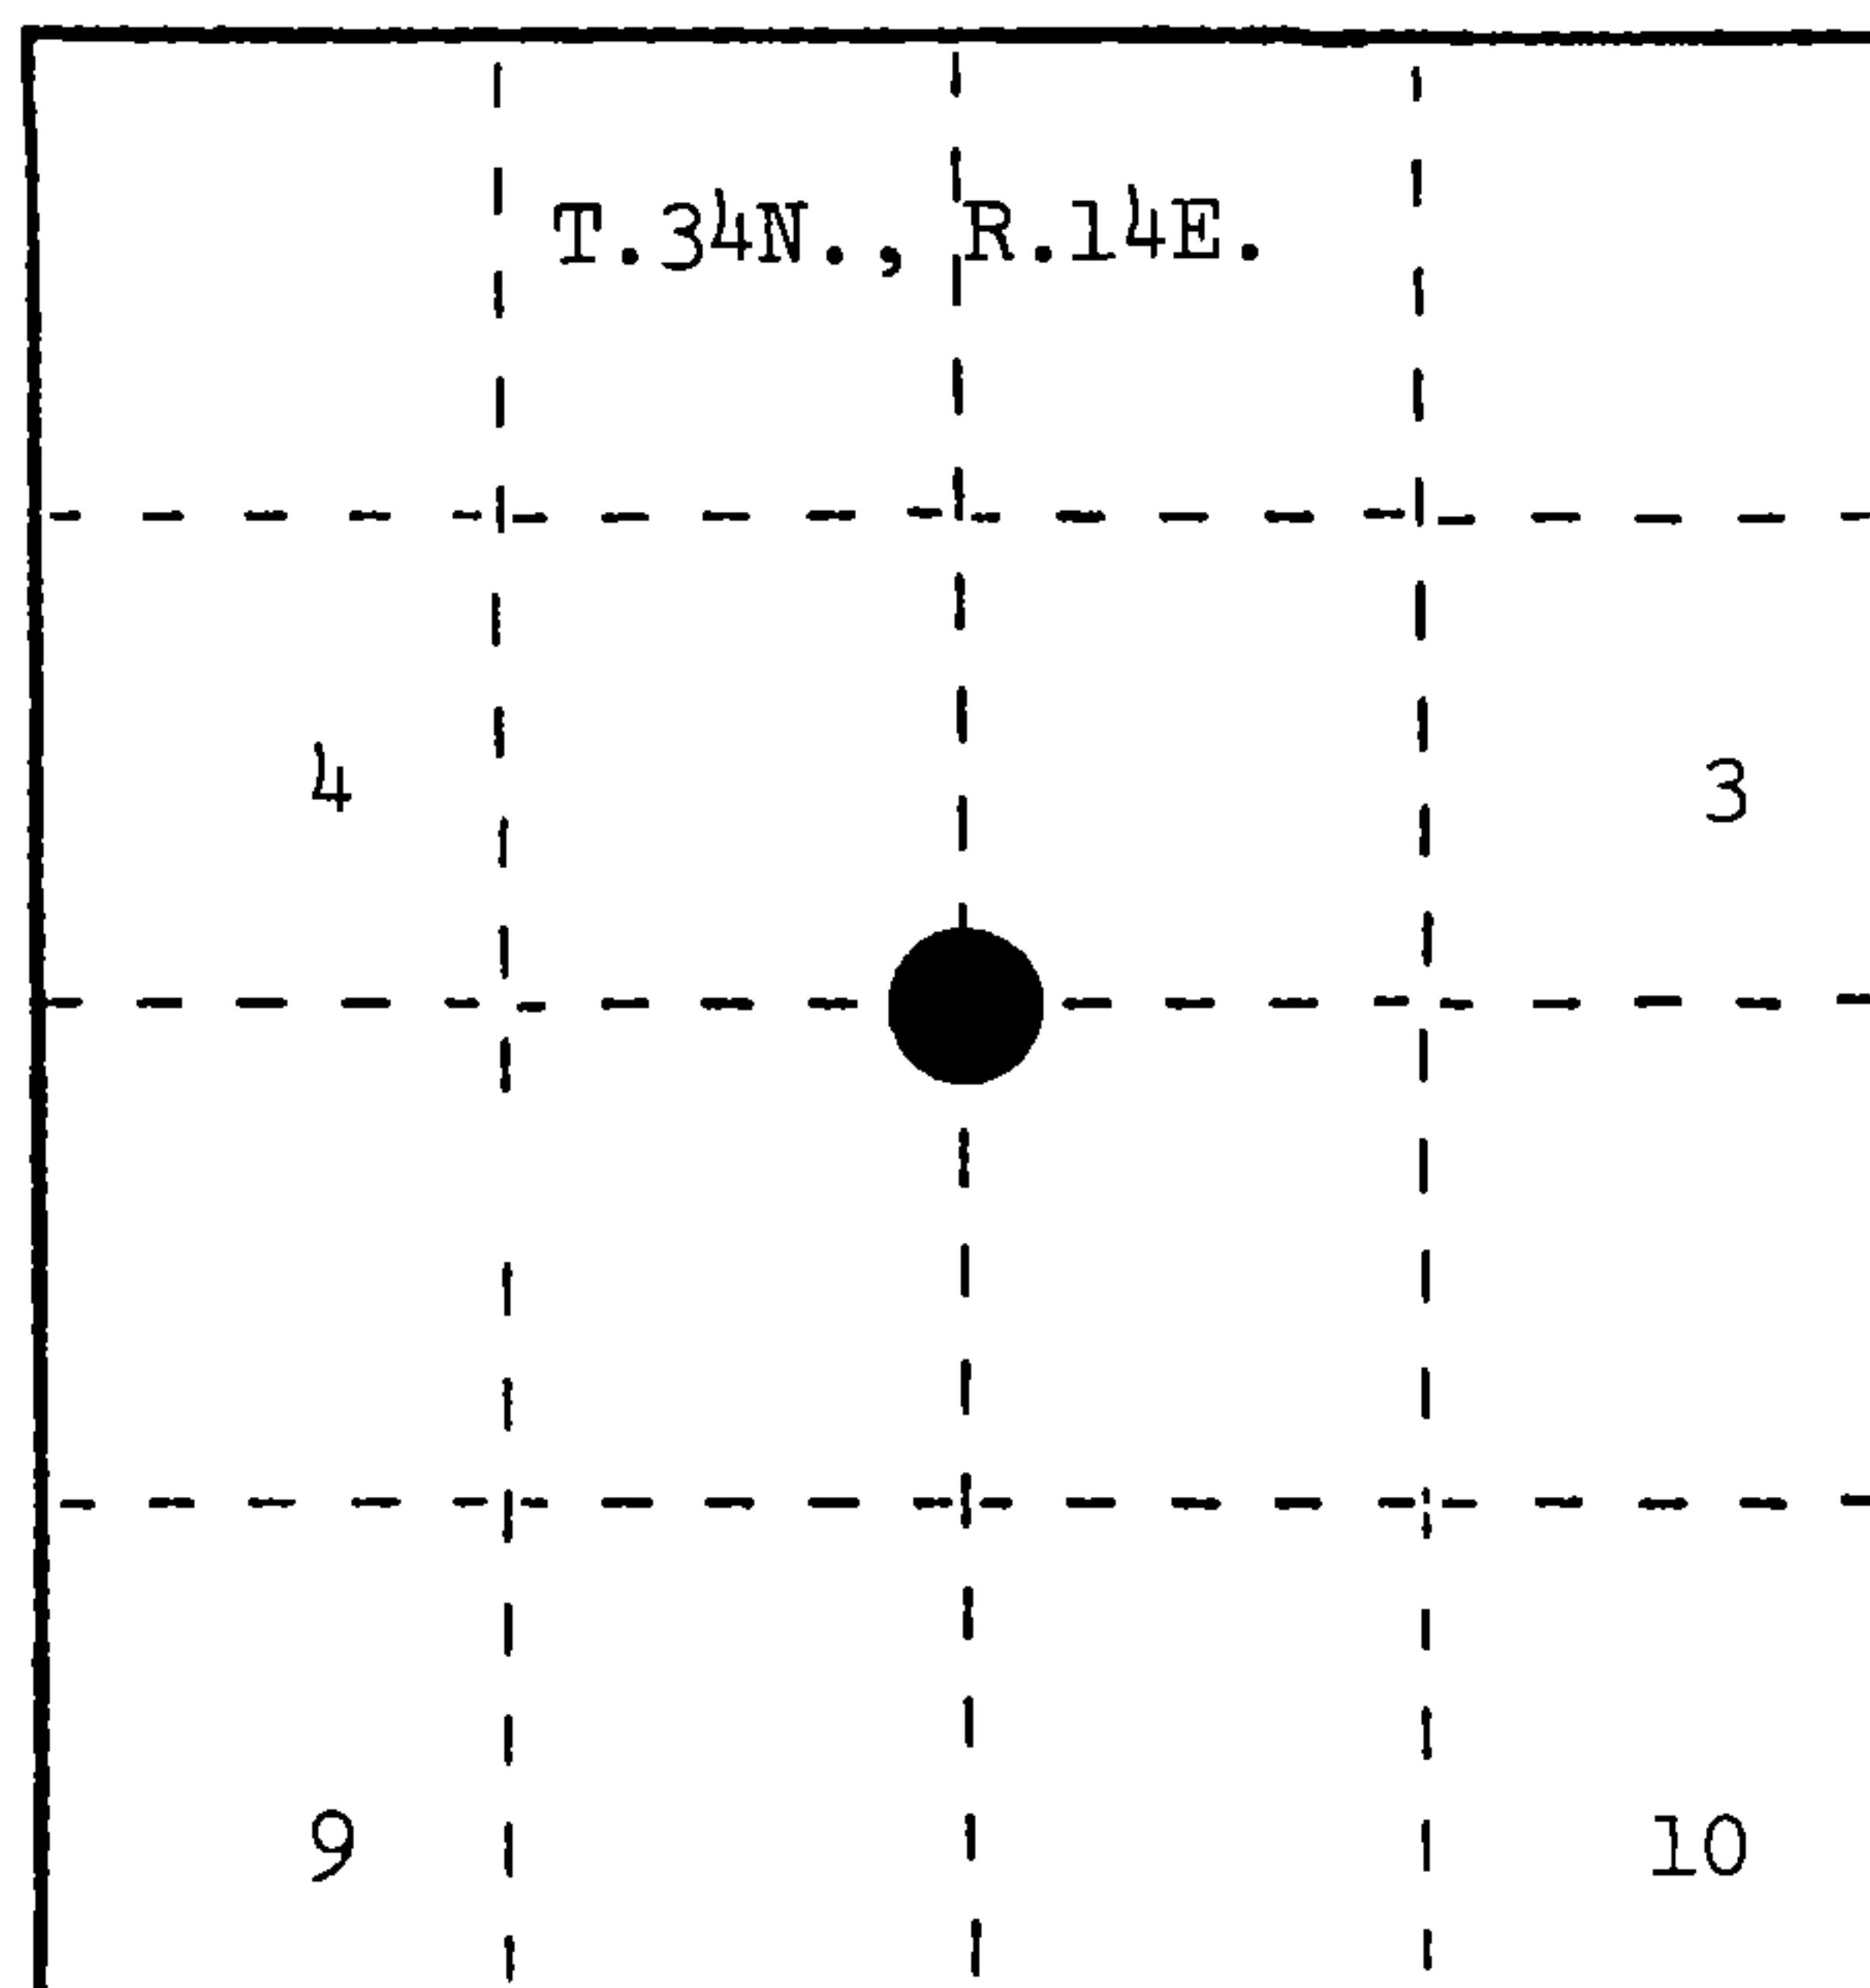


- (b) Describe any record evidence, monument evidence, occupational evidence, testimonial evidence or any other material evidence you considered, and whether the monument was found or placed.

Corner position recovered from original Birch stump and N. Smith's two resurvey bearing trees from 1912.

- (c) In the plan view drawing below, provide reference ties to at least 4 witness monuments, or, if the location is within a municipality, to at least 2 witness monuments. (Witness monuments shall be made of concrete, natural stone, iron or other equally durable material.)
Describe witness monuments.

- (d) Show a plan view drawing depicting the relevant monuments and reference ties which is sufficient in detail to enable accurate relocation of the corner monument if the corner monument is disturbed. Indicate north.

1. Sugar, 4", N.33°E., 17.07 feet
2. Sugar, 7", S.43°E., 46.94 feet
3. Sugar, 6", S.15°W., 27.79 feet
4. Sugar, 5", N.84°W., 29.01 feet
5. Steel Sign Post, S.80°E., 1.60 feet

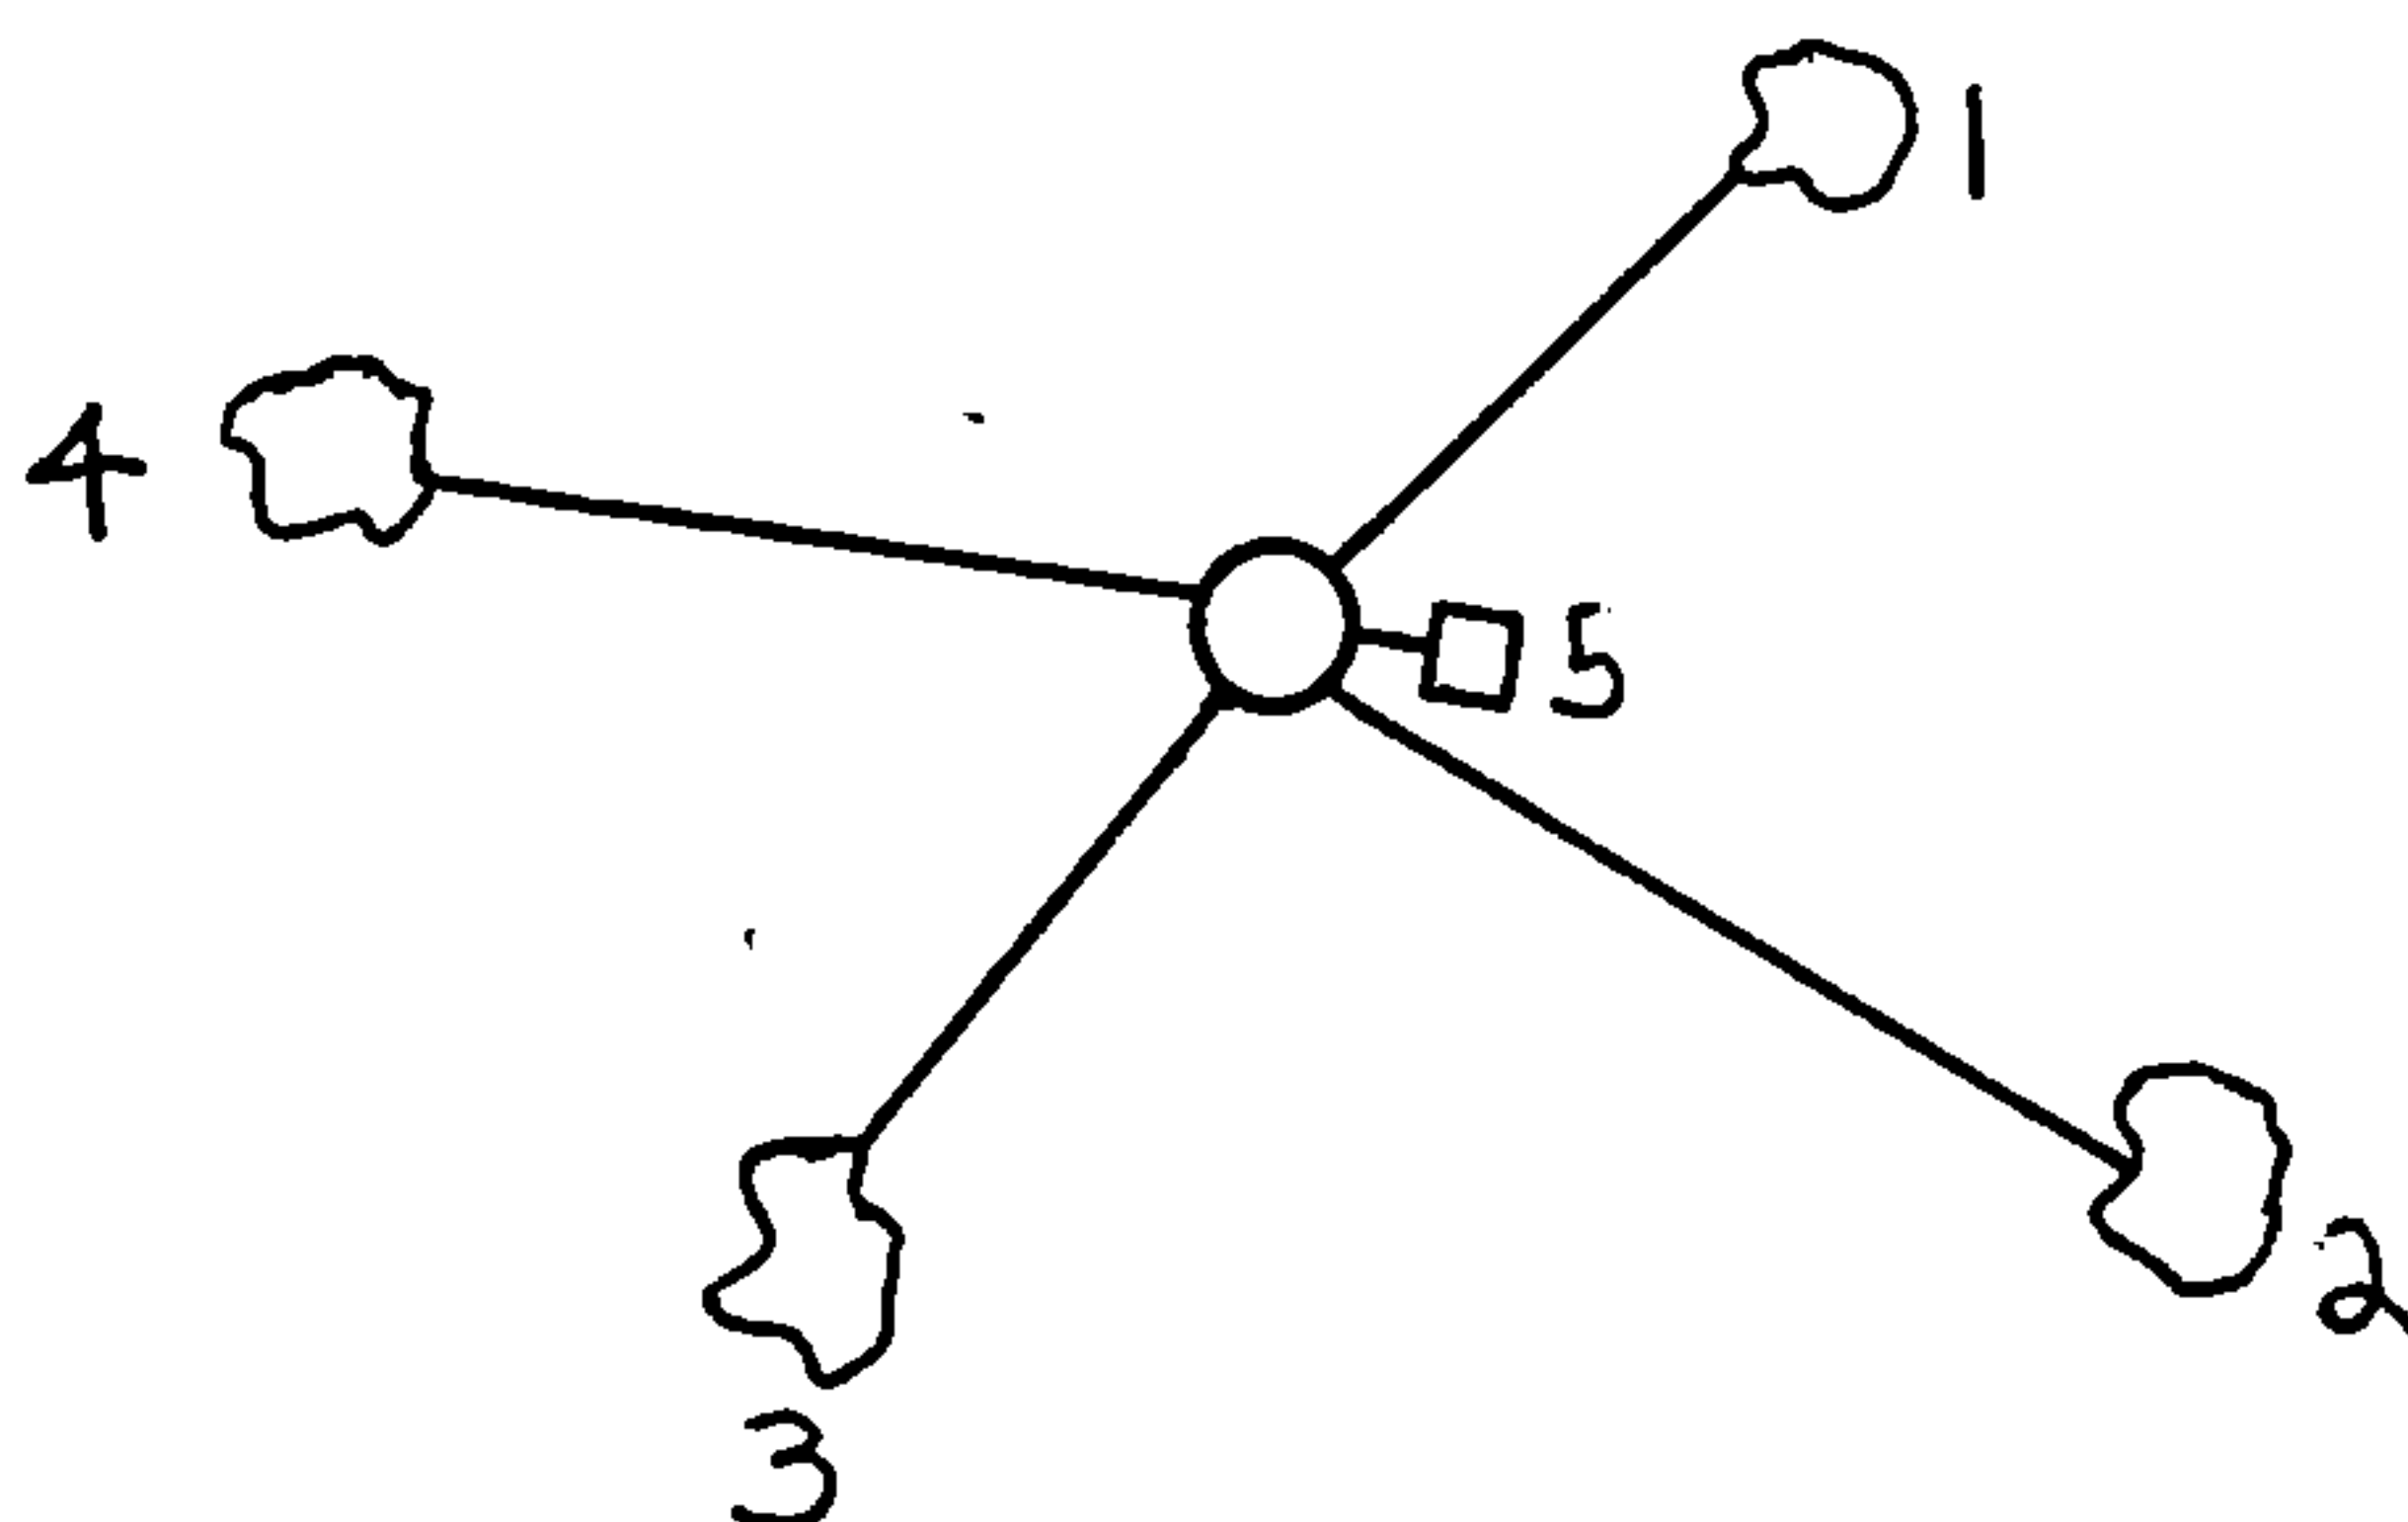

REGISTER'S OFFICE
Forest County, Wis.

Received for record this 21st day
of January, 1985 at

11:00 o'clock A.M. and

recorded in Vol. CORNER RESTORATIONS

on page 5-13

Paul Aschenbrenner
REGISTER

(e) Describe any material discrepancy between the location of the corner as restored or reestablished and the location of that corner as previously restored or reestablished by distance and direction. Show the discrepancy on the plan view drawing under (d), above. Show the distances between the corner as previously restored or reestablished and (1) the corner as restored or reestablished, and (2) to at least 2 of the witness monuments shown on the drawing in (d), above.

(f) Was the corner restored through acceptance of (1) an obliterated evidence location, or, (2) a found perpetuated location?

Found perpetuated corner location.

(g&h) Was the corner reestablished through lost corner proportionate methods? If so, show the method, including the directions and distances to other public land survey corners used as evidence or used for proportioning in determining the corner location?

(i) I, Milo E. Stefan

(type or print name) certify that the corner location shown on this record was determined by me or under my direction and control and that this U.S. Public Land Survey Monument Record is correct and complete to the best of my knowledge and belief.

Signature

Date

Affix Land Surveyor Seal

