


CERTIFIED LAND CORNER RESTORATION

Index No. **59**

State of Wisconsin }
County of Forest } ss.

I, Jean F. Resvick, do hereby
certify that on the 3rd day
of June, 19 64, I found
evidence of the Southeast Section
corner of Section 8
Township 34, North, Range
14 East, Fourth Principal Meridian,
as described hereon; and that from this evidence
I established a new monument and accessories
as described hereon to perpetuate the original
location of this corner.

Resident witnesses:

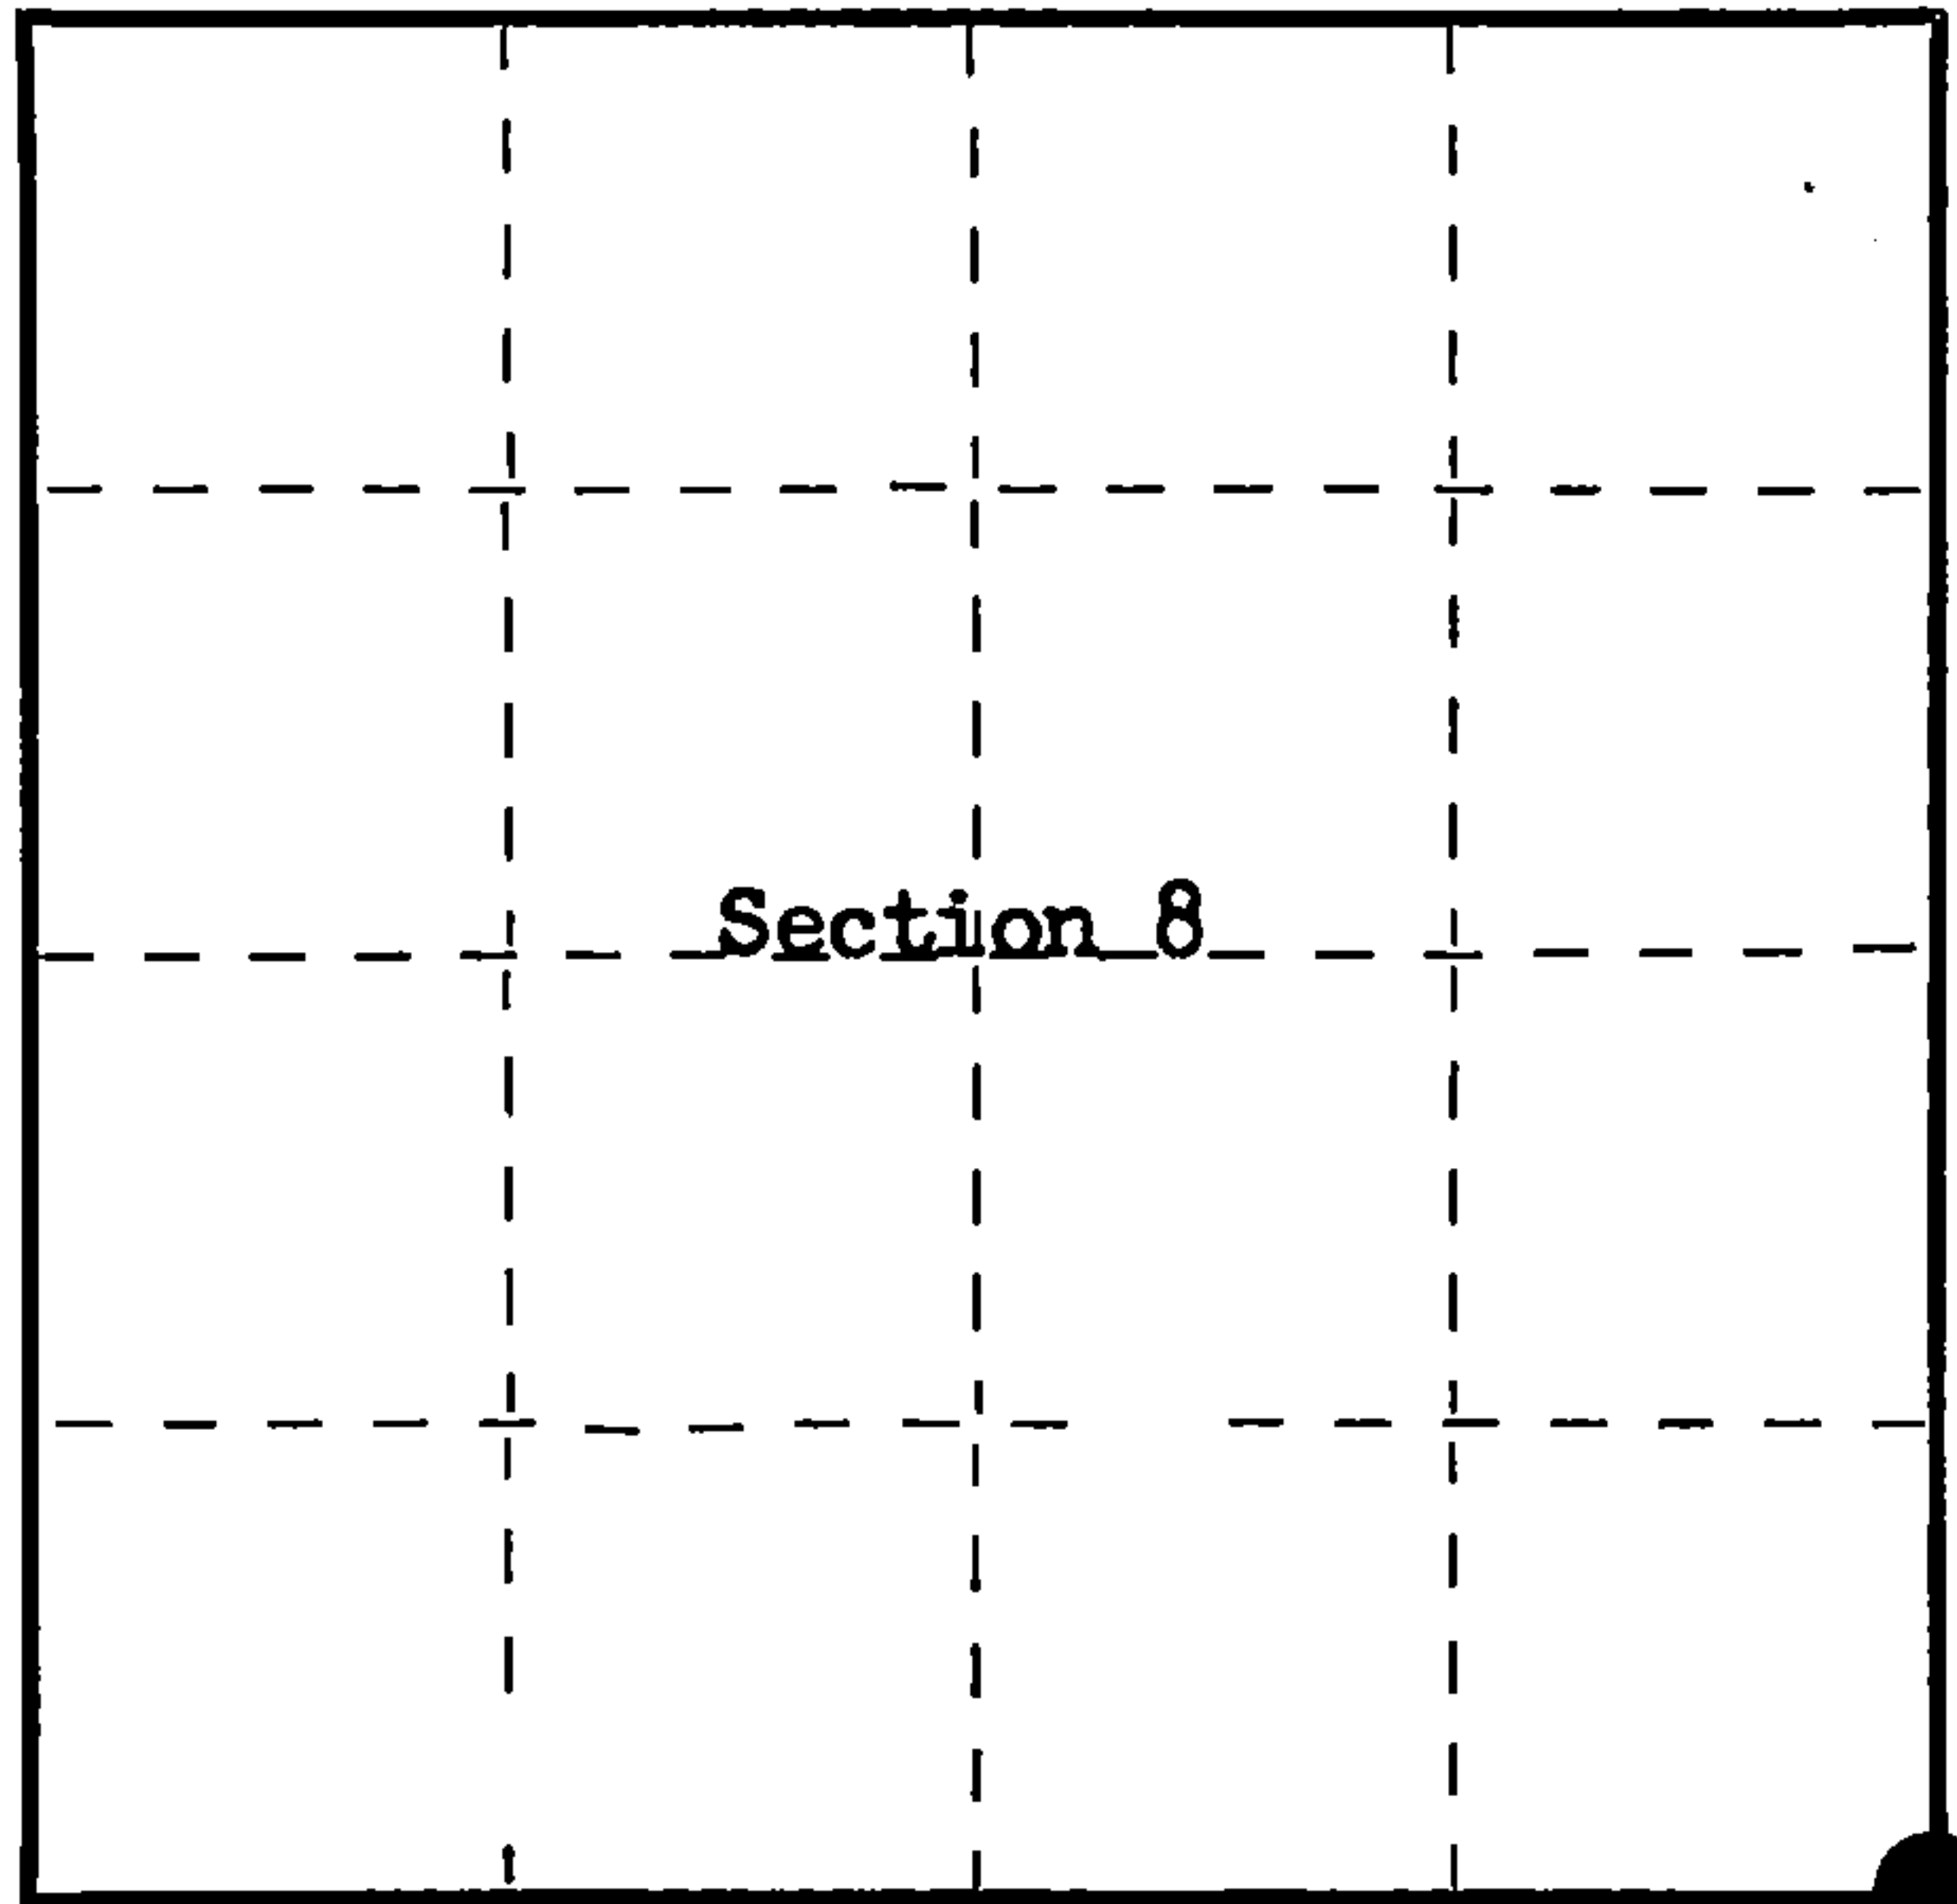

○ = Corner monument restored.

History of original corner establishment:
Surveyed in 1859 by James McBride
80.00 chains north between sections 16 & 17 set post
Linn 20", N52°W, 23 lks (15.18 ft.)
Hemlock 16", N51°E, 26 lks (17.16 ft.)
Hemlock 12", S57°E, 45 lks (29.70 ft.)
Hemlock 12", S33°W, 30 lks (19.80 ft.)

Description of corner evidence found:
Squared hemlock post under fallen Yellow Birch with Forest Service tag on.
Bottom of post found in mound of rock under yellow birch.
24-inch hemlock stump, backgrowth of scribing readable in hollow center,
S62°E, 29.70 ft. from post.
Hemlock stump, rotted, N46°E, 17.20 ft.
Hemlock stump, S45°W, 15.0 feet
Black cherry 8", N46°E, 4.45 ft., scribed S9 B.T.
Linn 6", S79°W, 9.70 ft., scribed S17 B.T.

Description of monument and accessories I established to perpetuate the original location of this corner.
Replaced hemlock post with 2-inch inside diameter, galvanized iron pipe, 5 feet long,
flanged at bottom, filled with concrete, with brass cap stamped:

T34N R14E
S 8 | S 9
S17 | S16
1964
S-802
from which the following new blazed and scribed bearing trees bear:
Ironwood 6", N34°E, 18.50 ft. (28.03 lks)
Maple 6", S20°E, 19.10 ft. (28.94 lks)
Maple 6", S61°W, 29.90 ft. (45.30 lks)
Maple 7", N55°W, 45.82 ft. (69.42 lks)

Dated at Rhineland, Wis., this 3rd day of August, 1964.

Signature Jean F. Resvick Title Cadastral Surveyor Registration No. S-802
(County Surveyor, Registered Land Surveyor, or other duly authorized official)

Office of Register of Deeds, County of Forest, I hereby certify that the within
instrument was filed in this office for record on the 21 day of Oct, 19 64
at 11 o'clock A. M. Doc. #89306 Vol. 1 Page J-9 CORNER RESTORATIONS

Anna Peterson 89306
(Register of Deeds)

By _____ Deputy

FORM 985 H. C. MILLER CO., MILWAUKEE

14311408000