


U. S. PUBLIC LAND SURVEY MONUMENT RECORD

INSTRUCTIONS:

This record shall show the location of the corner and shall include all of the following nine elements (a through i).

- (a) Identify the corner by reference to the U.S. public land survey system.
- = Corner monument restored.

Section Corner to Sections 13, 14, 23 and 24, T.34N., R.14E., Forest County, WI.

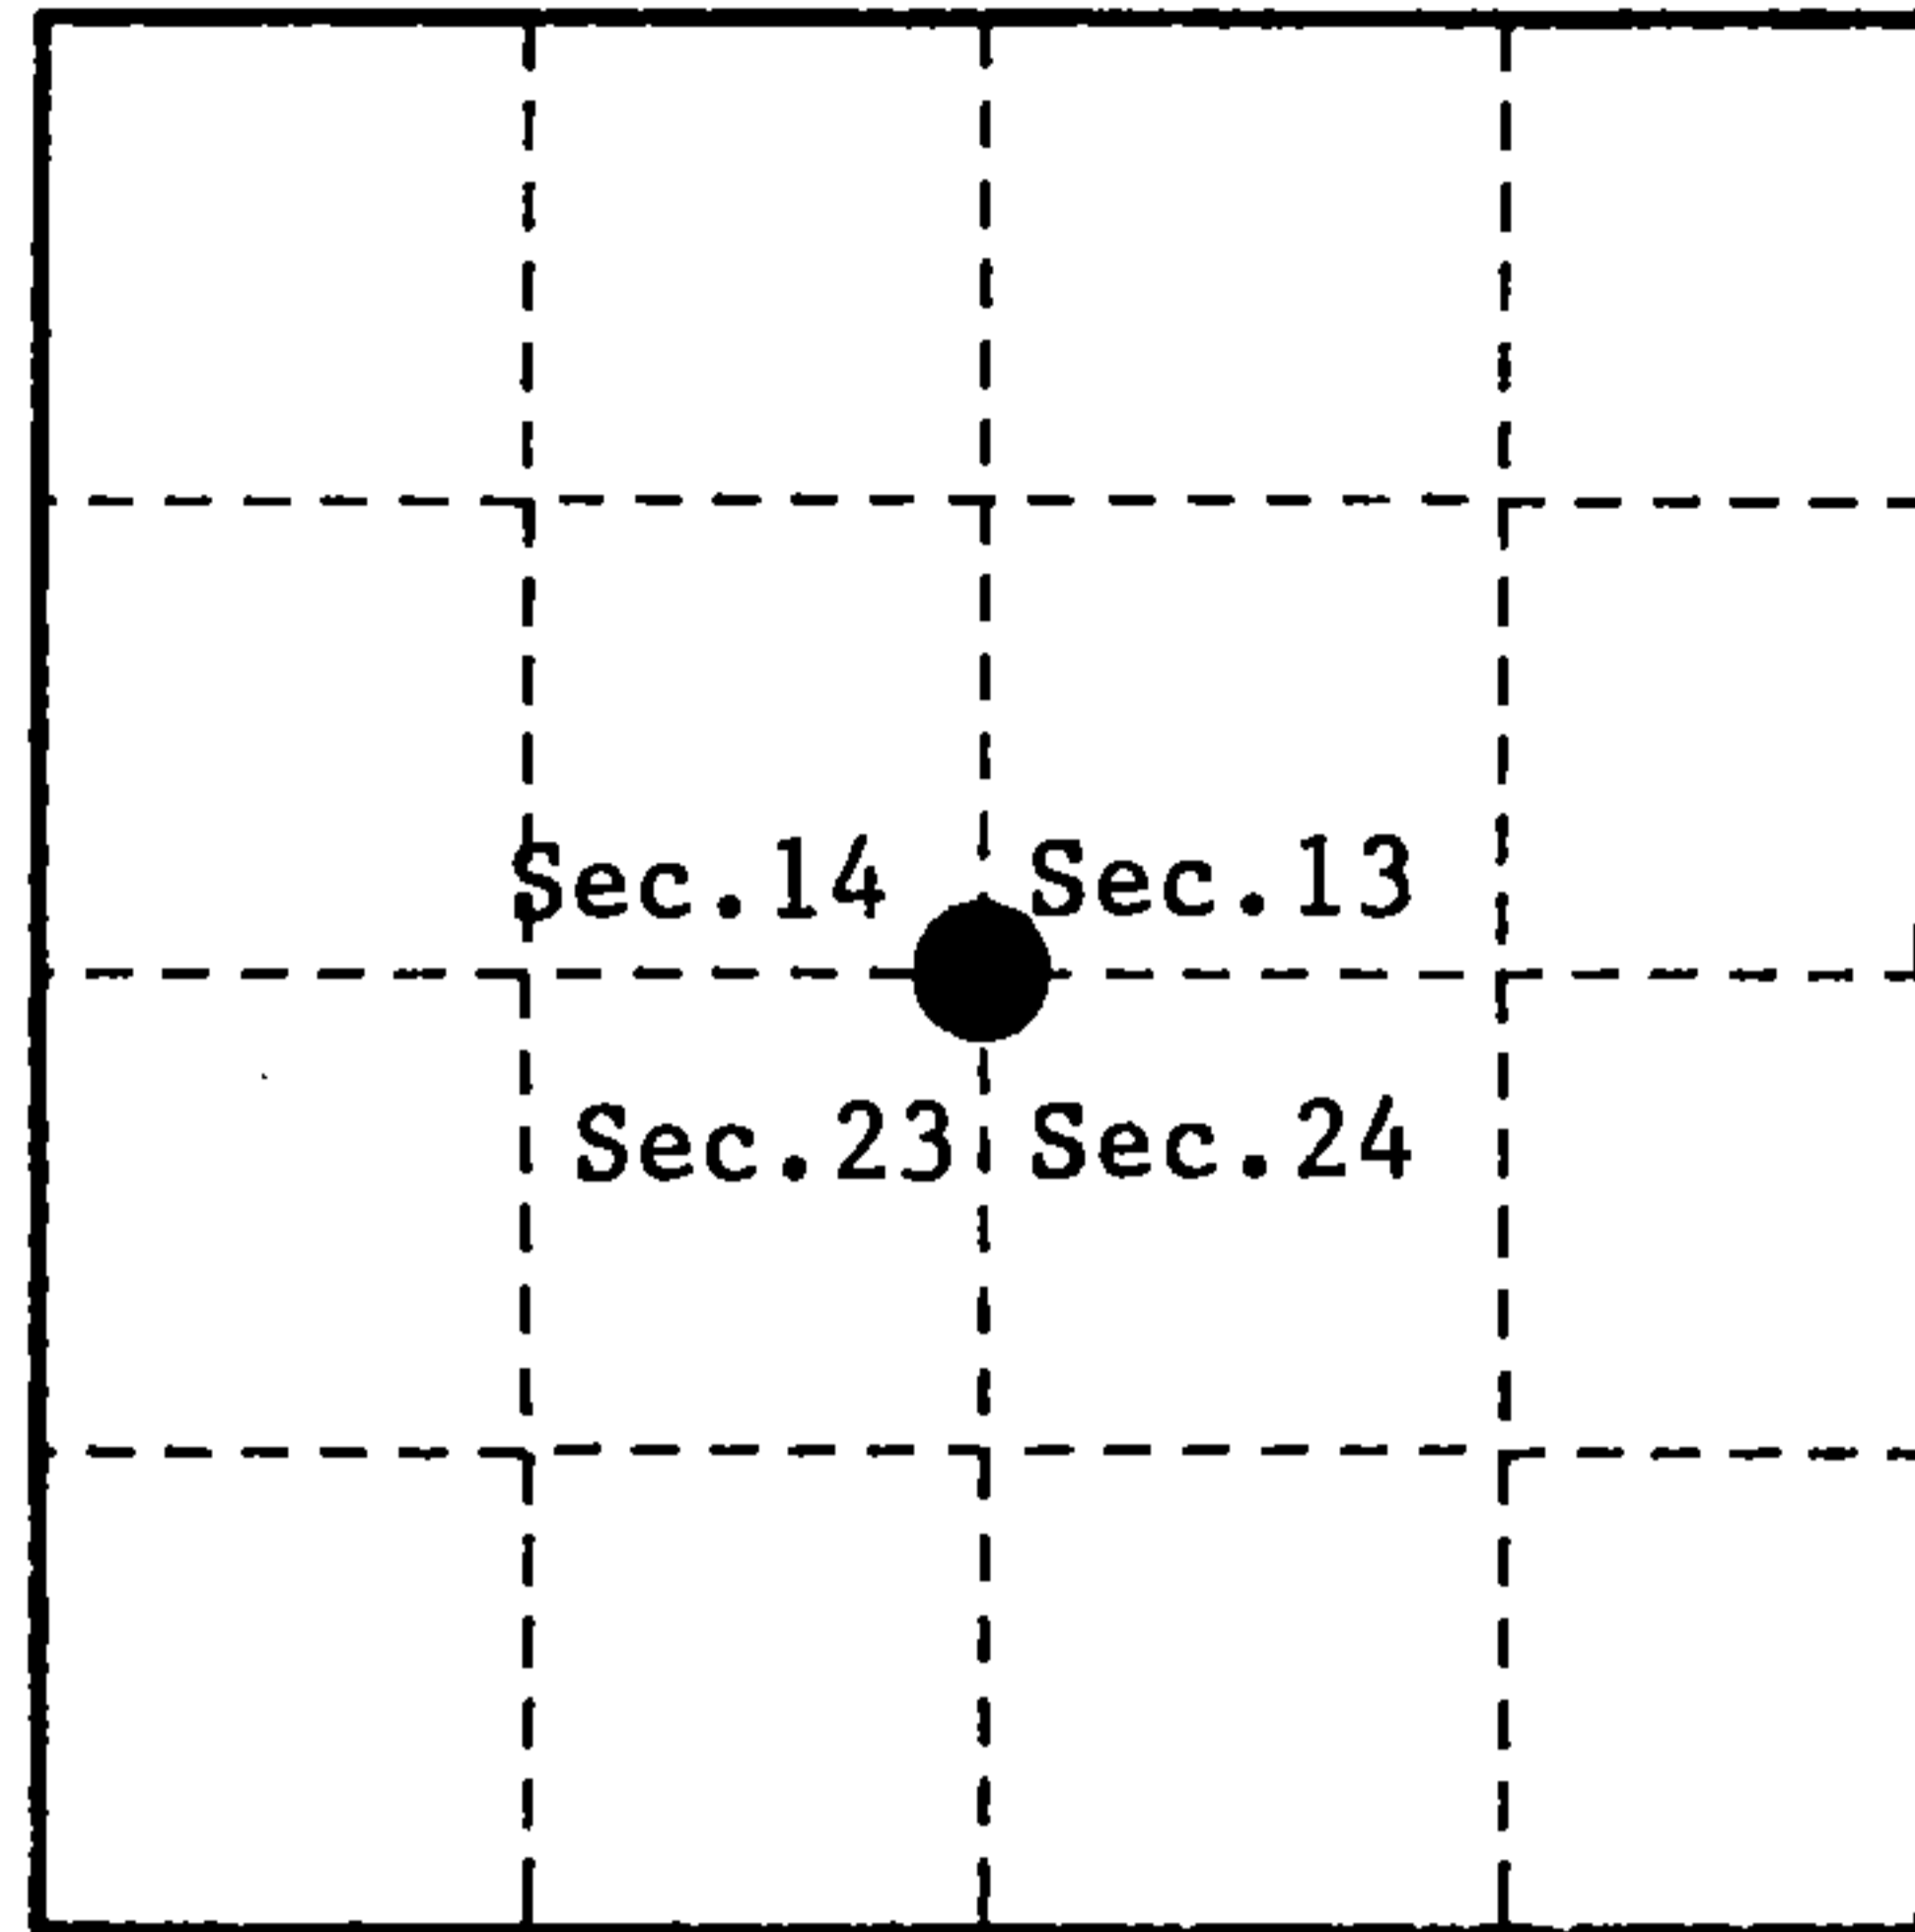

- (b) Describe any record evidence, monument evidence, occupational evidence, testimonial evidence or any other material evidence you considered, and whether the monument was found or placed.

Original survey in 1859 by James McBride. Set wood post and the following bearing trees; Sugar, 10", N.39°E., 24 links, Hemlock, 10", S.09°E., 48 links, Sugar, 10", S.53°W., 14 links, Sugar, 12", N.19°W., 31 links.


On February 27, 1980 Milo Stefan, R.L.S., talked to local landowner Ed Rommel. He stated that the corner position is at the intersection of roads, North, South and West, and in line with a fence line East. Stefan accepted this evidence as the best available and set a 2" x 30" aluminum monument with a tablet stamped to identify the corner. Made the following new bearing trees; Sugar, 6", N.77°E., 42.24 feet, Sugar, 7", S.25°E., 56.77 feet, Sugar, 22", S.63°W., 106.03 feet, Sugar, 18", N.31°W., 99.06 feet, Steel Sign Post, East, 19.60 feet.

On October 6, 1993, Alan Harrison, R.L.S, found the monument and bearing trees as noted above. Removed monument for road construction.

On August 27, 1994, Alan Harrison, R.L.S., set a railroad spike flush with a new blacktop road surface, and set a 2 1/2" x 36" aluminum witness corner monument East, 22.00 feet. Steel Sign Post bears West, 2.30 feet from witness corner monument.

- (c) In the plan view drawing below, provide reference ties to at least 4 witness monuments, or, if the location is within a municipality, to at least 2 witness monuments. (witness monuments shall be made of concrete, natural stone, iron or other equally durable material.)

- (d) Show a plan view drawing depicting the relevant monuments and reference ties which is sufficient in detail to enable accurate relocation of the corner monument if the corner monument is disturbed. Indicate north.
1. Railroad Spike in blacktop.
 2. Sugar, 6", N.77°E., 42.24 feet.
 3. 2 1/2" x 36" Witness Corner Monument, East, 22.00 feet.
 4. Sugar, 7", S.25°E., 56.77 feet.
 5. Sugar, 22", S.63°W., 106.03 feet.
 6. Sugar, 18", N.31°W., 99.06 feet.
 7. Steel Sign Post, 2.30 feet West of Witness Corner Monument.

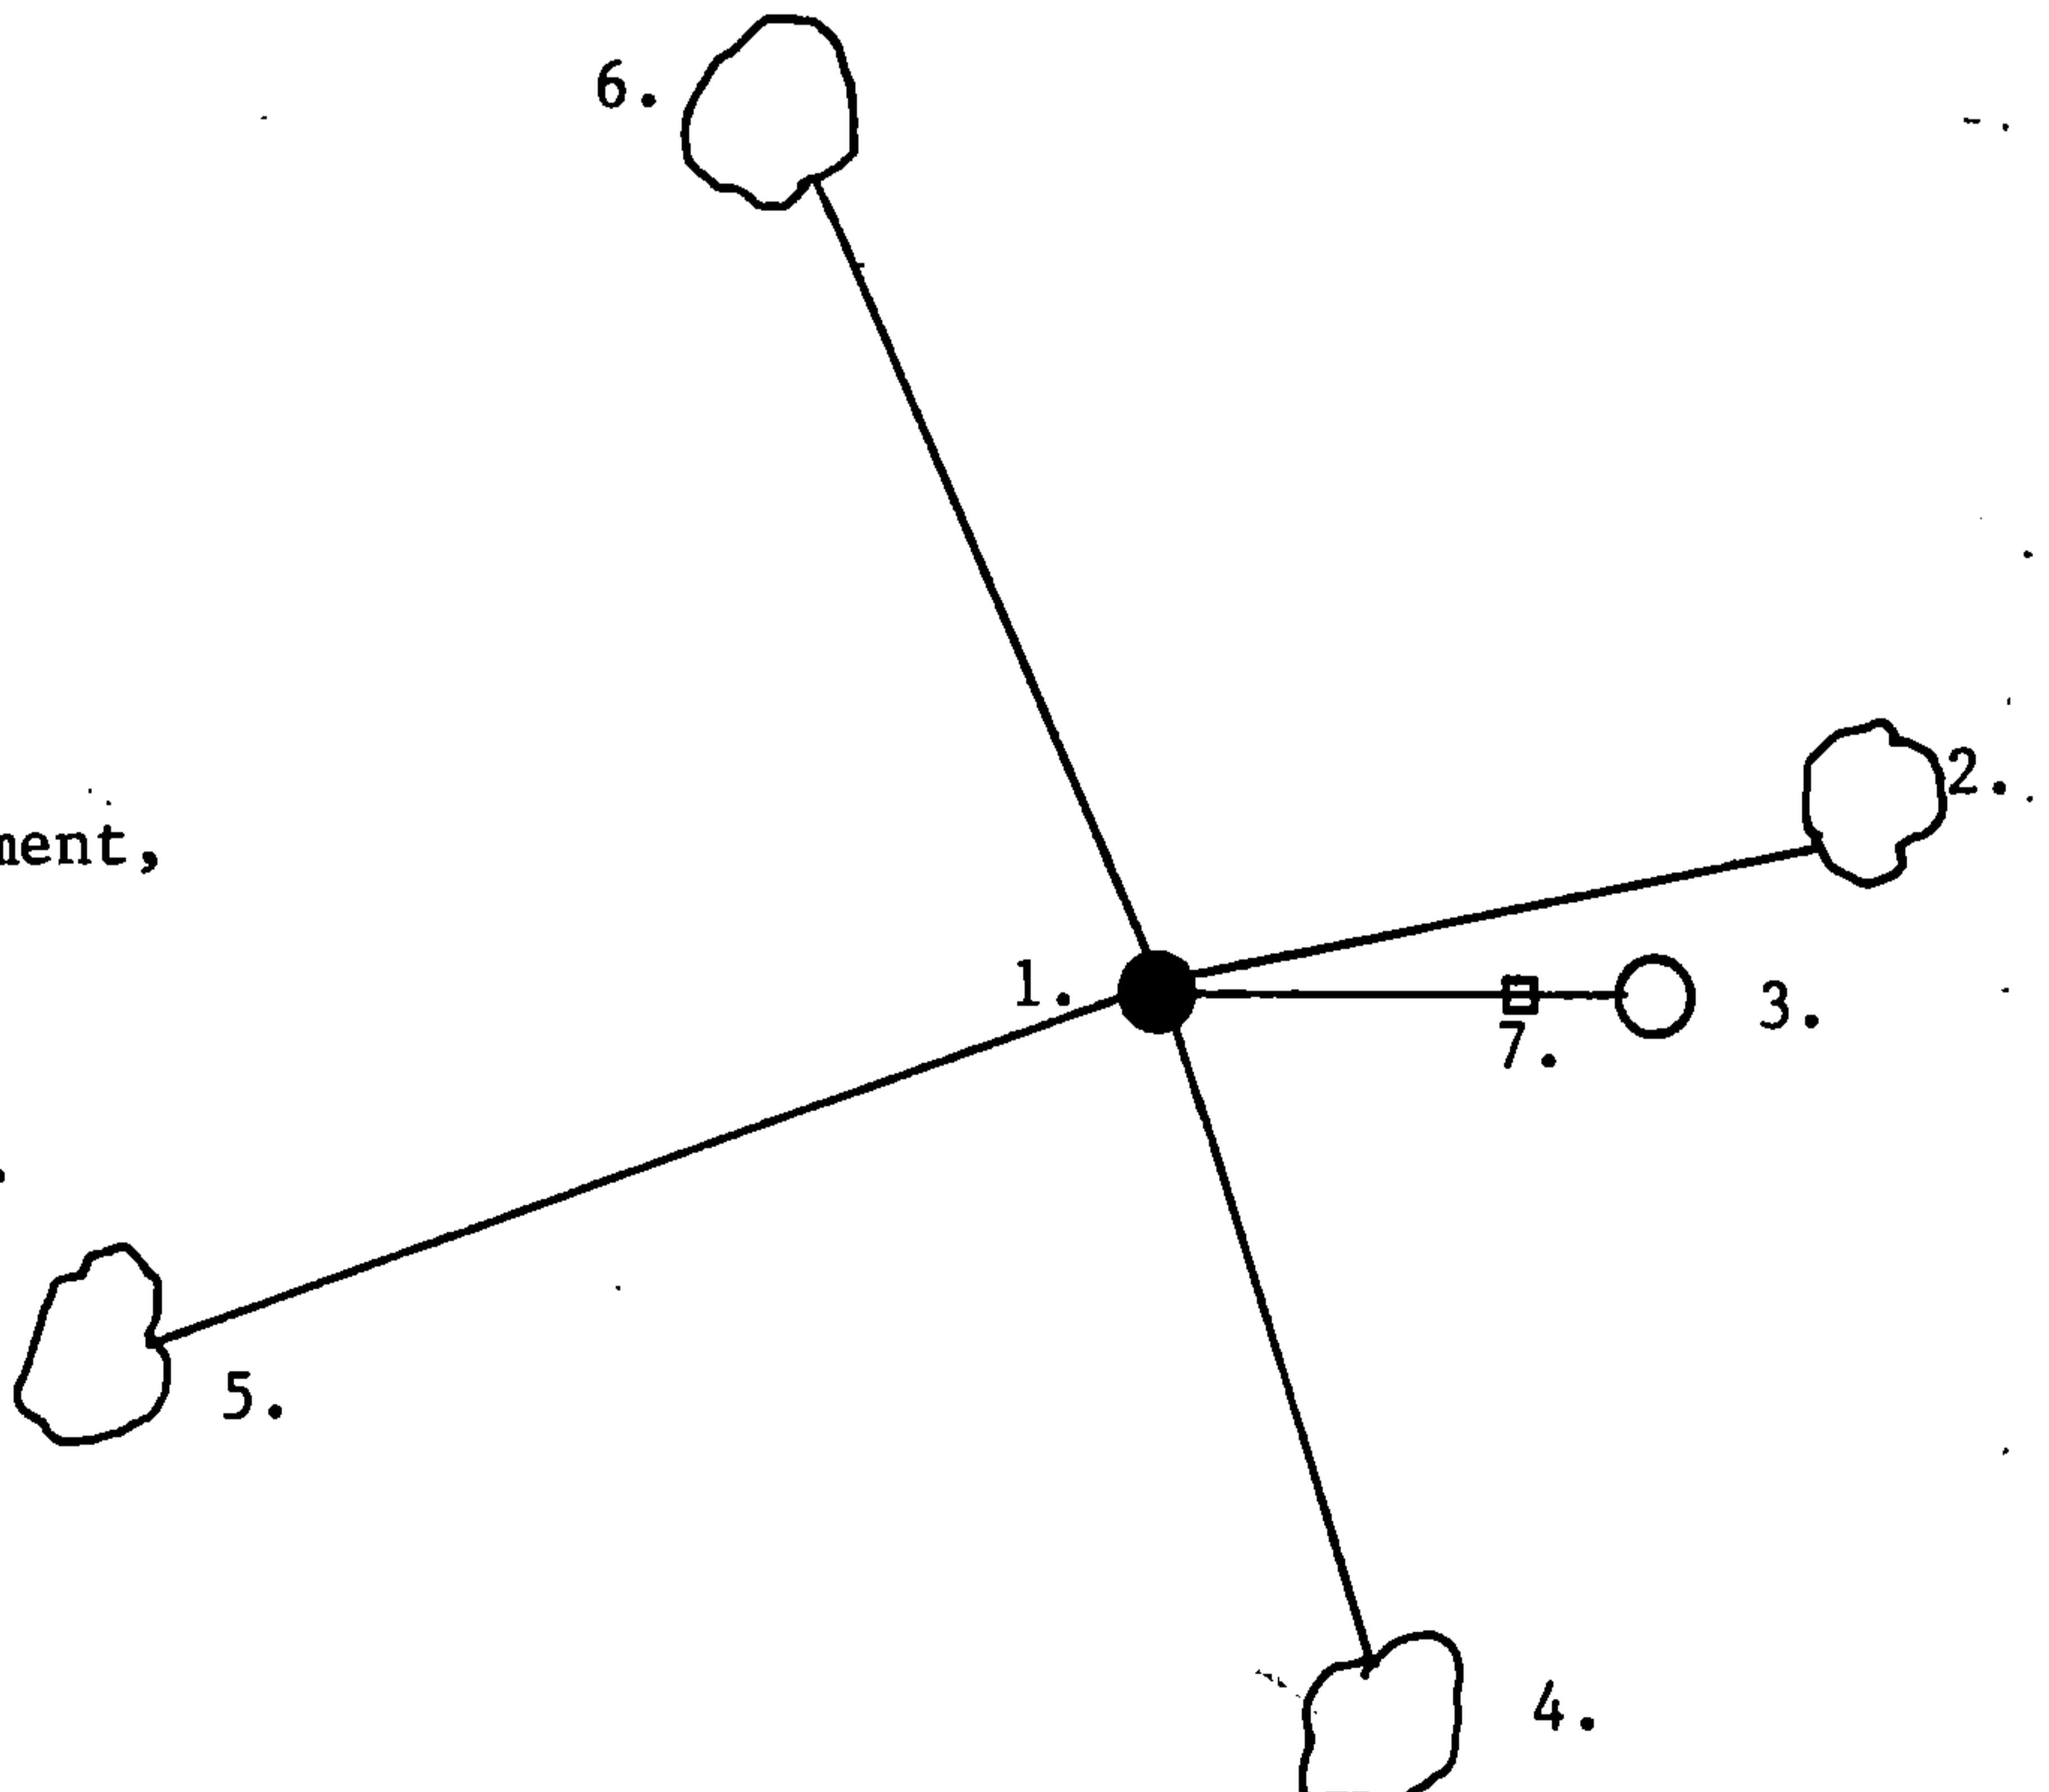

(e) Describe any material discrepancy between the location of the corner as restored or reestablished and the location of that corner as previously restored or reestablished by distance and direction. Show the discrepancy on the plan view drawing under (d), above. Show the distances between the corner as previously restored or reestablished and (1) the corner as restored or reestablished, and (2) to at least 2 of the witness monuments shown on the drawing in (d), above.

None

(f) Was the corner restored through acceptance of (1) an obliterated evidence location, or, (2) a found perpetuated location?

(2)

(g & h) Was the corner reestablished through lost corner proportionate methods? If so, show the method, including the directions and distances to other public land survey corners used as evidence or used for proportioning in determining the corner location?

No

REGISTER'S OFFICE
Forest County, Wis.

Received for record this 23rd day
of March, A.D. 19 97 at
9:00 o'clock A.M. and recorded
in Vol. Land Restorations
page 34-14-11-21

Paul C. Little Deputy
Register of Deeds

Alan D. Harrison

(1) I, _____
(type or print name) certify that the corner location shown
on this record was determined by me or under my direction and
control and that this U.S. Public Land Survey Monument Record is
correct and complete to the best of my knowledge and belief.

Alan D. Harrison

Signature

10/31/94

Date

CERTIFICATE READY FOR FILING:

Sue Vap

District Ranger

