


U. S. PUBLIC LAND SURVEY MONUMENT RECORD

INSTRUCTIONS: This record shall show the location of the corner and shall include all of the following nine elements (a through i).

- (a) Identify the corner by reference to the U.S. public land survey system.
- = Corner monument restored.

Quarter corner to Sections 19 and 24, T.34N., R.14-15E.

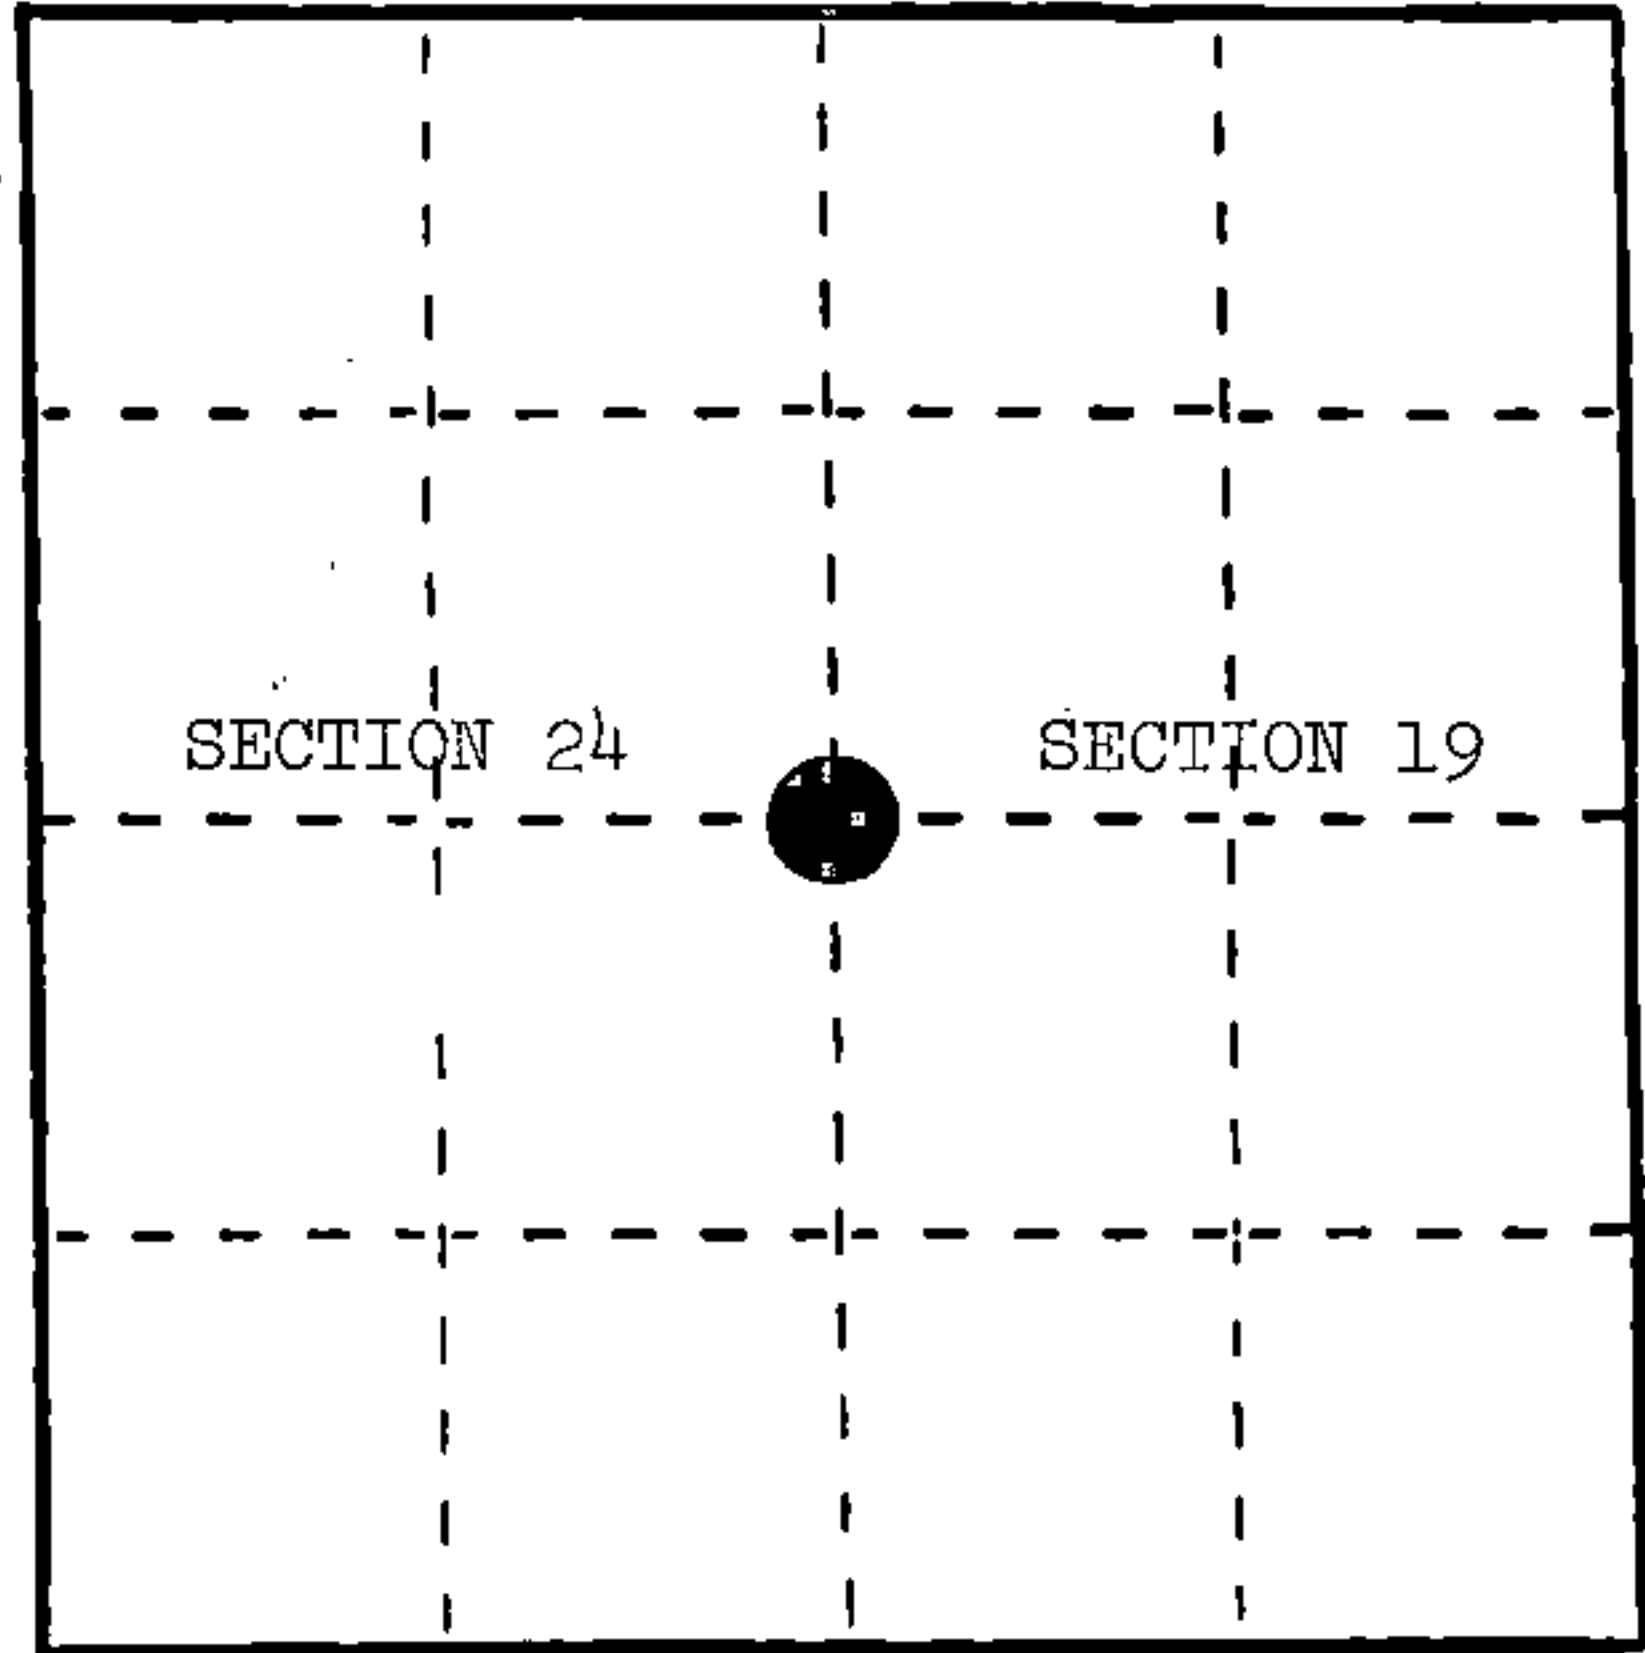

REGISTER'S OFFICE
 Forest County, Wis.
 Received for record this 14th day
 of March A.D., 1986 at
10:35 o'clock A.M. and recorded
 in Vol. CORNER RESTORATIONS
 page 7-1
Saul A. Schaubrenner
 Register of Deeds

- (b) Describe any record evidence, monument evidence, occupational evidence, testimonial evidence or any other material evidence you considered, and whether the monument was found or placed.

July, 1857, Artemas Curtis placed a wood post with the following BTs: 25" Hemlock, S.85°E., 26 links; 12" White Birch, N.35°W., 39 links.

In 1909, N. H. Smith located original corner and made new BTs: 7" Sugar, N.1/2°W., 19 1/2 links; 23" Sugar, S.31°W., 24.66 links. In January, 1909, J. A. Melindy found original corner and placed a 4" x 4" x 36" Elm post with stone on each side of post (east and west).


August 20, 1980, Milo E. Stefan found fence corner and stump holes to fit to original BTs and Smith's 7" Sugar.

May 5, 1985, Milo E. Stefan, using recently found J. A. Melindy notes, located the stone alongside post hole with original Hemlock stump and Smith's 23" Sugar, a large stump at proper bearing and distance. Original Birch stump is only a stump hole.

- (c) In the plan view drawing below, provide reference ties to at least 4 witness monuments, or, if the location is within a municipality, to at least 2 witness monuments. (Witness monuments shall be made of concrete, natural stone, iron or other equally durable material.) Describe witness monuments.

- (d) Show a plan view drawing depicting the relevant monuments and reference ties which is sufficient in detail to enable accurate relocation of the corner monument if the corner monument is disturbed. Indicate north.

1. 2" x 30" aluminum monument
2. Sugar Maple, 10", N.35°E., 8.91 feet
3. Sugar Maple, 6", S.28°E., 25.90 feet
4. Sugar Maple, 10", N.80°W., 83.42 feet
5. Steel Sign Post, South, 2.0 feet
6. Stefan, 1980--Position bears N.88°12'44"W., 39.35 feet.

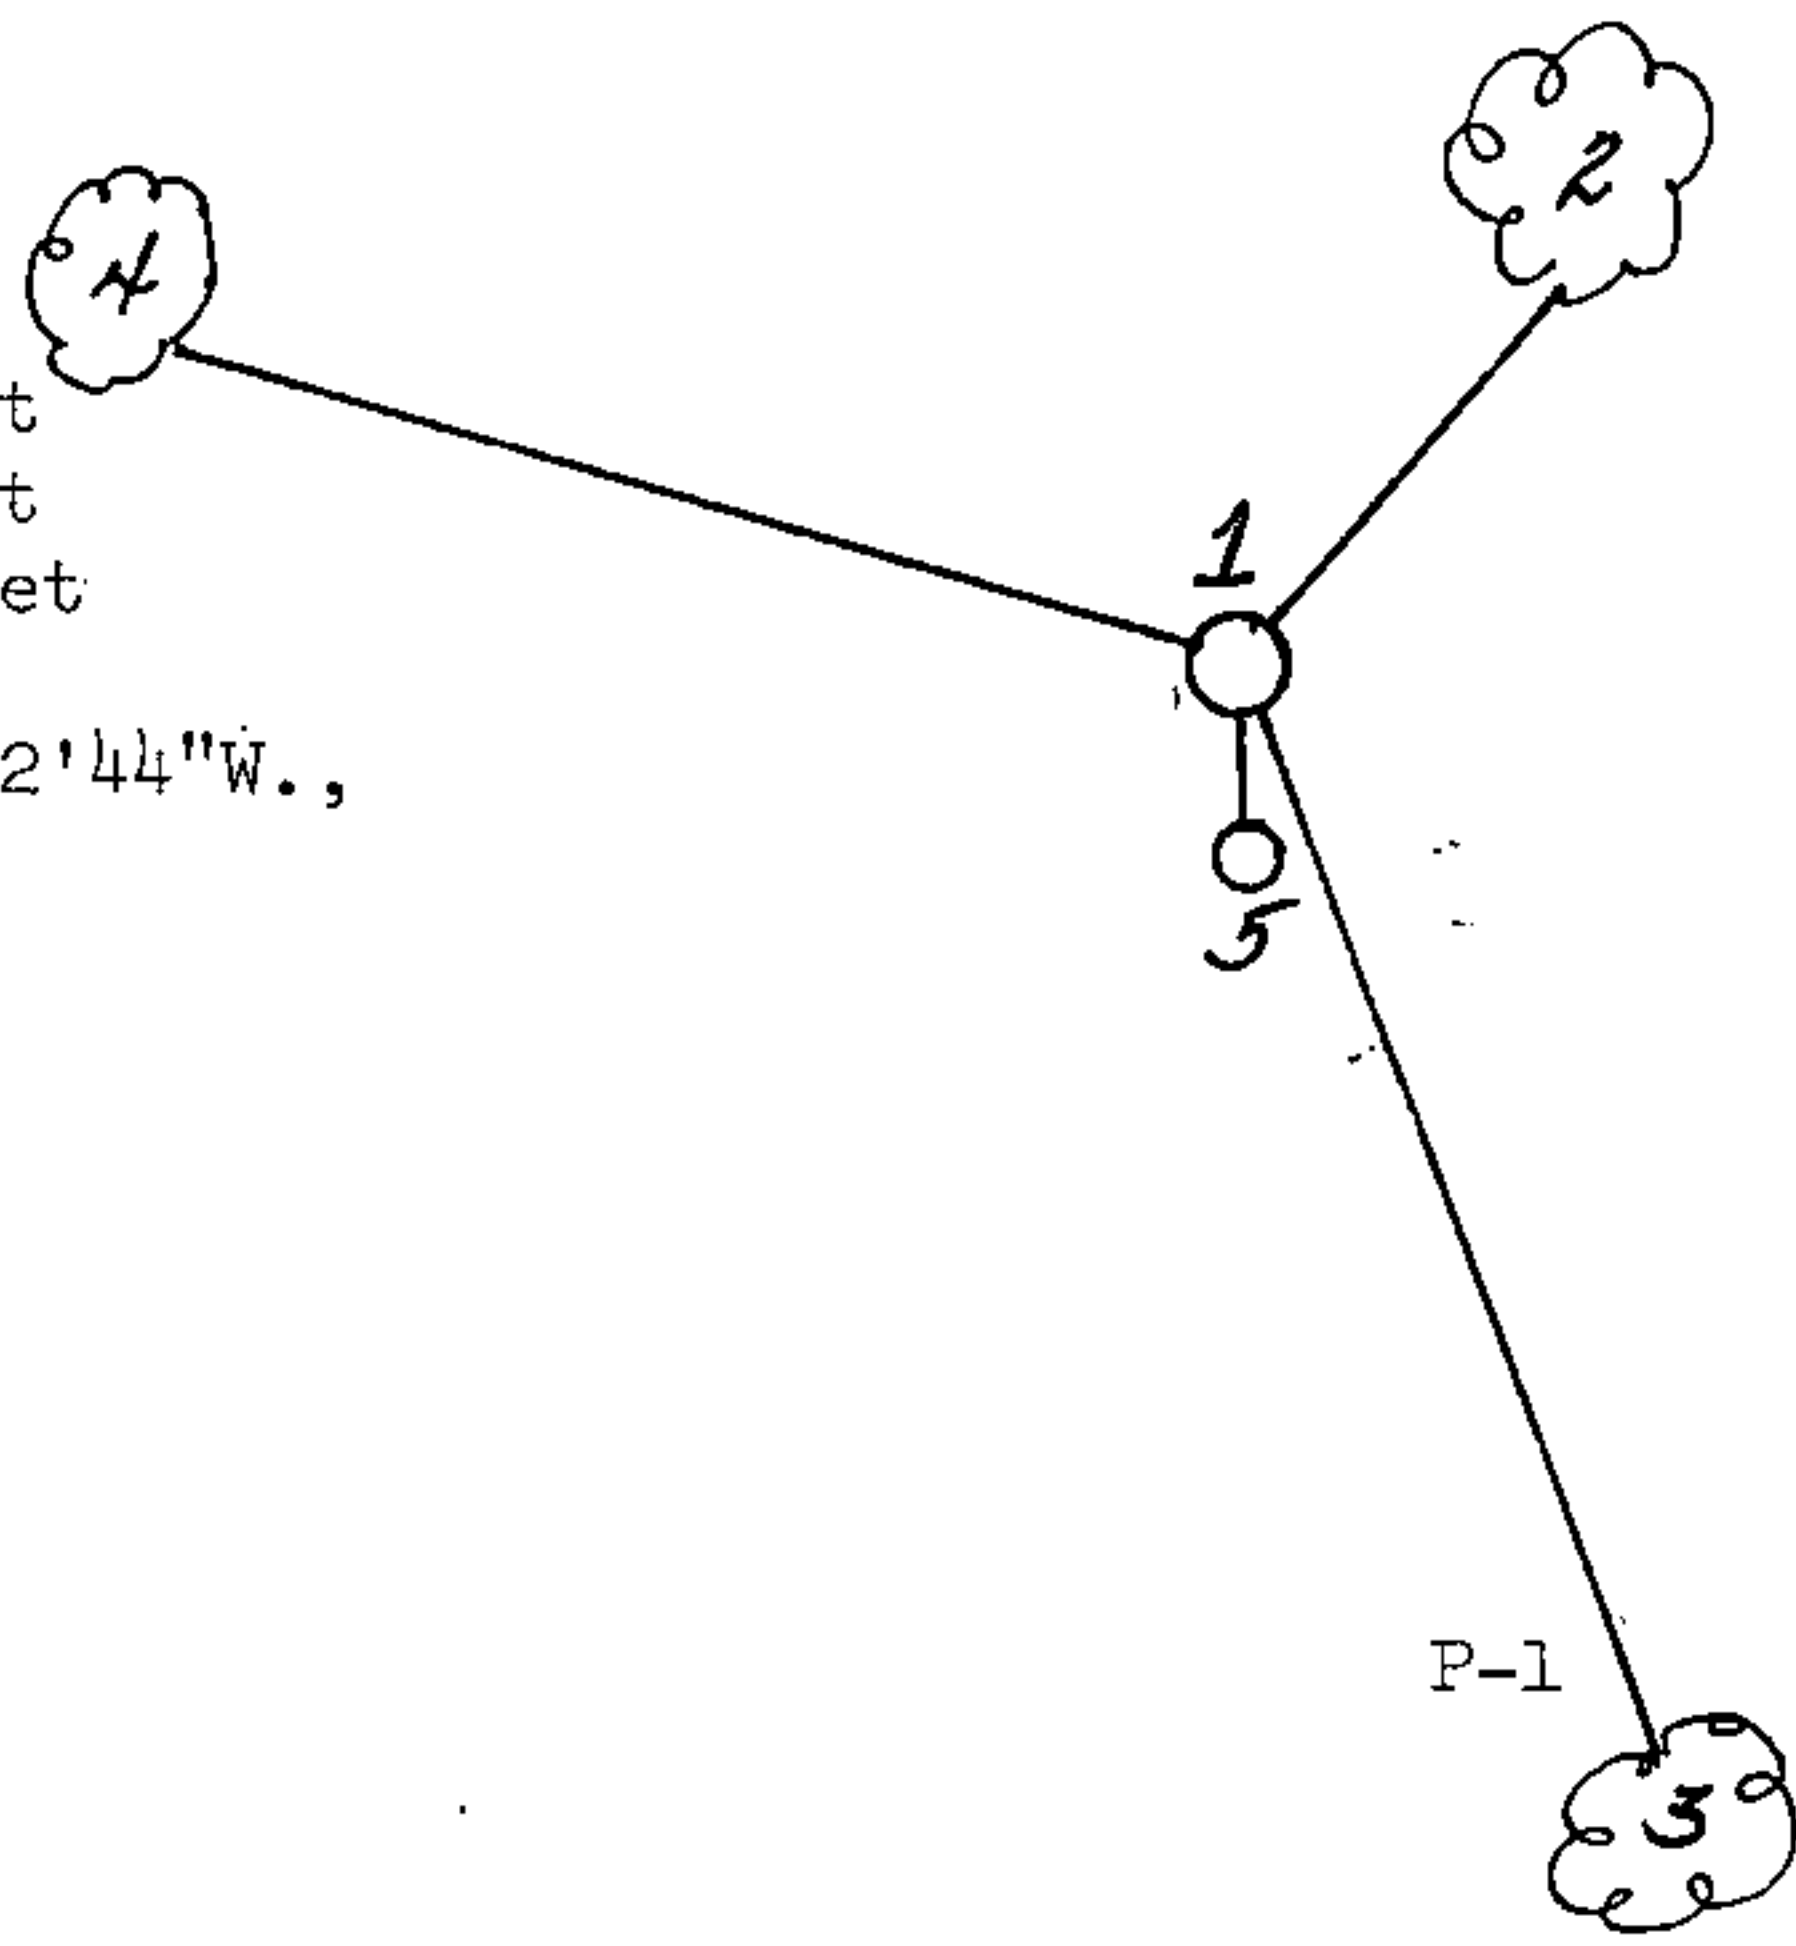

(e) Describe any material discrepancy between the location of the corner as restored or reestablished and the location of that corner as previously restored or reestablished by distance and direction. Show the discrepancy on the plan view drawing under (d), above. Show the distances between the corner as previously restored or reestablished and (1) the corner as restored or reestablished, and (2) to at least 2 of the witness monuments shown on the drawing in (d), above.

Notes by J. J. Melindy were located in 1984. These notes indicated that Melindy had the original scribed BTs and called the stones and two new BTs.

(f) Was the corner restored through acceptance of (1) an obliterated evidence location, or, (2) a found perpetuated location?


(1) an obliterated evidence location.

(g&h) Was the corner reestablished through lost corner proportionate methods? If so, show the method, including the directions and distances to other public land survey corners used as evidence or used for proportioning in determining the corner location?

(1) I, Milo E. Stefan
(Type or print name) certify that the corner location shown on this record was determined by me or under my direction and control and that this U.S. Public Land Survey Monument Record is correct and complete to the best of my knowledge and belief.

Milo E. Stefan
Signature

2/19/86
Date

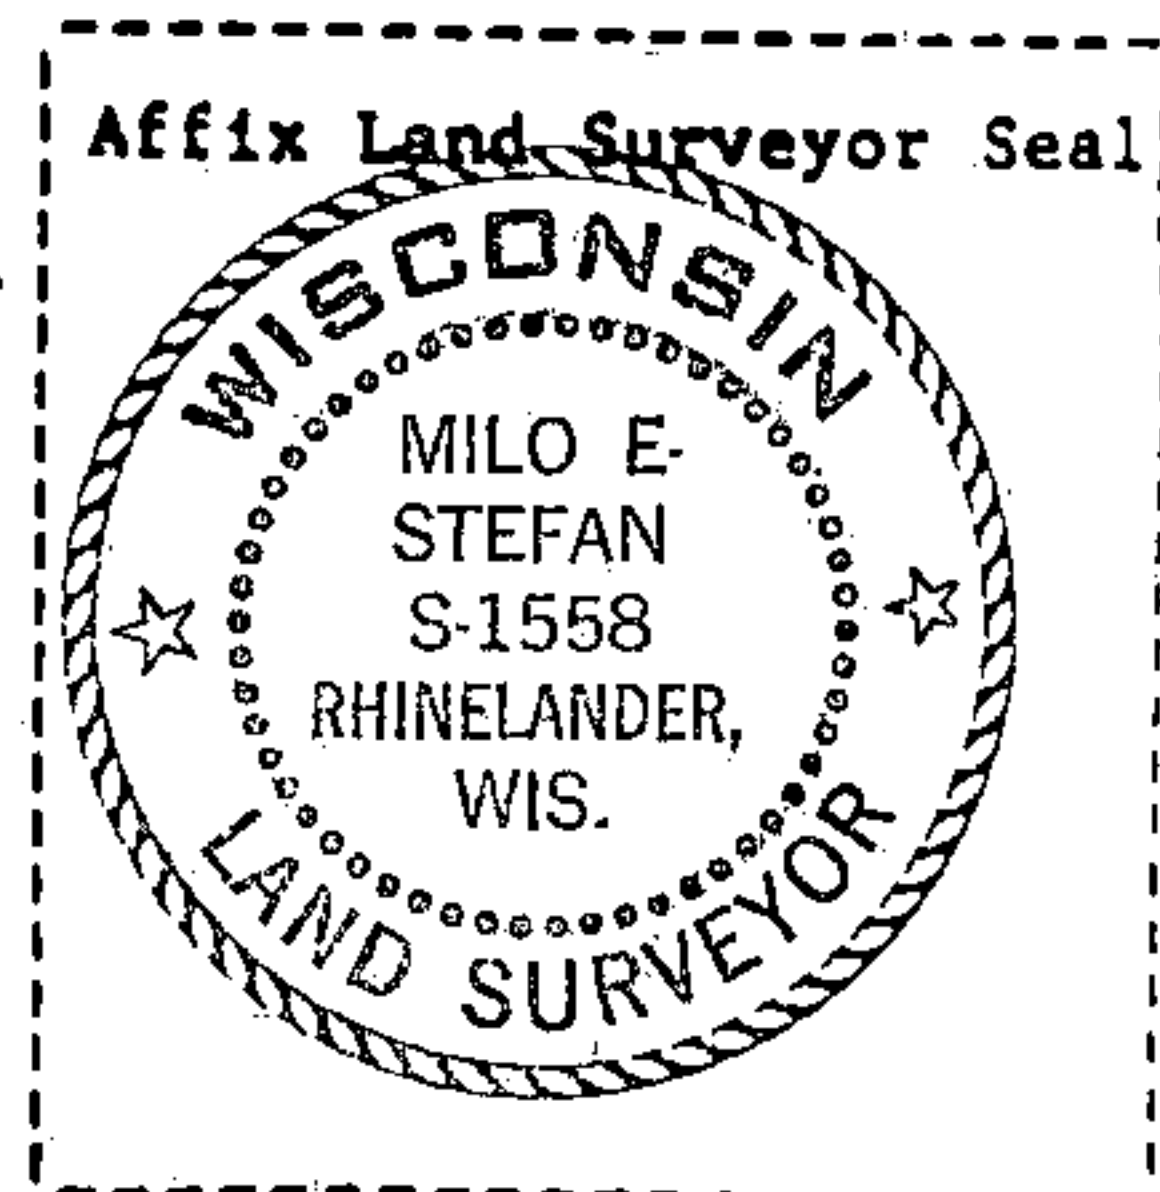


U. S. PUBLIC LAND SURVEY MONUMENT RECORD

INSTRUCTIONS: This record shall show the location of the corner and shall include all of the following nine elements (a through i).

(a) Identify the corner by reference to the U.S. public land survey system.

○ = Corner monument restored.

Quarter corner to Sections 19 and 24, T.34N., R.13E., and R.14E.

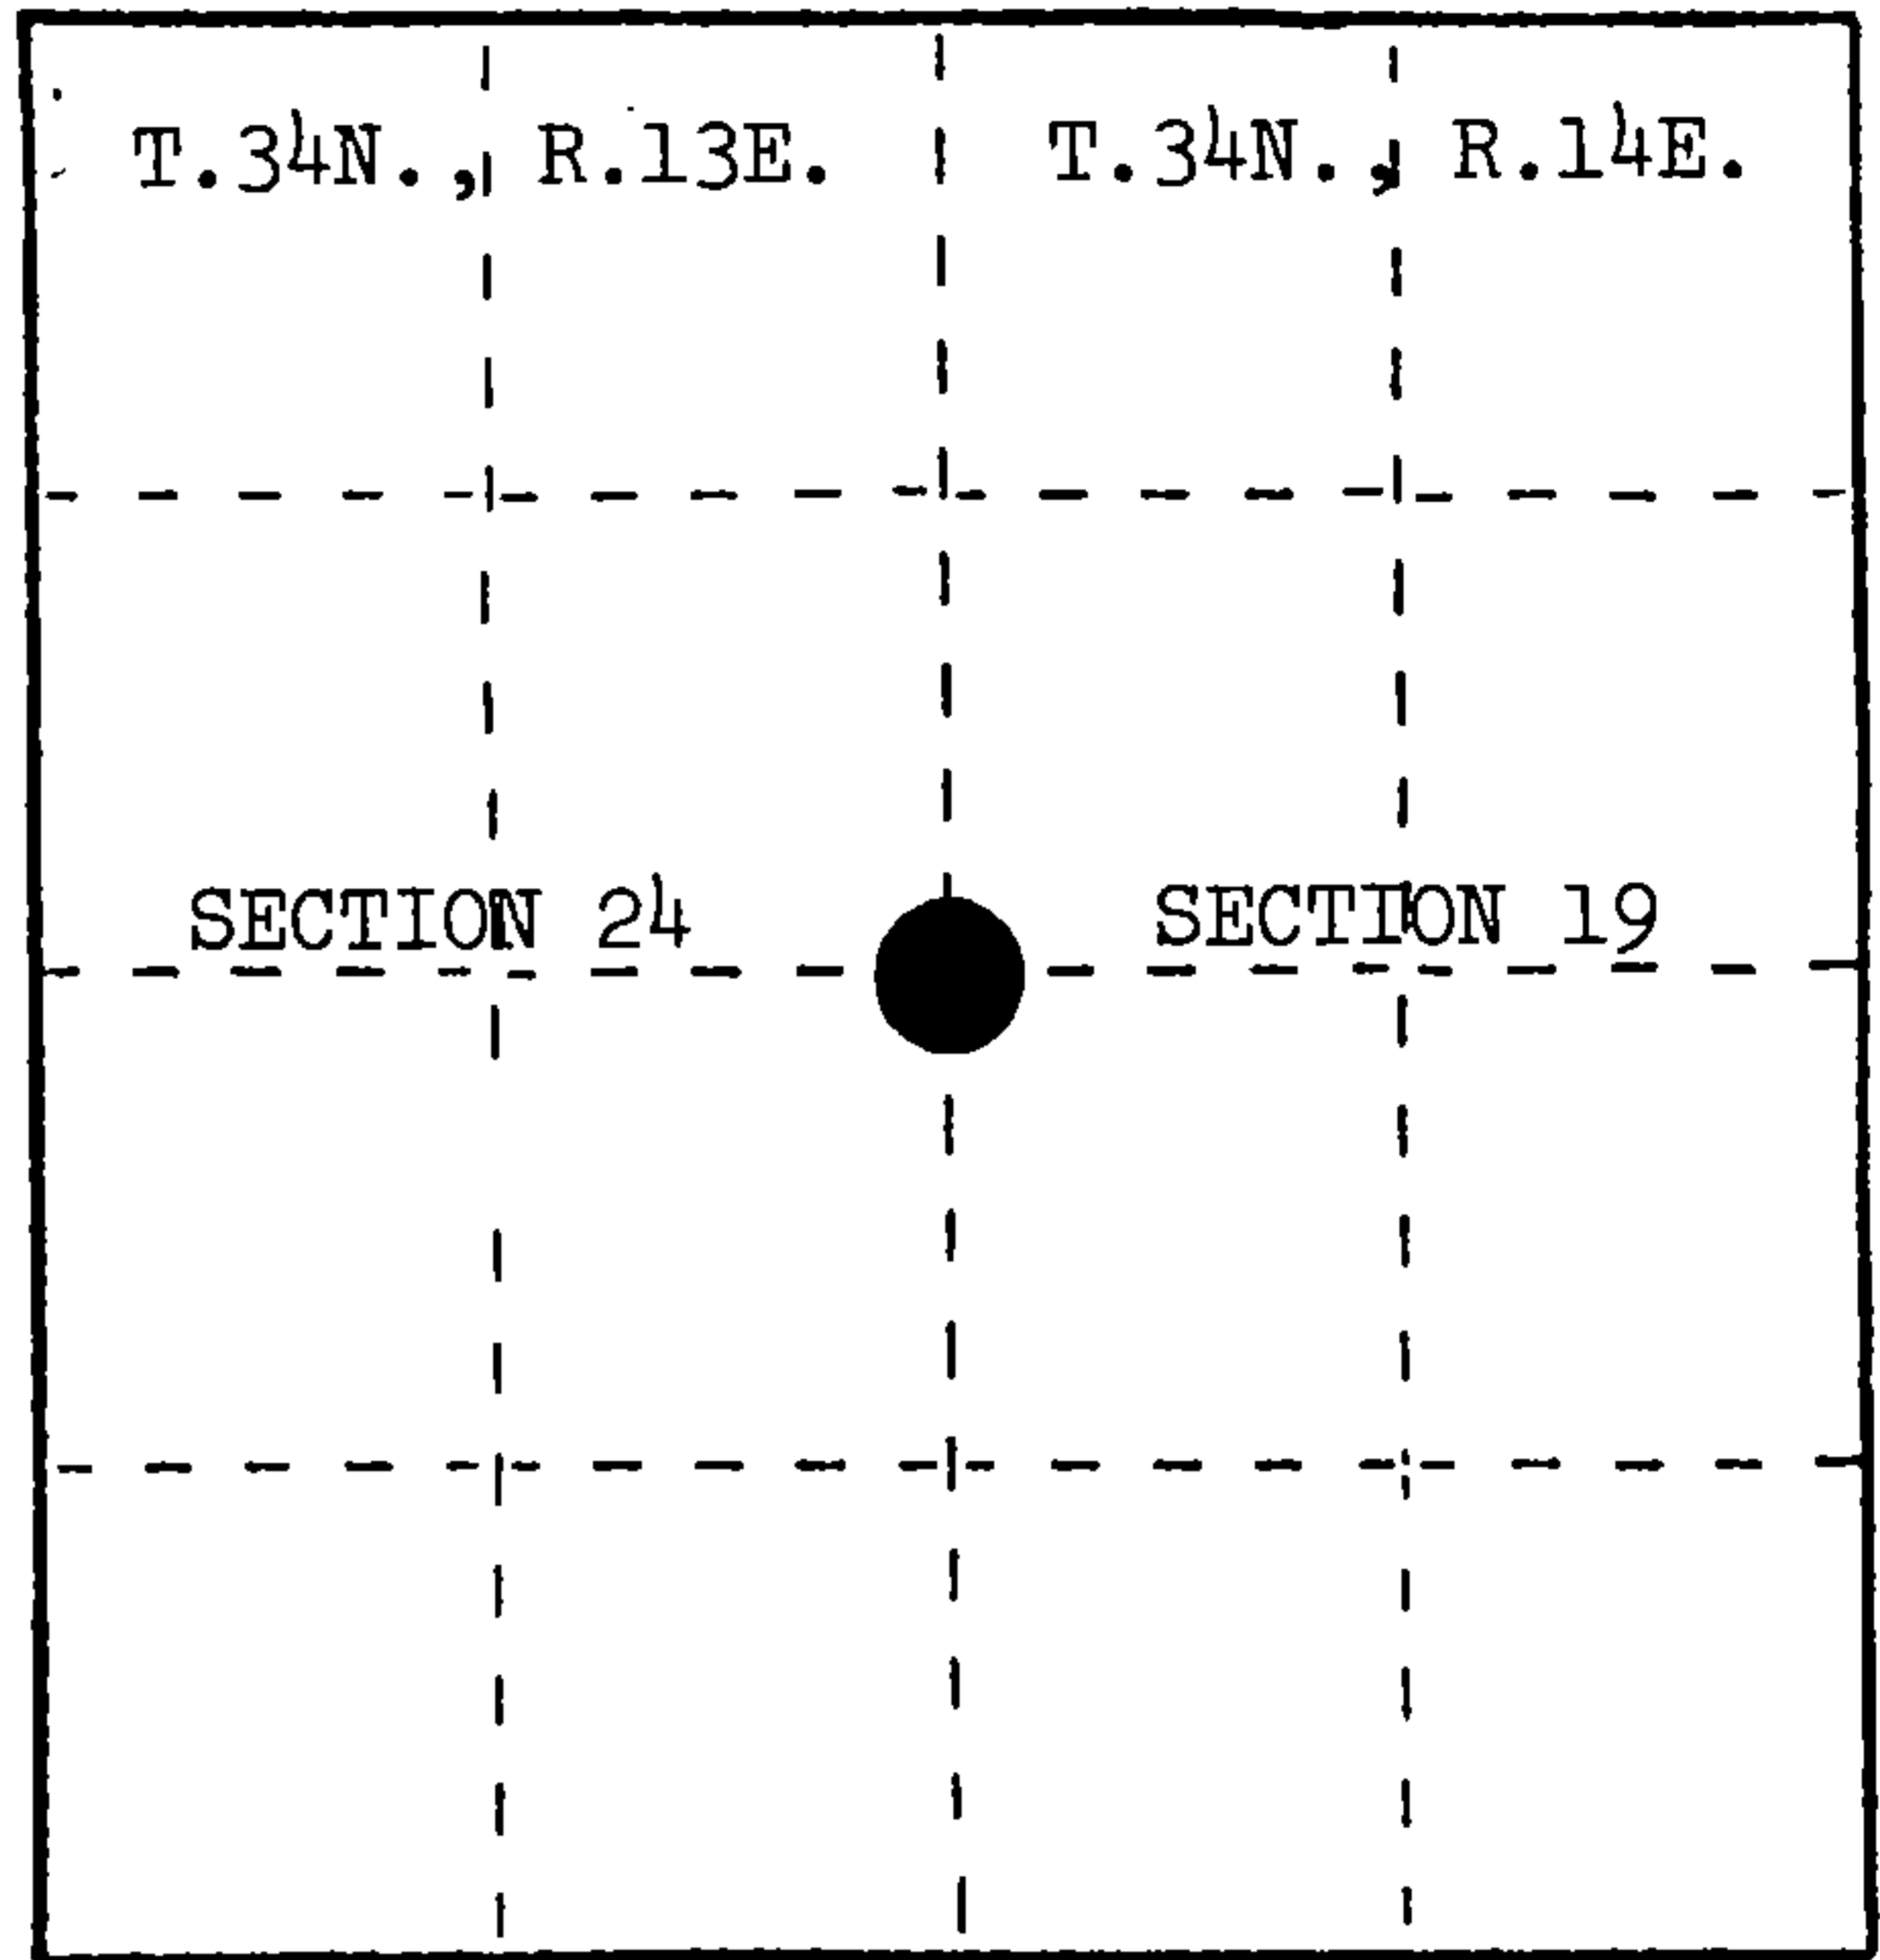

(b) Describe any record evidence, monument evidence, occupational evidence, testimonial evidence or any other material evidence you considered, and whether the monument was found or placed.


Corner position restored from remains of the original bearing trees and post hole, as placed by Alfred Millard in 1857.

(c) In the plan view drawing below, provide reference ties to at least 4 witness monuments, or, if the location is within a municipality, to at least 2 witness monuments. (Witness monuments shall be made of concrete, natural stone, iron or other equally durable material.) Describe witness monuments.

(d) Show a plan view drawing depicting the relevant monuments and reference ties which is sufficient in detail to enable accurate relocation of the corner monument if the corner monument is disturbed. Indicate north.

1. Sugar Maple, 8", N.87°E., 10.50 feet
2. Sugar Maple, 6", S.48°W., 23.16 feet
3. Sugar Maple, 5", N.89°W., 13.56 feet
4. Steel Sign Post, South, 1.20 feet
5. Kimberly Clark Monument, S.67°26'42"E., 37.11 feet

REGISTER'S OFFICE }
 Forest County, Wis. }
 Received for record this 16th day
 of January A. D., 1925 at
2:30 o'clock P. M. and
 recorded in Vol. CORNER RESTORATIONS
 on page P-1
Paul Aschenbrenner
 REGISTER

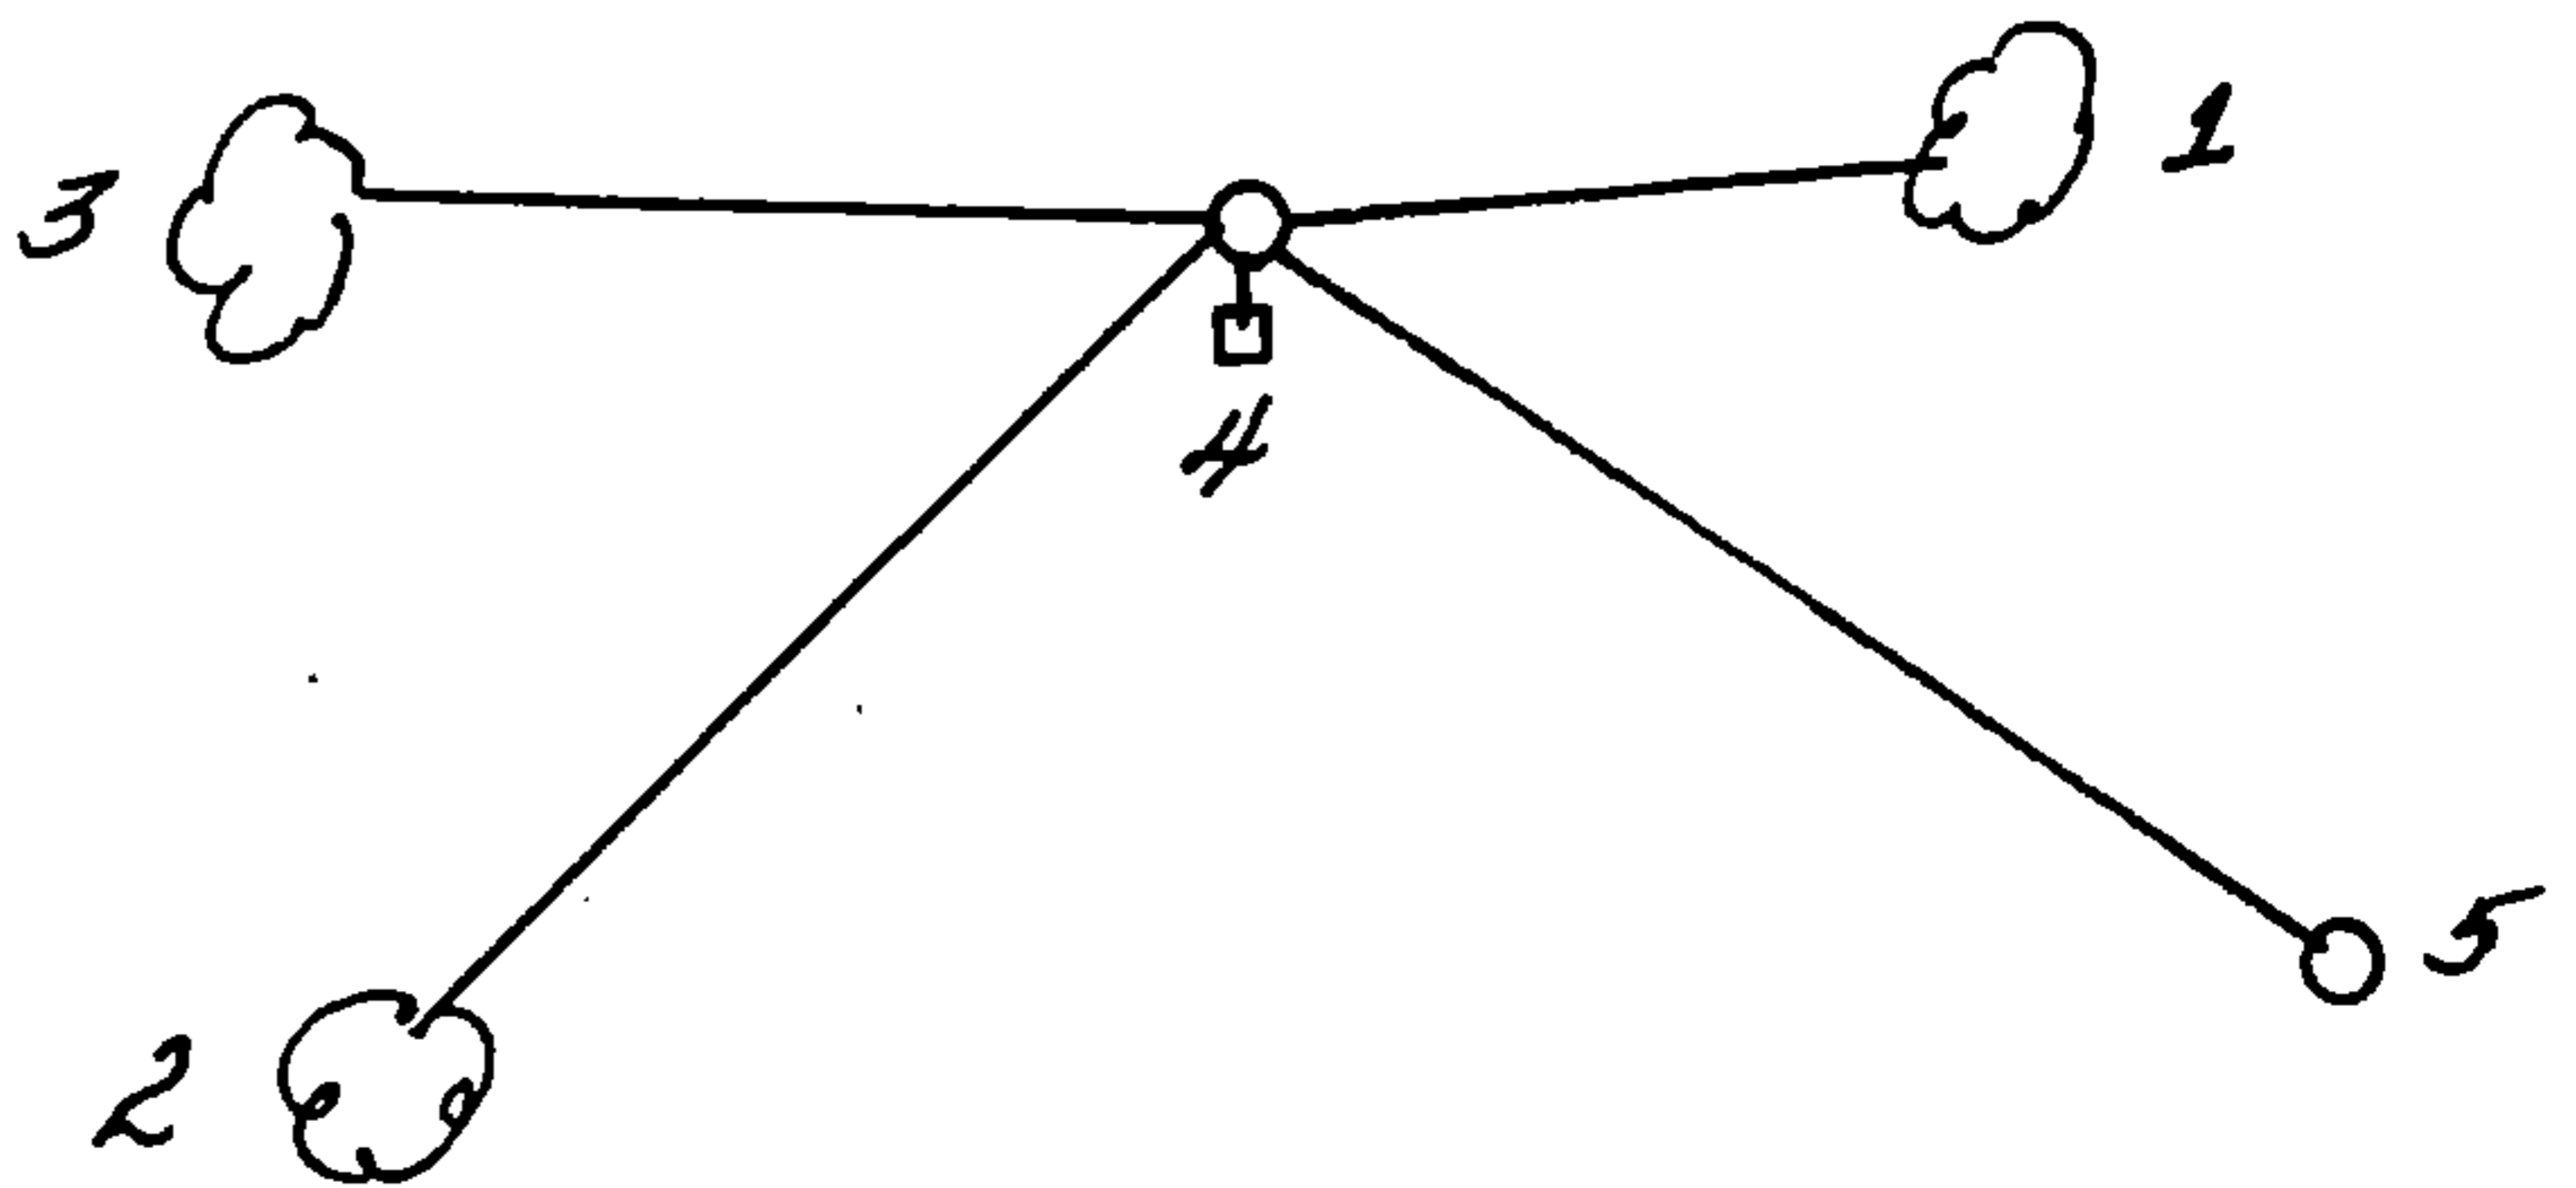

SEE P-25 TR 34-13

43414242000

(e) Describe any material discrepancy between the location of the corner as restored or reestablished and the location of that corner as previously restored or reestablished by distance and direction. Show the discrepancy on the plan view drawing under (d), above. Show the distances between the corner as previously restored or reestablished and (1) the corner as restored or reestablished, and (2) to at least 2 of the witness monuments shown on the drawing in (d), above.

(f) Was the corner restored through acceptance of (1) an obliterated evidence location, or, (2) a found perpetuated location?

(g&h) Was the corner reestablished through lost corner proportionate methods? If so, show the method, including the directions and distances to other public land survey corners used as evidence or used for proportioning in determining the corner location?

Affix Land Surveyor Seal



(i) I, Milo E. Stefan
(type or print name) certify that the corner location shown on this record was determined by me or under my direction and control and that this U.S. Public Land Survey Monument Record is correct and complete to the best of my knowledge and belief.

Milo E. Stefan
Signature

3/21/84
Date