


CERTIFIED LAND CORNER RESTORATION

Index No. **V25**

State of Wisconsin }  
County of Forest } ss.

I Jean F. Resvick, do hereby  
certify that on the 5th day  
of June, 1964, I found  
evidence of the Northeast section  
corner of Section 36  
Township 34, North, Range  
14 East, Fourth Principal Meridian,  
as described hereon; and that from this evidence  
I established a new monument and accessories  
as described hereon to perpetuate the original  
location of this corner.

Resident witnesses:

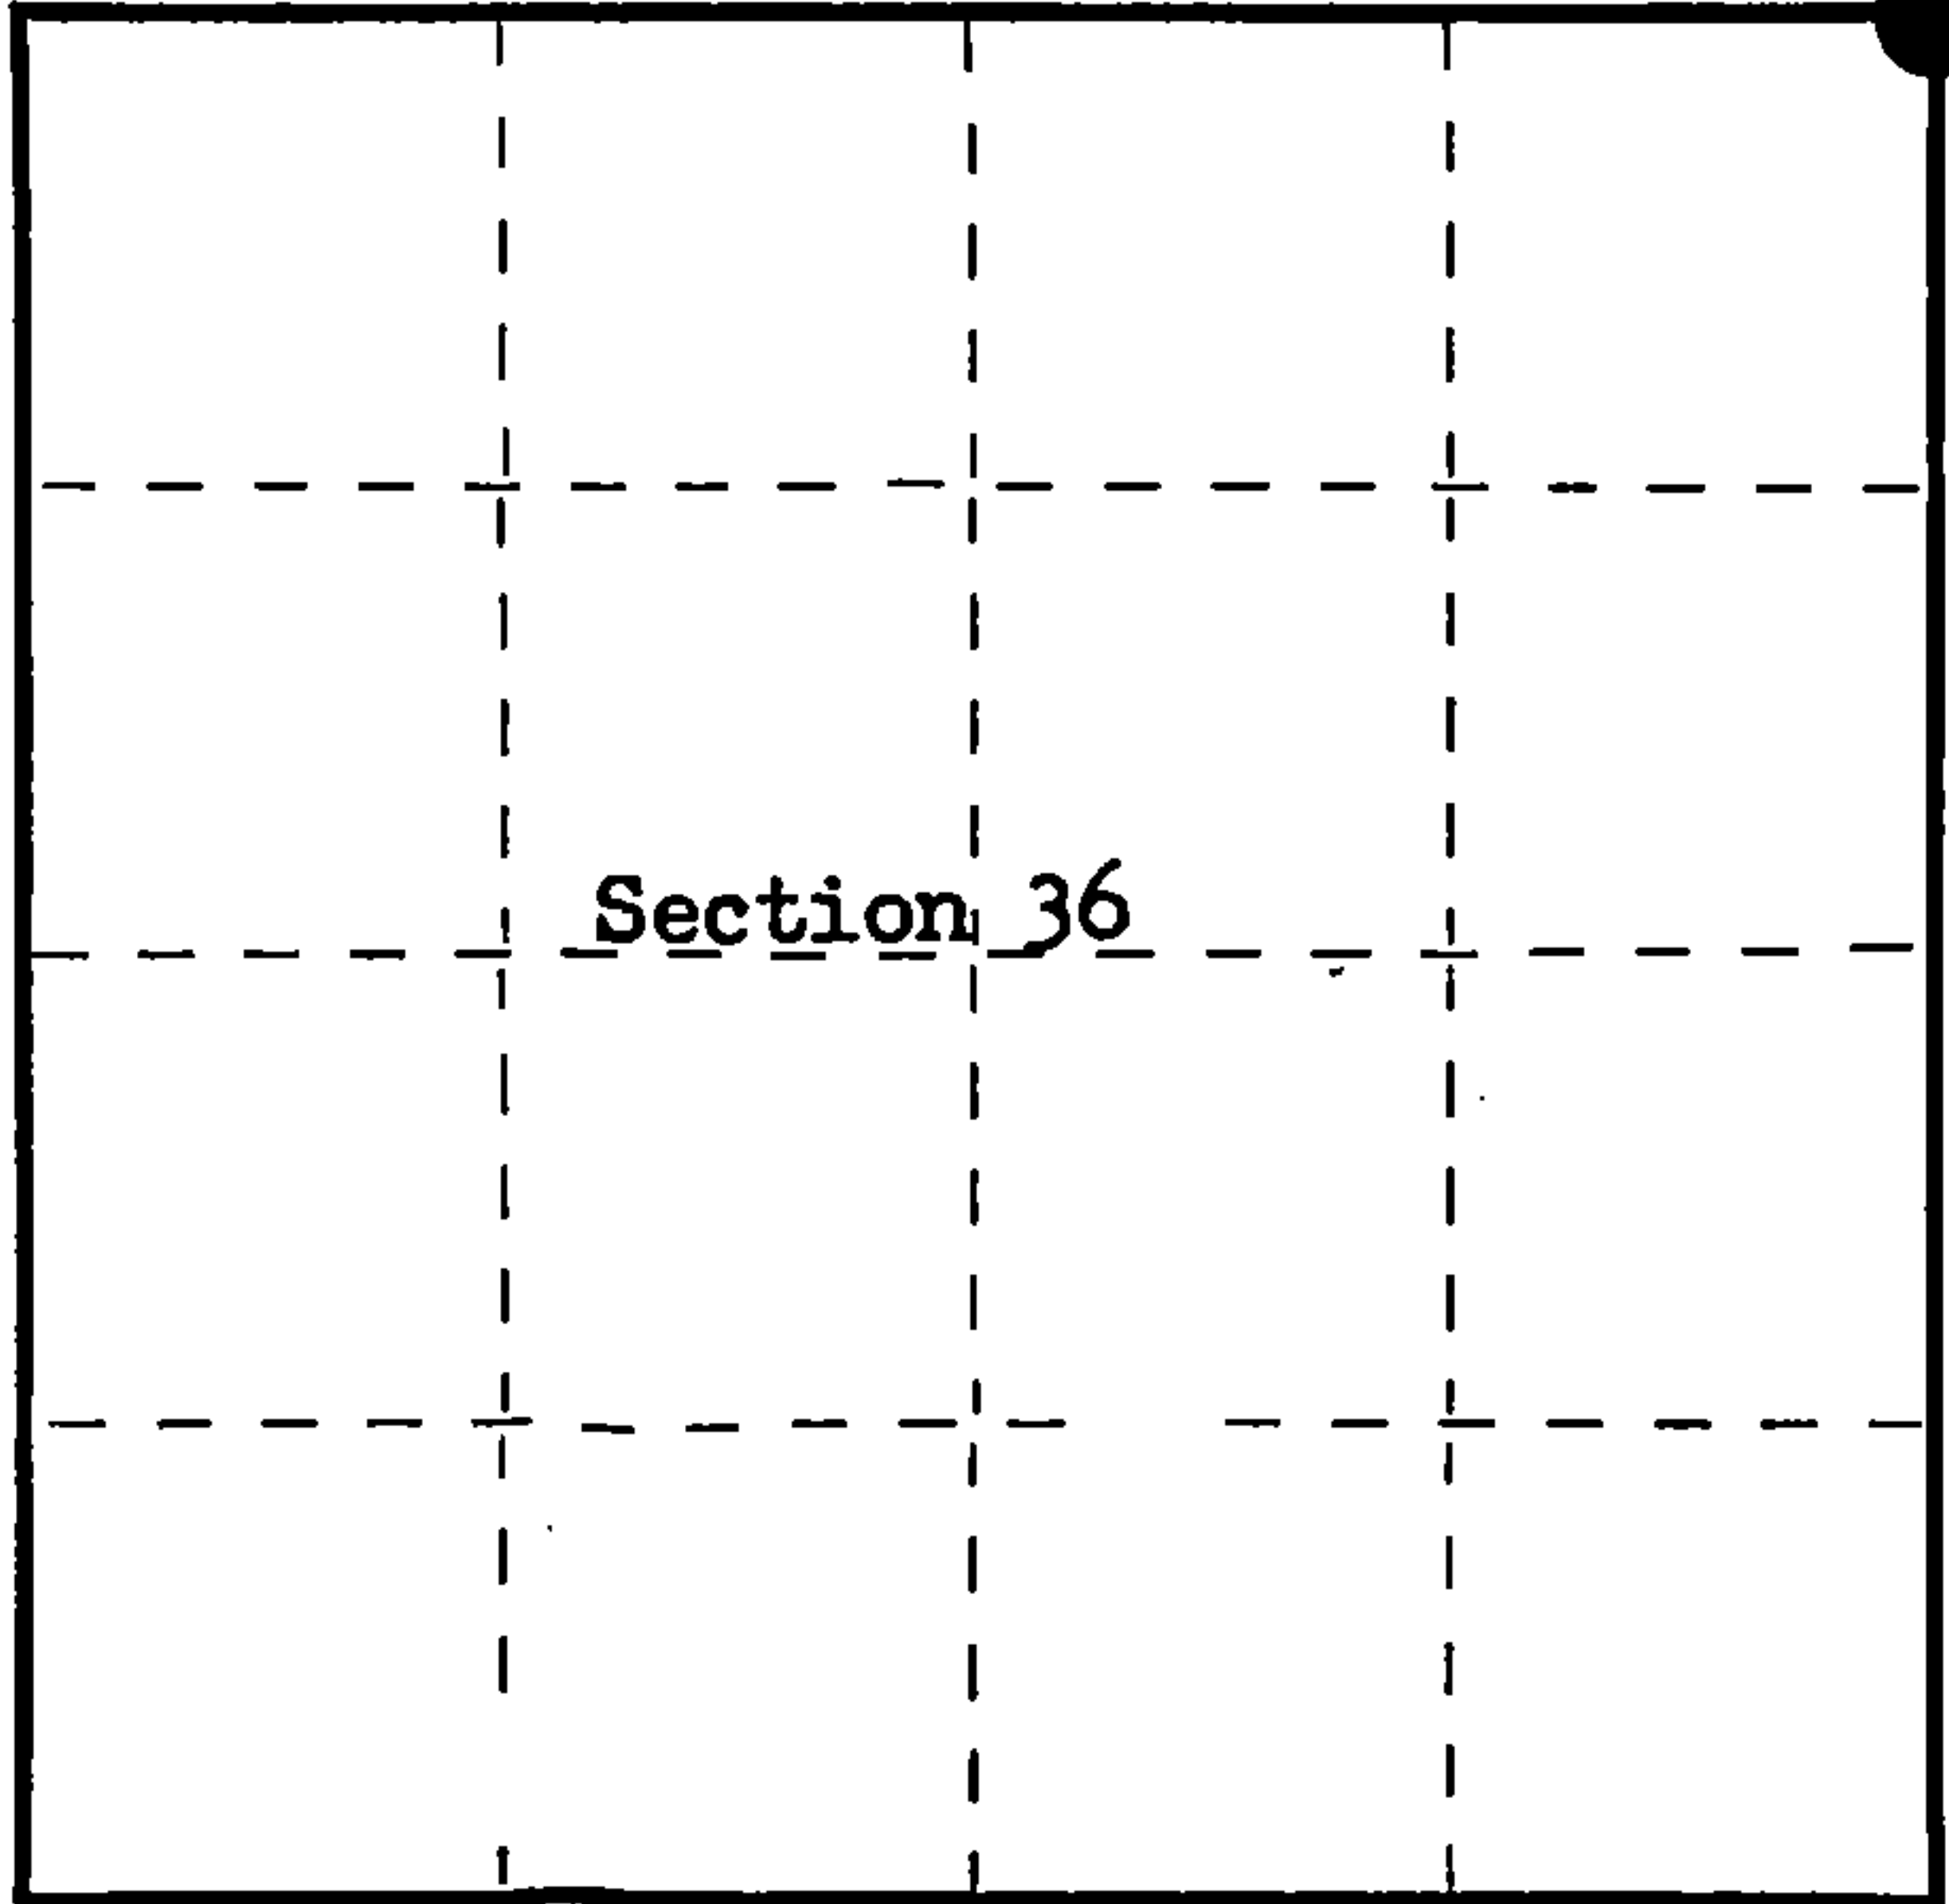


○ = Corner monument restored.

History of original corner establishment:  
80.00 chains N1°E between Sections 31 and 36, set post for section corner  
section 25, 30, 31 & 36  
Ironwood 10", S85°W, 44 lks.  
Elm 9", N67°W, 27 lks  
Yellow Birch 18", N85°E, 19 lks  
Sugar 9", S2°E, 24 lks.

Description of corner evidence found:  
Elm 13", fallen snag with face blazes.  
From a point S67°E, 17.82 ft. from elm  
1. Yellow Birch stump, N85°E, 12.54 ft.  
2. Stump hole, S2°E, 15.8 ft.  
3. Scribed post S85°W, 6 ft., post set on uphill side of boulder and held  
by two large stones.  
I accept the bearing tree evidence as the location of the corner and I believe that  
the post had been found down and placed behind boulder.

Description of monument and accessories I established to perpetuate the original location of this corner.  
Set 2-inch inside diameter galvanized iron pipe, 5 feet long, filled with concrete,  
flanged at bottom, with brass cap stamped:

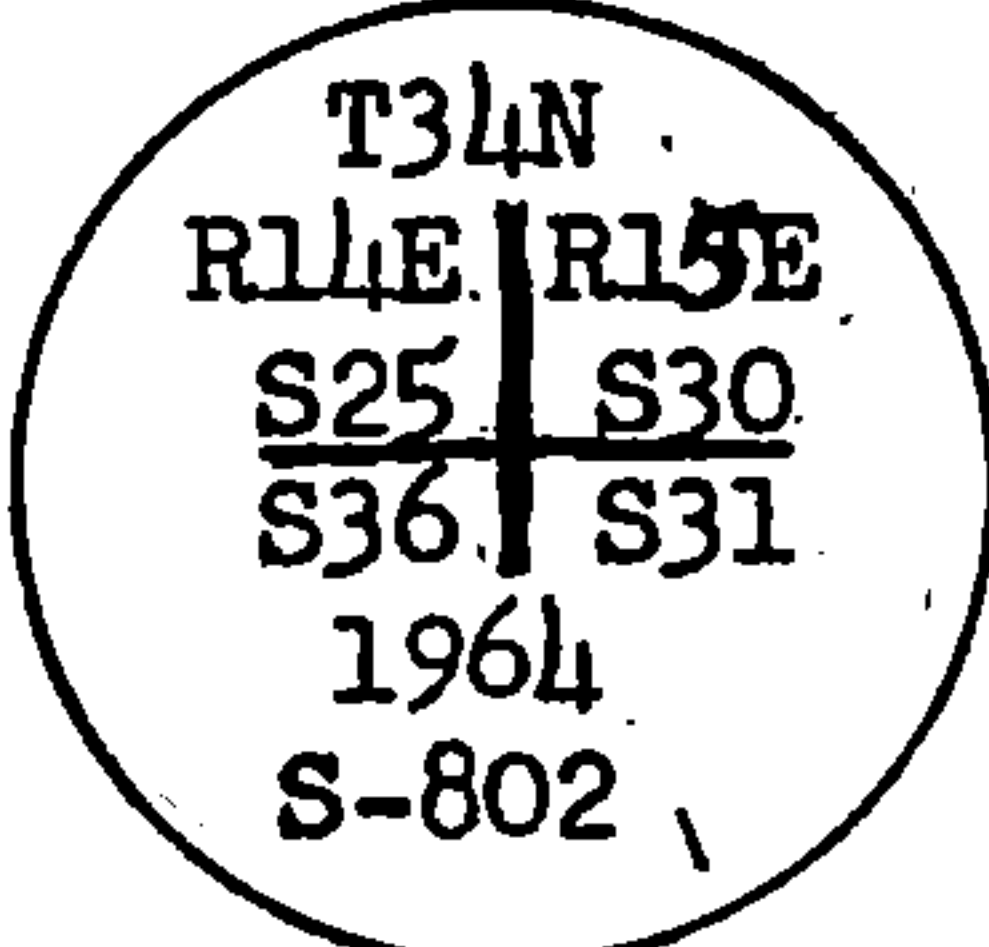

from which the following blazed and scribed new bearing trees bear:  
Maple 13", N14°30'W, 14.05 ft. (21.29 lks)  
Maple 8", N74°E, 23.92 ft. (36.24 lks)  
Ironwood 8", S52°E, 46.05 ft. (69.77 lks)  
Maple 16", S9°W, 34.85 ft. (52.80 lks)

Dated at Rhineland, Wis., this 3rd day of August, 1964.

Signature Jean F. Resvick Title Cadastral Surveyor Registration No. S-802  
(County Surveyor, Registered Land Surveyor, or other duly authorized official)

Office of Register of Deeds, County of FOREST, I hereby certify that the within  
instrument was filed in this office for record on the 21st day of Oct., 1964  
at 11 o'clock A M. Doc. #89307 Vol 1 Page V-25 CORNER RESTORATIONS

Anna Peterson  
(Register of Deeds)

By \_\_\_\_\_ Deputy

FORM 985 H. C. MILLER CO., MILWAUKEE

42414250000


# U. S. PUBLIC LAND SURVEY MONUMENT RECORD

**I N S T R U C T I O N S :** This record shall show the location of the corner and shall include all of the following nine elements (a through i).

- (a) Identify the corner by reference to the U.S. public land survey system.

○ = Corner monument restored.

Section corner common to Sections 30 and 31, T.34N., R.14E., and Sections 25 and 36, T.34N., R.13E.

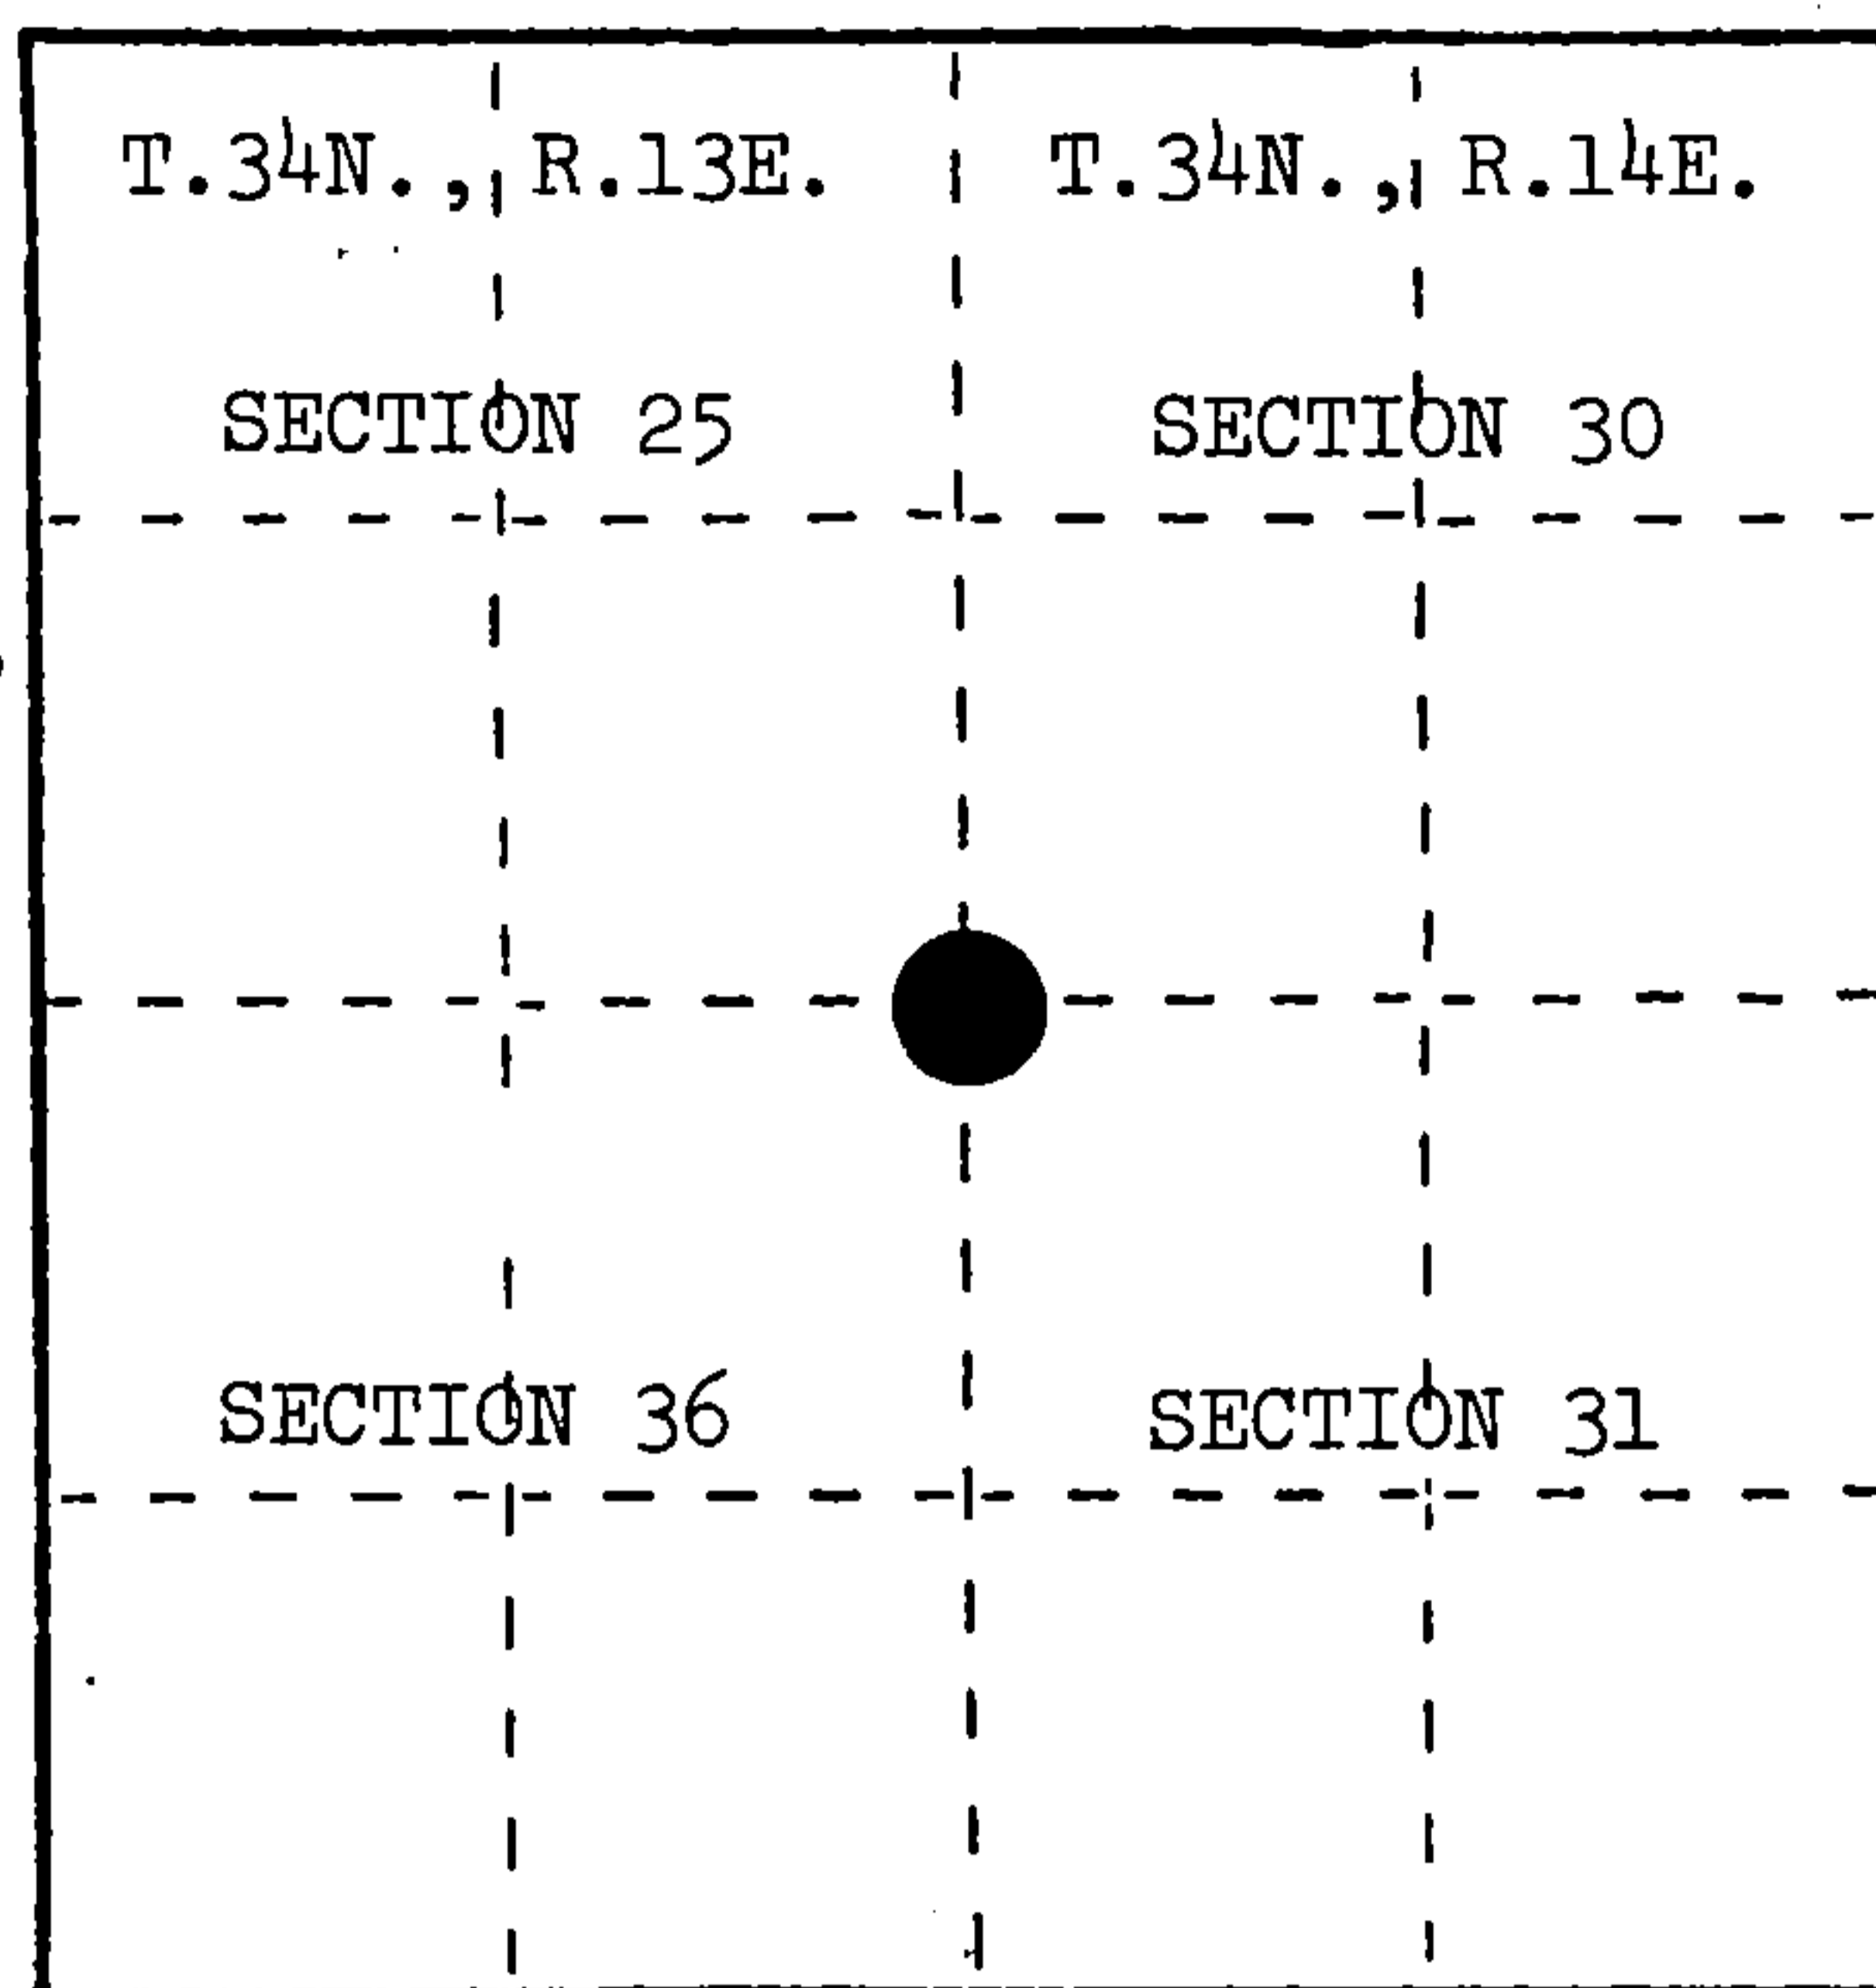


- (b) Describe any record evidence, monument evidence, occupational evidence, testimonial evidence or any other material evidence you considered, and whether the monument was found or placed.

Found post point hole, from which stump holes remain of the original bearing trees from Alfred Millard's survey of 1857.

- (c) In the plan view drawing below, provide reference ties to at least 4 witness monuments, or, if the location is within a municipality, to at least 2 witness monuments. (Witness monuments shall be made of concrete, natural stone, iron or other equally durable material.)  
Describe witness monuments.

- (d) Show a plan view drawing depicting the relevant monuments and reference ties which is sufficient in detail to enable accurate relocation of the corner monument if the corner monument is disturbed. Indicate north.

1. Sugar Maple, 8", N.83°E., 44.67 feet
2. Sugar Maple, 4", S.41°E., 33.65 feet
3. Sugar Maple, 4", S.01°W., 12.40 feet
4. White Ash, 8", N.24°W., 10.70 feet
5. Steel Sign Post, South, 1.10 feet
6. Kimberly Clark Monument, N.74°E., 31.84 feet

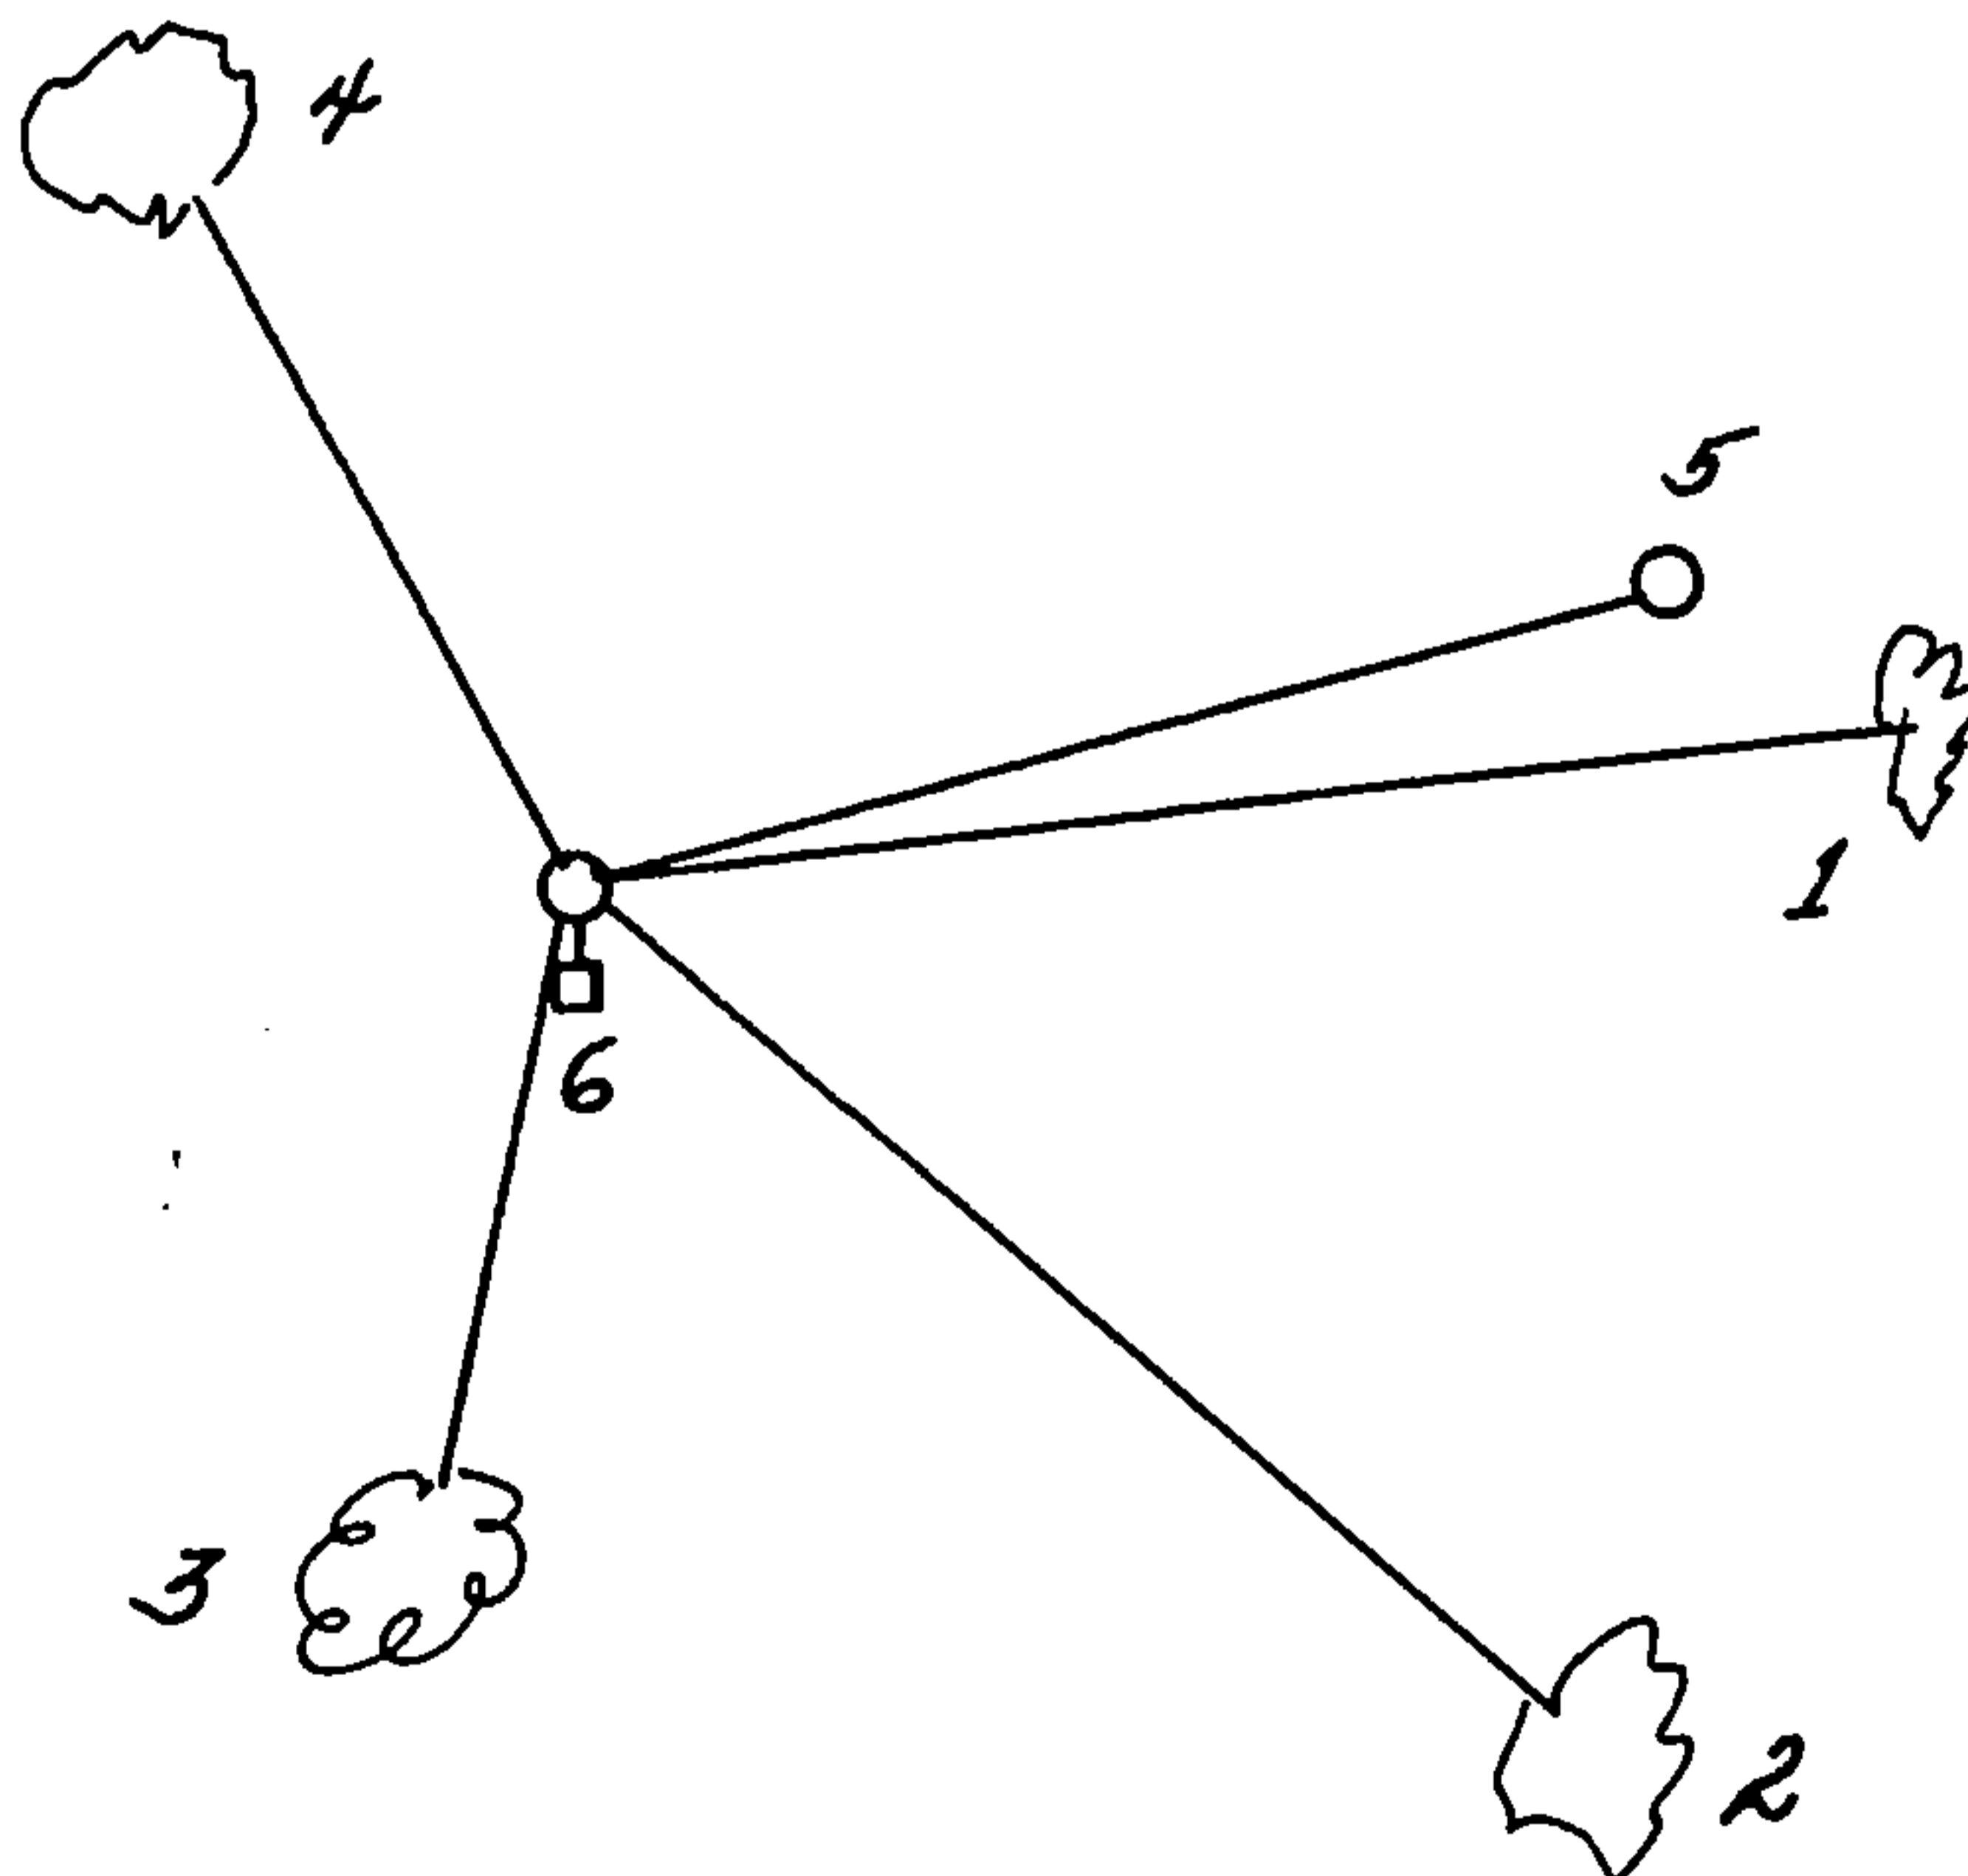

REGISTER'S OFFICE  
Forest County, Wis.

Received for record this... 16th day  
of January... A.D., 1985 at  
... 2:30 o'clock... P. M. and

recorded in Vol. CORNER RESTORATIONS  
on page 1  
Paul Hochbrenner  
REGISTER

- (e) Describe any material discrepancy between the location of the corner as restored or reestablished and the location of that corner as previously restored or reestablished by distance and direction. Show the discrepancy on the plan view drawing under (d), above. Show the distances between the corner as previously restored or reestablished and (1) the corner as restored or reestablished, and (2) to at least 2 of the witness monuments shown on the drawing in (d), above.

This corner is restored from the remains of Millard's original survey of 1857. Neal Sperhake's monument bears north  $74^{\circ}$  east, 31.84 feet, which was restored by lost method from one mile south and two miles north.

- (f) Was the corner restored through acceptance of (1) an obliterated evidence location, or, (2) a found perpetuated location?

An obliterated evidence location.

- (g&h) Was the corner reestablished through lost corner proportionate methods? If so, show the method, including the directions and distances to other public land survey corners used as evidence or used for proportioning in determining the corner location?

Affix Land Surveyor's Seal



(i) I, Milo E. Stefan

(type or print name) certify that the corner location shown on this record was determined by me or under my direction and control and that this U.S. Public Land Survey Monument Record is correct and complete to the best of my knowledge and belief.

Milo E. Stefan

Signature

3/21/84

Date