

CERTIFIED LAND CORNER RESTORATION

83254

Index No.


237

4
4

State of Wisconsin }
County of Forest } ss.

I Robert E. Badow, do hereby certify that on the 3rd day of July, 1959, I found evidence of the East 1/16th Corner on E-W corner of Quarter line of Section 30 Township 34, North, Range 14 East, Fourth Principal Meridian, as described hereon; and that from this evidence I established a new monument and accessories as described hereon to perpetuate the original location of this corner:

Resident witnesses:

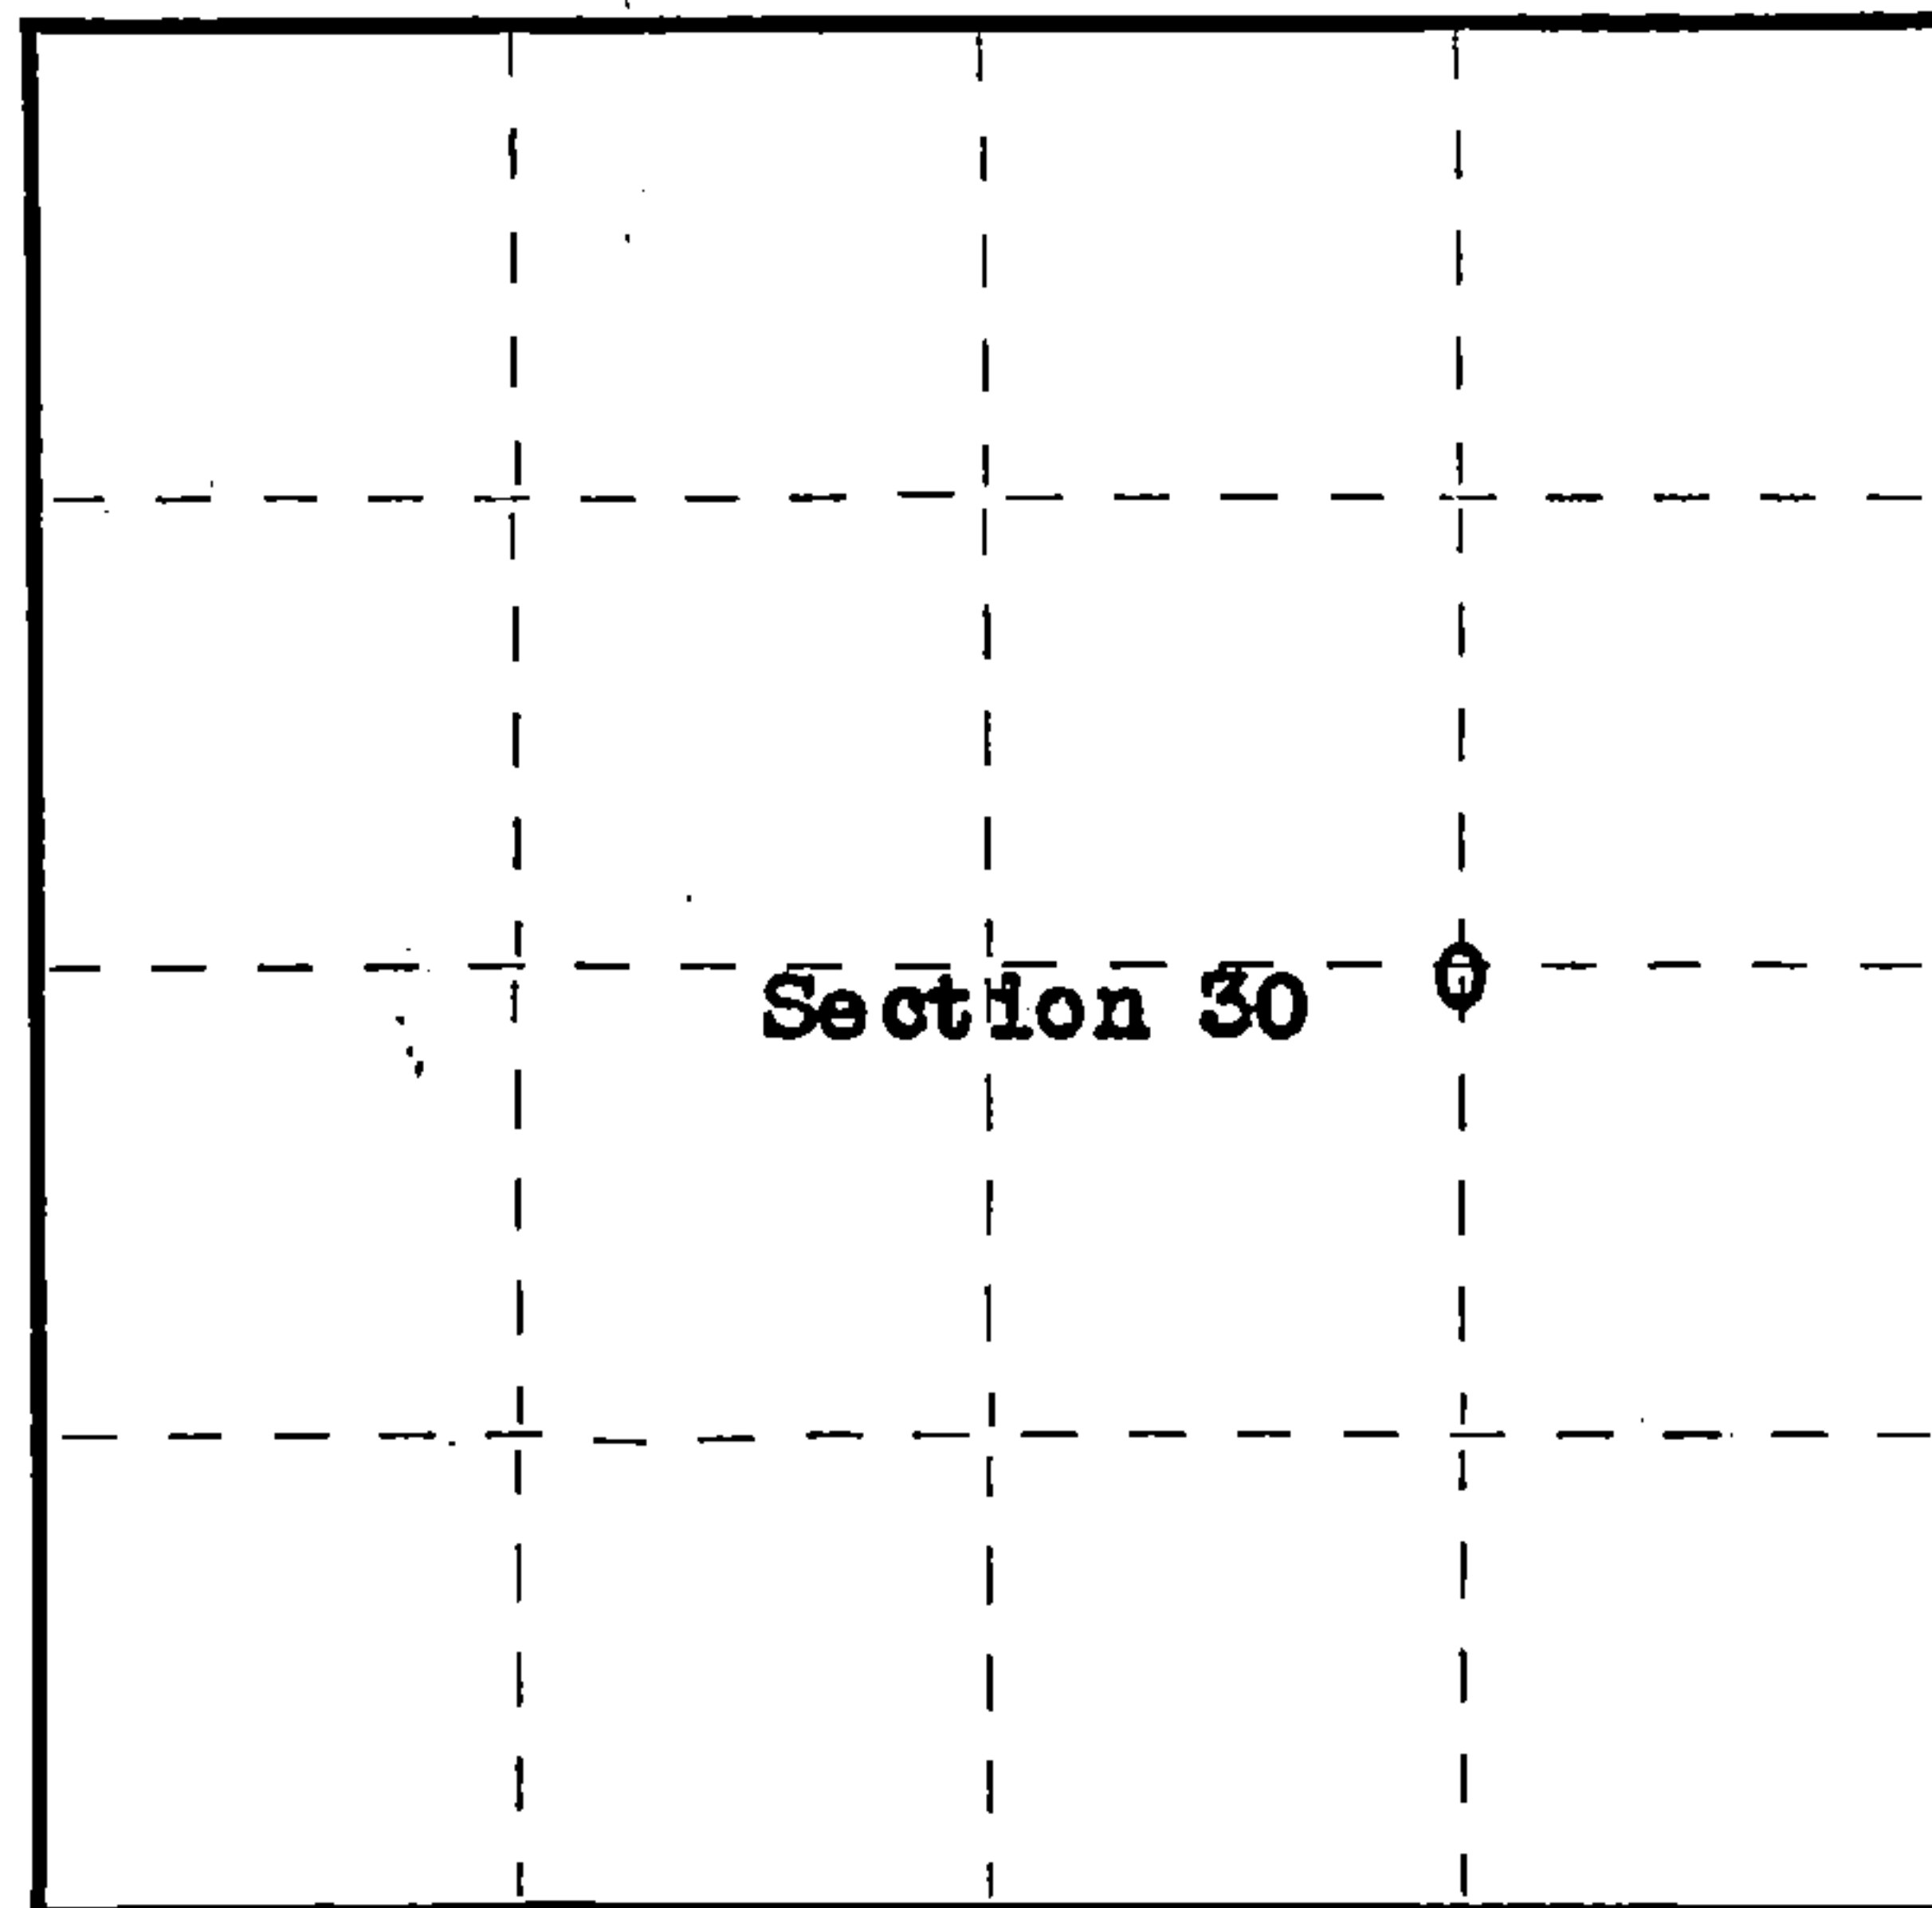

○ = Corner monument restored.

History of original corner establishment:


Position for corner was established by the United States Forest Service after running between the East Quarter Corner as re-established by Genisot Engineering Company, Rhinelander, Wisconsin, and the center of the Section as previously established by John Hammes, County Surveyor, Forest County. 4"x4" wood post marks position of corner.

Corner was set on a straight line midway between the East Quarter Corner and the center of the section.

Field notes of survey are located in the U.S. Forest Service Supervisor's office.

Description of corner evidence found:

4"x4" wood post set by United States Forest Service.

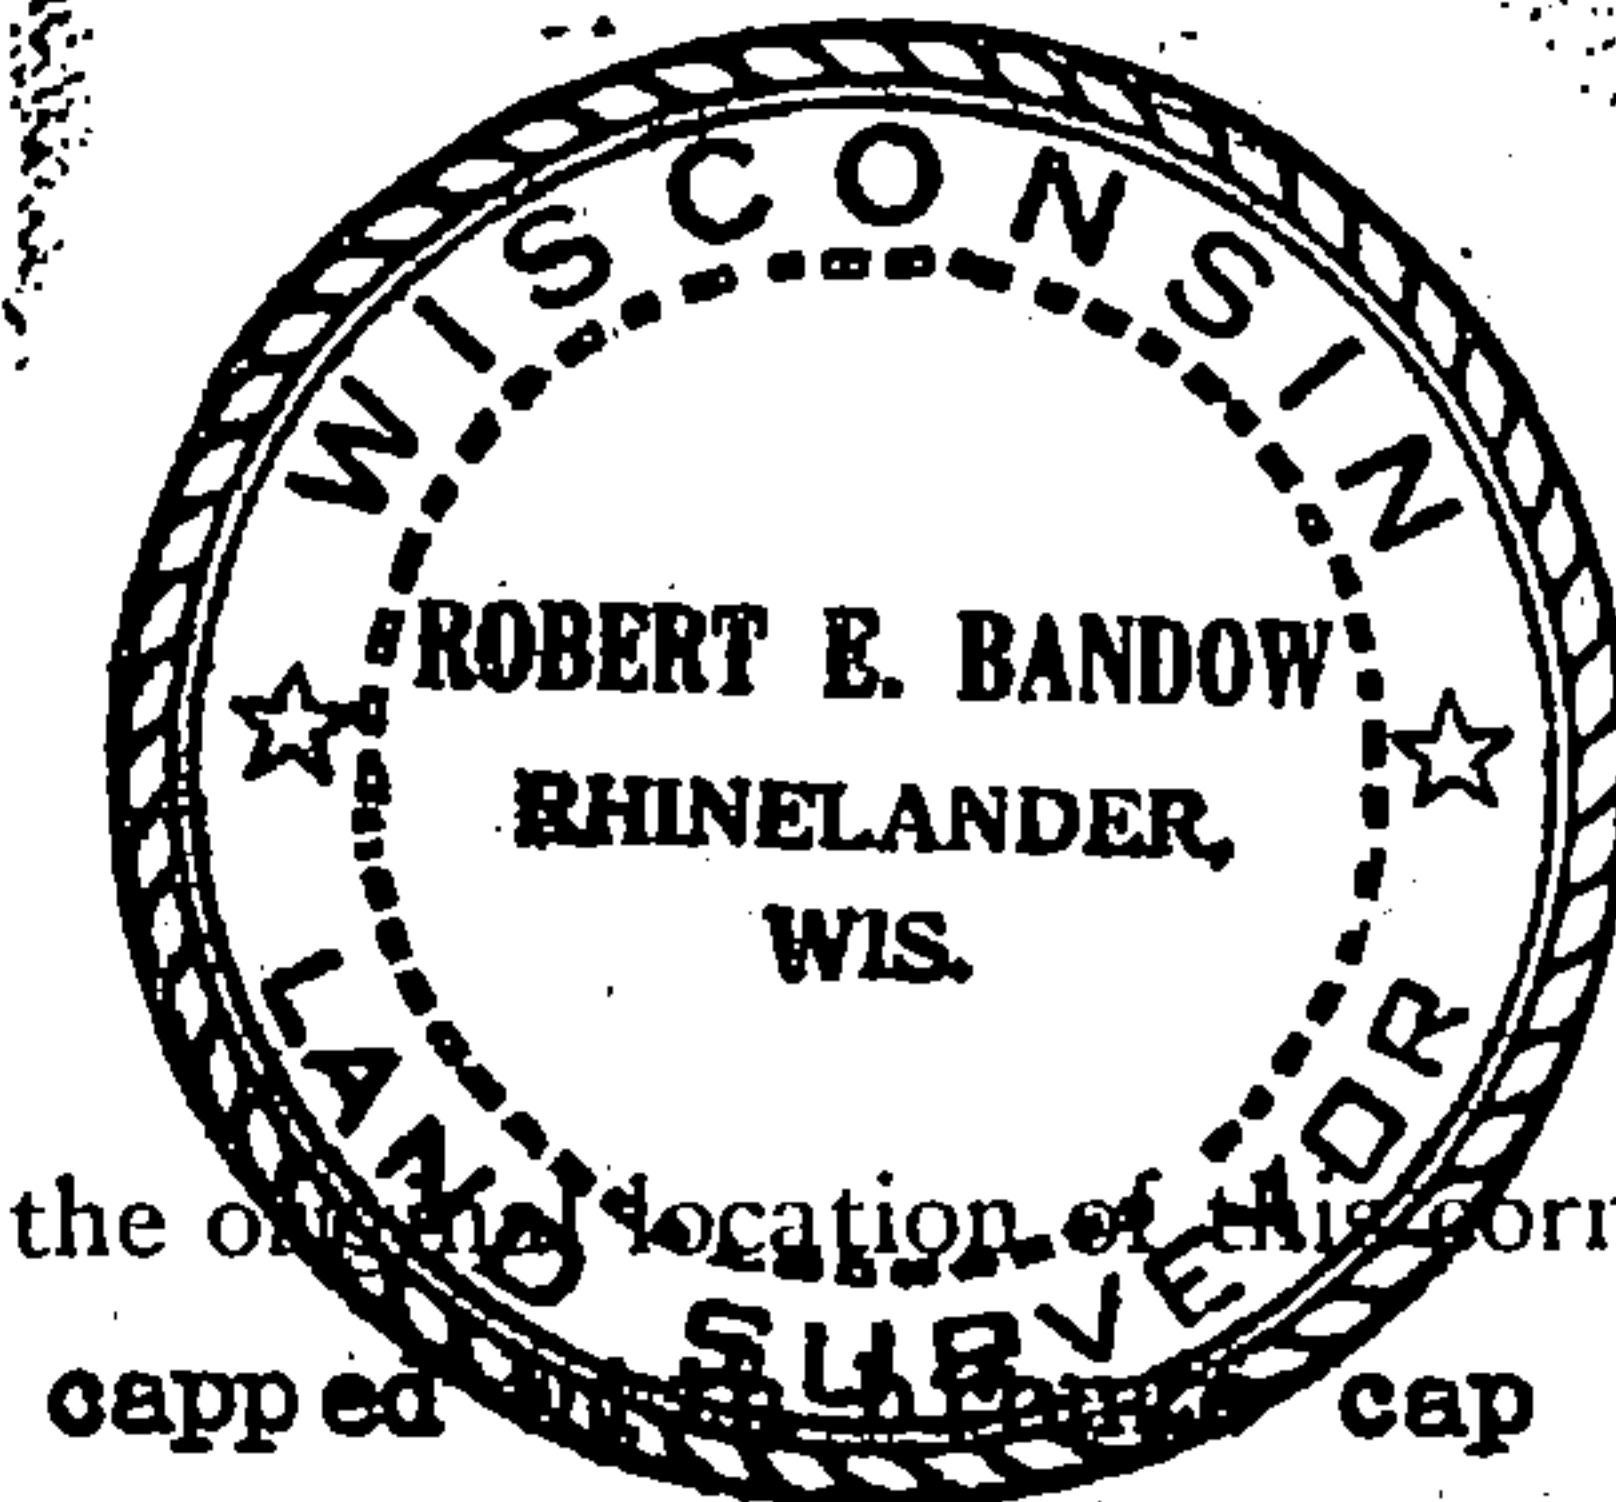

Description of monument and accessories I established to perpetuate the original location of this corner. Set 2"x5' Galvanized Iron Pipe filled with concrete, capped with a metal cap and stamped as follows:

T34N R14E
E 1/16
c S30 c
1959

RLS No. S-104

Blazed and scribed the following bearing trees: White Birch 7" S36°30'E 4.4 feet
Elm 3" N75°30'E 15.4 feet

Genisot Engineering Company

Dated at Rhinelander, Wis., this 30th day of November, 1959

Signature Robert E. Badow Title Registered Land Surveyor Registration No. S-104
(County Surveyor, Registered Land Surveyor, or other duly authorized official)

Office of Register of Deeds, County of Forest, I hereby certify that the within instrument was filed in this office for record on the 21st day of March, 1960 at 9:00 o'clock A M.

Anna Peterson
(Register of Deeds)

By _____ Deputy

Subscribed and sworn to before me this 30th day of November 1959. Joseph G. Kirby Notary Public, Oneida Co.

Wisconsin.
My Commission expires May, 1960

43414302010

FORM 985 H. C. MILLER CO., MILWAUKEE