


State of Wisconsin }  
County of Forest } ss.

I Robert E. Badow, do hereby certify that on the 3rd day of July, 1959, I found evidence of the Quarter Corner--center of Section 30 ~~corner~~ Township 34, North, Range 14 East, Fourth Principal Meridian, as described hereon; and that from this evidence I established a new monument and accessories as described hereon to perpetuate the original location of this corner.

Resident witnesses:

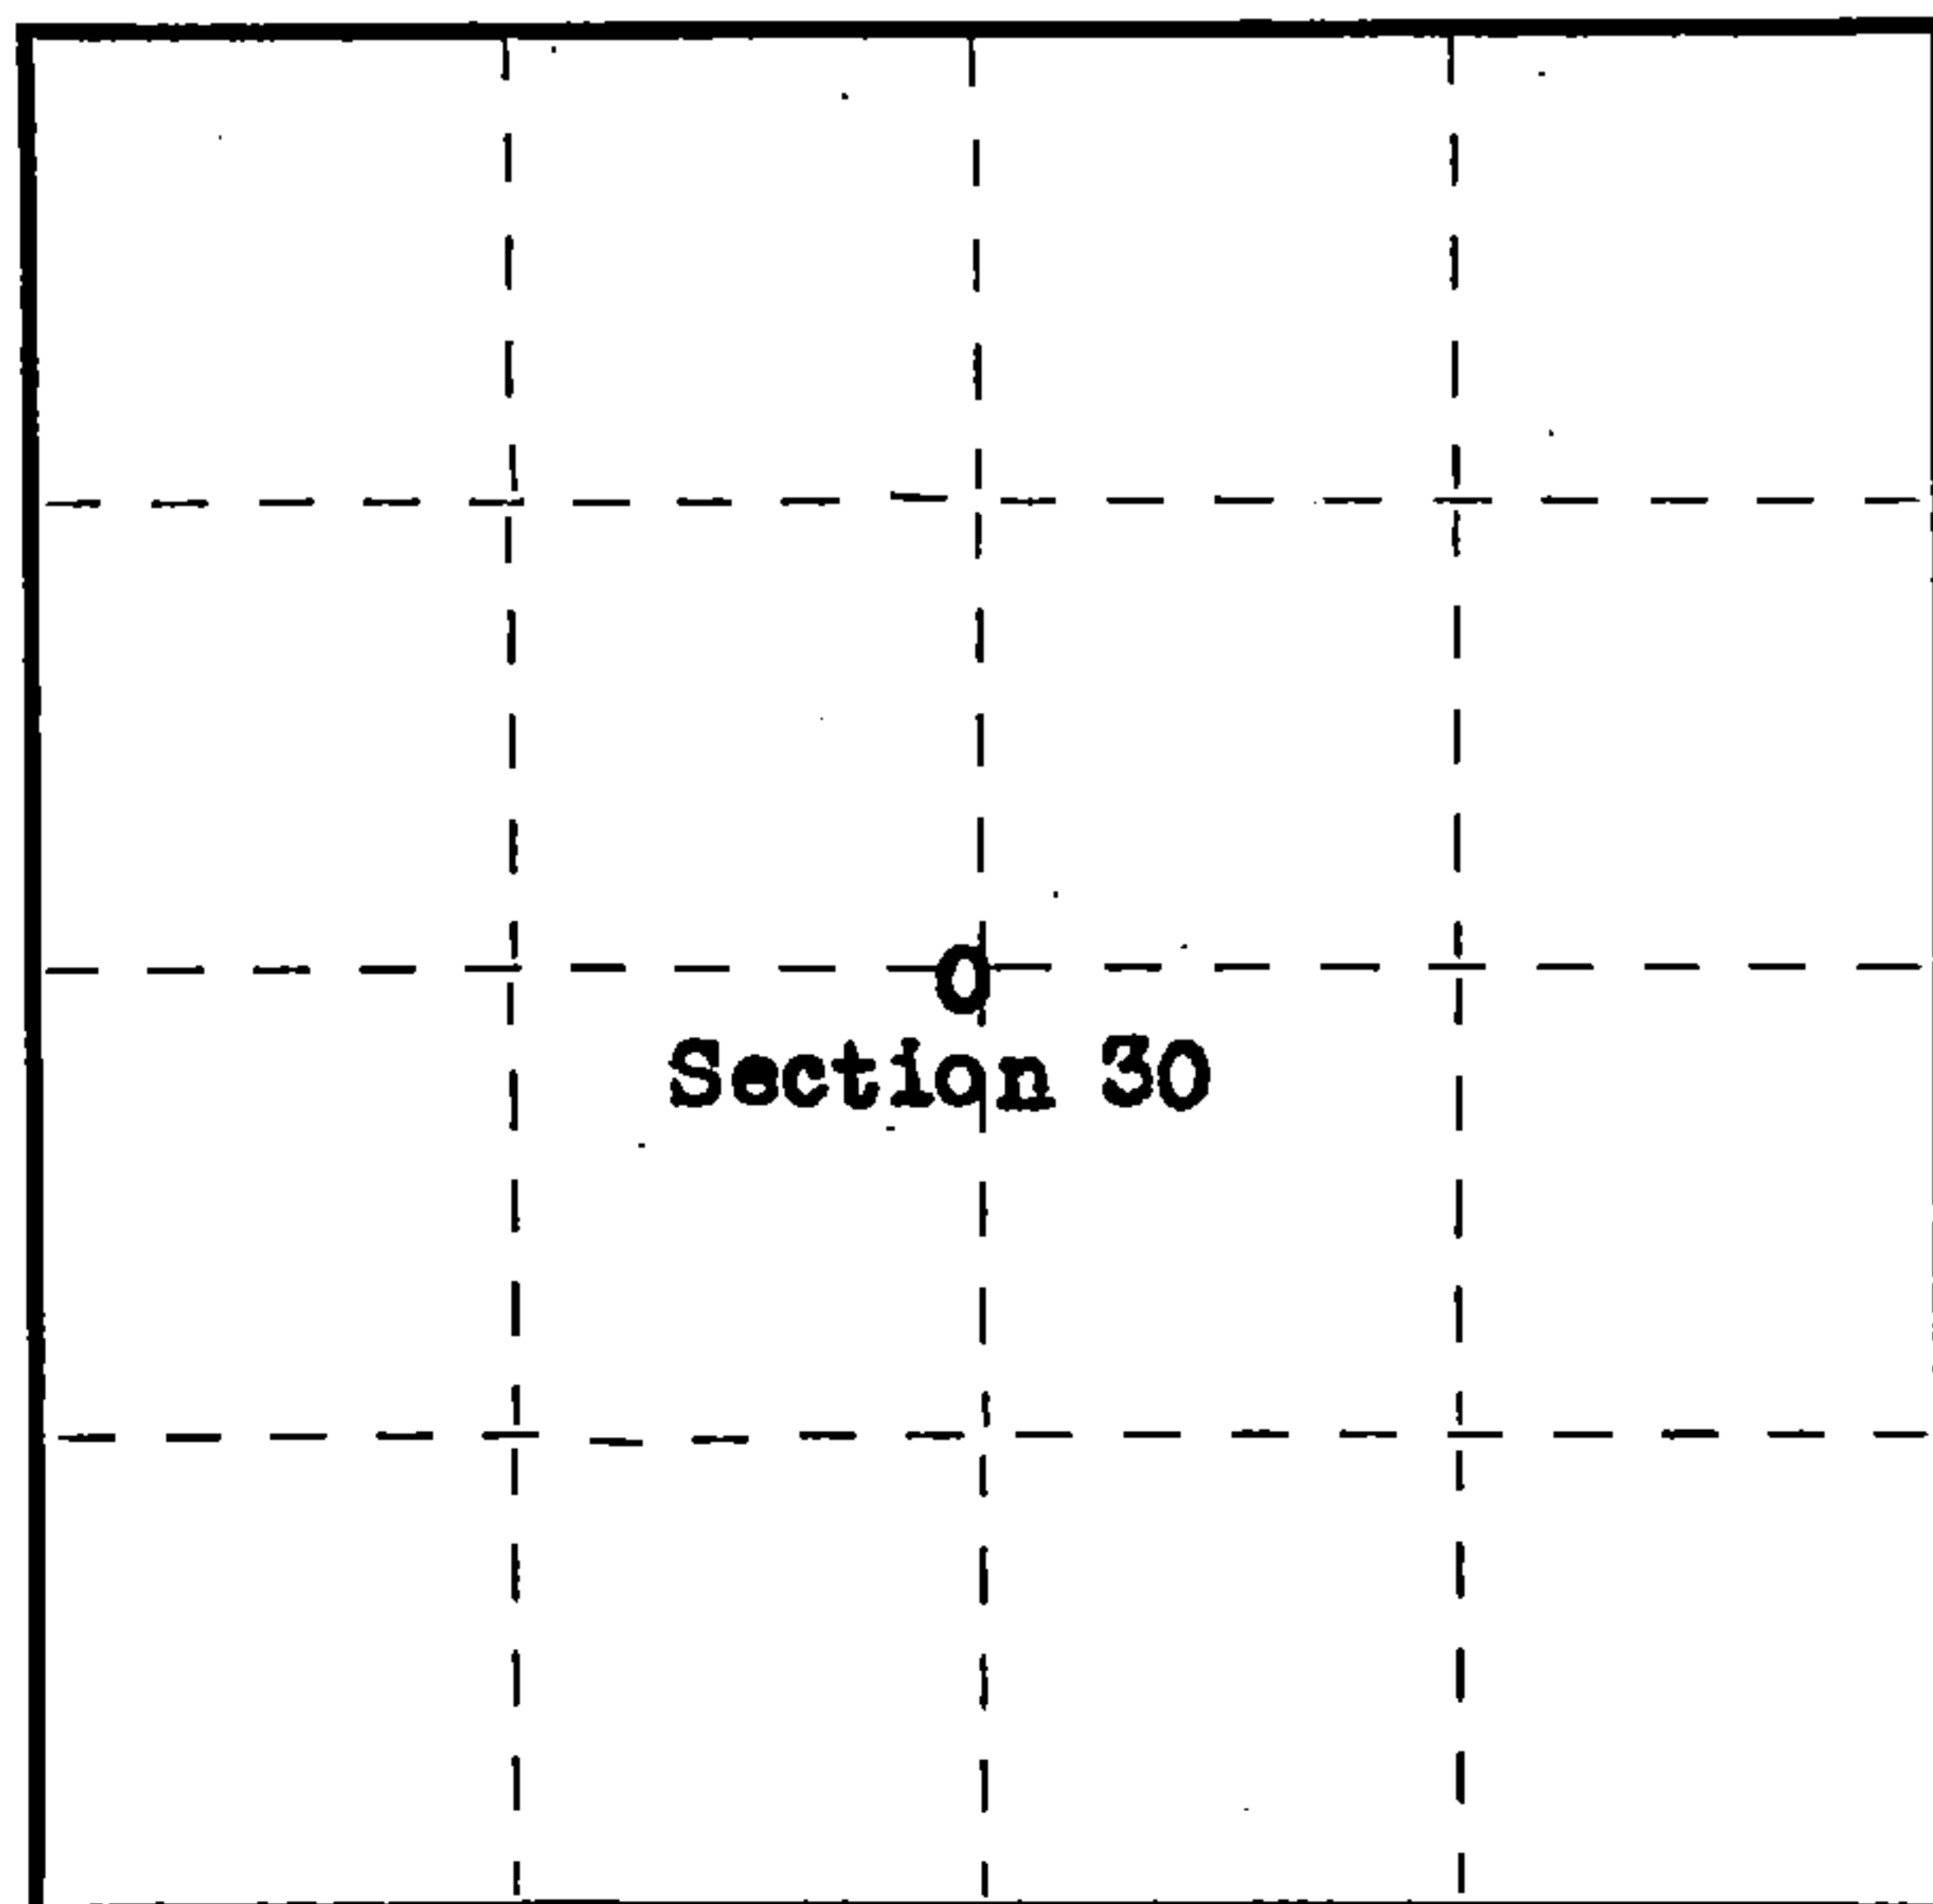

○ = Corner monument restored.

History of original corner establishment:

Original corner established by John Hammes, County Surveyor, Forest County, in the course of subdivision of the section. Record of survey and notes were not recorded.

Post marking position of corner was well scribed and remains of bearing tree shows definite evidence of scribing. It appears as though corner was set at least 35 years ago.

Description of corner evidence found:

4"x4" post at corner and remains of bearing tree.



Description of monument and accessories I established to perpetuate the original location of this corner. Set 2"x5' Galvanized Iron Pipe filled with concrete, capped with bronze cap and stamped as follows:

T34N R14E  
O 1/2 S30  
1959

RLS No. S-104

Blazed and scribed the following bearing trees: Balsam 6" N66°30'W 17.7 feet  
Tamarack 6" N33°30'W 16.0 feet  
Spruce 6" N55°E 18.2 feet

Genisot Engineering Company

Dated at Rhinelander, Wis., this 30th day of November, 1959.

Signature Robert E. Badow Title Registered Land Surveyor Registration No. S-104  
(County Surveyor, Registered Land Surveyor, or other duly authorized official)

Office of Register of Deeds, County of Forest, I hereby certify that the within instrument was filed in this office for record on the 21st day of March, 1960 at 9:00 o'clock A. M.

Anna Peterson  
(Register of Deeds)

By \_\_\_\_\_ Deputy

Subscribed and sworn to before me this 30th day of November 1959. Joseph C. Deuby Notary Public, Oneida County, Wis. My Commission expires May 1, 1960.

FORM 935 H. C. MILLER CO., MILWAUKEE

43414302020