#### U.S. PUBLIC LAND SURVEY MONUMENT RECORD

Note: This form is intended and designed to fulfill all requirements of Wisconsin Administrative Code, Chapter A-E 7.08 U.S. Public Land Survey Monument Record (3)(a-i).

(a) CORNER LOCATION
Cor. of Secs. 5, 6, 31 & 32
Township 33 & 34 North
Range 14 East of the 4th P.M.
Town of Wolf River/Freedom
County of Langlade/Forest

WISCRS - Langlade County
N: 427,220.16 USft
E: 715,847.42 USft
WISCRS - Forest County
N: 500,560.62 USft
E: 867,050.30 USft
Datum: NAD 83(2011)
GNSS Method: WISCORS RTN

SEC. 6
T33N R14E

(b) HISTORY OF ORIGINAL CORNER ESTABLISHMENT

Original Surveyor: Alfred Millard

Original Accessories:

Date of Survey

Commenced: August, 1857 Completed: August, 1857 Hemlock 28" S55°E, 40 lks.
Y. Birch 14" S45°W, 48 lks.
Hemlock 16" N43°W, 38 lks.
Hemlock 14" N60°E, 58 lks.

(b)(f)(g)(h) Description of monument found at this corner and if it was accepted, state all evidence (material, testimonial, occupational, plats, records, other monuments) used as a basis for accepting. If not accepted or if nothing was found, state evidence used as basis for establishing location. If re-established through lost corner proportionate methods, indicate all monuments, distances and directions used to establish. Indicate type of monument and sign post found or set.

This is a perpetuation of a previous USPLS Monument Record by Milo E. Stefan, RLS dated February 19, 1985 and filed in the office of the Langlade County Surveyor. A complete history of the corner can be found on the previous monument record. I accept the previous location as a true and faithful perpetuation or reestablishment of the original corner location and further perpetuate it as follows.

This is a perpetuation of a previous USPLS Monument Record by Alan D. Harrison, RLS dated October 26, 1994 and filed in the office of the Langlade County Surveyor. A complete history of the corner can be found on the previous monument record. I accept the previous location as a true and faithful perpetuation or reestablishment of the original corner location and further perpetuate it as follows.

November 6, 2016: I found and accepted the record monument, a 2-1/2" diam. aluminum pipe with a 3-1/4" diam. aluminum cap projecting 14" above the ground surface. I set a DEEP-1 magnet adjacent to the monument. All record bearing trees are gone or standing dead. I established accessories as shown below. A USFS steel sign post bears West, 1.8 ft. I set a white vinyl sign post bearing West, 0.8 ft.

(c)(d)(e) Plan view of corner with ties to at least 4 witness monuments. If in disagreement with previously established corner, show the distances between the two corners and also indicate the ties to the disputed.

set nail/sign in new set nail/sign in new 7" diam. aspen 6" diam. aspen T34N R14E S31 S32 S6 S5 2-1/2" dlam. **S88'W** T33N aluminum mon. 6.52 set nail/sign in new S75·F 3" diam. red maple 30.20 set 3/4" x 30" iron rod and plastic cap Magnetic 1" = 30' set 3/4" x 30" iron rod and plastic cap

FOREST COUNTY, WI CORTNEY BRITTEN CLEEREMAN REGISTER OF DEEDS RECEIVED FOR RECORD

APR 2 7 2018

Time: (): (): (): M. M. Vol.: Corner Restoration Page Number: Z-5

Clearcut South of Corner

(i) I, Jeffrey W. Austin, Professional Land Surveyor No. S-1885, hereby certify that the corner location on this record was determined by me or under my direction and control and that this U.S. Public Land Survey Monument Record is correct and complete to the best of my knowledge and belief.

gnature

1044.4.2017 Date



3414310000 (INDEX NO. A-5)

434 1431 0000

### U. S. PUBLIC LAND SURVEY MONUMENT RECORD

INSTRUCTIONS:

This record shall show the location of the corner and shall include all of the following nine elements (a through 1).


(a) Identify the corner by reference to the U.S. public land survey system.

O - Corner monument restored.

Section Corner to Sections 5, 6, 31, and 32, T.33-34N., R.14E., Forest and Langlade Counties, WI.

State Plane Coordinates
Wisconsin North Zone
79585.37562-N
2281752.35877-E

Geographic Coordinates 45-22-41.97973-N

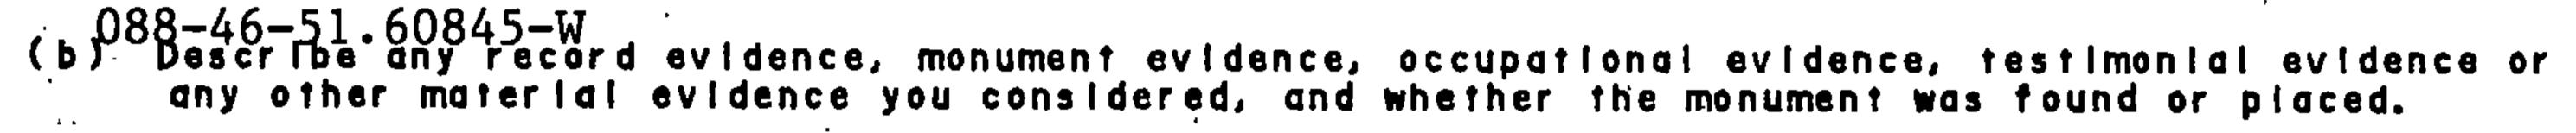

Original survey in 1857 by Alfred Millard. Set wood post and the following bearing trees; Hemlock, 28", S.55°E., 40 links, Yellow Birch, 14", S.45°W., 48 links, Hemlock, 16", N.43°W., 38 links, Hemlock, 14", N.60°E., 58 links.


In 1962 Neal Spearhake set an aluminum monument (KImberly Clark) off a scribed bearing tree. See "e" on reverse side.


In 1983, Milo Stefan, R.L.S., restored the corner from the remains of 3 original bearing tree stumps. Set a 2" x 36" aluminum monument with a tablet stamped to identify corner. Blazed and scribed new bearing trees; Balsam, 8", N.36°E., 30.60 feet, Aspen, 6", S.70°E., 27.38 feet, Balsam, 3", S.13°W., 6.70 feet, Balsam, 7", N.30°W., 15.26 feet, Steel sign post, West, 1.87 feet. Kimberly-Clark monument, S.37°E., 5.80 feet.

On March 26 1991, Alan Harrison, R.L.S., found monument and bearing trees as set in 1983. Northwest bearing tree is dead. Made 1 new bearing tree; Balsam, 8", S.55°W., 26.50 feet.

On November 1 1993, Alan Harrison, R.L.S., found monument and bearing trees as set in 1983 and 1991. Cut down all but the Northeast bearing tree. Blazed and scribed 3 new bearing trees; Aspen, 7", S.69°E., 42.19 feet, Aspen, 8", S.17°W., 32.60 feet, Balsam, 9", N.83°W., 63.79 feet.

- (c) In the plan view drawing below, provide reference ties to at least 4 witness monuments, or, if the location is within a municipality, to at least 2 witness monuments. (witness monuments shall be made of concrete, natural stone, iron orother equally durable material.)
- depicting the relevent monuments and reference ties which is sufficient in detail to enable accurate relocation of the corner monument if the corner monument is disturbed. Indicate north.
- 1. 2" x 36" aluminum monument with tablet stamped to identify corner.
  - 2. Balsam, 8", N.36°E., 30.60 feet.
- 3. Aspen, 7", S.69°E., 42.19 feet.
  - 4. Kimberly-Clark Monument, S.37°E., 5.80 feet.
  - 5. Aspen, 8", S.17°W., 32.60 feet.
  - 6. Balsam, 9", N.83°W., 63.79 feet.
  - 7. Steel sign post, West, 1.87 feet.

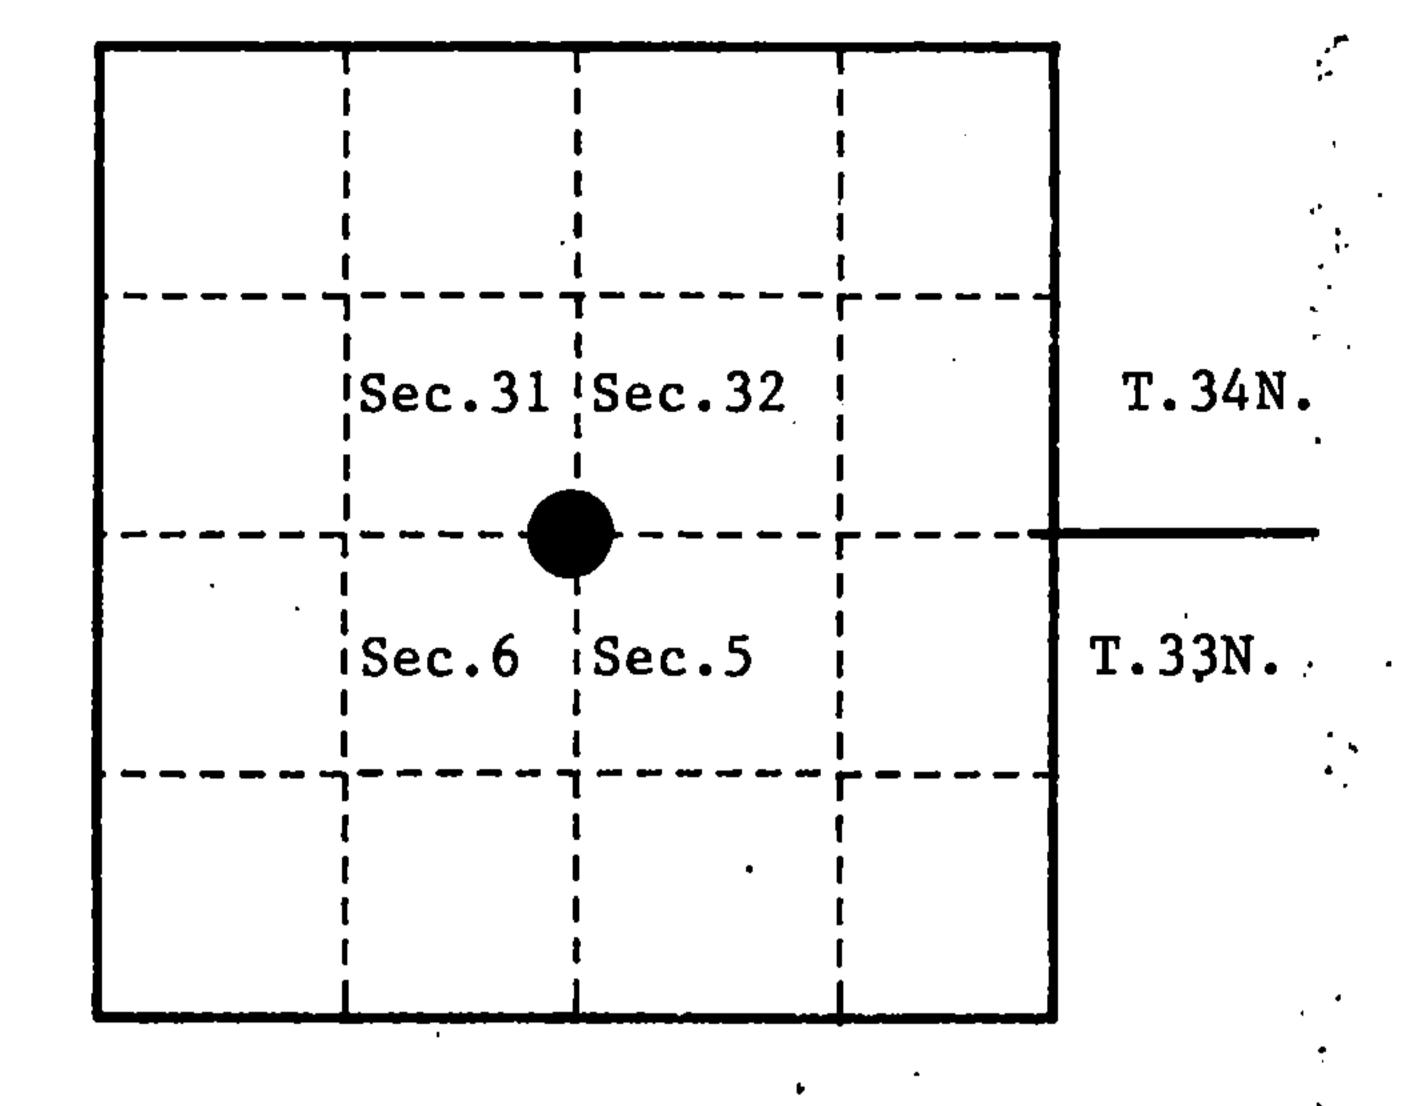

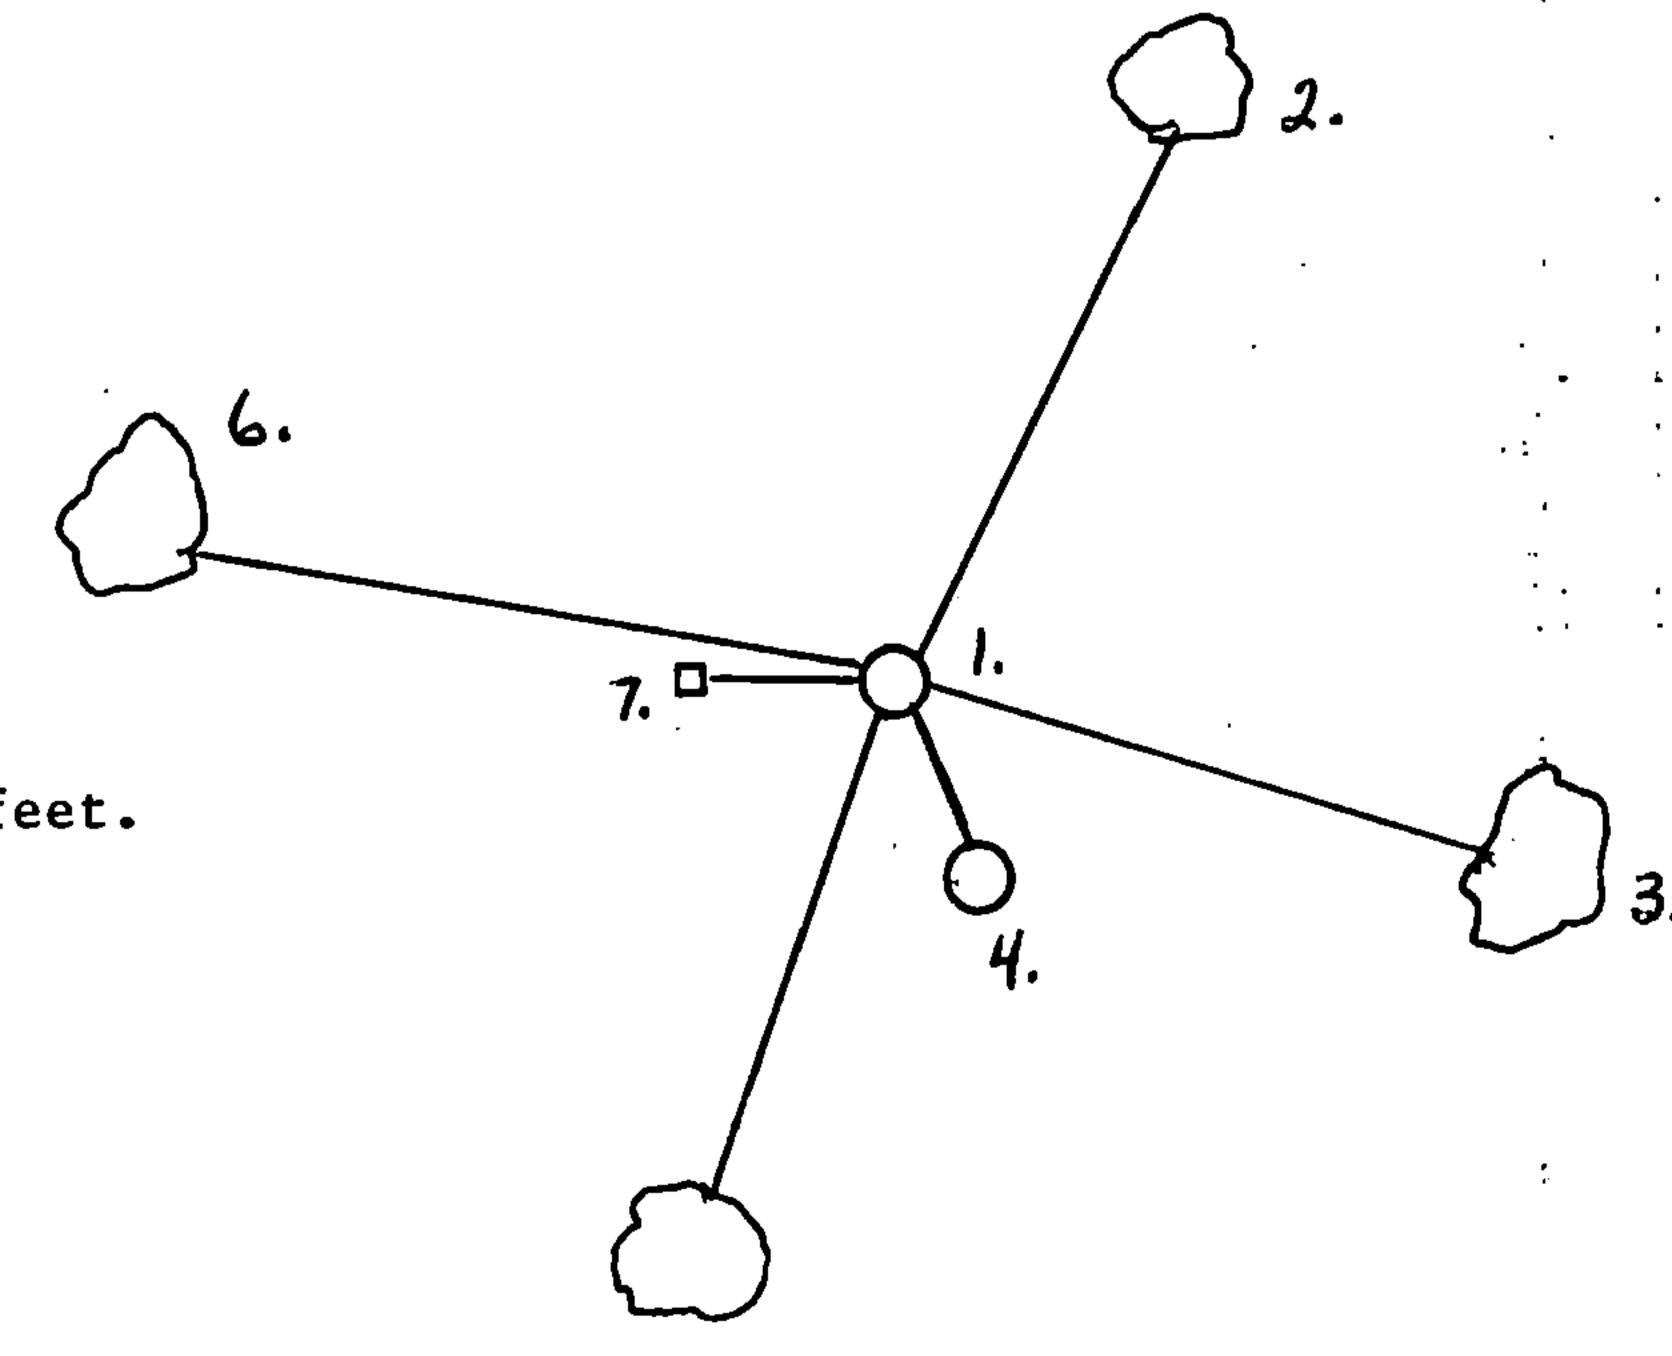

(e) Describe any material discrepancy between the location of the corner as restored or reestablished and the location of that corner as previously restored or reestablished by distance and direction. Show the discrepancy on the plan view drawing under (d), above. Show the distances between the corner as previously restored or reestablished and (i) the corner as restored or reestablished, and (2) to at least 2 of the witness monuments shown on the drawing in (d), above.

Kimberly-Clark monument was set from a resurvey bearing tree, origin unknown, which resulted in Kimberly-Clark monument being S.37°E., 5.80 feet from original corner position.

(f) Was the corner restored through acceptance of (1) an obliterated evidence location, or, (2) a found perpetuated location?

(1)


(g & h) Was the corner reestablished through lost corner proportionate methods? If so, show the method, including the directions and distances to other public land survey corners used as evidence or used for proportioning in determining the corner location?

No

REGISTER'S OFFICE
Forest County, Wis.

Received for record this 23 day
of ALMAN A.D. 19 % al

9:00 o'clock A.M. and recorded
in Vol. of the Land Land
page 34-14:2-5
Register of Deeds

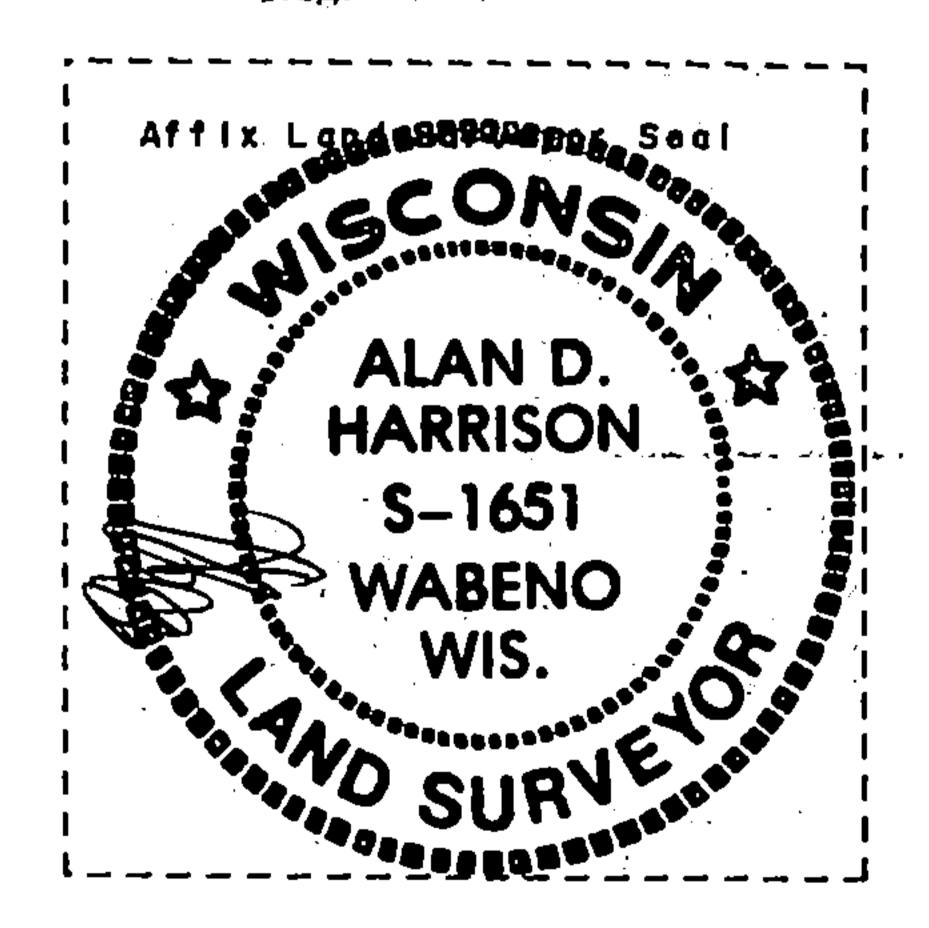

Alan D. Harrison

(type or print name) certify that the corner location shown on this record was determined by me or under my direction and control and that this U.S. Public Land Survey Monument Record is correct and complete to the best of my knowledge and belief.

Signature

Da,te

CERTIFICATE READY FOR FILING:

District Ranger

# U. S. PUBLIC LAND SURVEY MONUMENT RECORD

INSTRUCTIONS:

This record shall show the location of the corner and shall include all of the following nine elements (a through i).

(a) Identify the corner by reference to the U.S. public land survey system.


O - Corner monument restored.

Section corner to Sections 5, 6, 31, and 32, T.33-34N., R.14E.

REGISTER'S OFFICE
Forest County, Wis.

Received for record this day
of A.D., 19 35 at
3:10 o'clock A.M. and recorded
in Vol. CORNER RESTORATIONS
page Z-5

Register of Doods

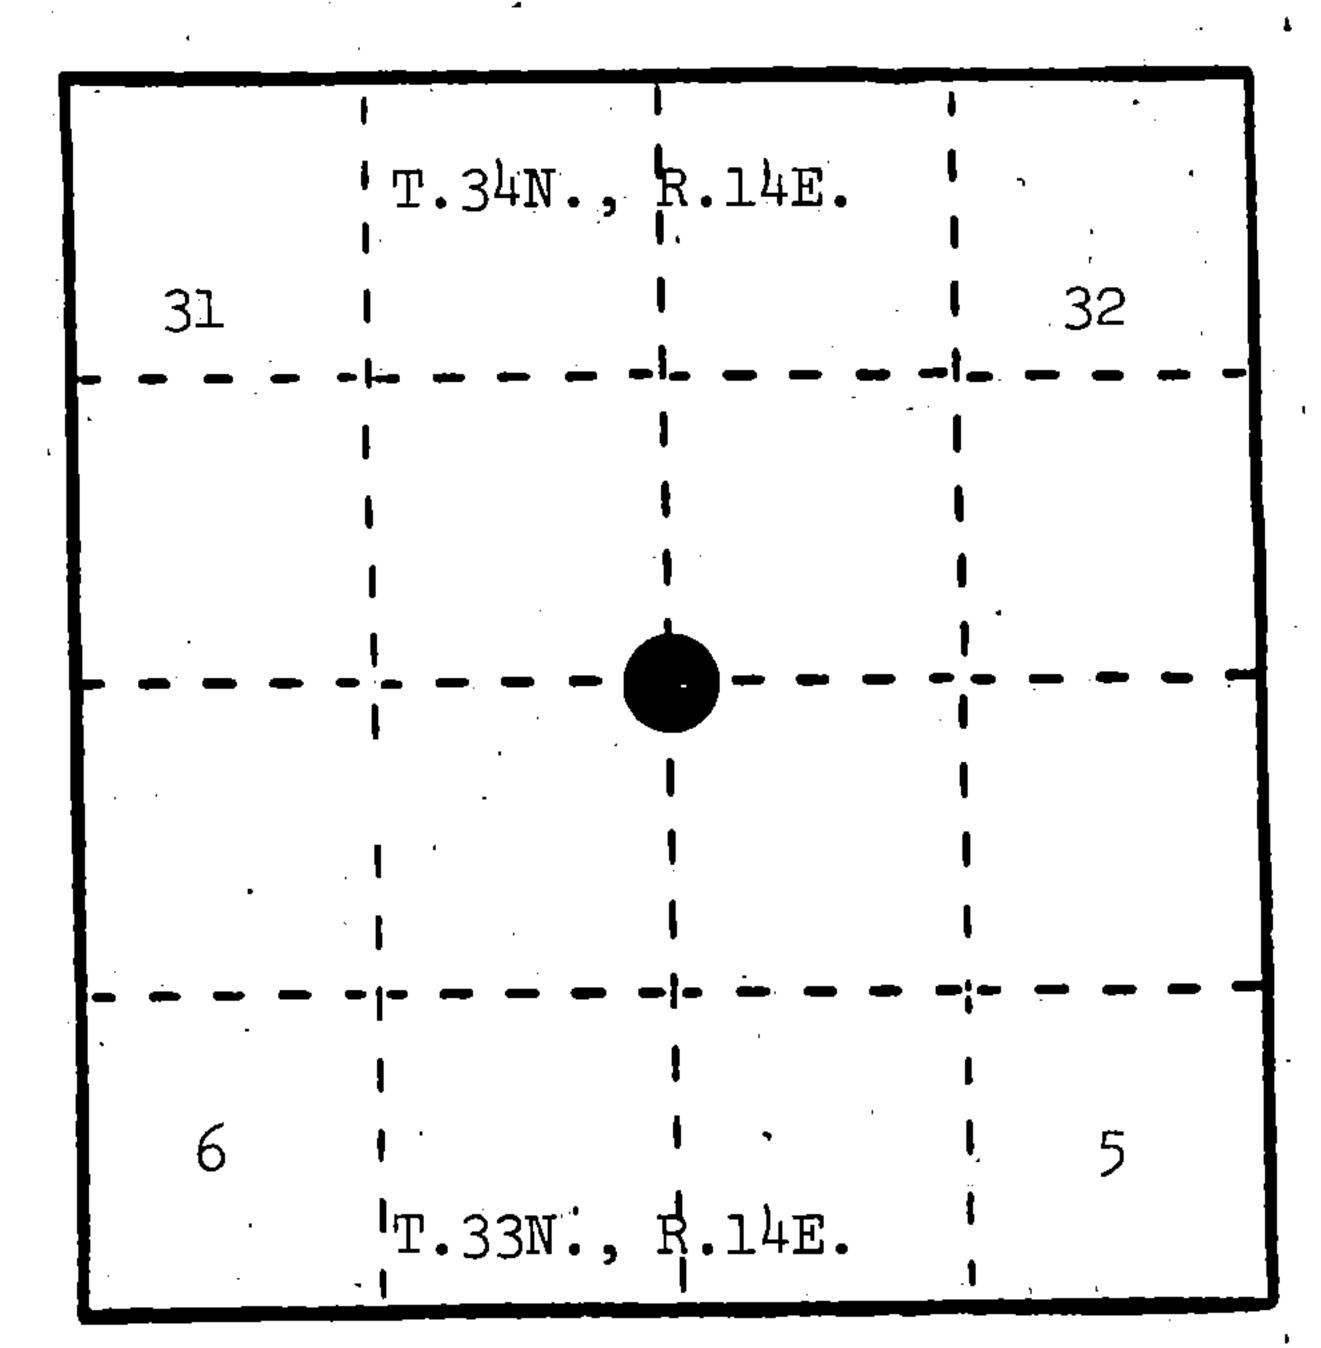

(b) Describe any record evidence, monument evidence, occupational evidence, testimonial evidence or any other material evidence you considered, and whether the monument was found or placed.


In June, 1857, Alfred Millard set wood post and made the following BTs: Hemlock, 28", S.55°E., 40 links; Yellow Birch, 14", S.45°W., 48 links; Hemlock, 16", N.43°W., 38 links; Hemlock, 14", N.60°E., 58 links.

1962, Neal Spearhake set aluminum monument (Kimberly Clark) off scribed bearing tree-see "e" on reverse side.

In April, 1984, Milo Stefan restored corner position from the remains of the original bearing tree stumps.

- (c) In the plan view drawing below, provide reference ties to at least 4 witness monuments, or, if the location is within a municipality, to at least 2 witness monuments. (Witness monuments shall be made of concrete, natural stone, iron or other equally durable material.)

  Describe witness monuments.
- (d) Show a plan view drawing depicting the relevant monuments and reference ties which is sufficient in detail to enable accurate relocation of the corner monument if the corner monument is disturbed. Indicate north.
- 1. Balsam, 8", N.36°E., 30.60 feet
- 2. Aspen, 6", S.70°E., 27.38 feet
- 3. Balsam, 3", S.13°W., 6.70 feet
- 4. Balsam, 7", N.30°W., 15.26 feet
- 5. Steel Sign Post, West, 1.87 feet
- Kimberly Clark monument, S.37°E., 5.80 feet
- 7. 2" x 36" aluminum monument stamped to identify the corner.

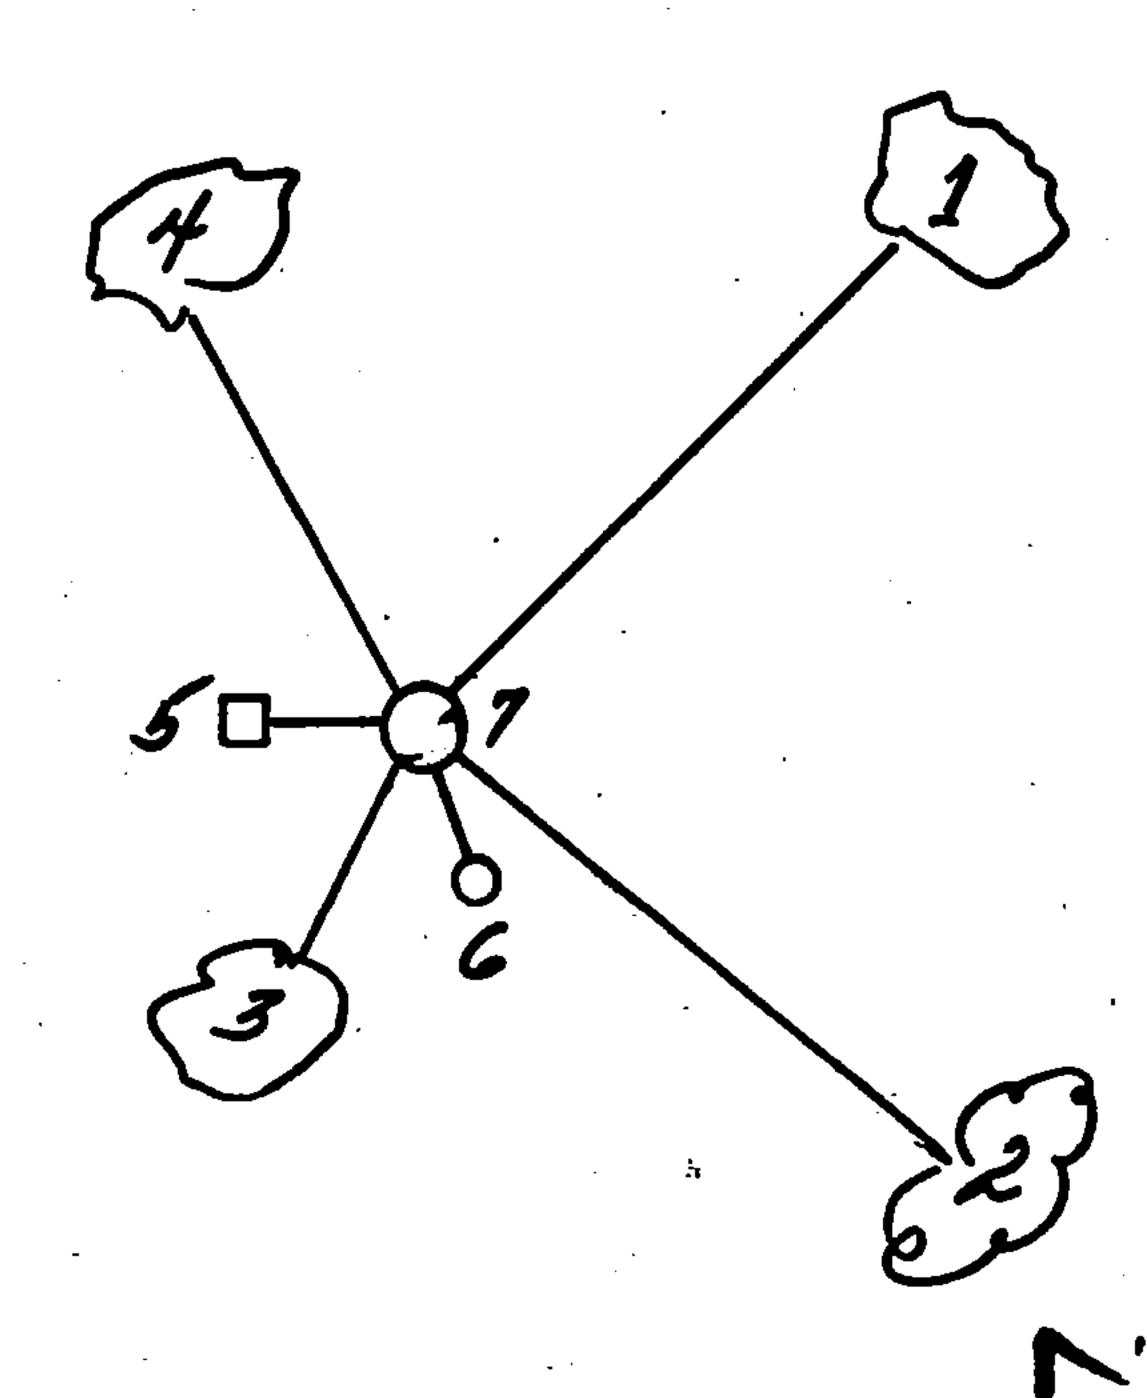

Describe any material discrepancy between the location of the corner as restored or reestablished and the location of that corner as previously restored or reestablished by distance and direction. Show the discrepancy on the plan view drawing under (d), above. Show the distances between the corner as previously restored or reestablished and (1) the corner as restored or reestablished, and (2) to at least 2 of the witness monuments shown on the drawing in (d), above.

Kimberly Clark monument was set from resurvey bearing tree, origin unknown, which resulted in Kimberly Clark corner position being S.37°E., 5.8 feet from original corner position.

- (f) was the corner restored through acceptance of (1) an obliterated evidence location, or, (2) a found perpetuated location?
- (1) an obliterated evidence location.

(gan) was the corner reestablished through lost corner proportionate methods? If so, show the method, including the directions and distances to other public land survey corners used as evidence or used for proportioning in determining the corner location?

(i) I. Milo E. Stefan

(type or print name) certify that the corner location shown on this record was determined by me or under my direction and control and that this U.S. Public Land Survey Monument Record Is correct and complete to the best of my knowledge and belief.

Signature Signature

0010

MILO ESTEFAN
S-1558
RHINELANDER,
WIS.

# U. S. PUBLIC LAND SURVEY MONUMENT RECORD

INSTRUCTIONS:

This record shall show the location of the corner and shall include all of the following nine elements (a through i).

(a) Identify the corner by reference to the U.S. public land survey system.


O - Corner monument restored.

Section corner to Sections 5, 6, 31, and 32, T.33-34N., R.14E.

REGISTER'S OFFICE
Forest County, Wis.

Received for record this day
of A.D., 19 35 at
3:10 o'clock A.M. and recorded
in Vol. CORNER RESTORATIONS
page Z-5

Register of Doods

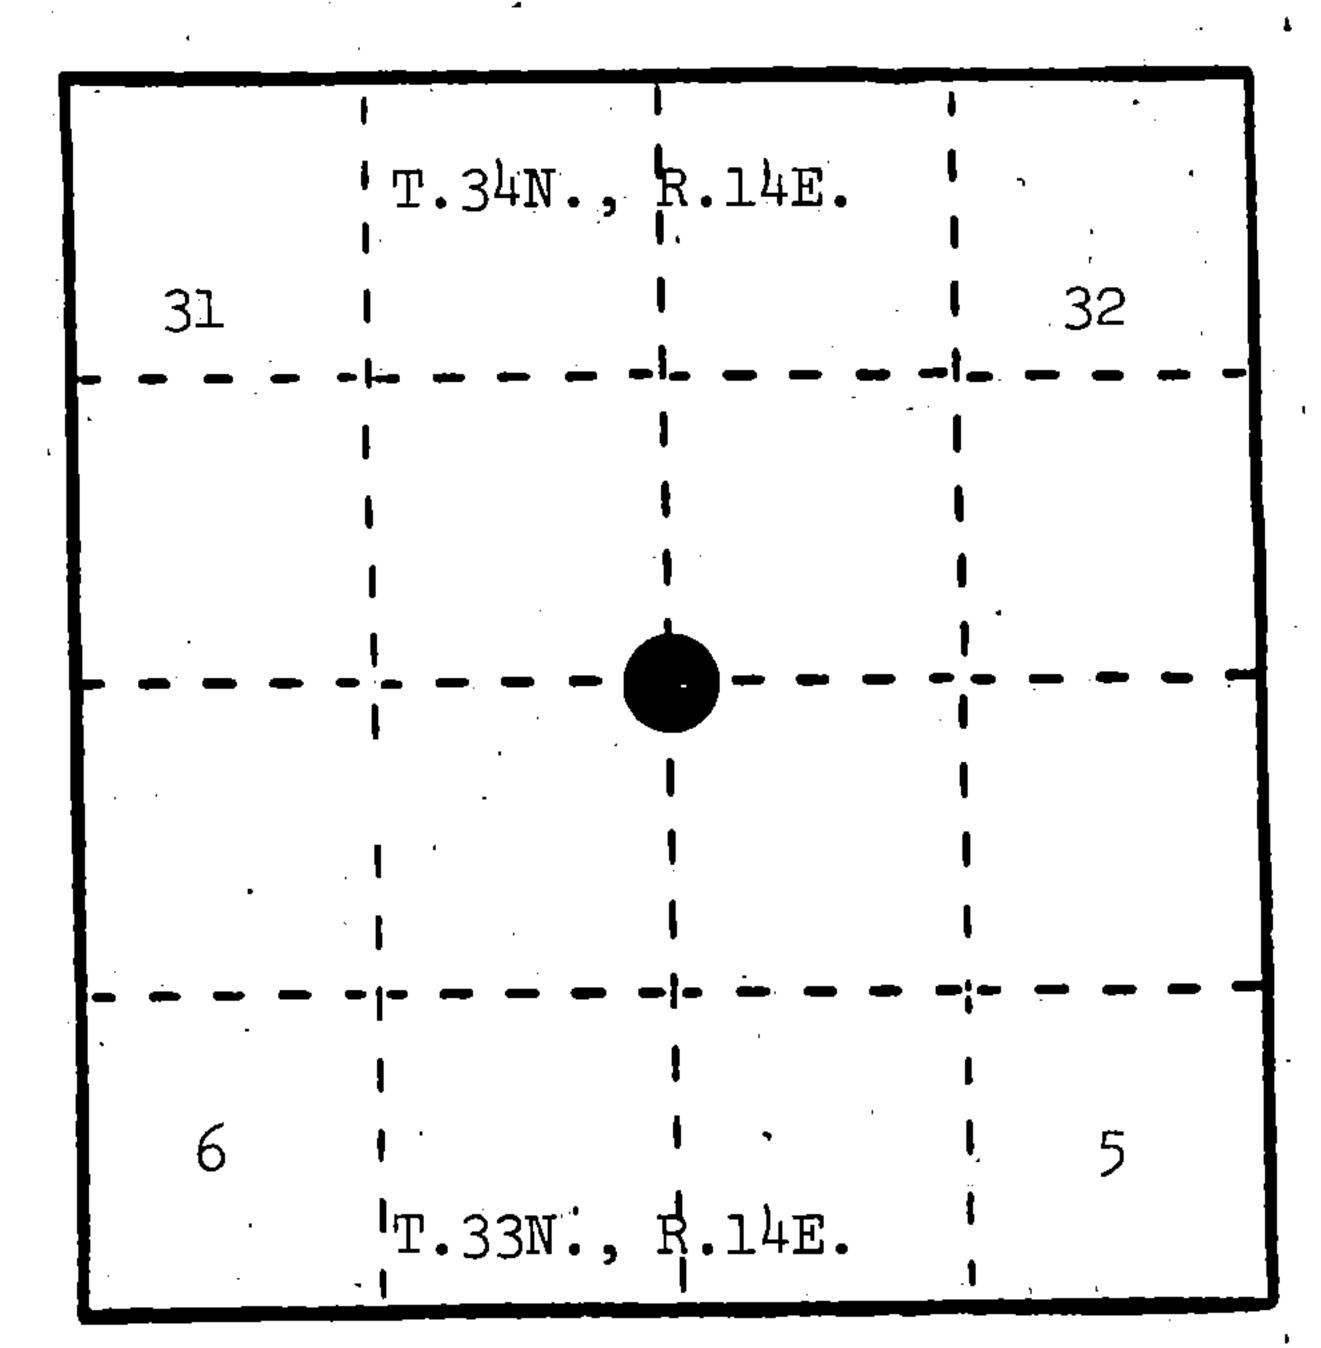

(b) Describe any record evidence, monument evidence, occupational evidence, testimonial evidence or any other material evidence you considered, and whether the monument was found or placed.


In June, 1857, Alfred Millard set wood post and made the following BTs: Hemlock, 28", S.55°E., 40 links; Yellow Birch, 14", S.45°W., 48 links; Hemlock, 16", N.43°W., 38 links; Hemlock, 14", N.60°E., 58 links.

1962, Neal Spearhake set aluminum monument (Kimberly Clark) off scribed bearing tree-see "e" on reverse side.

In April, 1984, Milo Stefan restored corner position from the remains of the original bearing tree stumps.

- (c) In the plan view drawing below, provide reference ties to at least 4 witness monuments, or, if the location is within a municipality, to at least 2 witness monuments. (Witness monuments shall be made of concrete, natural stone, iron or other equally durable material.)

  Describe witness monuments.
- (d) Show a plan view drawing depicting the relevant monuments and reference ties which is sufficient in detail to enable accurate relocation of the corner monument if the corner monument is disturbed. Indicate north.
- 1. Balsam, 8", N.36°E., 30.60 feet
- 2. Aspen, 6", S.70°E., 27.38 feet
- 3. Balsam, 3", S.13°W., 6.70 feet
- 4. Balsam, 7", N.30°W., 15.26 feet
- 5. Steel Sign Post, West, 1.87 feet
- Kimberly Clark monument, S.37°E., 5.80 feet
- 7. 2" x 36" aluminum monument stamped to identify the corner.

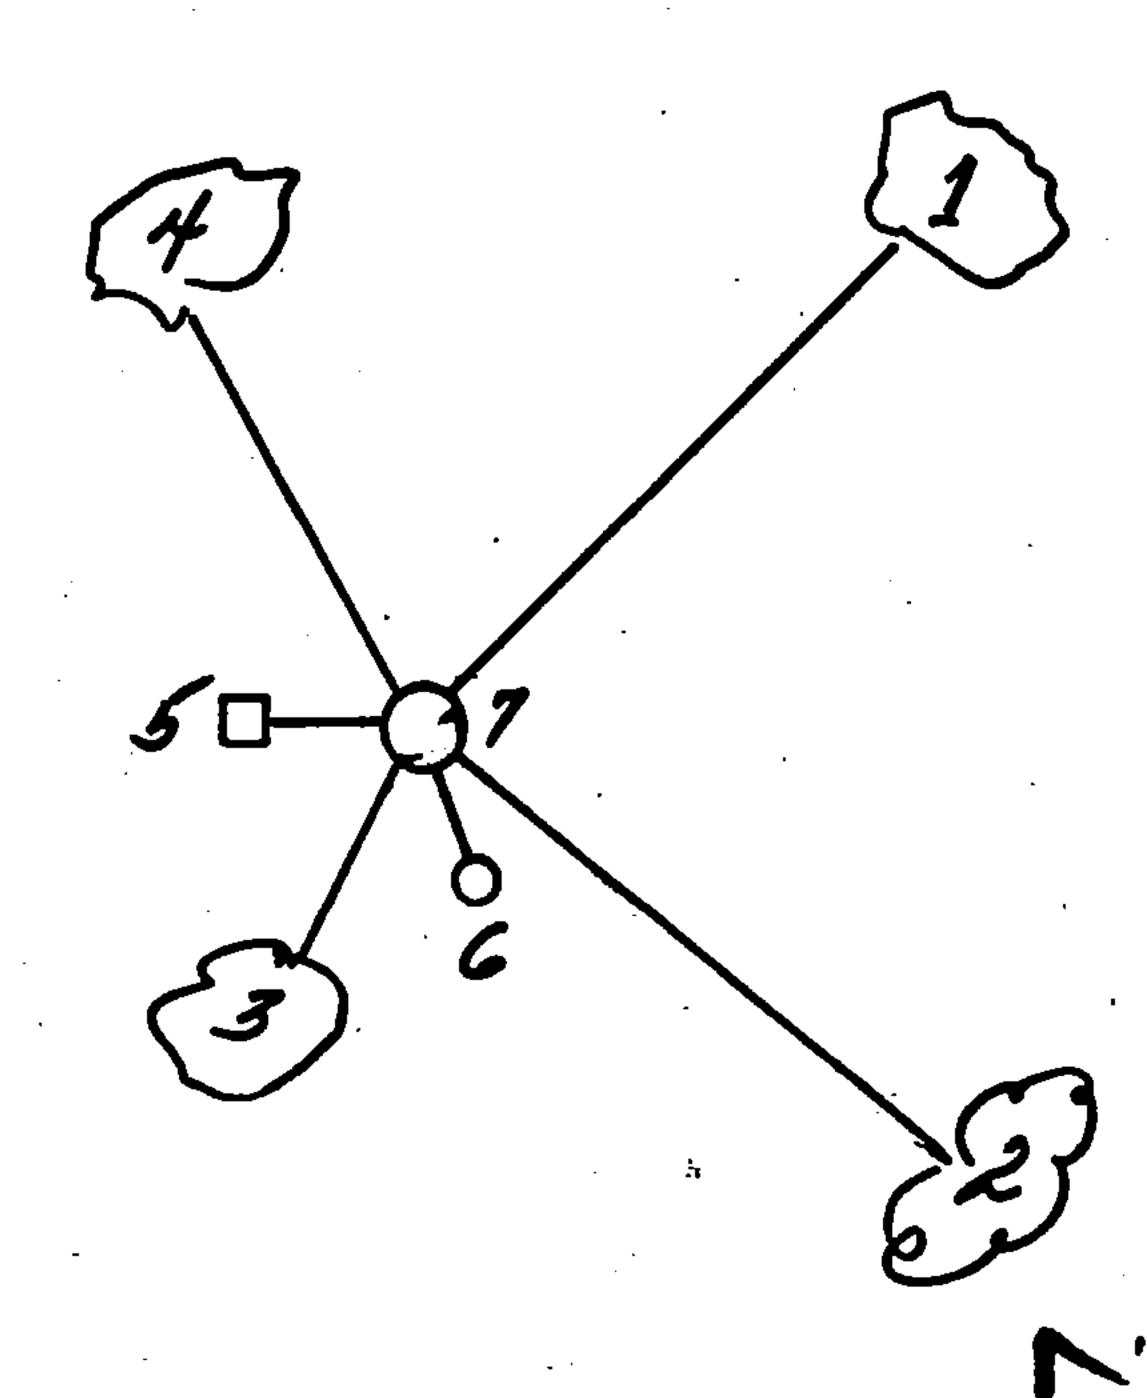

Describe any material discrepancy between the location of the corner as restored or reestablished and the location of that corner as previously restored or reestablished by distance and direction. Show the discrepancy on the plan view drawing under (d), above. Show the distances between the corner as previously restored or reestablished and (1) the corner as restored or reestablished, and (2) to at least 2 of the witness monuments shown on the drawing in (d), above.

Kimberly Clark monument was set from resurvey bearing tree, origin unknown, which resulted in Kimberly Clark corner position being S.37°E., 5.8 feet from original corner position.

- (r) was the corner restored through acceptance of (1) an obliterated evidence location, or, (2) a found perpetuated location?
- (1) an obliterated evidence location.

(gan) was the corner reestablished through lost corner proportionate methods? If so, show the method, including the directions and distances to other public land survey corners used as evidence or used for proportioning in determining the corner location?

(i) I. Milo E. Stefan

(type or print name) certify that the corner location shown on this record was determined by me or under my direction and control and that this U.S. Public Land Survey Monument Record Is correct and complete to the best of my knowledge and belief.

Signature Signature

0010

MILO ESTEFAN
S-1558
RHINELANDER,
WIS.

•		•	•	
			;	
	] 	] 	] ]	
	$ \frac{1}{1}$	   	<del> </del> -	- <del>-</del> ′
	· I	; ;	<b>1</b>	
		-34-		. — •
	\ 	1		
	1. · +	 	<del> </del> -	- <b>-</b>
-	I	\ \ \ \ \ \ \ \ \ \ \ \ \ \ \ \ \ \ \	<b>1</b>	

Wisconsin

certify that on the FIRST day

SECTION 31

14 EAST ; Fourth Principal Meridian,

as described hereon; and that from this evidence

established a new monument and accessories

as described hereon to perpetuate the original

FOREST

evidence of the SOUTHEAST SECTION

NEAL SPERHAKE

Richard Piontek - Waubeno

David Pichotta - Waubeno

State of

of NOVEMBER

location of this corner.

Resident witnesses:

corner of

County of.

O = Corner monument restored.

#### CERTIFIED LAND CORNER RESTORATION

88934

Index No. 20

History of original corner establishment:

This corner can also be described as: THE SECTION CORNER COMMON TO SECTIONS 5 AND 6, T33M-R14E, AND, 31 AND 32, T34N-R14E, 4TH P.M.

This corner was established during the original survey of the town line between towns 33 and 34 North, as noted in the Original Field Notes for the Original Survey of T34N-R14E, 4th p.m.

Description of corner evidence found:

The original bearign three, described in the original field notes as:

"Hemlock 16 N43°W 38 links"

is still present at this date, with a portion of the original scribe marks still visible.

Description of monument and accessories I established to perpetuate the original location of this corner.

At the site of the original post, as determined from the existing original bearing tree noted above, I emplaced a "Galvanized iron pipe, three feet long, one inch in diameter, with an aluminum cap denoted as, 'KIMBERLY-CLARK CORP T33-34N 31, 32, 5, 6, R14E SPERHAKE RLS 463 11-1-62".

The pipe is witnessed by:

Balsam 3 N34°W 32 links. (Scribed S31 NBT). Balsam 5 N24°E 50 links. (Scribed S32 NBT).

Dated at Crandon	, Wis., this	25th	day of	August	, 19 64
Signature (County Surveyor, Regis	Title Reg	istered	Land Surve	yor Regist	ration No. S-463
(County Surveyor, Regis	stered Land Surveyor, o	or other du	ly authorized offi	icial)	
Office of Register of Deeds, County o	f Forest			, I hereby ce	rtify that the within
nstrument was filed in this office for	record on the2!	<u>5</u>	day of	L. August	, 19. <sup>04</sup>
at 2:00 o'clock P. M.			Subscrib Neal Sperk		before me by day of Augl964.
(Register of Deeds)			Nota Com.	ry Public For expires Oct.	est Co. Wis. 31,1965