


U. S. PUBLIC LAND SURVEY MONUMENT RECORD

INSTRUCTIONS:

This record shall show the location of the corner and shall include all of the following nine elements (a through i).

- (a) Identify the corner by reference to the U.S. public land survey system.
- = Corner monument restored.

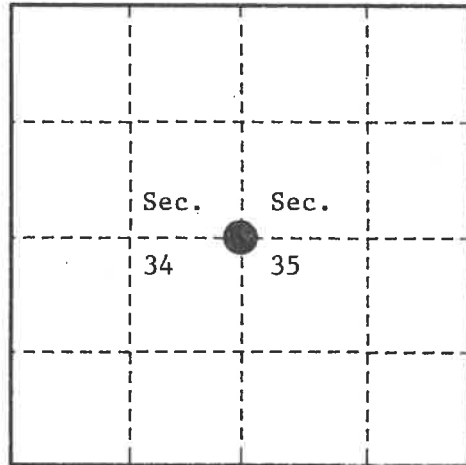

Quarter Corner to Sections 34 and 35,  
R.34N., R.14E., Forest County, WI.

State Plane Coordinates  
Wisconsin North Zone  
82576.67596-N  
2297626.05504-E

Geographic Coordinates  
45-23-09.04195-N

- (b) ~~088-43-08.59370-W~~  
Describe any record evidence, monument evidence, occupational evidence, testimonial evidence or any other material evidence you considered, and whether the monument was found or placed.

Original survey in 1859 by James McBride. Set wood post and the following bearing trees; Sugar, 12", N.77°W., 23 links, Birch 15", S.56°E., 12 links.


In 1907, J.J. Melindy set a new Elm post and made the following new bearing trees; Maple, 10", S.30 1/4° E., 29 1/3 links, Maple, 8", S.36 1/2°W., 33 5/8 links.

In 1985, Alan Harrison, R.L.S., found an iron pipe in a rock pile with the top of an Elm post on ground. Found the following bearing tree remains; Large Turnout, N.77°W., 15.2 feet, Sugar Stump, 16", S.30°E., 19.4 feet, Stump hole, S.36°W., 22.1 feet. In place of iron pipe, set a 2 1/2" x 36" aluminum monument with a tablet stamped to identify corner. Blazed and scribed new bearing trees; Sugar, 7", N.26°E., 32.13 feet, Sugar, 10", S.36°E., 22.86 feet, Hemlock, 12", S.57°W., 20.58 feet, Steel sign post, North, 1.85 feet.

On October 28 1993, Alan Harrison, R.L.S., found the monument and bearing trees as set in 1985. Cut down the Hemlock bearing tree for G.P.S. Observations. Blazed and scribed a new bearing tree; Sugar, 8", N.52°W., 35.64 feet.

- (c) In the plan view drawing below, provide reference ties to at least 4 witness monuments, or, if the location is within a municipality, to at least 2 witness monuments. (witness monuments shall be made of concrete, natural stone, iron or other equally durable material.)

- (d) Show a plan view drawing depicting the relevant monuments and reference ties which is sufficient in detail to enable accurate relocation of the corner monument if the corner monument is disturbed. Indicate north.

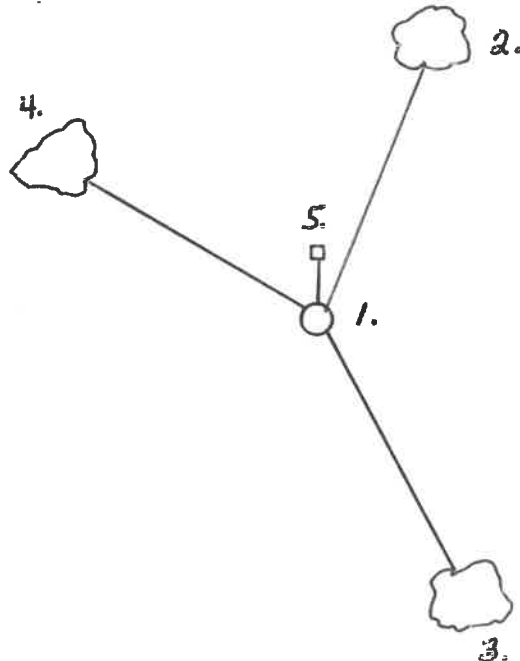

1. 2 1/2" x 36" aluminum monument with tablet stamped to identify corner.
2. Sugar, 7", N.26°E., 32.13 feet.
3. Sugar, 10", S.36°E., 22.86 feet.
4. Sugar, 8", N.52°W., 35.64 feet.
5. Steel sign post, North, 1.85 feet.

(e) Describe any material discrepancy between the location of the corner as restored or reestablished and the location of that corner as previously restored or reestablished by distance and direction. Show the discrepancy on the plan view drawing under (d), above. Show the distances between the corner as previously restored or reestablished and (1) the corner as restored or reestablished, and (2) to at least 2 of the witness monuments shown on the drawing in (d), above.

None


(f) Was the corner restored through acceptance of (1) an obliterated evidence location, or, (2) a found perpetuated location?

(2)

(g & h) Was the corner reestablished through lost corner proportionate methods? If so, show the method, including the directions and distances to other public land survey corners used as evidence or used for proportioning in determining the corner location?

No

REGISTER'S OFFICE {  
Forest County, Wis. {  
Received for record this 23rd day  
of November, A.D., 1994 at  
2:00 o'clock A.M. and recorded  
in Vol. Casey Restorations  
page 34-14-K-17  
Sue Vap, Deputy  
Register of Deeds

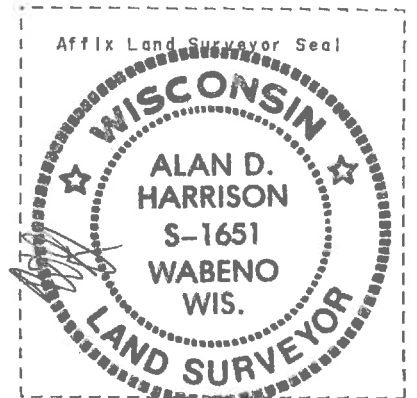

(1) I, Alan D. Harrison  
(type or print name) certify that the corner location shown on this record was determined by me or under my direction and control and that this U.S. Public Land Survey Monument Record is correct and complete to the best of my knowledge and belief.

Alan D. Harrison 10/26/94  
Signature Date

CERTIFICATE READY FOR FILING:

Sue Vap  
District Ranger


U. S. PUBLIC LAND SURVEY MONUMENT RECORD

INSTRUCTIONS: This record shall show the location of the corner and shall include all of the following nine elements (a through i).

(a) Identify the corner by reference to the U.S. public land survey system.

○ = Corner monument restored.

Quarter corner to Sections 34 and 35, T.34N., R.14E.

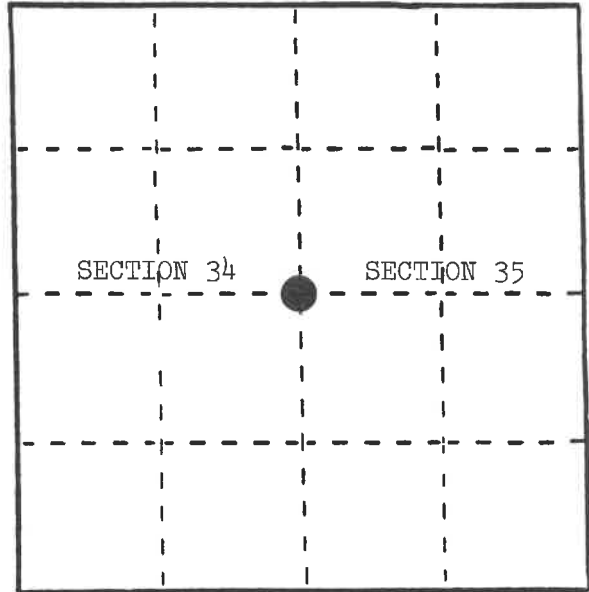

REGISTER'S OFFICE }  
Forest County, Wis.

Received for record this 21st day  
of October A.D., 1985 at

12:00 o'clock A.M. and recorded  
in Vol. CORNER RESTORATIONS

X-17  
Paul Aschenbrenner  
Register of Deeds

(b) Describe any record evidence, monument evidence, occupational evidence, testimonial evidence or any other material evidence you considered, and whether the monument was found or placed.

In 1859, James McBride set wood post and the following BTs: Sugar, 12", N.77°W., 23 links; Birch, 15", S.56°E., 12 links.


In 1907, J. J. Melindy set new Elm post (original Birch decayed, Maple o.k.) and made the following new BTs: Maple, 10", S.30¼°E., 29 1/3 links; Maple, 8", S.36½°W., 33 5/8 links.

In 1985, Al Harrison found iron pipe in rock pile with top of Elm post on ground and following BT remains: Large turnout, N.77°W., 15.2 feet; Sugar stump, 16", S.30°E., 19.4 feet; Stump hole, S.36°W., 22.1 feet.

(c) In the plan view drawing below, provide reference ties to at least 4 witness monuments, or, if the location is within a municipality, to at least 2 witness monuments. (Witness monuments shall be made of concrete, natural stone, iron or other equally durable material.) Describe witness monuments.

(d) Show a plan view drawing depicting the relevant monuments and reference ties which is sufficient in detail to enable accurate relocation of the corner monument if the corner monument is disturbed. Indicate north.

1. 2" x 36" aluminum monument stamped to identify corner location
2. Sugar, 7", N.26°E., 32.13 feet
3. Sugar, 10", S.36°E., 22.86 feet
4. Hemlock, 12", S.57°W., 20.58 feet
5. Steel Sign Post, North, 1.85 feet

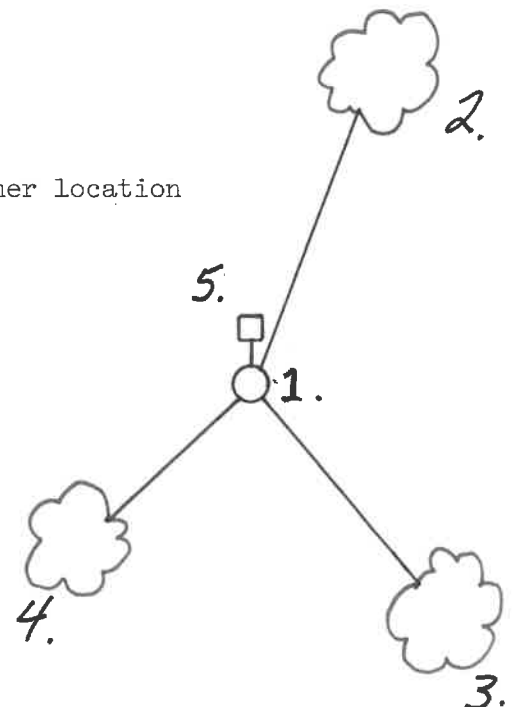

(e) Describe any material discrepancy between the location of the corner as restored or reestablished and the location of that corner as previously restored or reestablished by distance and direction. Show the discrepancy on the plan view drawing under (d), above. Show the distances between the corner as previously restored or reestablished and (1) the corner as restored or reestablished, and (2) to at least 2 of the witness monuments shown on the drawing in (d), above.

None.

(f) Was the corner restored through acceptance of (1) an obliterated evidence location, or, (2) a found perpetuated location?

(2) a found perpetuated location.

(g&h) Was the corner reestablished through lost corner proportionate methods? If so, show the method, including the directions and distances to other public land survey corners used as evidence or used for proportioning in determining the corner location?

No.

(i) I, Al Harrison  
(type or print name) certify that the corner location shown on this record was determined by me or under my direction and control and that this U.S. Public Land Survey Monument Record is correct and complete to the best of my knowledge and belief.

Alan D. Harrison  
Signature

9/16/85  
Date

