


U. S. PUBLIC LAND SURVEY MONUMENT RECORD

INSTRUCTIONS: This record shall show the location of the corner and shall include all of the following nine elements (a through i).

(a) Identify the corner by reference to the U.S. public land survey system.

○ = Corner monument restored.

Quarter corner between Sections 1 and 6, T.34N., R.15-16E.

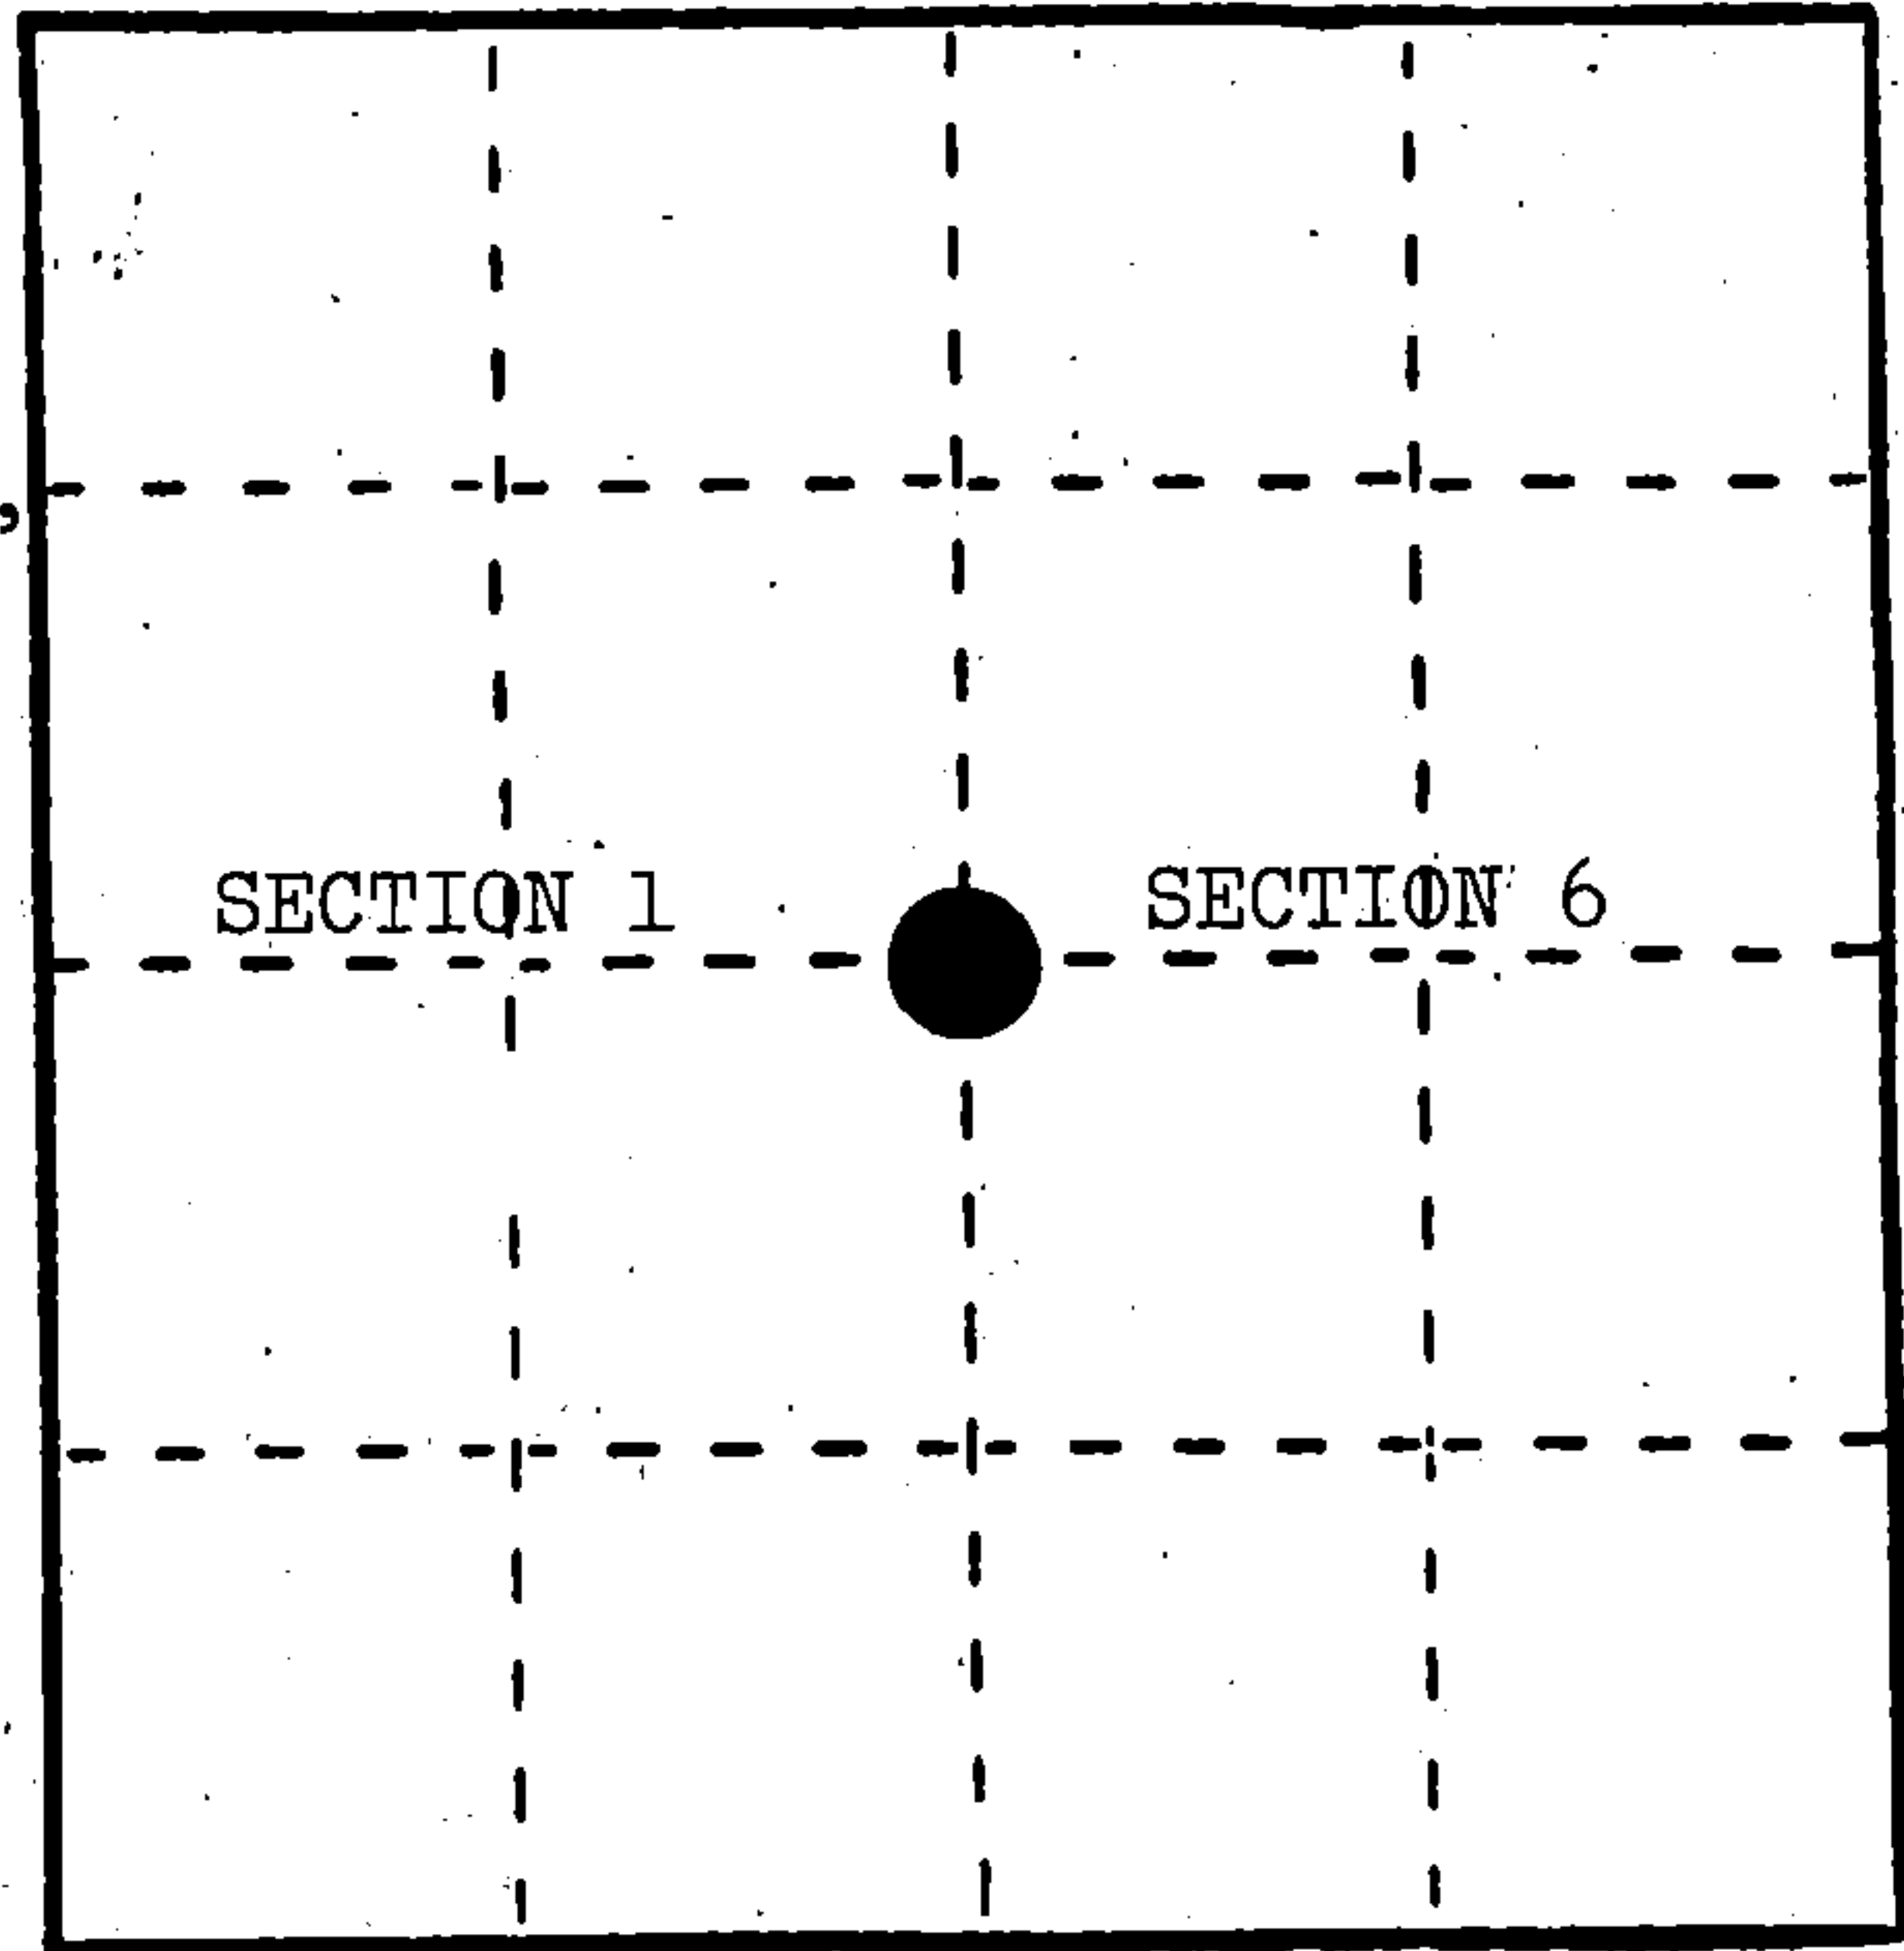

(b) Describe any record evidence, monument evidence, occupational evidence, testimonial evidence or any other material evidence you considered, and whether the monument was found or placed.

In 1839, Tom Sprague set post with following BTs: Cedar, 12", N.80°W., 8 links; Cedar, 14", S.32°E., 19 links.


October 17, 1934, Stabo and Savee found stake in center of road; Yellow Birch BT, 12", SW $\frac{1}{2}$ chain, (not original); location poster of 4" Aspen, 1 $\frac{1}{2}$ chains north of corner.

September 22, 1983, Milo Stefan found base of Cedar post on west side of road and Yellow Birch stump, SW $\frac{1}{2}$ chain from road center. From new BT and 874 post, we restored corner position in Lindsey Road.

(c) In the plan view drawing below, provide reference ties to at least 4 witness monuments, or, if the location is within a municipality, to at least 2 witness monuments. (Witness monuments shall be made of concrete, natural stone, iron or other equally durable material.) Describe witness monuments.

(d) Show a plan view drawing depicting the relevant monuments and reference ties which is sufficient in detail to enable accurate relocation of the corner monument if the corner monument is disturbed. Indicate north.

1. "x" on large rock 8" below road surface.
2. Reference corner (2" x 36" monument) stamped to identify corner, S.36°E., 27.51'
3. Black Spruce, 8", N.50°E., 27.54'
4. Black Ash, 5", N.87°W., 23.63'
5. Red Maple, 5", N.28°W., 78.47'

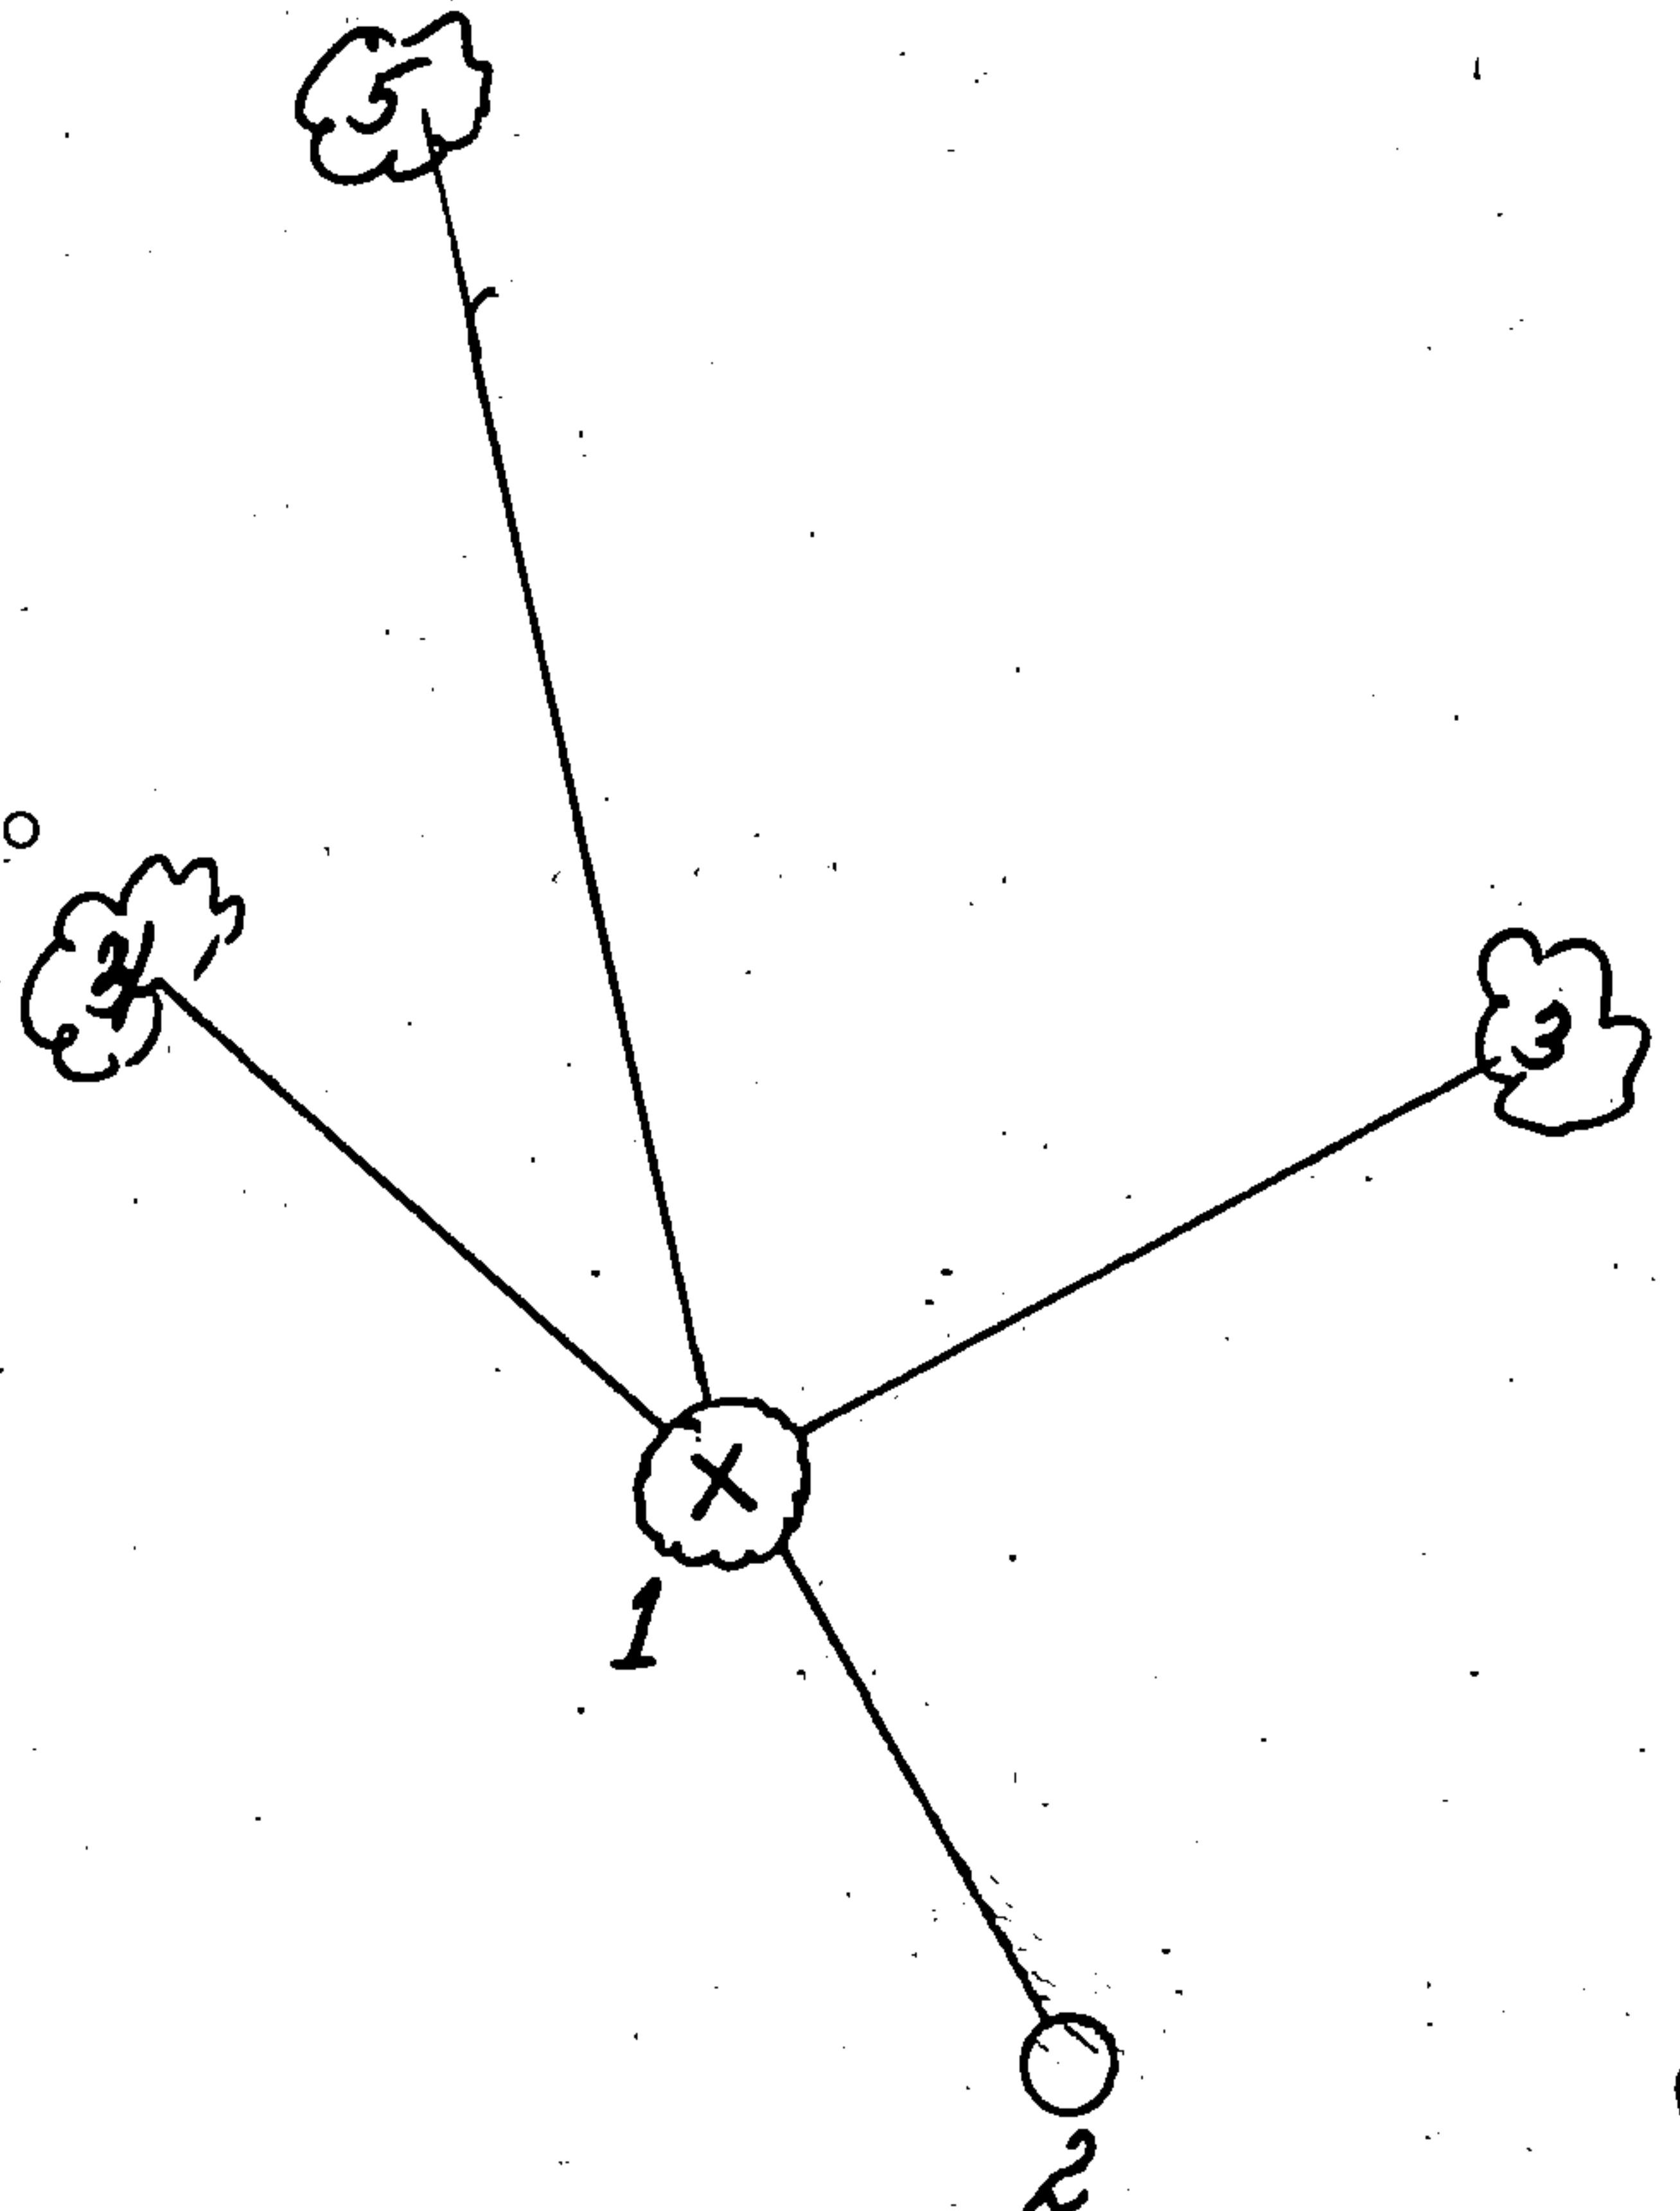

REGISTER'S OFFICE)
 Forest County, Wis.)
 Received for record this 23rd day
 of January.....A. D., 1985
 at 2:00 o'clock.....P.....M. and
 recorded in Vol. CORNER RESTORATIONS
 on page 1
Paul Aschenbrenner
 REGISTER

C-1

(e) Describe any material discrepancy between the location of the corner as restored or reestablished and the location of that corner as previously restored or reestablished by distance and direction. Show the discrepancy on the plan view drawing under (d), above. Show the distances between the corner as previously restored or reestablished and (1) the corner as restored or reestablished, and (2) to at least 2 of the witness monuments shown on the drawing in (d), above.

None.

(f) Was the corner restored through acceptance of (1) an obliterated evidence location, or, (2) a found perpetuated location?

(2) a found perpetuated location.

(g&h) Was the corner reestablished through lost corner proportionate methods? If so, show the method, including the directions and distances to other public land survey corners used as evidence or used for proportioning in determining the corner location?

No.

Affix Land Surveyor Seal



(1) I, Milo E. Stefan
(type or print name) certify that the corner location shown on this record was determined by me or under my direction and control and that this U.S. Public Land Survey Monument Record is correct and complete to the best of my knowledge and belief.

Milo E. Stefan
Signature

11/15/84
Date