


U. S. PUBLIC LAND SURVEY MONUMENT RECORD

INSTRUCTIONS: This record shall show the location of the corner and shall include all of the following nine elements (a through i).

(a) Identify the corner by reference to the U.S. public land survey system.

○ = Corner monument restored.

Quarter Corner Common to Sections 3 and 4 T34N, R15E, Forest County, Wisconsin.

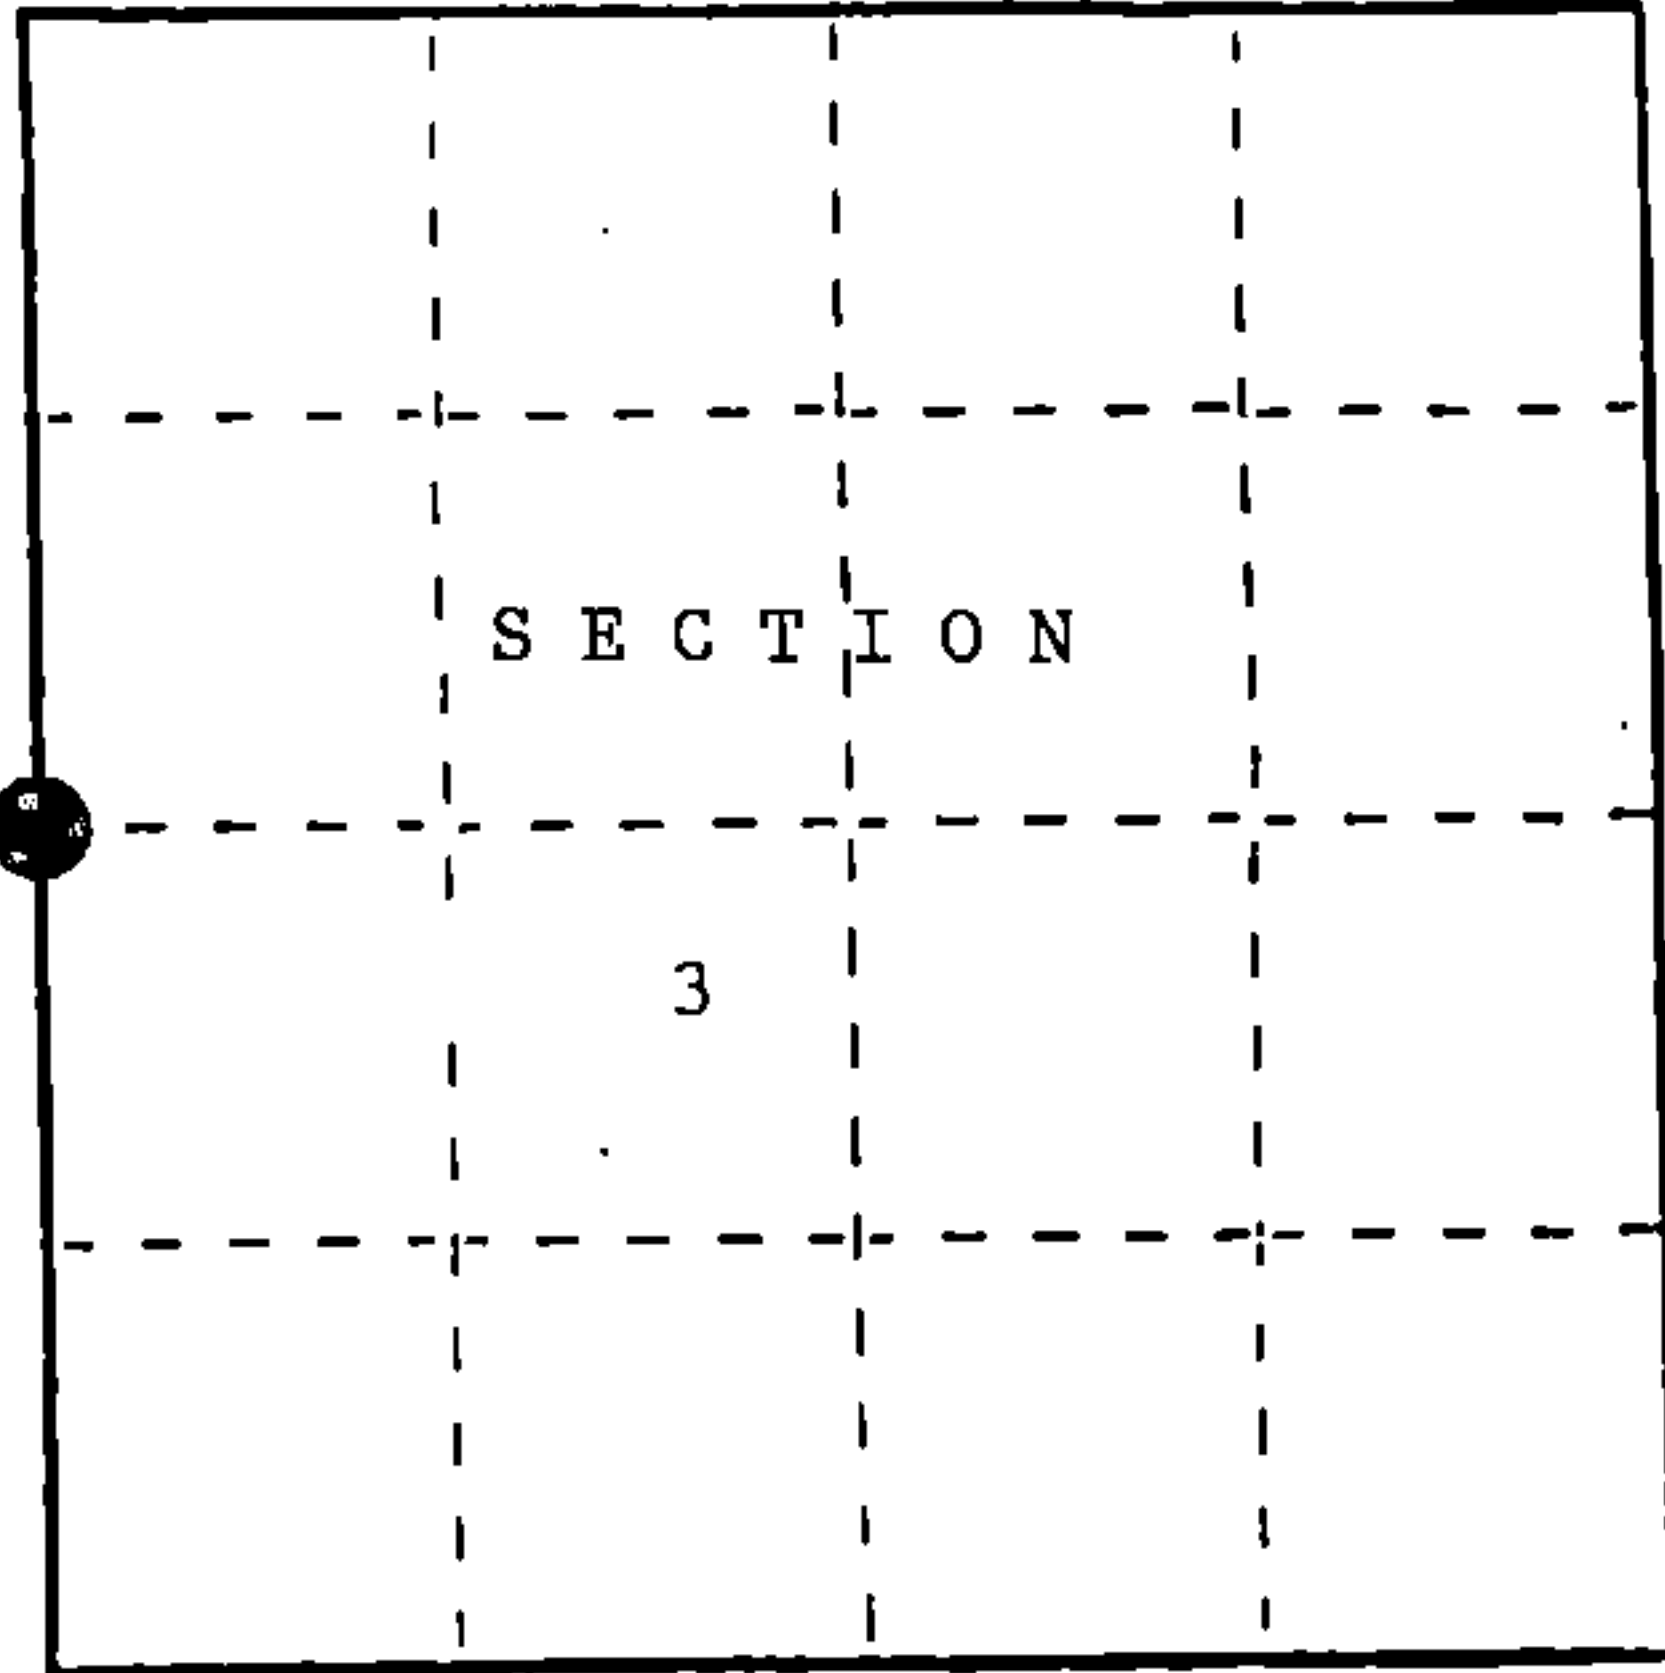

REGISTER'S OFFICE
Forest County, Wis. *gth*
Received for record this *9th* day
of *December* A.D., 19*88* at
2:50 o'clock *P.*M. and recorded
in Vol. *C-13* **CORNER RESTORATIONS**
page *13*
Paul Aschenbrenner
Register of Deeds

(b) Describe any record evidence, monument evidence, occupational evidence, testimonial evidence or any other material evidence you considered, and whether the monument was found or placed.

In 1959, J. McBride set a wood post for the corner and the following corner references:

Basswood	24"	N23°W	12 lks.
Sugar	14"	N56°E	24 lks.

In Oct. 1910, N. H. Smith found no evidence. Set a wood post for the corner and the following corner references:

Elm	12"	S64 3/4°E	85 1/2 lks.
Elm	6"	N37°35'W	63 1/2 lks.

In 1988, Found no evidence.
Placed a 2 1/2" X 36" aluminum monument.

(c) In the plan view drawing below, provide reference ties to at least 4 witness monuments, or, if the location is within a municipality, to at least 2 witness monuments. (Witness monuments shall be made of concrete, natural stone, iron or other equally durable material.) Describe witness monuments.

(d) Show a plan view drawing depicting the relevant monuments and reference ties which is sufficient in detail to enable accurate relocation of the corner monument if the corner monument is disturbed. Indicate north.

1. 2 1/2" X 36" aluminum magnetic cap monument stamped to identify the corner.
2. Sugar Maple 5" N67°W 34.50 ft.
3. Sugar Maple 4" N20°W 26.16 ft.
4. Red Maple 5" S13°E 34.54 ft.
5. Sugar Maple 3" S44°W 23.28 ft.
6. Steel sign post North 1.0 ft.

