


U. S. PUBLIC LAND SURVEY MONUMENT RECORD

INSTRUCTIONS: This record shall show the location of the corner and shall include all of the following nine elements (a through i).

(a) Identify the corner by reference to the U.S. public land survey system.

○ = Corner monument restored.

Quarter corner to Sections 5 and 6, T.34N., R.15E.

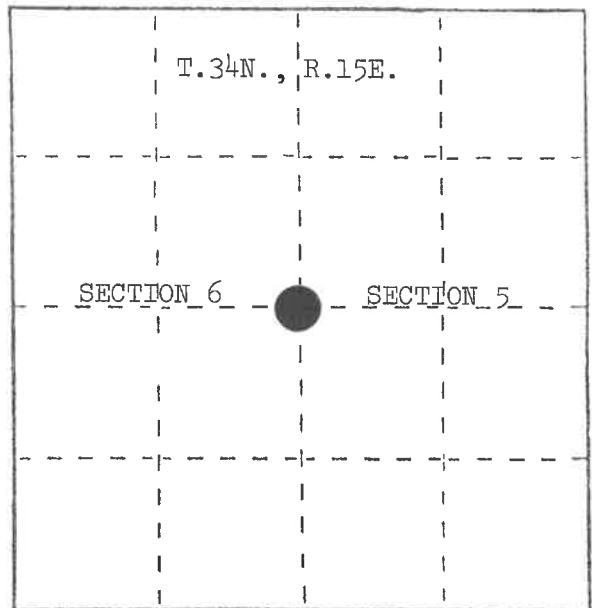


(b) Describe any record evidence, monument evidence, occupational evidence, testimonial evidence or any other material evidence you considered, and whether the monument was found or placed.

Corner location restored by lost methods. Set a 2" x 36" aluminum monument.

(c) In the plan view drawing below, provide reference ties to at least 4 witness monuments, or, if the location is within a municipality, to at least 2 witness monuments. (Witness monuments shall be made of concrete, natural stone, iron or other equally durable material.) Describe witness monuments.

(d) Show a plan view drawing depicting the relevant monuments and reference ties which is sufficient in detail to enable accurate relocation of the corner monument if the corner monument is disturbed. Indicate north.

1. White Spruce, 4", S.58°W., 104.32 feet
2. Basswood, 14", N.52°W., 31.74 feet
3. Basswood, 11", N.4°W., 42.94 feet
4. Steel Sign Post, North, 0.80 feet

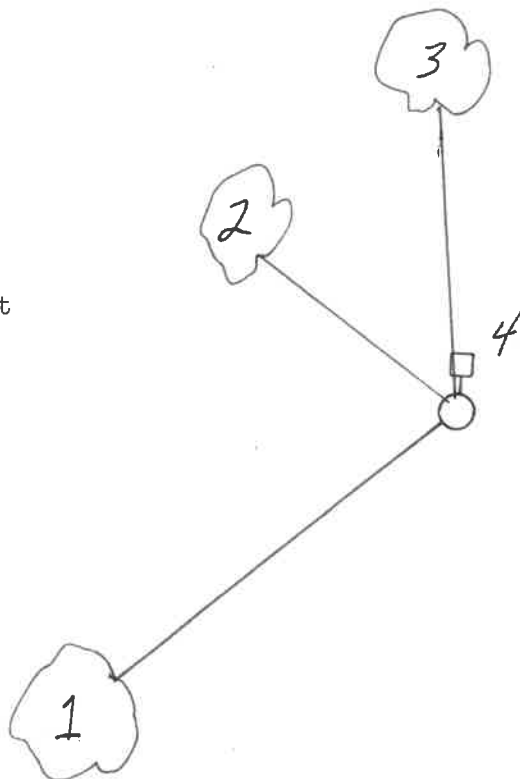

REGISTER'S OFFICE }
 Forest County, Wis. }
 Received for record this 21st day
 of January.....A. D., 1985 at
2:50 o'clock.....A.....M. and
 recorded in Vol. CORNER RESTORATIONS
 on page 5.....
Paul Aschenbrenner
 REGISTER

34-15

C
5

DOCUMENT NUMBER
136607


U. S. PUBLIC LAND SURVEY MONUMENT RECORD

INSTRUCTIONS: This record shall show the location of the corner and shall include all of the following nine elements (a through i).

(a) Identify the corner by reference to the U.S. public land survey system.

○ = Corner monument restored.

Quarter corner common to Sections 5 and 6, T34N, R15E, Forest County, Wisconsin.

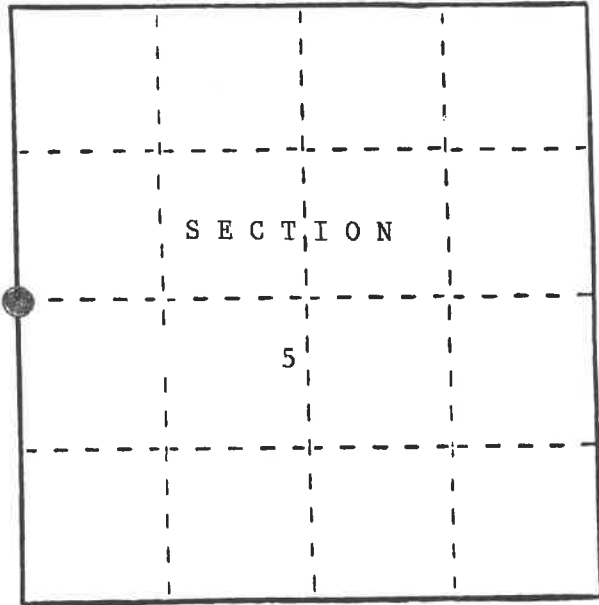

REGISTER'S OFFICE
Forest County, Wis. 19th
Received for record this 19th day
of December, D., 1988 at
2:50 o'clock P.M. and recorded
in Vol. CORNER RESTORATIONS
page 2-5
Paul Kschwendner
Register of Deeds

(b) Describe any record evidence, monument evidence, occupational evidence, testimonial evidence or any other material evidence you considered, and whether the monument was found or placed.

In 1859, James McBride set a wood post for the corner and the following corner references:
Sugar 12" S35°E 25 lks. Sugar 7" N54°W 10 lks.

In 1908, J. Melendy declared the corner lost and set wood post by proportionate measurement. The following corner references: Maple 6" N77°E 30 lks. Maple 12" S23°E 28 lks.

In 1984, Milo Stefan restored corner as described on the Corner Certificate (Doc. #127191).
In 1988, John Schulke found monument as described on said document #127191 (see item e).

(c) In the plan view drawing below, provide reference ties to at least 4 witness monuments, or, if the location is within a municipality, to at least 2 witness monuments. (Witness monuments shall be made of concrete, natural stone, iron or other equally durable material.) Describe witness monuments.

(d) Show a plan view drawing depicting the relevant monuments and reference ties which is sufficient in detail to enable accurate relocation of the corner monument if the corner monument is disturbed. Indicate north.

1. 2 1/2" X 36" aluminum magnetic cap monument stamped to identify the corner.
2. White Spruce 5" S56°W 107.01 feet
3. Basswood 17" N59°W 29.91 feet
4. Basswood 11" N08°W 39.03 feet
5. Sugar Maple 13" N89°W 50.60 feet
6. Sugar Maple 10" S13°E 65.93 feet
7. Steel sign post North 1.4 feet

