


U. S. PUBLIC LAND SURVEY MONUMENT RECORD

INSTRUCTIONS: This record shall show the location of the corner and shall include all of the following nine elements (a through i).

(a) Identify the corner by reference to the U.S. public land survey system.

○ = Corner monument restored.

Quarter corner between Sections 7 and 12, T.34N., R.15E.

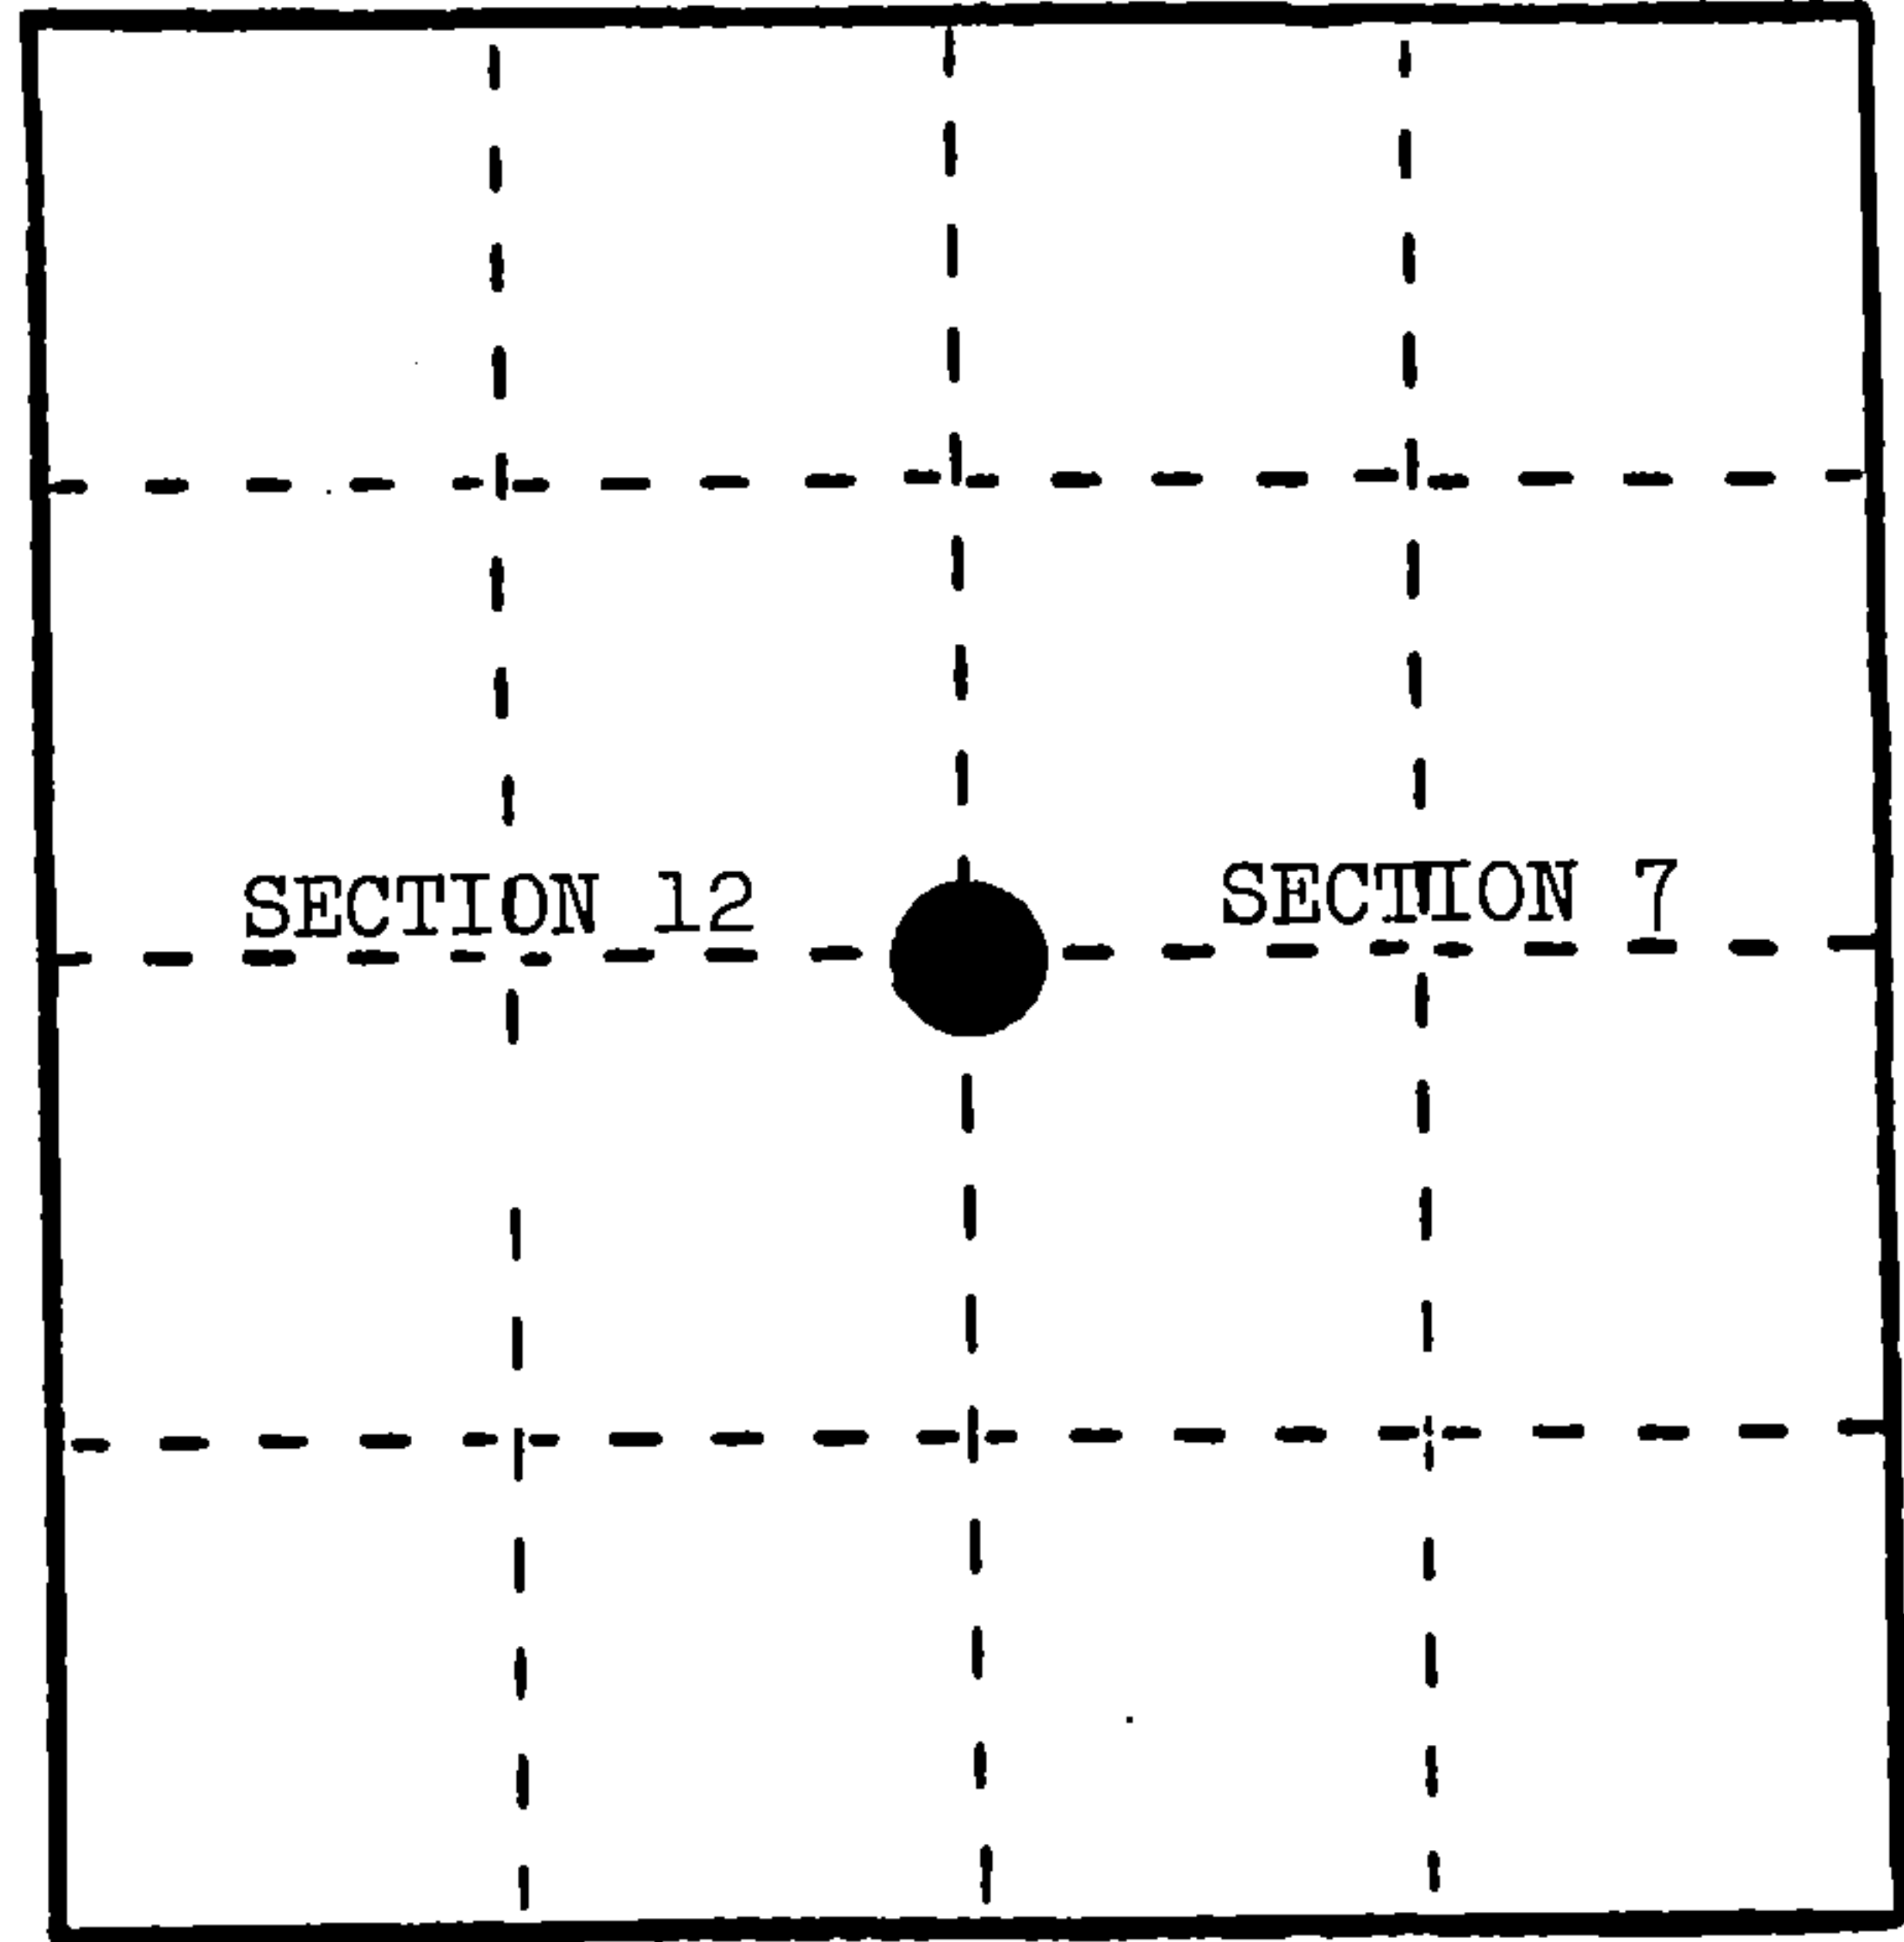

(b) Describe any record evidence, monument evidence, occupational evidence, testimonial evidence or any other material evidence you considered, and whether the monument was found or placed.

In 1839, Tom Sprague set wood post with the following BTs: Hemlock, 9", S.25°W., 15 links; Sugar, 20", N.63°E., 24 links.

November 8, 1922, Nathan Smith subdivided Section 12, T.34N., R.15E. and called original corner.


October 17, 1934, Stabo and Savee found a stake 3" below road surface; also, Hemlock stump, 10", S.50°W., 33'. Metal location poster on 9" fence post east of corner 1/2 chain.

June 25, 1984, Alan Harrison searched area, found no evidence of original corner. Set corner by retracement of N. Smith's 1922 survey of Section 12 from W 1/4 through C 1/4 through CE 1/16 to E 1/4.

(c) In the plan view drawing below, provide reference ties to at least 4 witness monuments, or, if the location is within a municipality, to at least 2 witness monuments. (Witness monuments shall be made of concrete, natural stone, iron or other equally durable material.) Describe witness monuments.

(d) Show a plan view drawing depicting the relevant monuments and reference ties which is sufficient in detail to enable accurate relocation of the corner monument if the corner monument is disturbed. Indicate north.

1. 2" x 30" aluminum monument stamped to identify the corner--4" below surface.
2. Power Pole #3416-7L27, N.89°E., 22.39'
3. Red Pine, 6", S.35°W., 71.92'
4. Red Pine, 8", N.48°W., 51.85'
5. Steel Sign Post, West, 15.51'

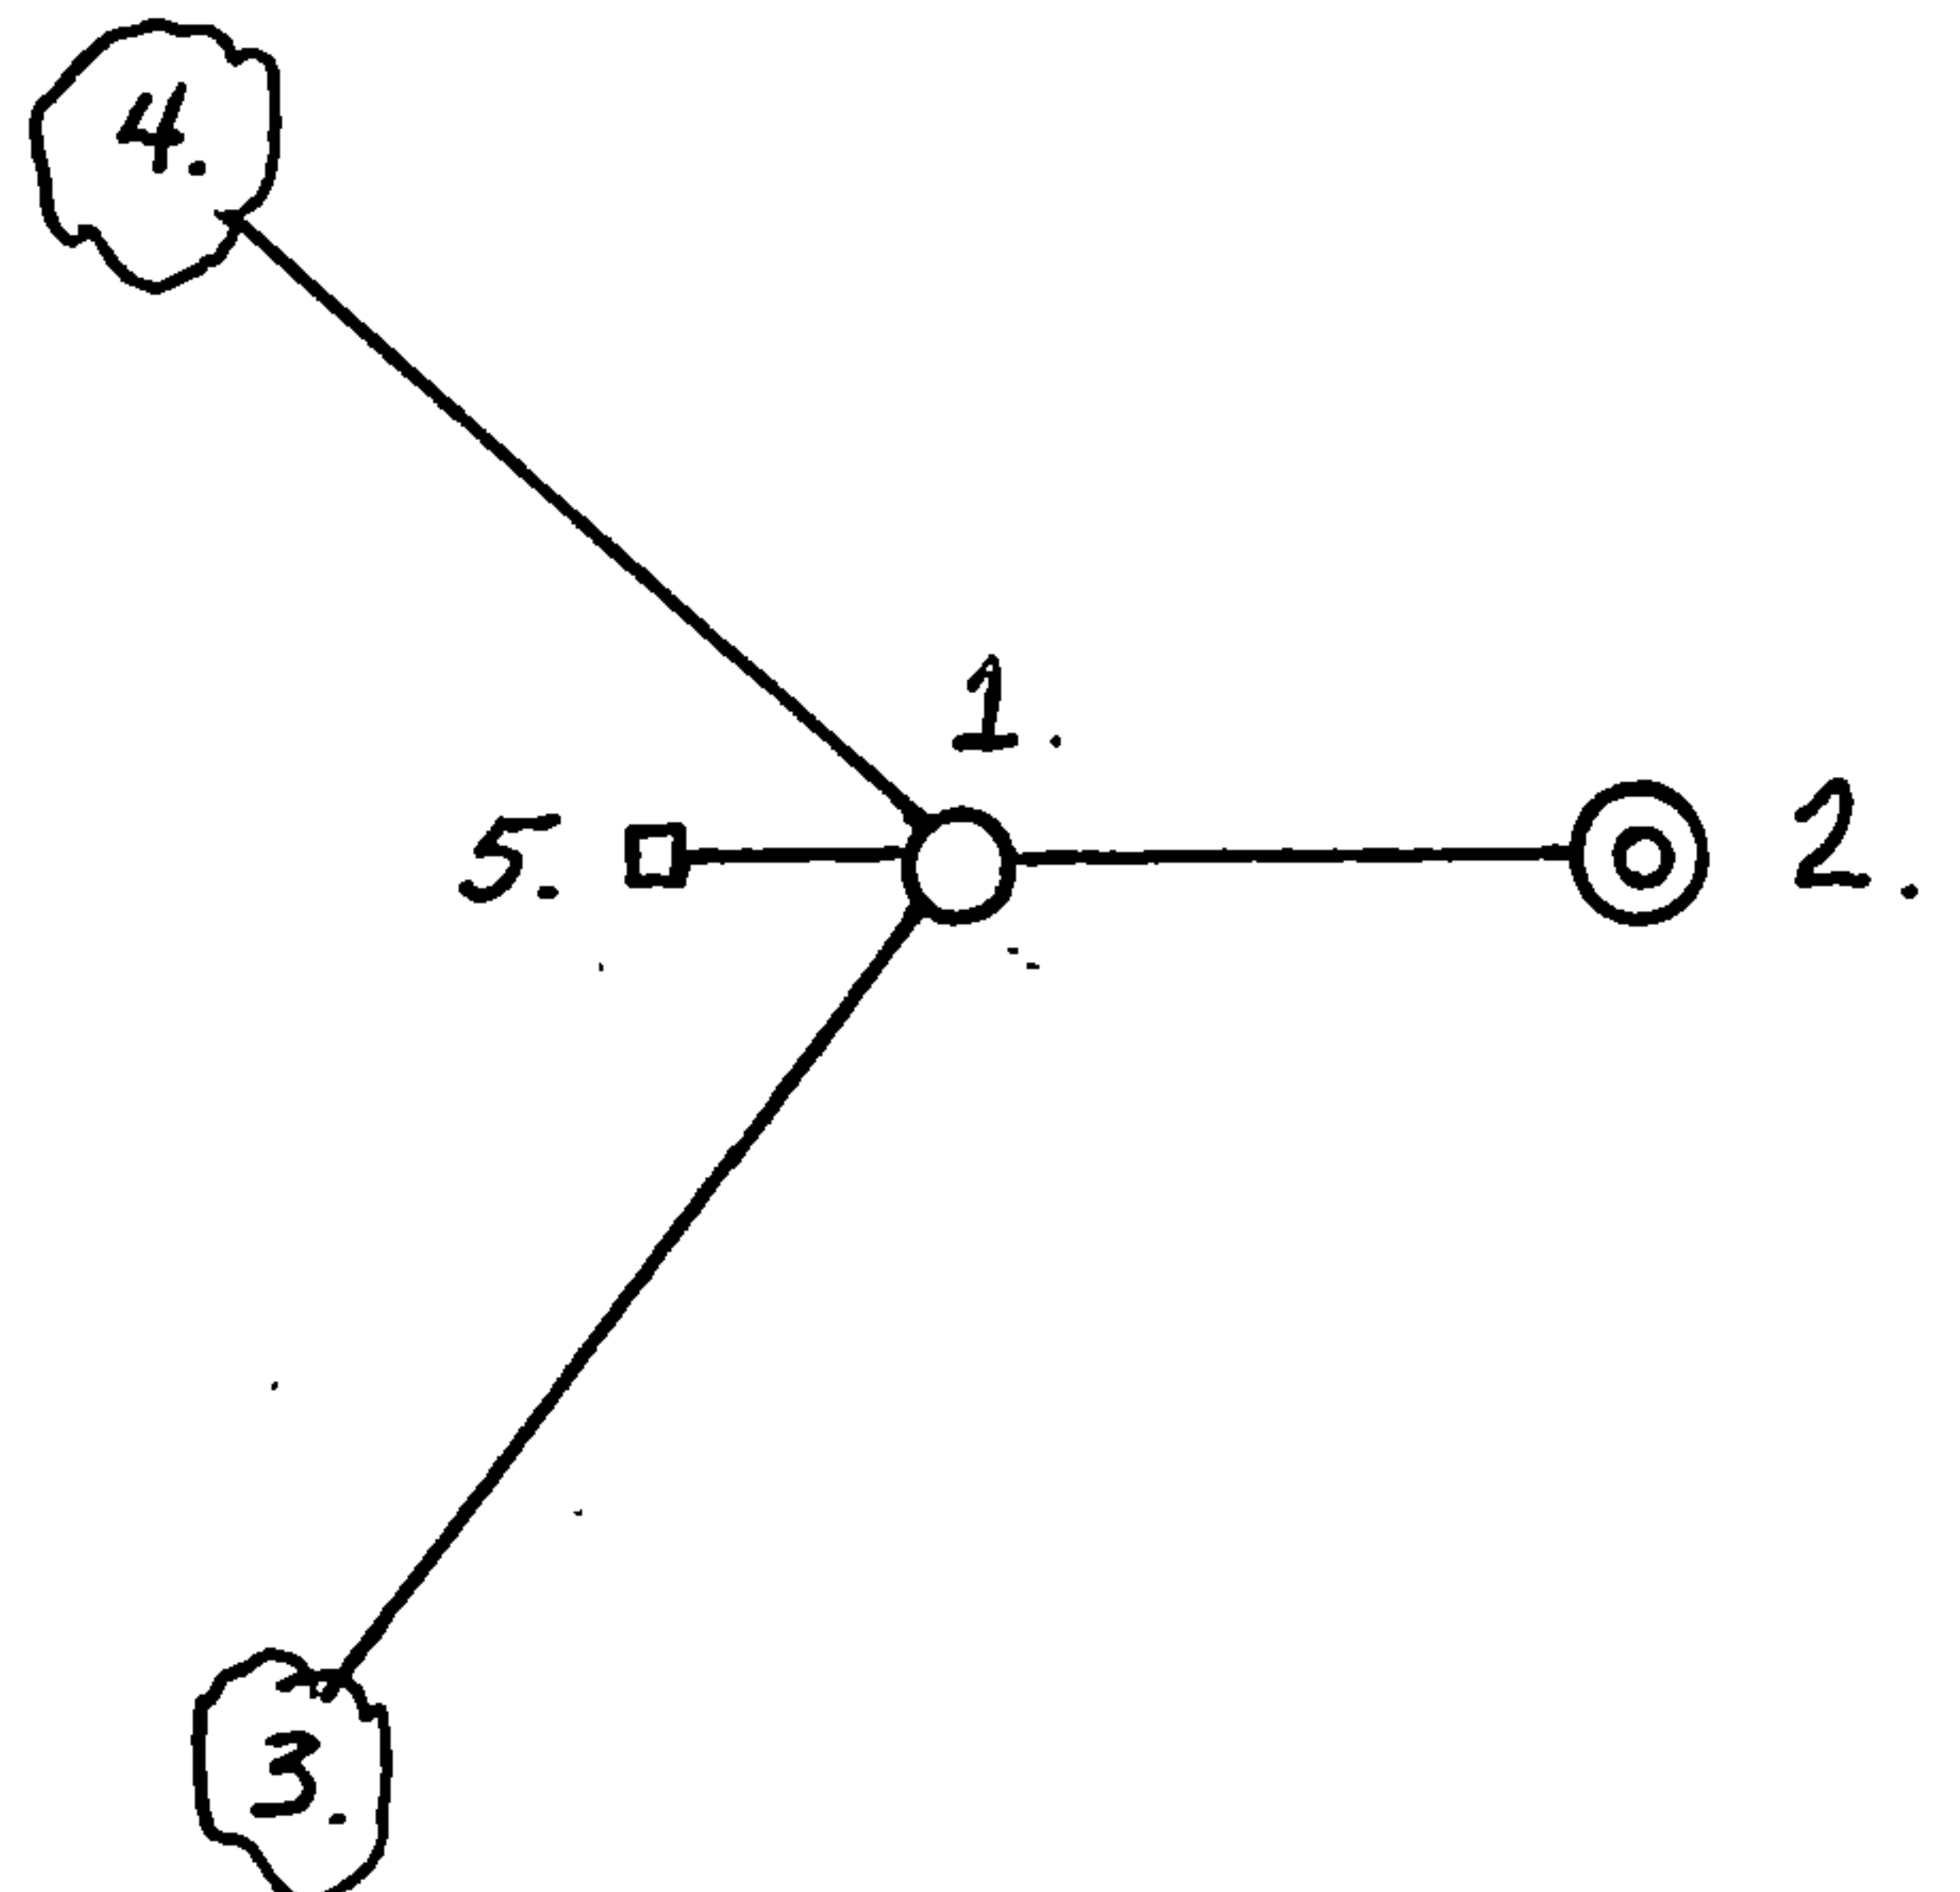

REGISTER'S OFFICE }
 Forest County, Wis. }
 Received for record this 23rd day
 of January A. D., 1985 at
2:00 o'clock P. M. and
 recorded in Vol. CORNER RESTORATIONS
 on page 9
Paul Aschendorf
 REGISTER

