

DR16


U. S. PUBLIC LAND SURVEY MONUMENT RECORD

INSTRUCTIONS: This record shall show the location of the corner and shall include all of the following nine elements (a through i).

(a) Identify the corner by reference to the U.S. public land survey system.

O = Corner monument restored.

Quarter corner to Sections 18 and 19, T.34N., R.15E.

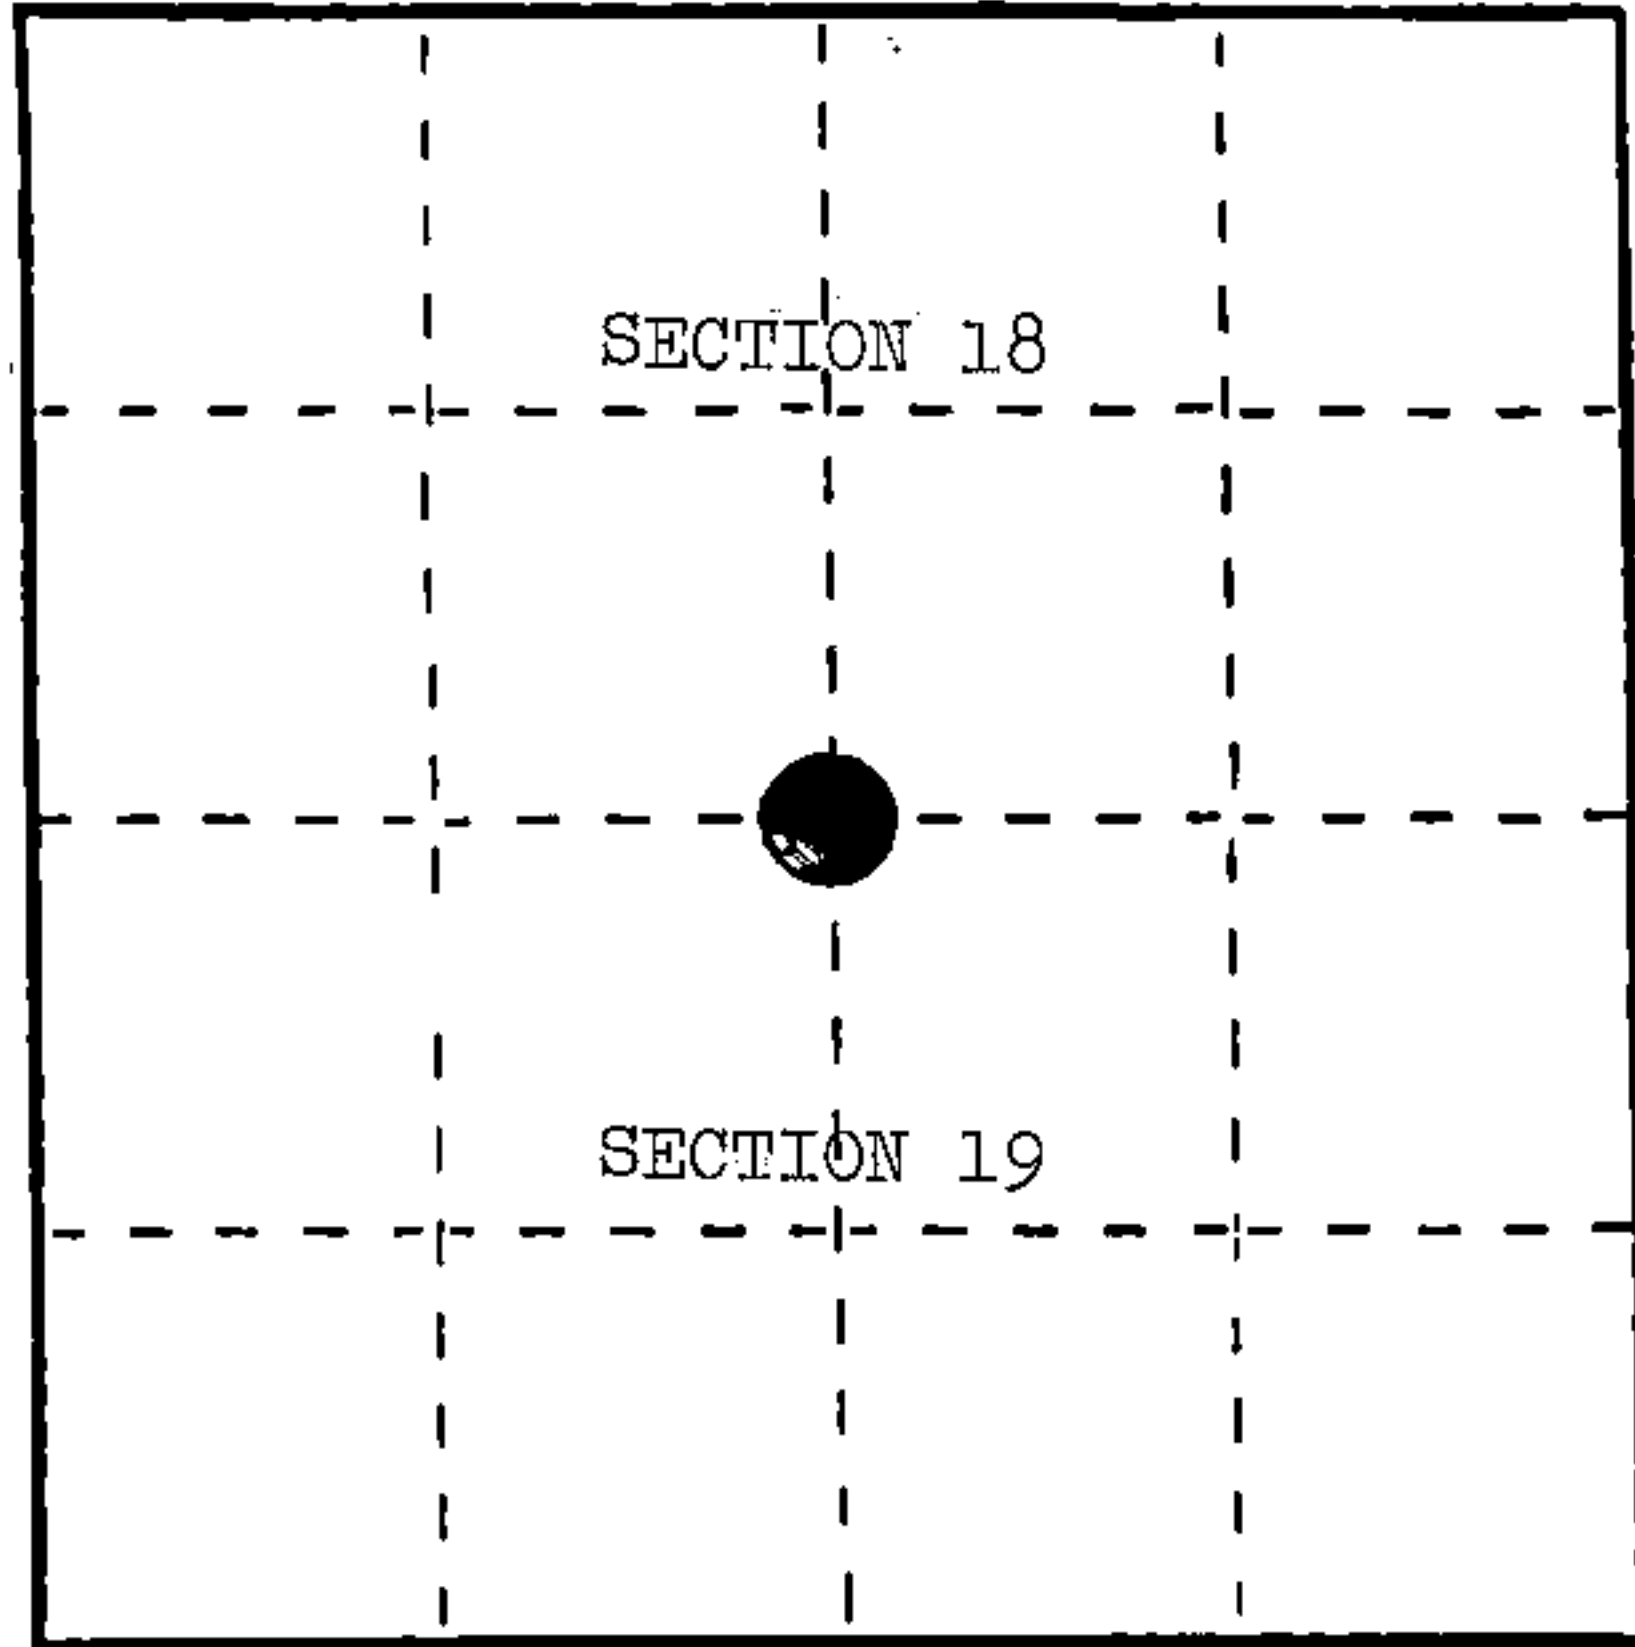

REGISTER'S OFFICE } Forest County, Wis. } Received for record this 14th day of March A.D., 1986 at 10:35 o'clock A.M. and recorded in Vol. CORNER RESTORATIONS page N-3 Paul Aschenbrenner Register of Deeds

(b) Describe any record evidence, monument evidence, occupational evidence, testimonial evidence or any other material evidence you considered, and whether the monument was found or placed.

June, 1859, James McBride placed quarter section post at 42.00 chains with the following BTs: 16" Birch, S.24°W., 34 links; 12" Birch, N.30°W., 15 links.


December 18, 1908, J. J. Melindy located 18" Birch BT stump, N.30°W., 15 links and 19" Birch (standing), marks plain, at S.15°W., 13 1/4 links. (Note error that Melindy found in original SW BT.) Melindy made two new BTs: 18" Elm, S.20°W., 67.2 links; 16" Birch, N.37°E., 93.6 links.

June 6, 1985, Milo Stefan found post hole and stump of original SW bearing tree. Monument was placed in post hole supported by original evidence of the SW Birch BT. J. J. Melindy had both original BTs and made two new BTs. Position is supported by bearing distances between the C 1/4 to CN 1/16 and northerly to this position.

(c) In the plan view drawing below, provide reference ties to at least 4 witness monuments, or, if the location is within a municipality, to at least 2 witness monuments. (Witness monuments shall be made of concrete, natural stone, iron or other equally durable material.) Describe witness monuments.

(d) Show a plan view drawing depicting the relevant monuments and reference ties which is sufficient in detail to enable accurate relocation of the corner monument if the corner monument is disturbed. Indicate north.

- 1. 2" x 60" aluminum monument
2. White Oak, 8", N.13°E., 29.25 feet
3. Twin White Oak, 6", S.45°E., 18.89 feet
4. White Oak, 8", S.58°W., 50.96 feet
5. Steel Sign Post, Northwest, 0.8 feet
6. Corner restored by the 1981 survey bears N.47°56'E., 38.9 feet

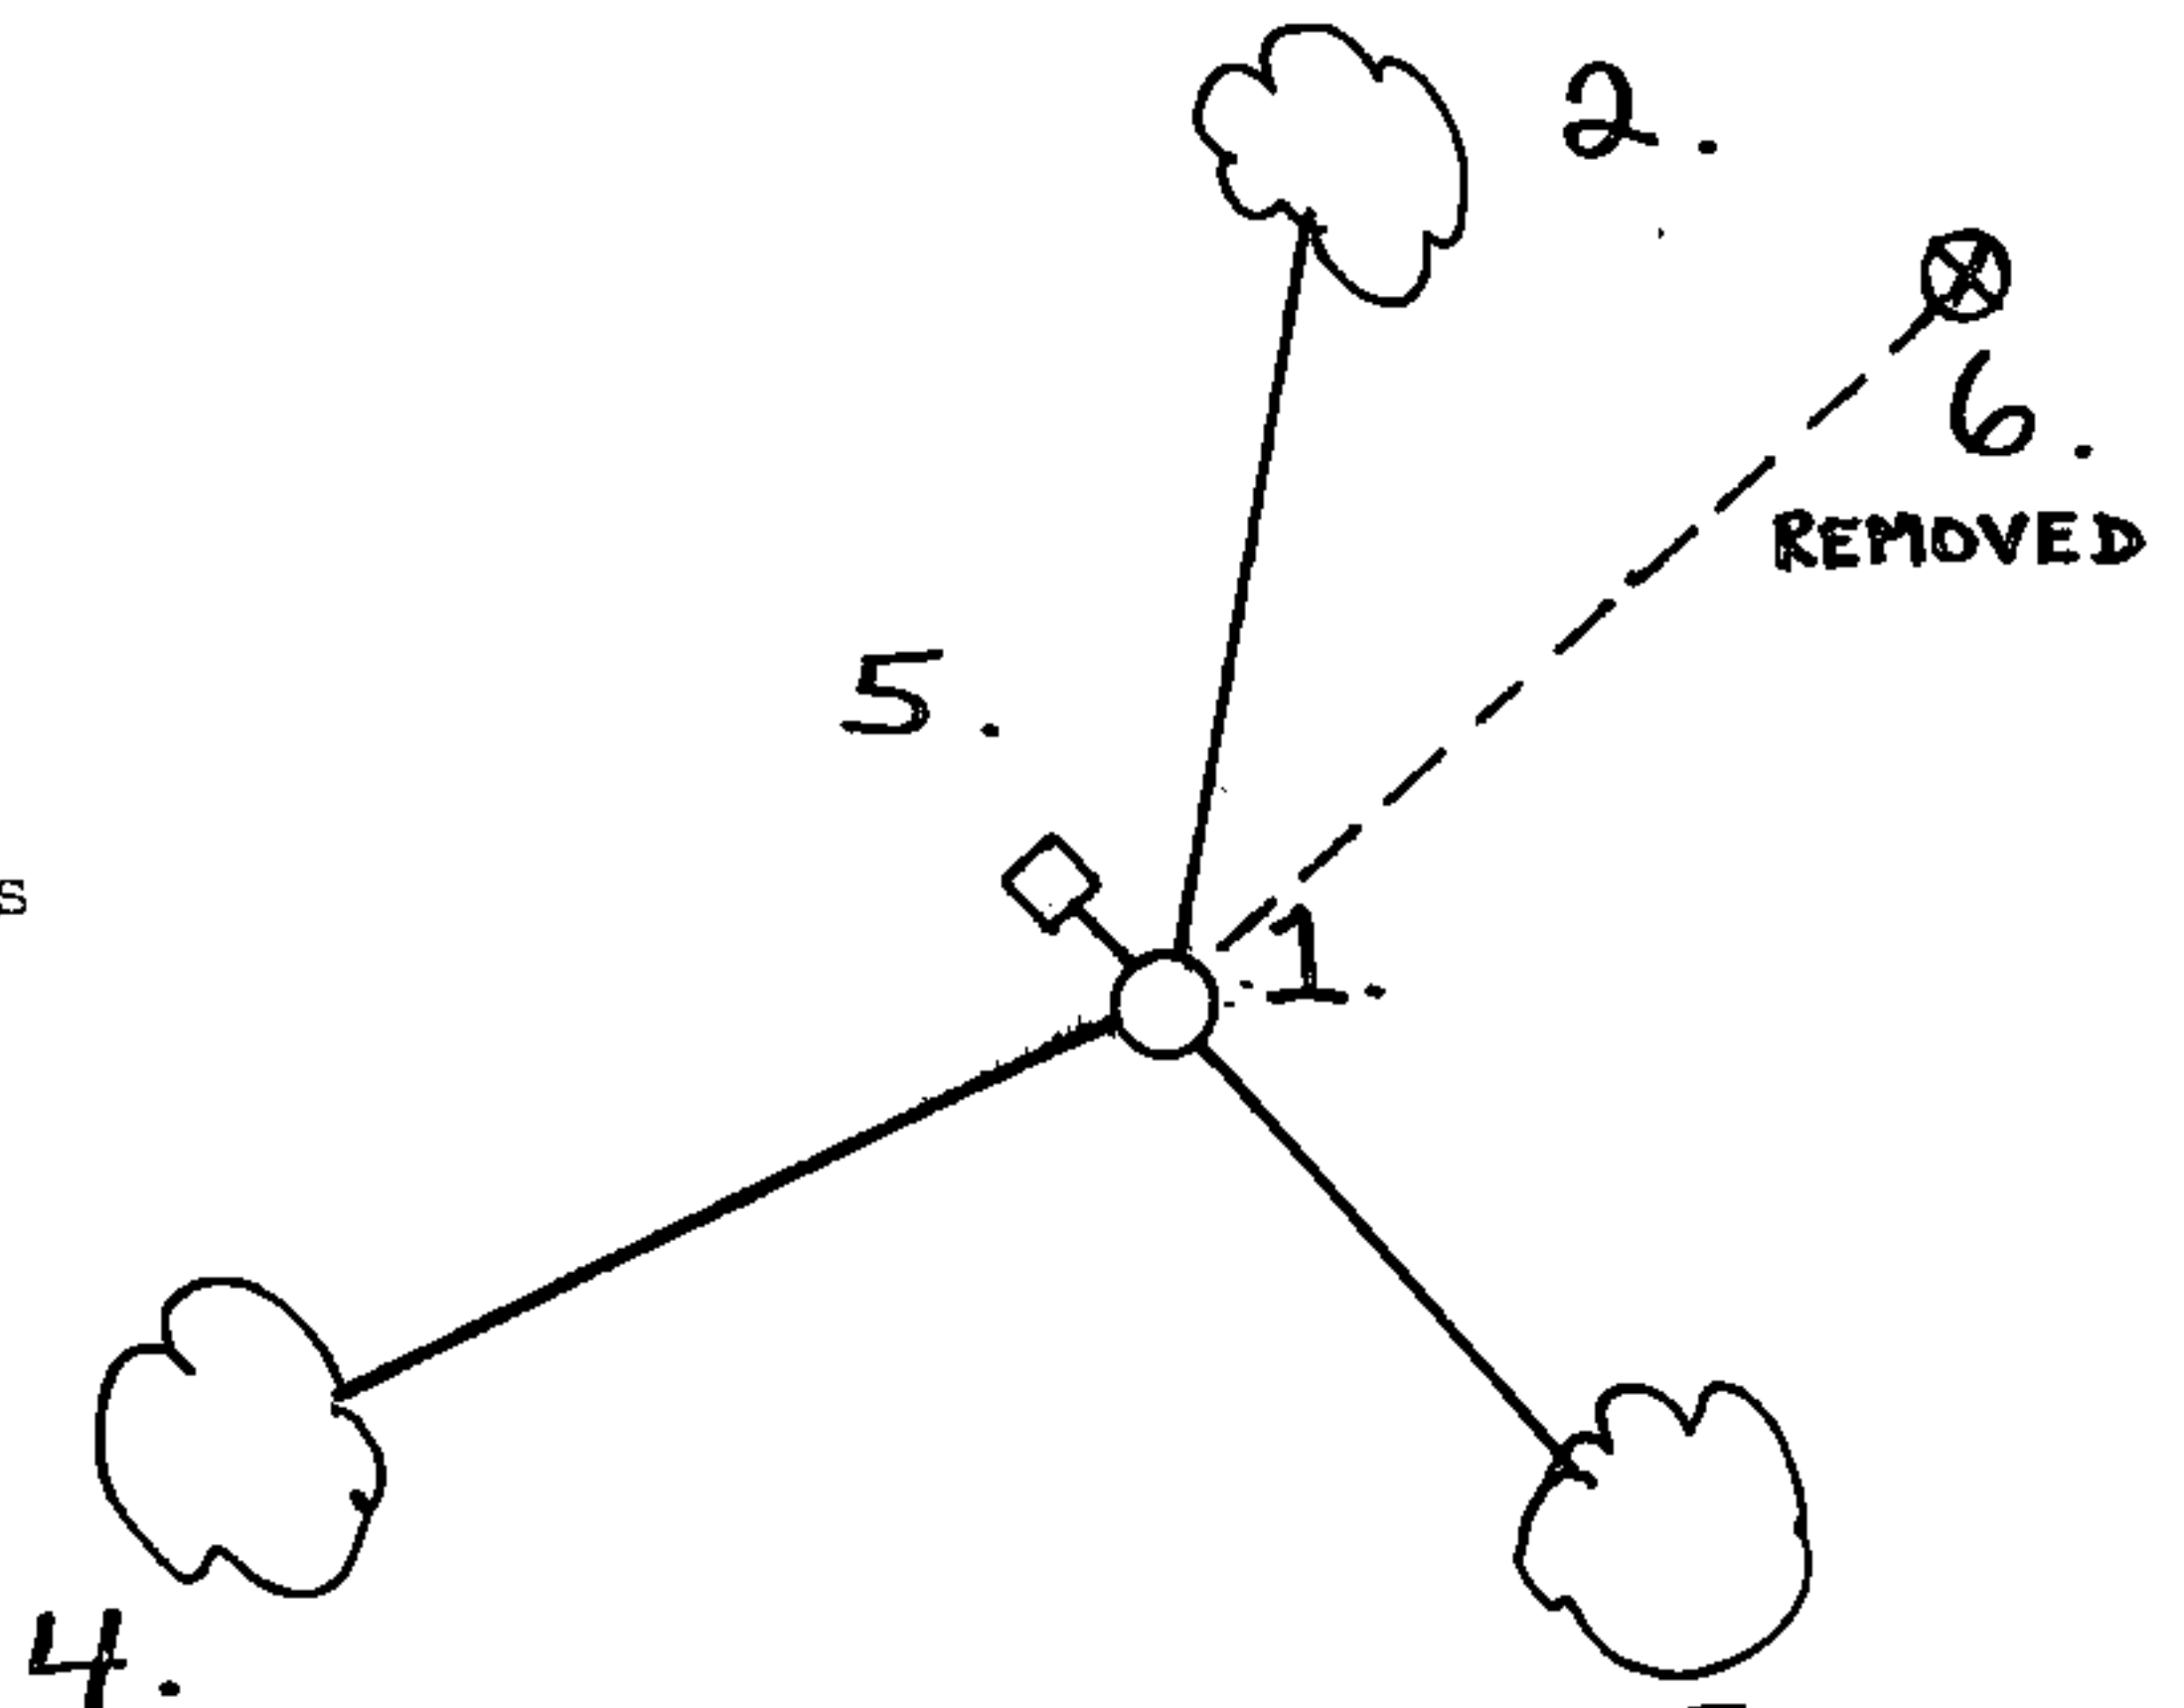

(e) Describe any material discrepancy between the location of the corner as restored or reestablished and the location of that corner as previously restored or reestablished by distance and direction. Show the discrepancy on the plan view drawing under (d), above. Show the distances between the corner as previously restored or reestablished and (1) the corner as restored or reestablished, and (2) to at least 2 of the witness monuments shown on the drawing in (d), above.

The 1981 survey placed this corner by lost methods. With the location of the Melindy notes, additional information allowed the location of the original corner to be restored.

(f) Was the corner restored through acceptance of (1) an obliterated evidence location, or, (2) a found perpetuated location?

(1) an obliterated evidence location.

(g&h) Was the corner reestablished through lost corner proportionate methods? If so, show the method, including the directions and distances to other public land survey corners used as evidence or used for proportioning in determining the corner location?

(1) I, Milo E. Stefan  
(Type or print name) certify that the corner location shown on this record was determined by me or under my direction and control and that this U.S. Public Land Survey Monument Record is correct and complete to the best of my knowledge and belief.

Milo E. Stefan  
Signature

2/19/86  
Date

