

CERTIFIED LAND CORNER RESTORATION

State of Wisconsin }  
County of Forest } ss.

I, Jean F. Resvick, do hereby certify that on the 5 day of June, 1973, I found evidence of the southeast section corner of section 32 Township 34 north, Range 15 east, Fourth Principal Meridian, as described hereon; and that from this evidence I established a new monument and accessories as described hereon to perpetuate the original location of this corner:

Description of original monument and accessories and subsequent restorations:


Survey in 1857 by Artemas Curtis  
80.00 chains west between sections 4 and 33  
Set post for corner of sections 4,5,32 and 33  
Hemlock 14, N53W, 41 links  
Yellow Birch 14, N42E, 44 links  
Cedar 12, S47W, 41 links

Description of corner evidence found:


Wood post with steel post along side  
Cedar stump, 5 feet high, 14 inch diameter, with scribing bears S44W, 26 feet from post  
Fallen Yellow Birch, 20 inch diameter, with face blaze and overgrowth bears N43E, 29 feet  
Hemlock stump roots bear N53W, 27 feet

Description of monument and accessories I established to perpetuate the location of this corner:

Replaced post with a 2 inch inside diameter galvanized iron pipe 5 feet long filled with concrete with brass cap stamped

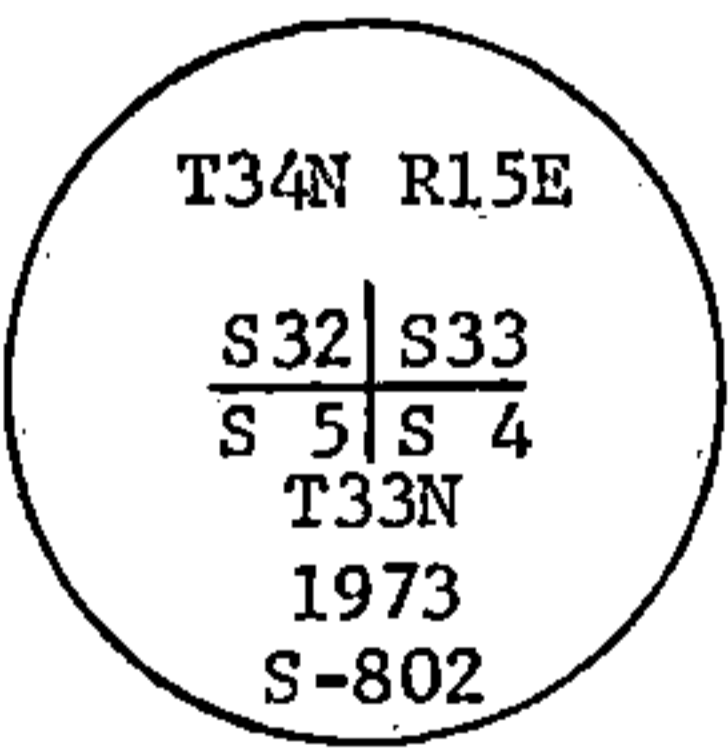

From which the following blazed and scribed new bearing trees bear:  
Hemlock 7, N77E, 32.35 feet  
Hemlock 13, S47E, 31.86 feet  
Red Maple 8, S53W, 14.07 feet  
Red Maple 17, N50W, 37.18 feet  
Set iron sign post 1.0 foot NE of monument.

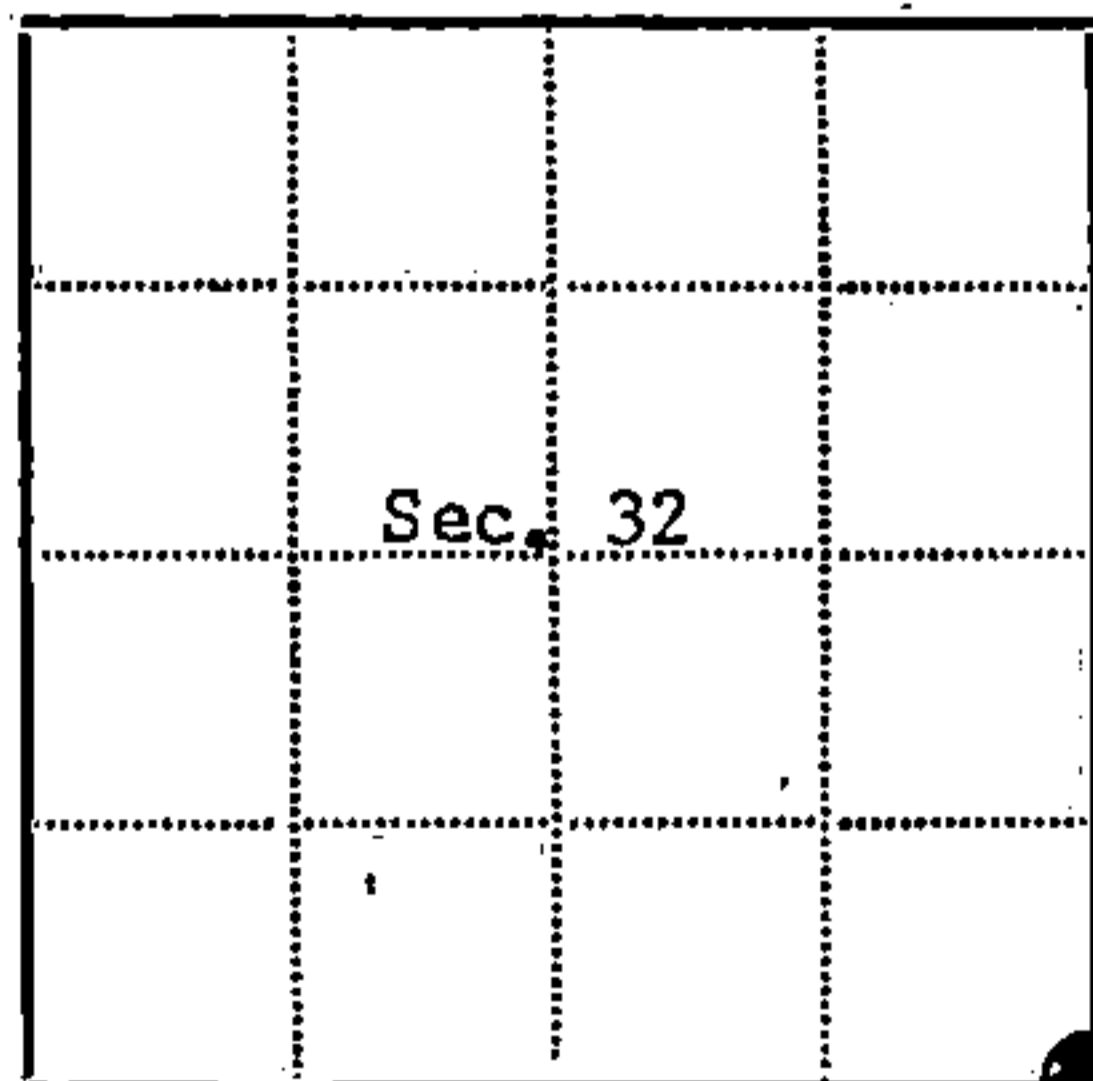

⊙ - Corner monument restored  
□ -

Resident witnesses.....

Dated at Rhinelander, Wisconsin, this 30th day of June, 1973.

Signature: *Jean F. Resvick*  
Jean F. Resvick Title: Land Surveyor  
(County Surveyor, Registered Land Surveyor, or other duly authorized official)

Surveyors Registration No. S-802 DOCUMENT NUMBER 104433

Office of Register of Deeds County of Forest

I hereby certify that the within instrument was filed in this office for record on the 13th day of November, 1973, and was filed in Book No. Corner Restorations Page No. 7-9 of County Records.

Signature: *Eugene [unclear]* Title: Register of Deeds

Township 34 north, Range 15 east, Section 32, Index No. Z-9, Page No. 2

43415320000