


U. S. PUBLIC LAND SURVEY MONUMENT RECORD

INSTRUCTIONS: This record shall show the location of the corner and shall include all of the following nine elements (a through i).

(a) Identify the corner by reference to the U.S. public land survey system.

○ = Corner monument restored.

Quarter corner to Sections 8 and 9, T.34N., R.16E.

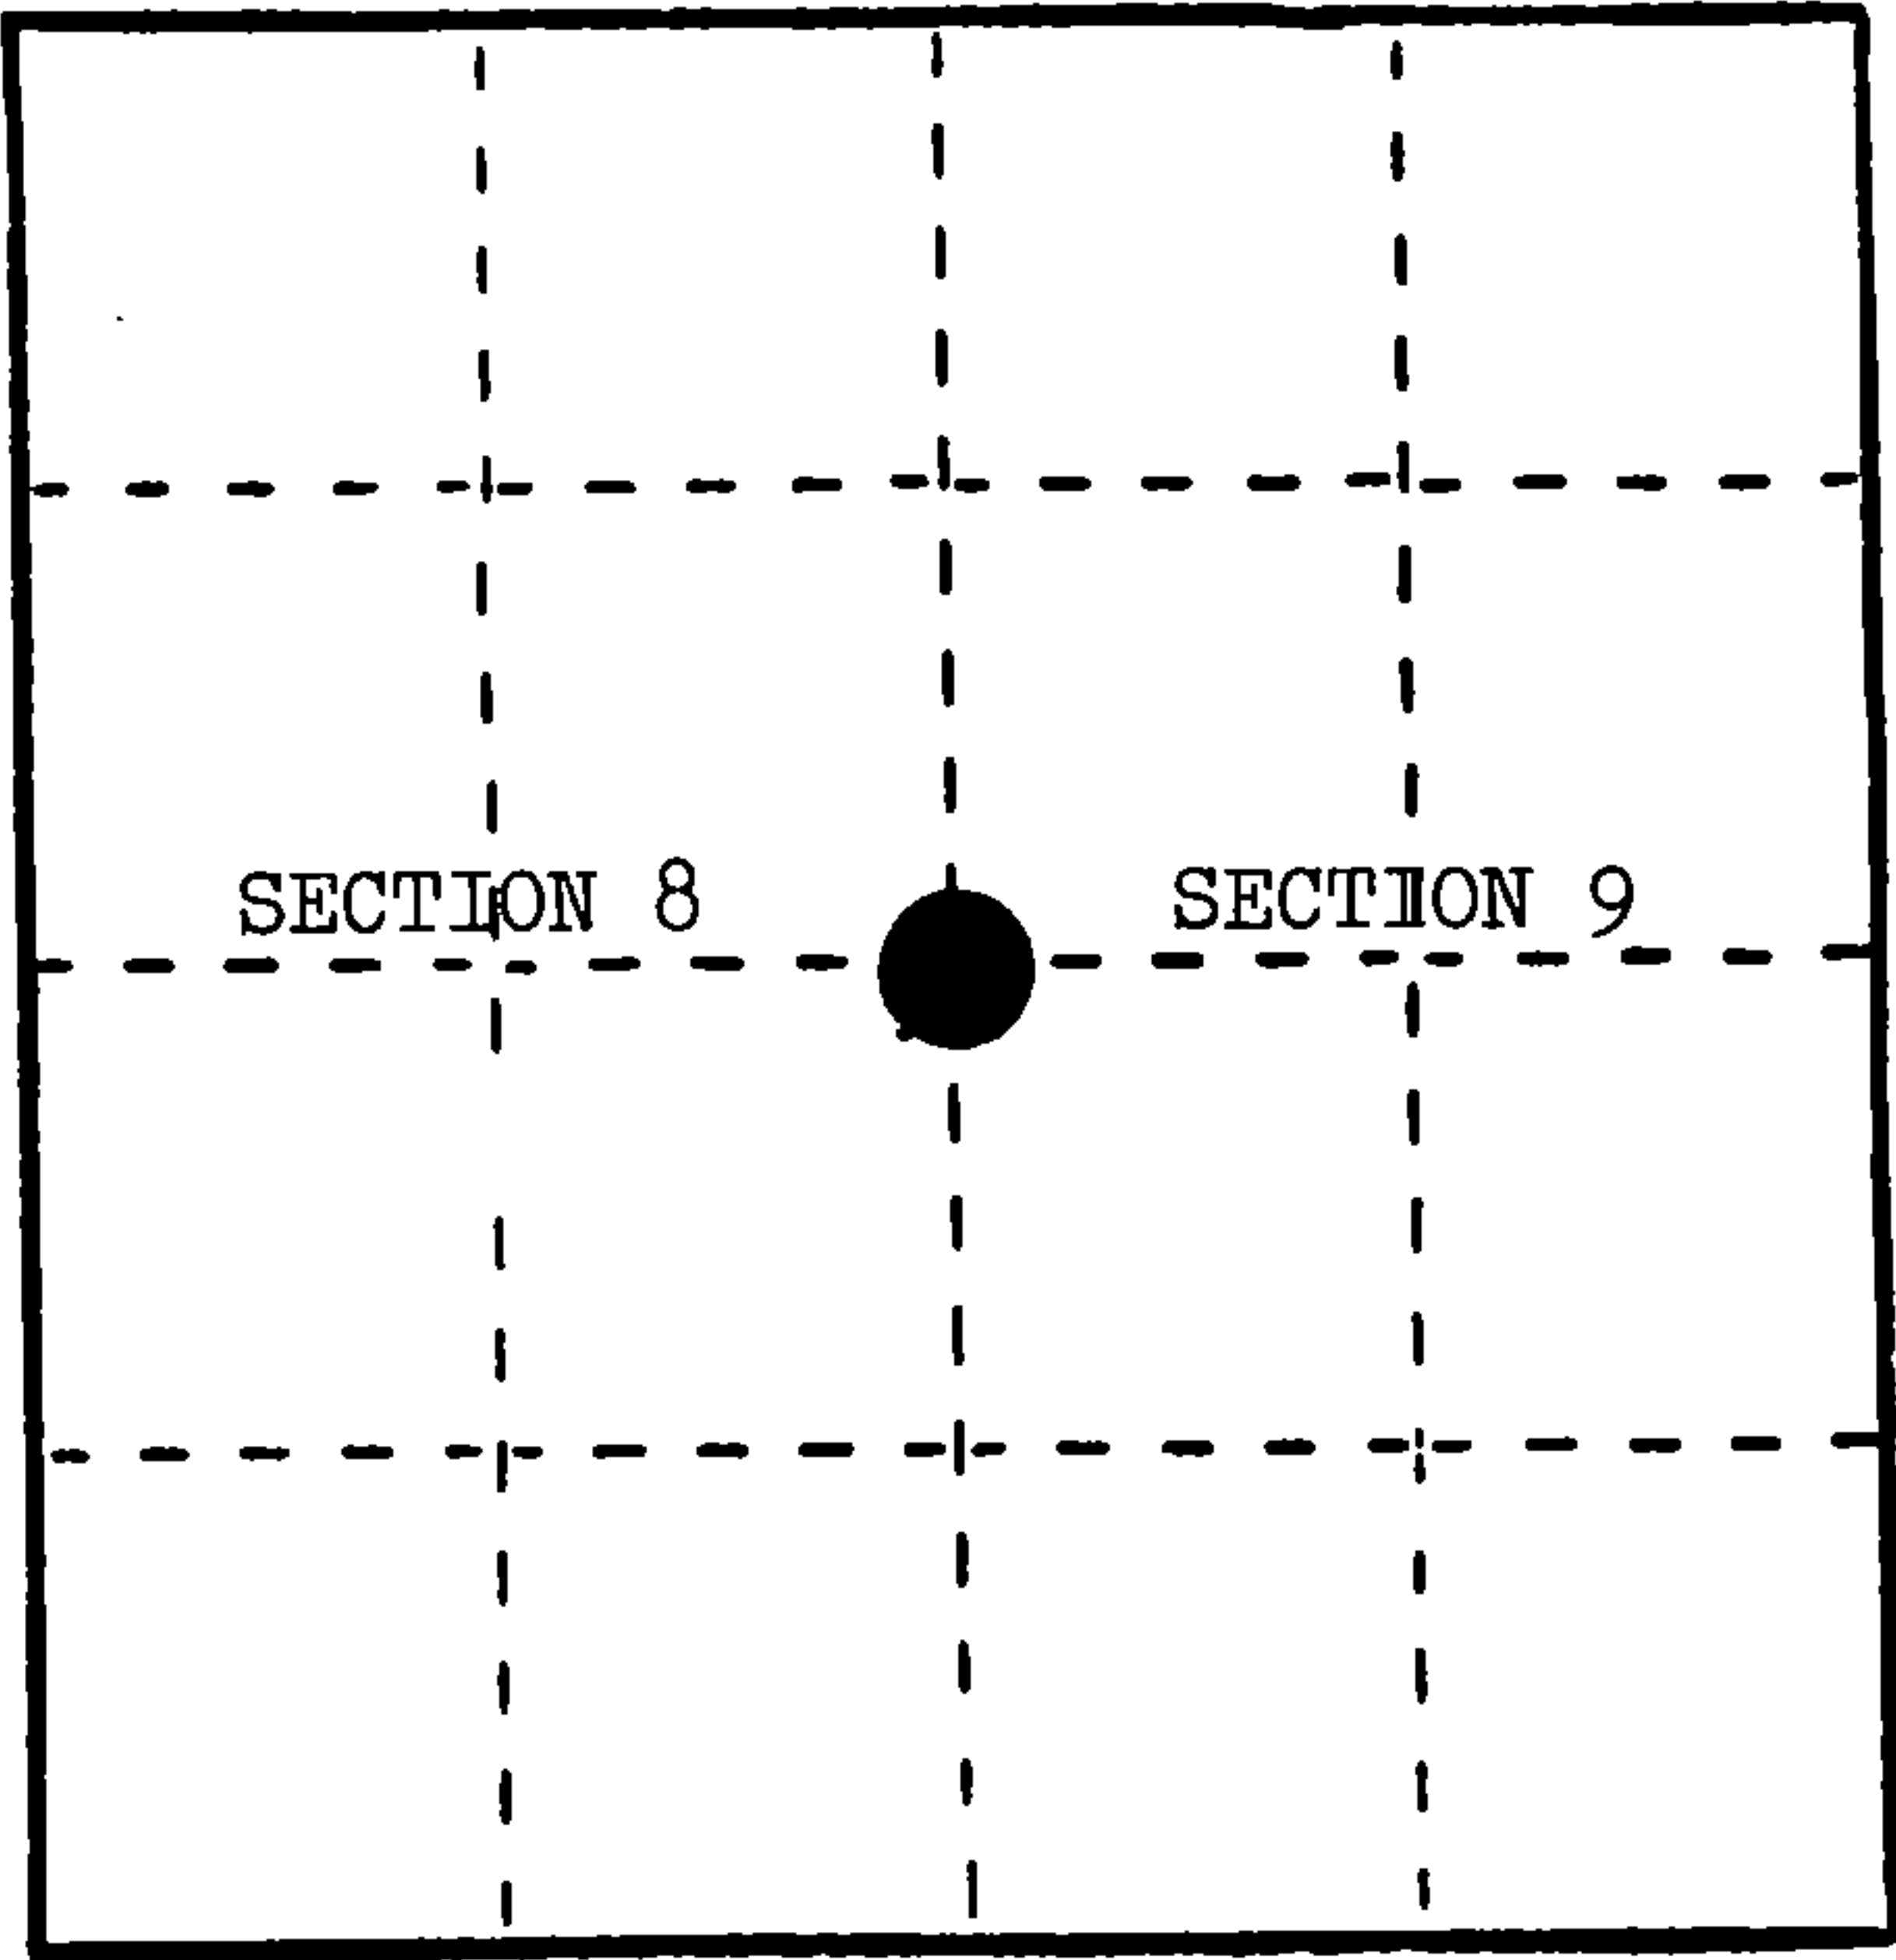

(b) Describe any record evidence, monument evidence, occupational evidence, testimonial evidence or any other material evidence you considered, and whether the monument was found or placed.

In 1858, James McBride set wood post with the following BTs: Hemlock, 12", S.31°W., 10 links; Hemlock, 10", N.19°E., 11 links.

January 9, 1935, L. Sobezak found iron pipe 12" high, location poster on post from which corner bears east, 1.0'


1966, Kolbe found iron pipe lying on ground.

May 9, 1984, Alan Harrison found plantation post with iron pipe lying on ground. Scraped area and found metal location tag 3' west of post. Found Cedar (axe marked) wood just south of post. Area has been furrowed. Plantation post is best evidence, with support of tag and Cedar remains.

(c) In the plan view drawing below, provide reference ties to at least 4 witness monuments, or, if the location is within a municipality, to at least 2 witness monuments. (Witness monuments shall be made of concrete, natural stone, iron or other equally durable material.) Describe witness monuments.

(d) Show a plan view drawing depicting the relevant monuments and reference ties which is sufficient in detail to enable accurate relocation of the corner monument if the corner monument is disturbed. Indicate north.

1. 2" x 36" aluminum monument stamped to identify the corner.
2. White Spruce, 4", N.45°E., 12.88'
3. Rock Elm, 5", S.58°E., 20.21'
4. White Spruce, 4", S.43°W., 12.34'
5. Steel Sign Post, Northwest, 1.3'

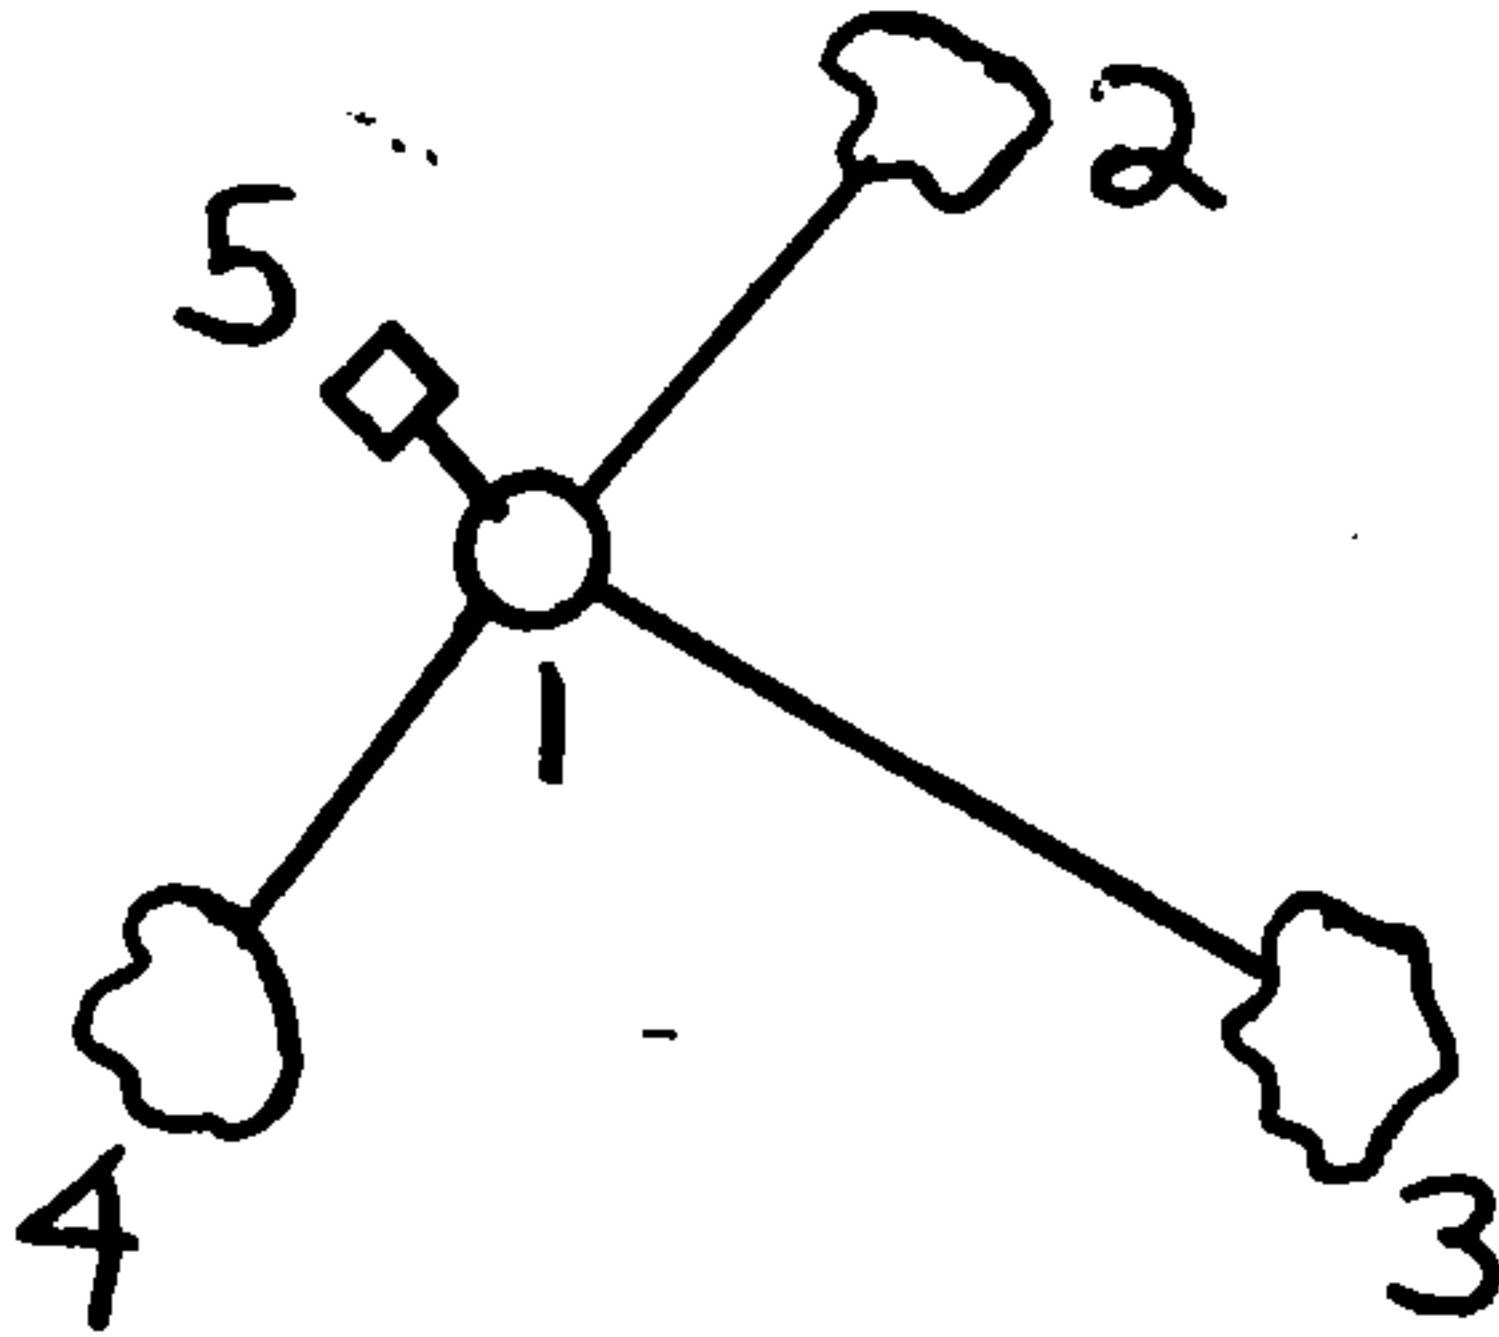

REGISTER'S OFFICE }  
Forest County, Wis. }  
Received for record this 23rd day  
of January, 1985, at  
2:00 o'clock, P.M. and  
recorded in Vol. CORNER RESTORATIONS  
on page G-9  
Paul Achenbrenner  
REGISTER

- (e) Describe any material discrepancy between the location of the corner as restored or reestablished and the location of that corner as previously restored or reestablished by distance and direction. Show the discrepancy on the plan view drawing under (d), above. Show the distances between the corner as previously restored or reestablished and (1) the corner as restored or reestablished, and (2) to at least 2 of the witness monuments shown on the drawing in (d), above.

None.

- (f) Was the corner restored through acceptance of (1) an obliterated evidence location, or, (2) a found perpetuated location?

(2) a found perpetuated location.

- (g&h) Was the corner reestablished through lost corner proportionate methods? If so, show the method, including the directions and distances to other public land survey corners used as evidence or used for proportioning in determining the corner location?

No.

- (1) I, Alan D. Harrison  
(type or print name) certify that the corner location shown on this record was determined by me or under my direction and control and that this U.S. Public Land Survey Monument Record is correct and complete to the best of my knowledge and belief.

Alan D. Harrison  
Signature

11/27/84  
Date

