


U. S. PUBLIC LAND SURVEY MONUMENT RECORD

INSTRUCTIONS:

This record shall show the location of the corner and shall include all of the following nine elements (a through i).

- (a) Identify the corner by reference to the U.S. public land survey system.
 O = Corner monument restored.

SOUTH MEANDER CORNER TO SECTIONS 17 AND 18,
 TWP. 34 N., R.16E.

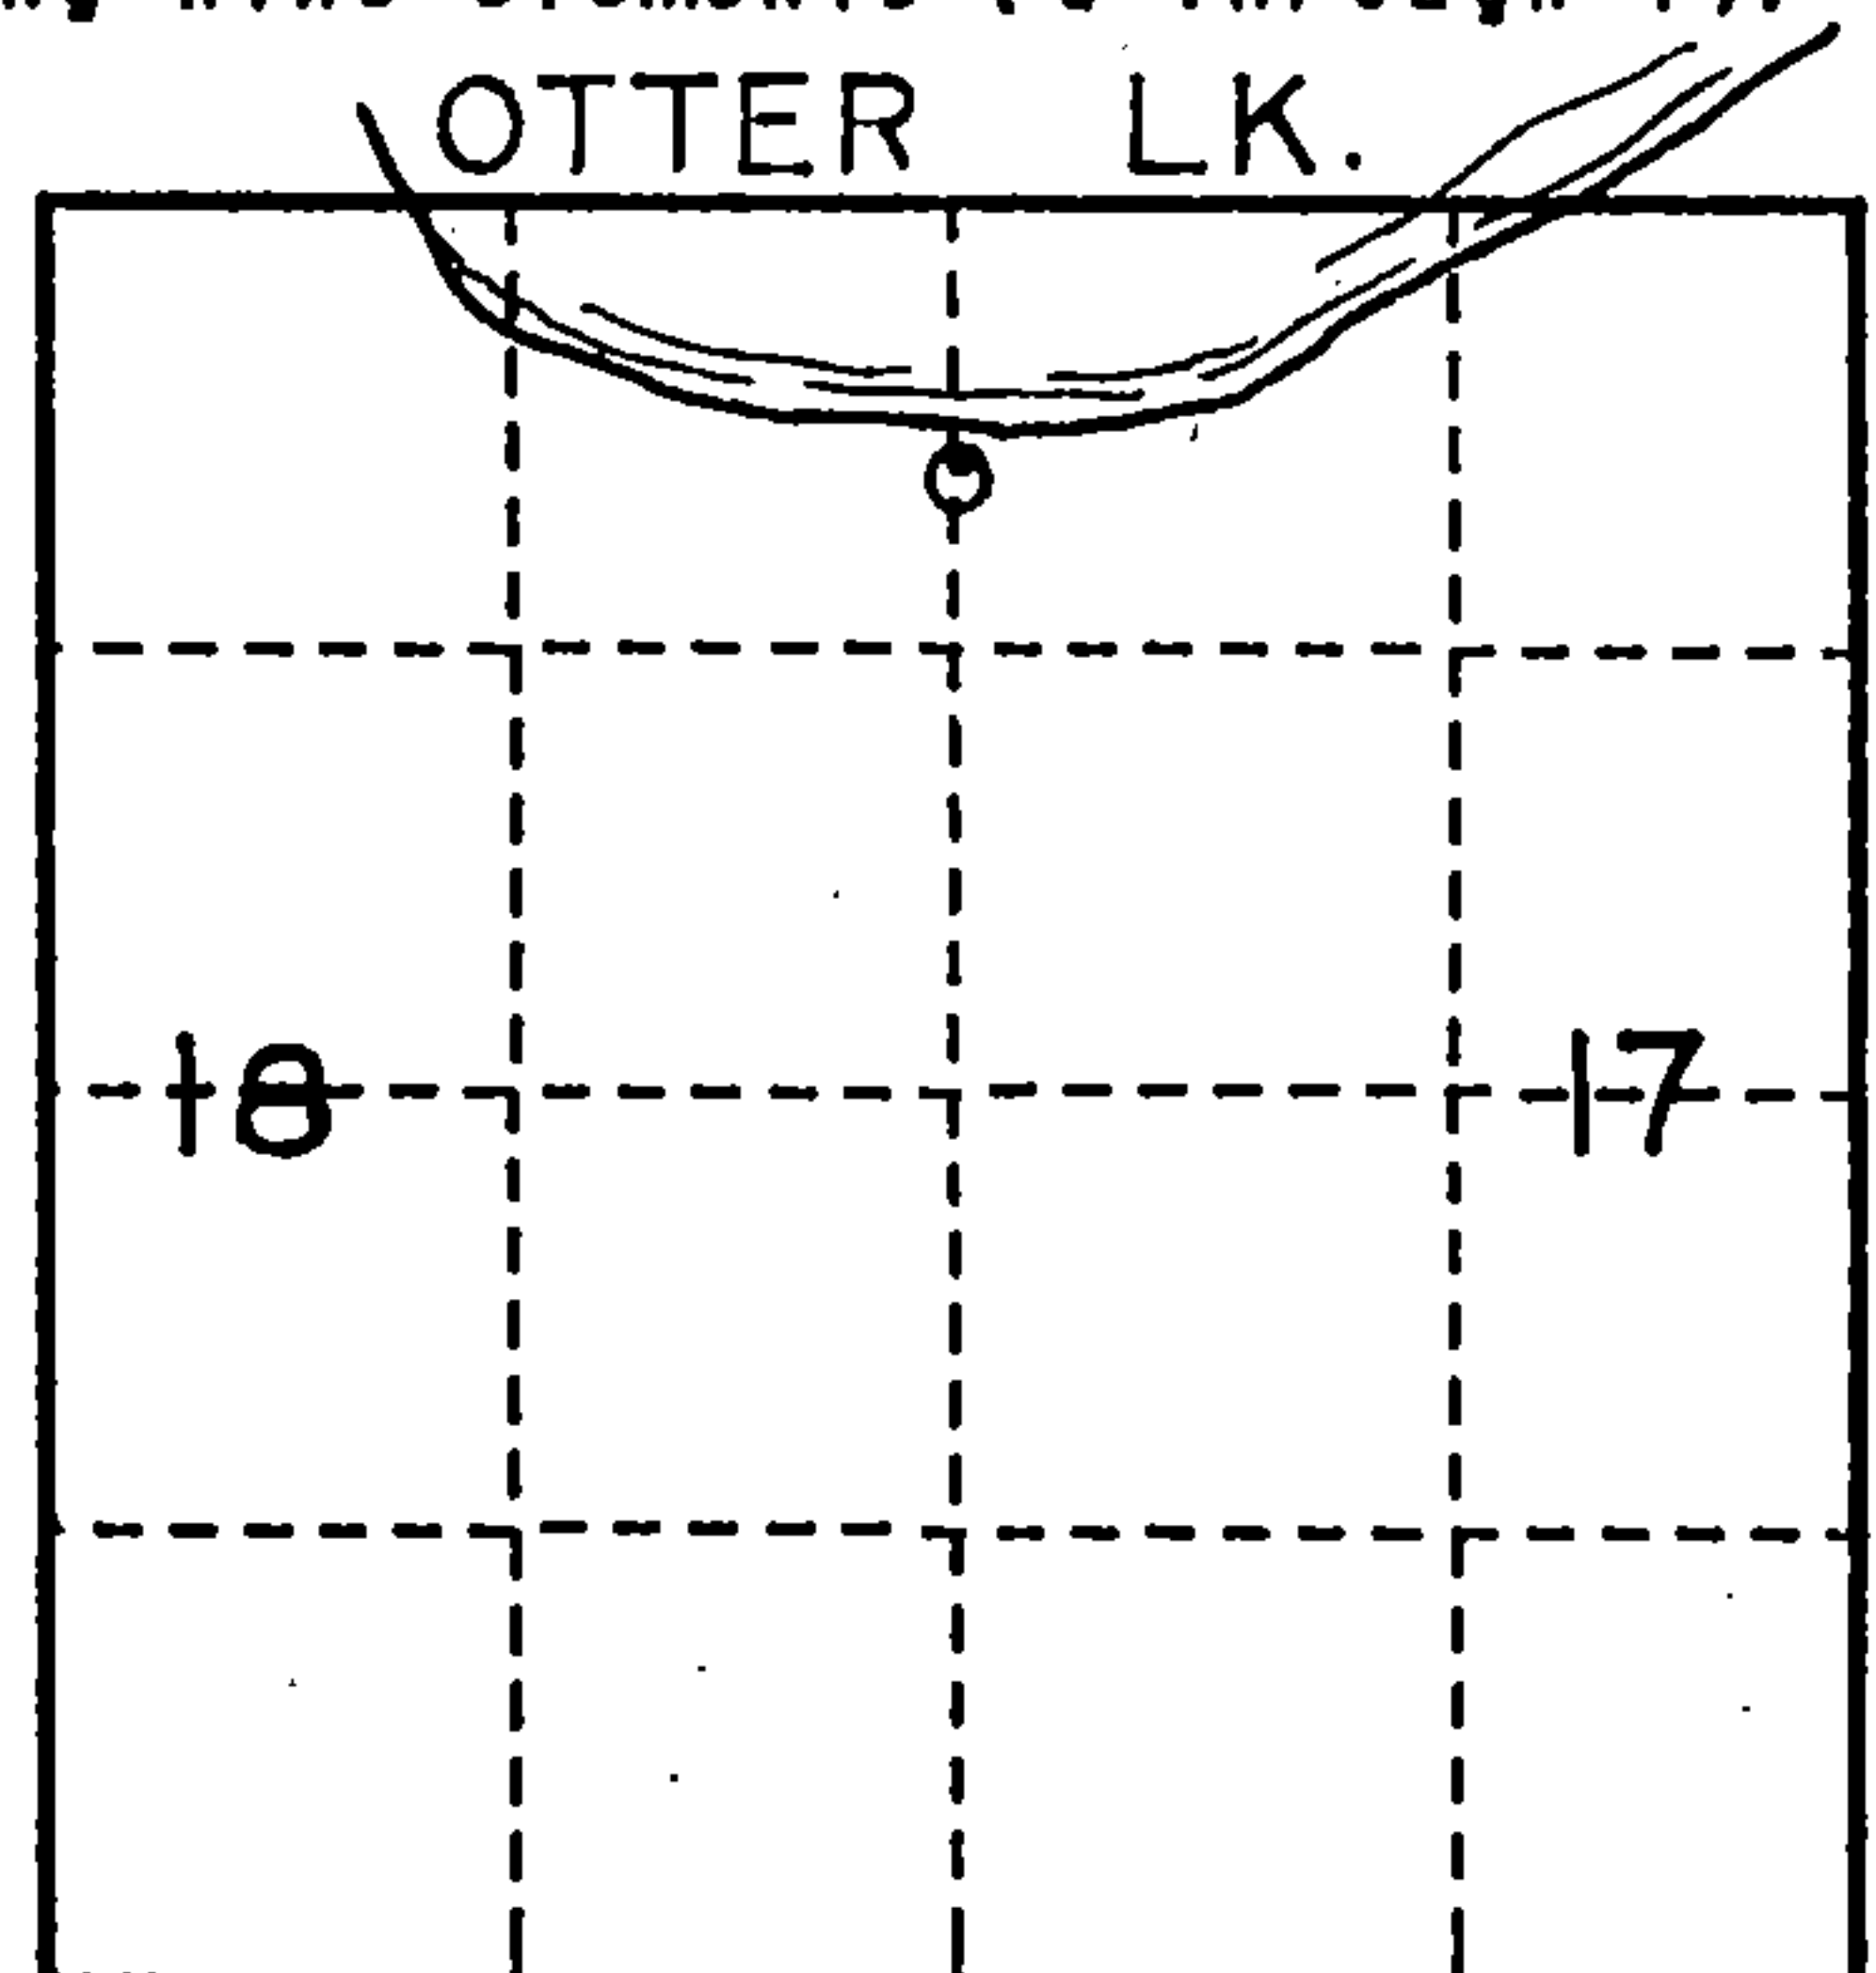

- (b) Describe any record evidence, monument evidence, occupational evidence, testimonial evidence or any other material evidence you considered, and whether the monument was found or placed.


1858 - ORIGINAL SURVEY BY McBRIDE, SET MEANDER POST, B.Ts - TAMARACK 6" S.9°W. 63 LKS., TAMARACK 6" S.22°E. 63 LKS.
 1983 - SMITH R.L.S., SAID IRON PIPE WAS AT M.C., ORIGINAL TAMARACK STILL THERE, HE USED THIS FOR SUBDN. OF SEC. 17.
 1983 - STEFAN R.L.S. NO. S-1558 AND HARRISON R.L.S NO. S-1651 FOUND IRON PIPE BUT NO STUMP REMAINS, TIED PIPE TO SURVEY
 1983 - HARRISON R.L.S. NO. S-1651 SET 2' DIA. AT M.C. , B.Ts - CEDAR 6" S.43°E. 48.38FT., CEDAR 6" S.21°W. 31.40FT., CEDAR 10" N.64°W. 39.65FT.
 WITNESS - STEEL SIGN POST NE 1.28FT.
 1993 - DOBBRATZ R.L.S. NO. S-973, FOUND MONUMENT, STEEL SIGN POST AND B.Ts EXCEPT B.T. CEDAR 10" N.64°W. 39.65FT. IS DOWN.

- (c) In the plan view drawing below, provide reference ties to at least 4 witness monuments, or, if the location is within a municipality, to at least 2 witness monuments. (witness monuments shall be made of concrete, natural stone, iron or other equally durable material.)

- (d) Show a plan view drawing depicting the relevant monuments and reference ties which is sufficient in detail to enable accurate relocation of the corner monument if the corner monument is disturbed. Indicate north.

WITNESS

1. STEEL SIGN POST NE 1.28FT. (EXISTING)
2. B.T. CEDAR 8" S.43°E. 48.55FT. (EXISTING)
3. B.T. CEDAR 8" S.21°W. 31.35FT. (EXISTING)
4. B.T. CEDAR 7" S.80°W. 31.70FT. (NEW)
5. 2" DIA. ALUMINUM MONUMENT AT M.C. CORNER (EXISTING)


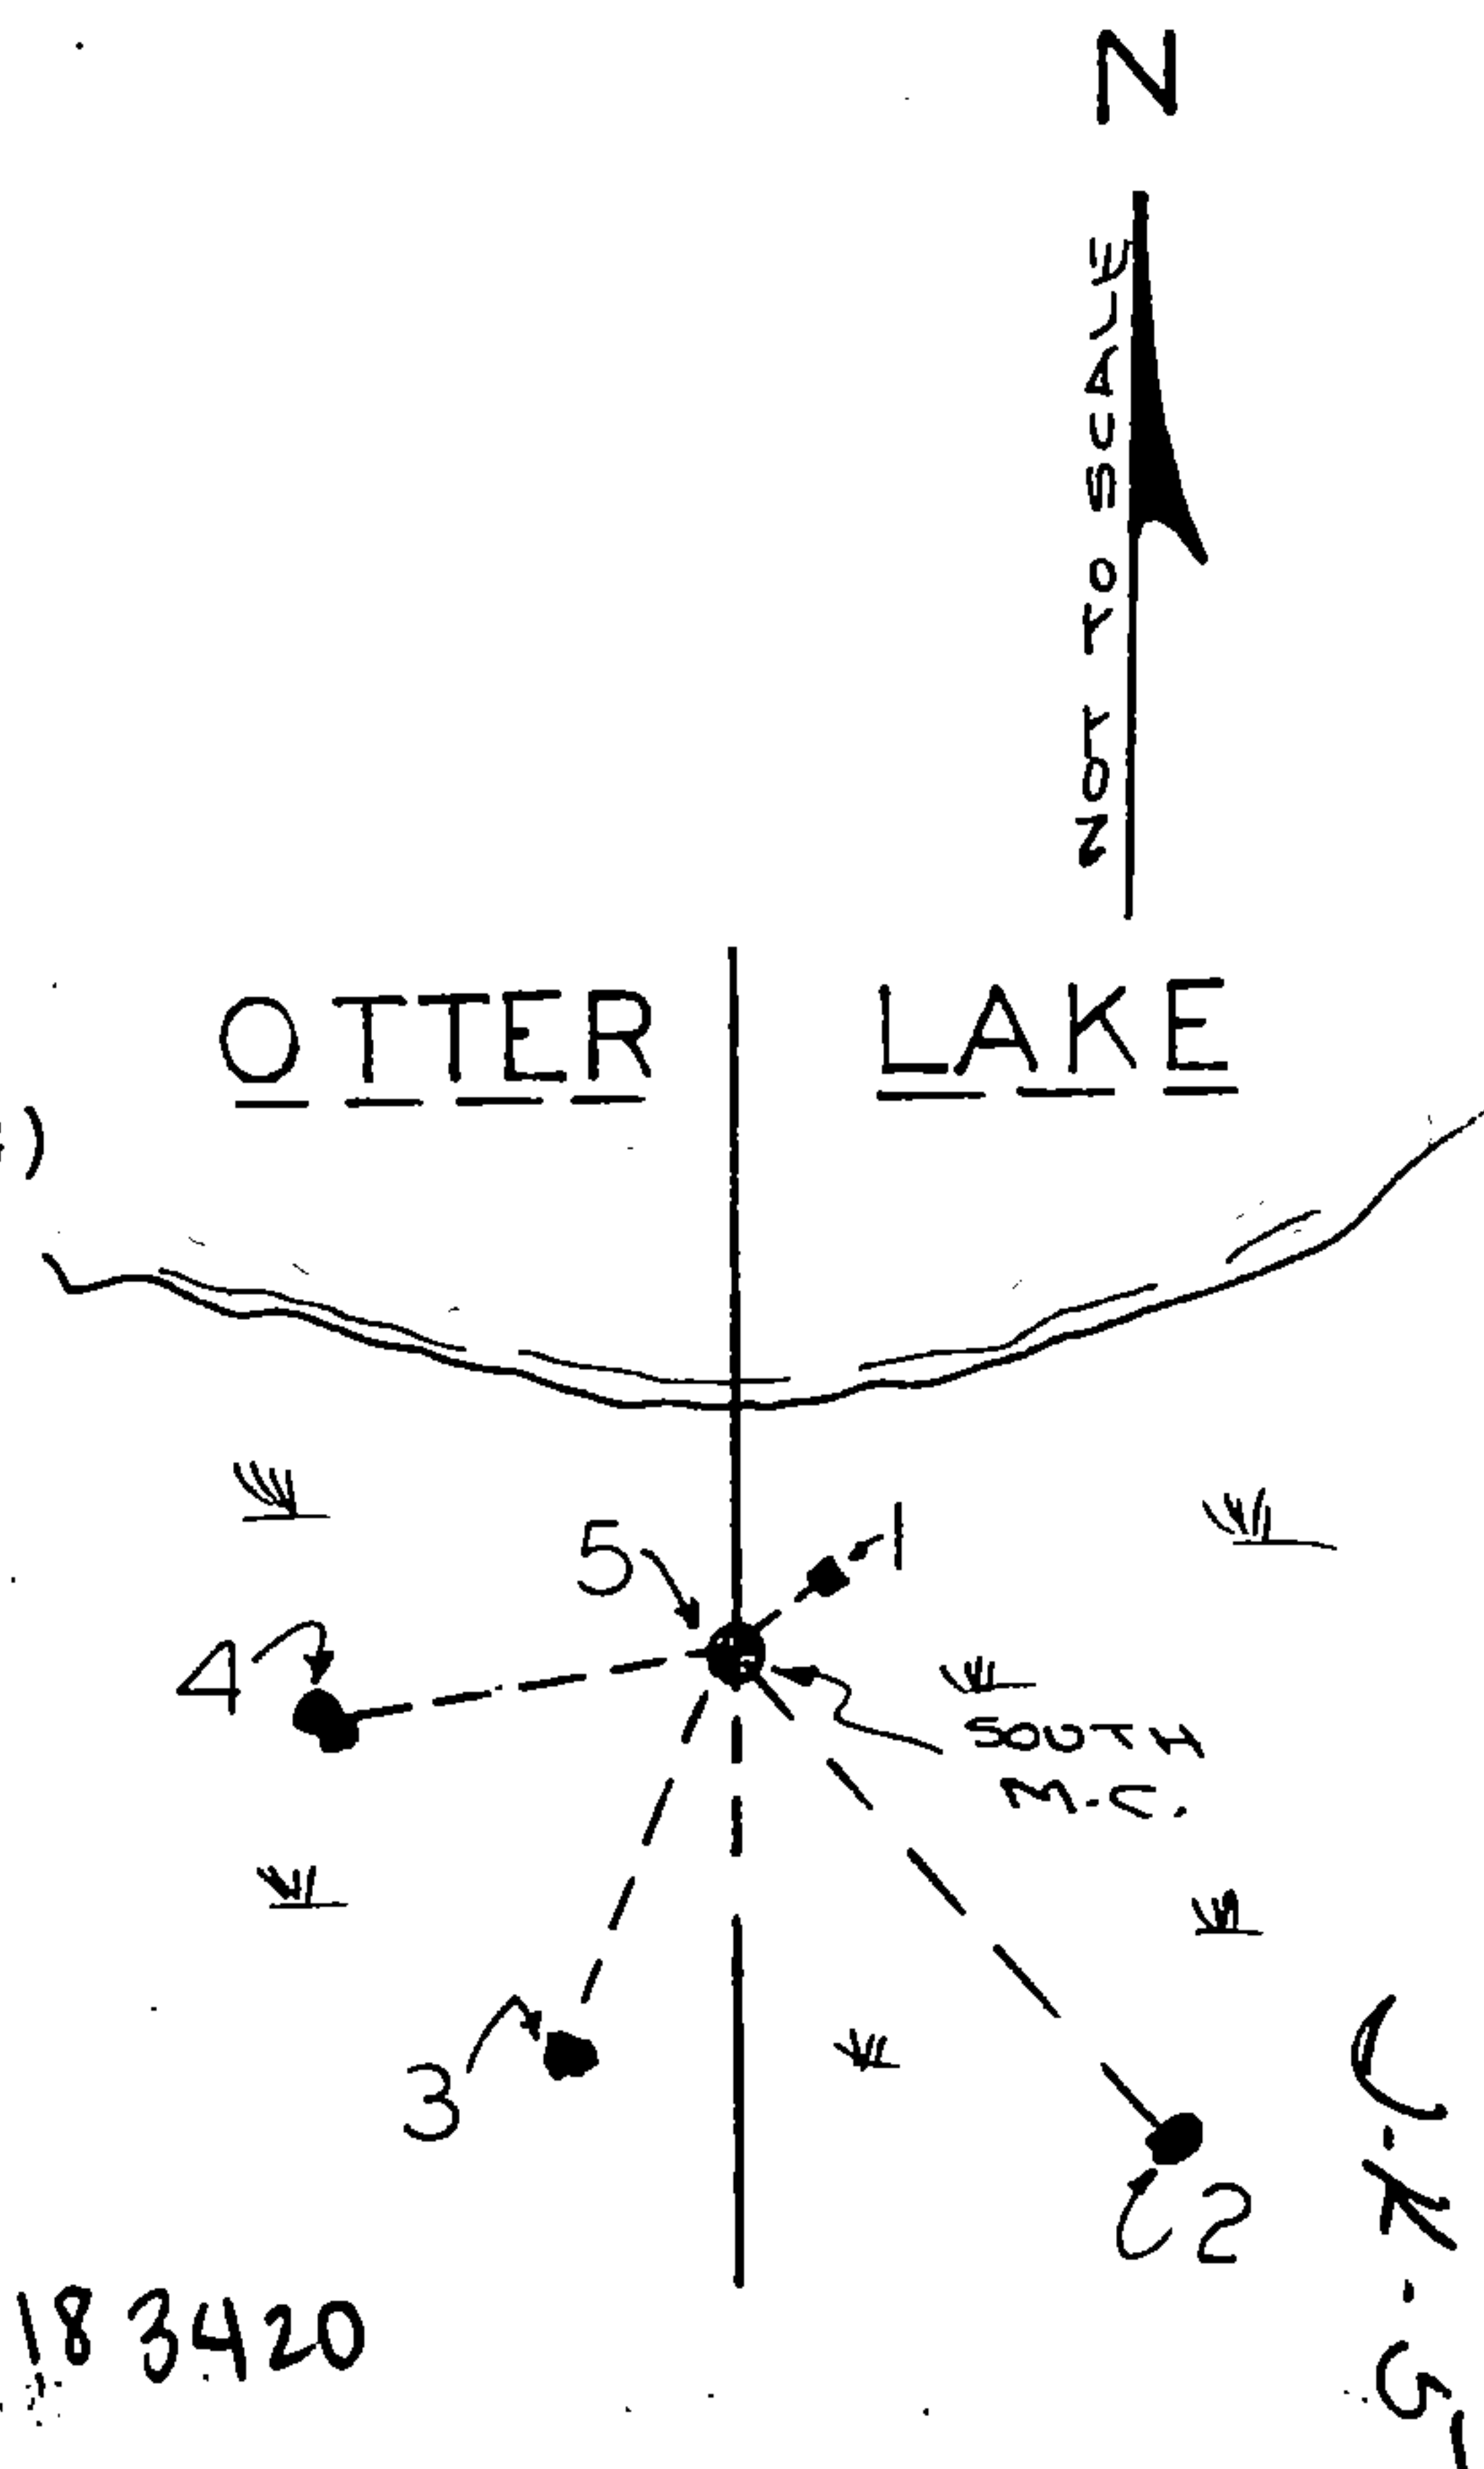


(a) Describe any material discrepancy between the location of the corner as restored or reestablished and the location of that corner as previously restored or reestablished by distance and direction. Show the discrepancy on the plan view drawing under (d), above. Show the distances between the corner as previously restored or reestablished and (1) the corner as restored or reestablished, and (2) to at least 2 of the witness monuments shown on the drawing in (d), above.

(f) Was the corner restored through acceptance of (1) an obliterated evidence location, or, (2) a found perpetuated location?

(2)

(g & h) Was the corner reestablished through lost corner proportionate methods? If so, show the method, including the directions and distances to other public land survey corners used as evidence or used for proportioning in determining the corner location?

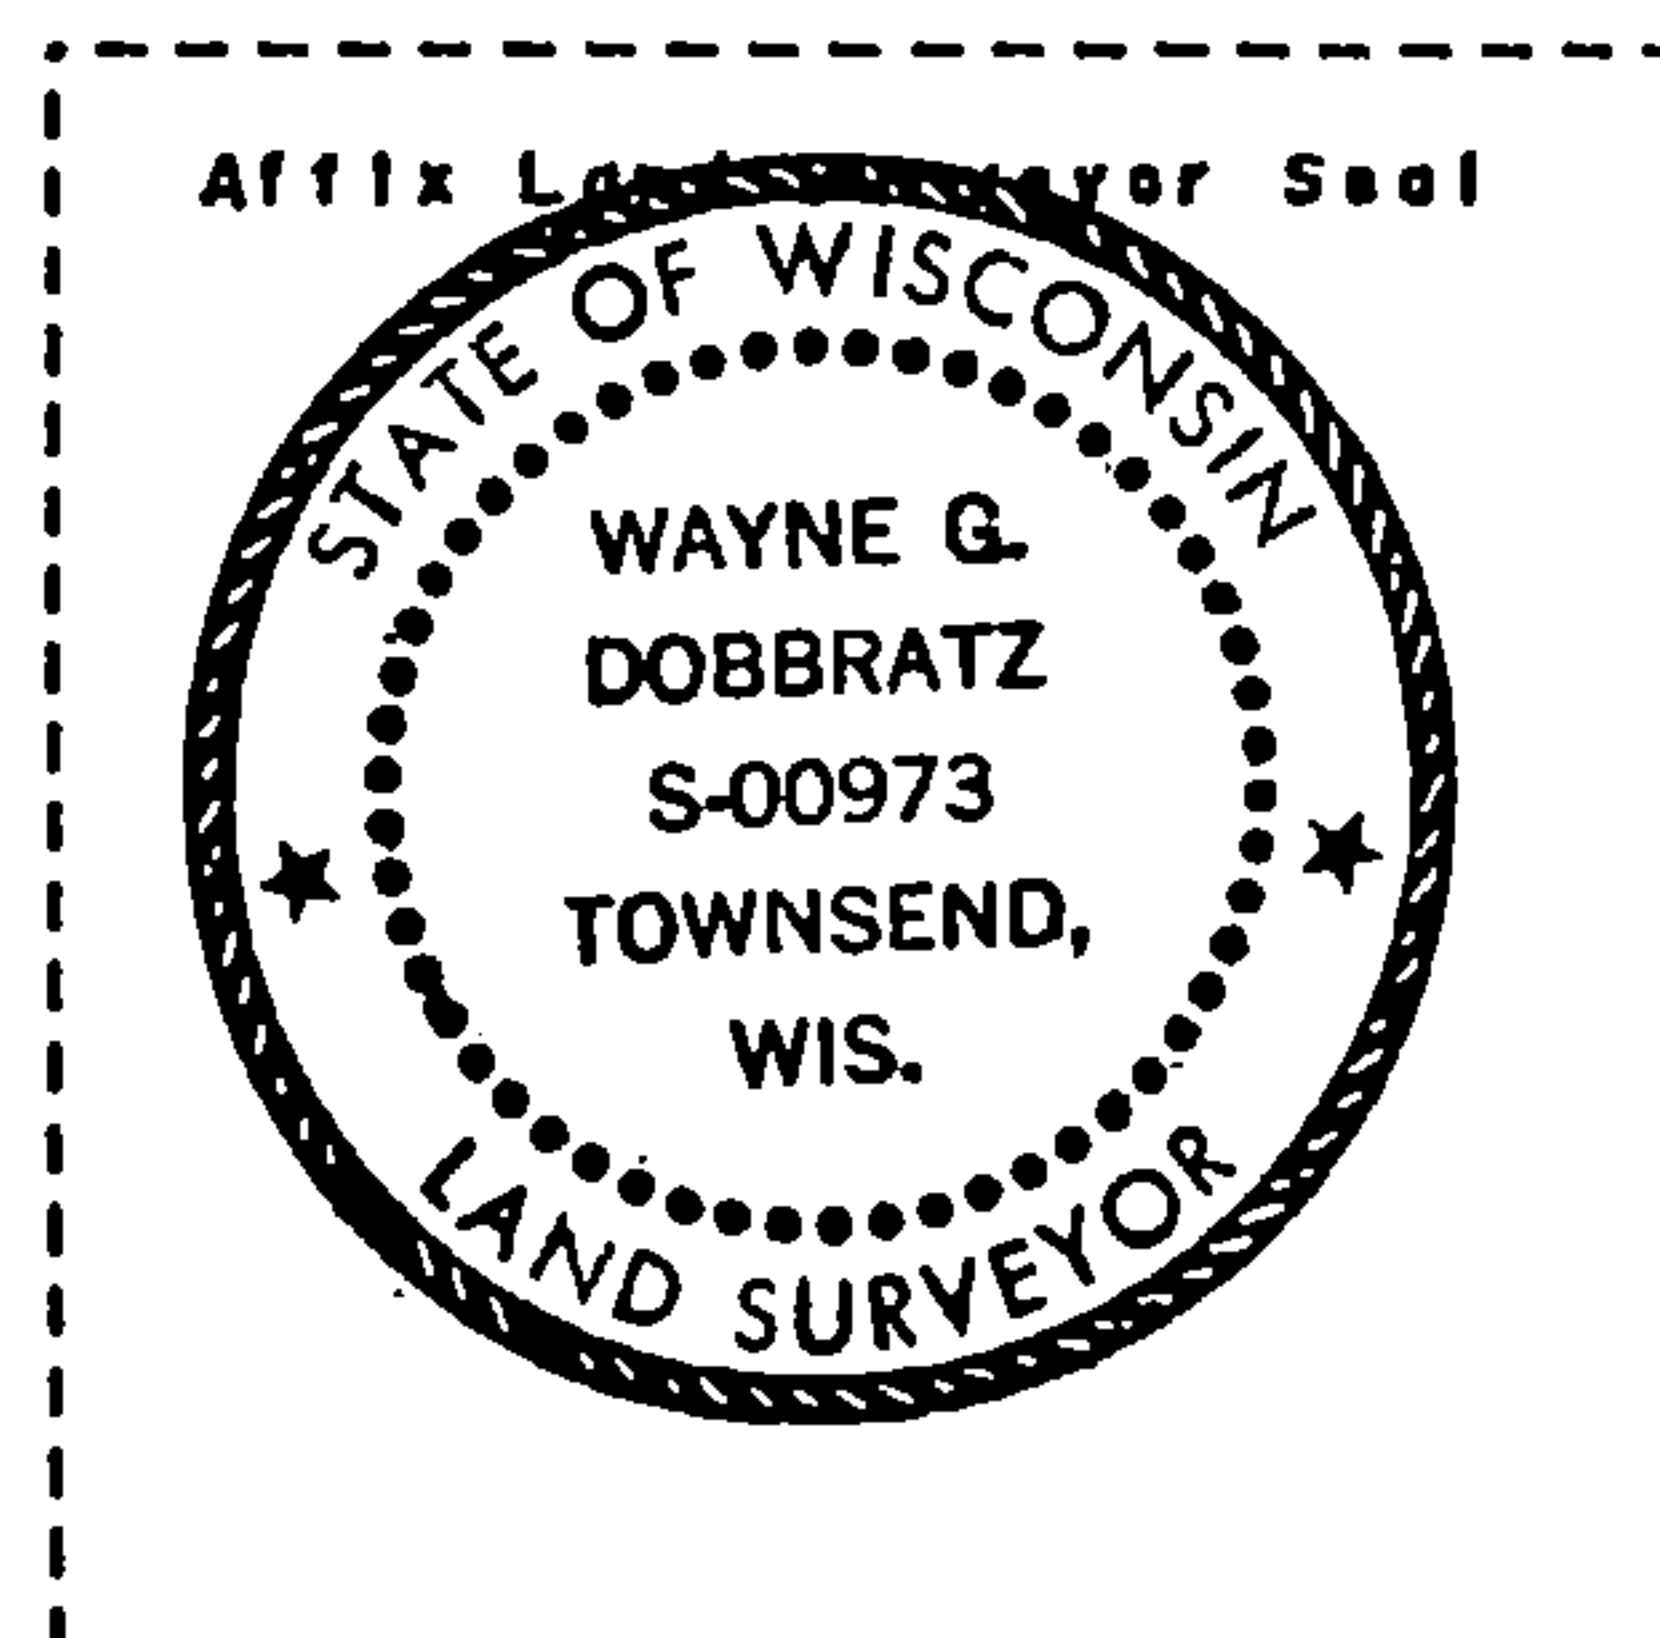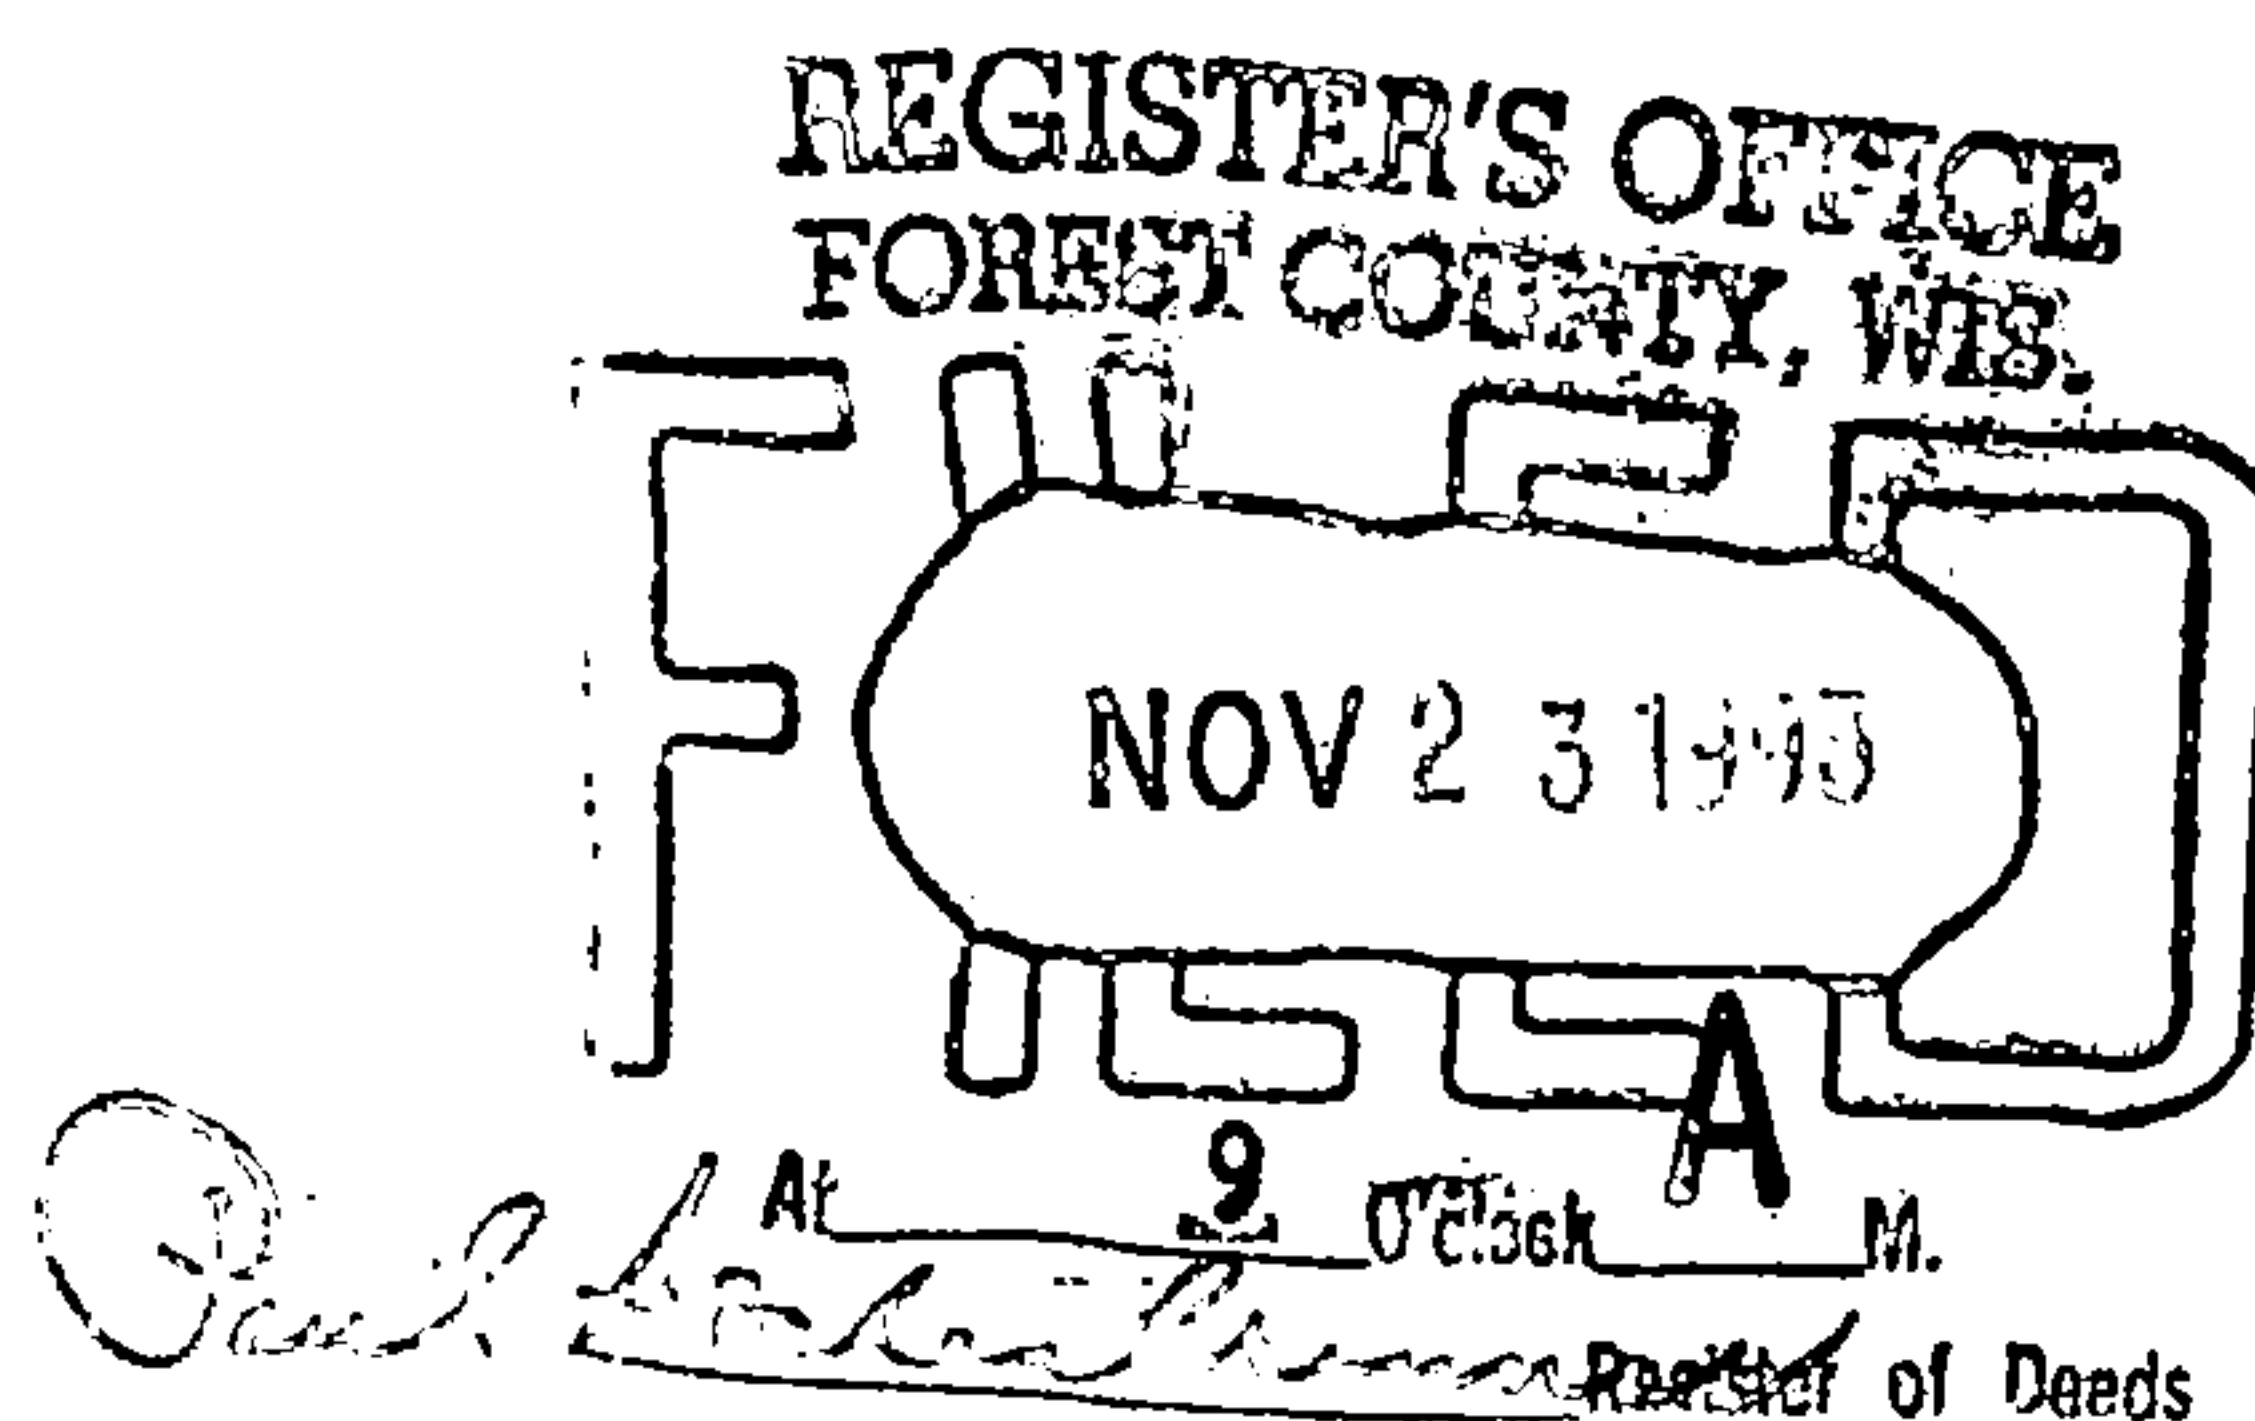

(1) I, WAYNE G. DOBBRATZ
(type or print name) certify that the corner location shown on this record was determined by me or under my direction and control and that this U.S. Public Land Survey Monument Record is correct and complete to the best of my knowledge and belief.

Signature

8/9/93

Date

CERTIFICATE READY FOR FILING:

Ralph A. Allen 11-5-93
Acting District Ranger

U. S. PUBLIC LAND SURVEY MONUMENT RECORD


INSTRUCTIONS:

This record shall show the location of the corner and shall include all of the following nine elements (a through i).

- (a) Identify the corner by reference to the U.S. public land survey system.

○ = Corner monument restored.

South meander corner to Sections 17 and 18,
T.34N., R.16E.

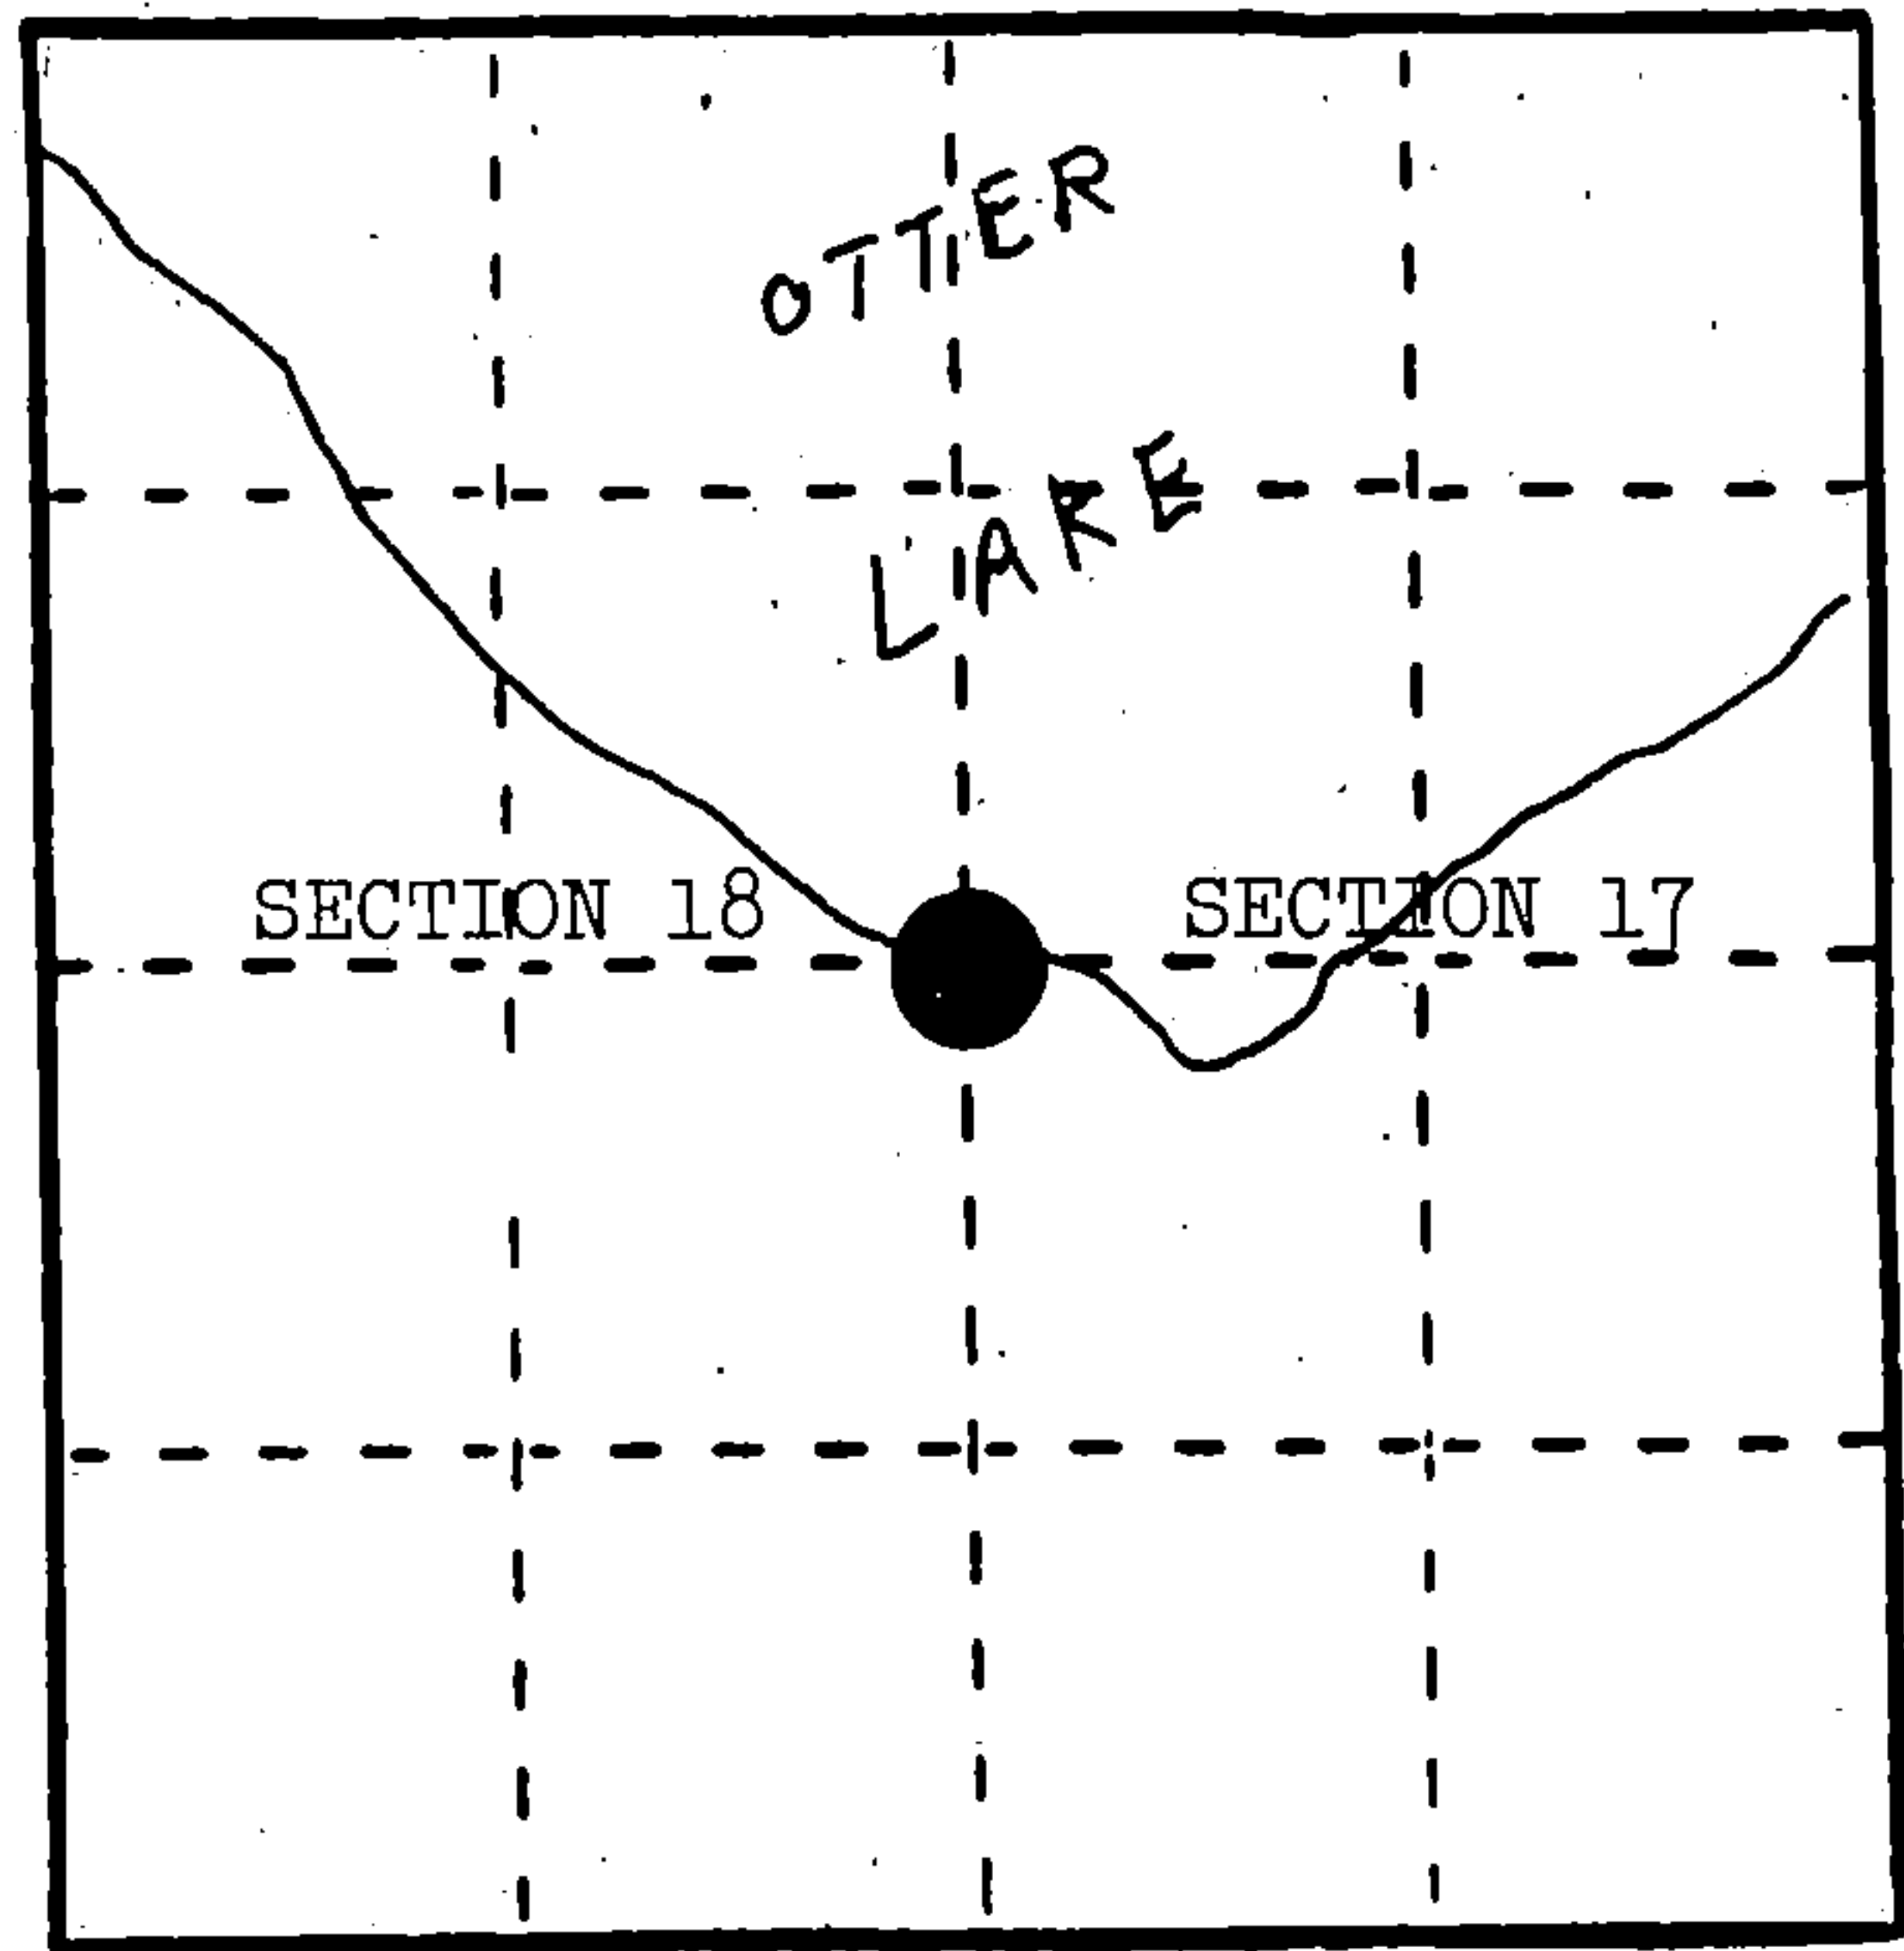

- (b) Describe any record evidence, monument evidence, occupational evidence, testimonial evidence or any other material evidence you considered, and whether the monument was found or placed.

In 1858, James McBride set meander post at 65.20 chains with the following BTs: Tamarack, 6", S.9°W., 63 links; Tamarack, 6", S.22°E., 63 links.

In 1983, Paul Smith, R.L.S., said iron pipe was at M.C. and original Tamarack still there. He used this for subdivision in Section 17.


December 30, 1983, Milo Stefan and Alan Harrison found iron pipe, but no stump remains-- tied pipe to survey.

July 23, 1984, Alan Harrison found no evidence of original corner. Distance to north M.C. is very close to original distance. Accepted this as best corner location evidence.

- (c) In the plan view drawing below, provide reference ties to at least 4 witness monuments, or, if the location is within a municipality, to at least 2 witness monuments. (Witness monuments shall be made of concrete, natural stone, iron or other equally durable material.) Describe witness monuments.

- (d) Show a plan view drawing depicting the relevant monuments and reference ties which is sufficient in detail to enable accurate relocation of the corner monument if the corner monument is disturbed. Indicate north.

- 2" x 60" aluminum monument stamped to identify the corner.
- Cedar, 6", S.43°E., 48.38'
- Cedar, 6", S.21°W., 31.40'
- Cedar, 10", N.64°W., 39.65'
- Steel Sign Post, Northeast, 1.28'

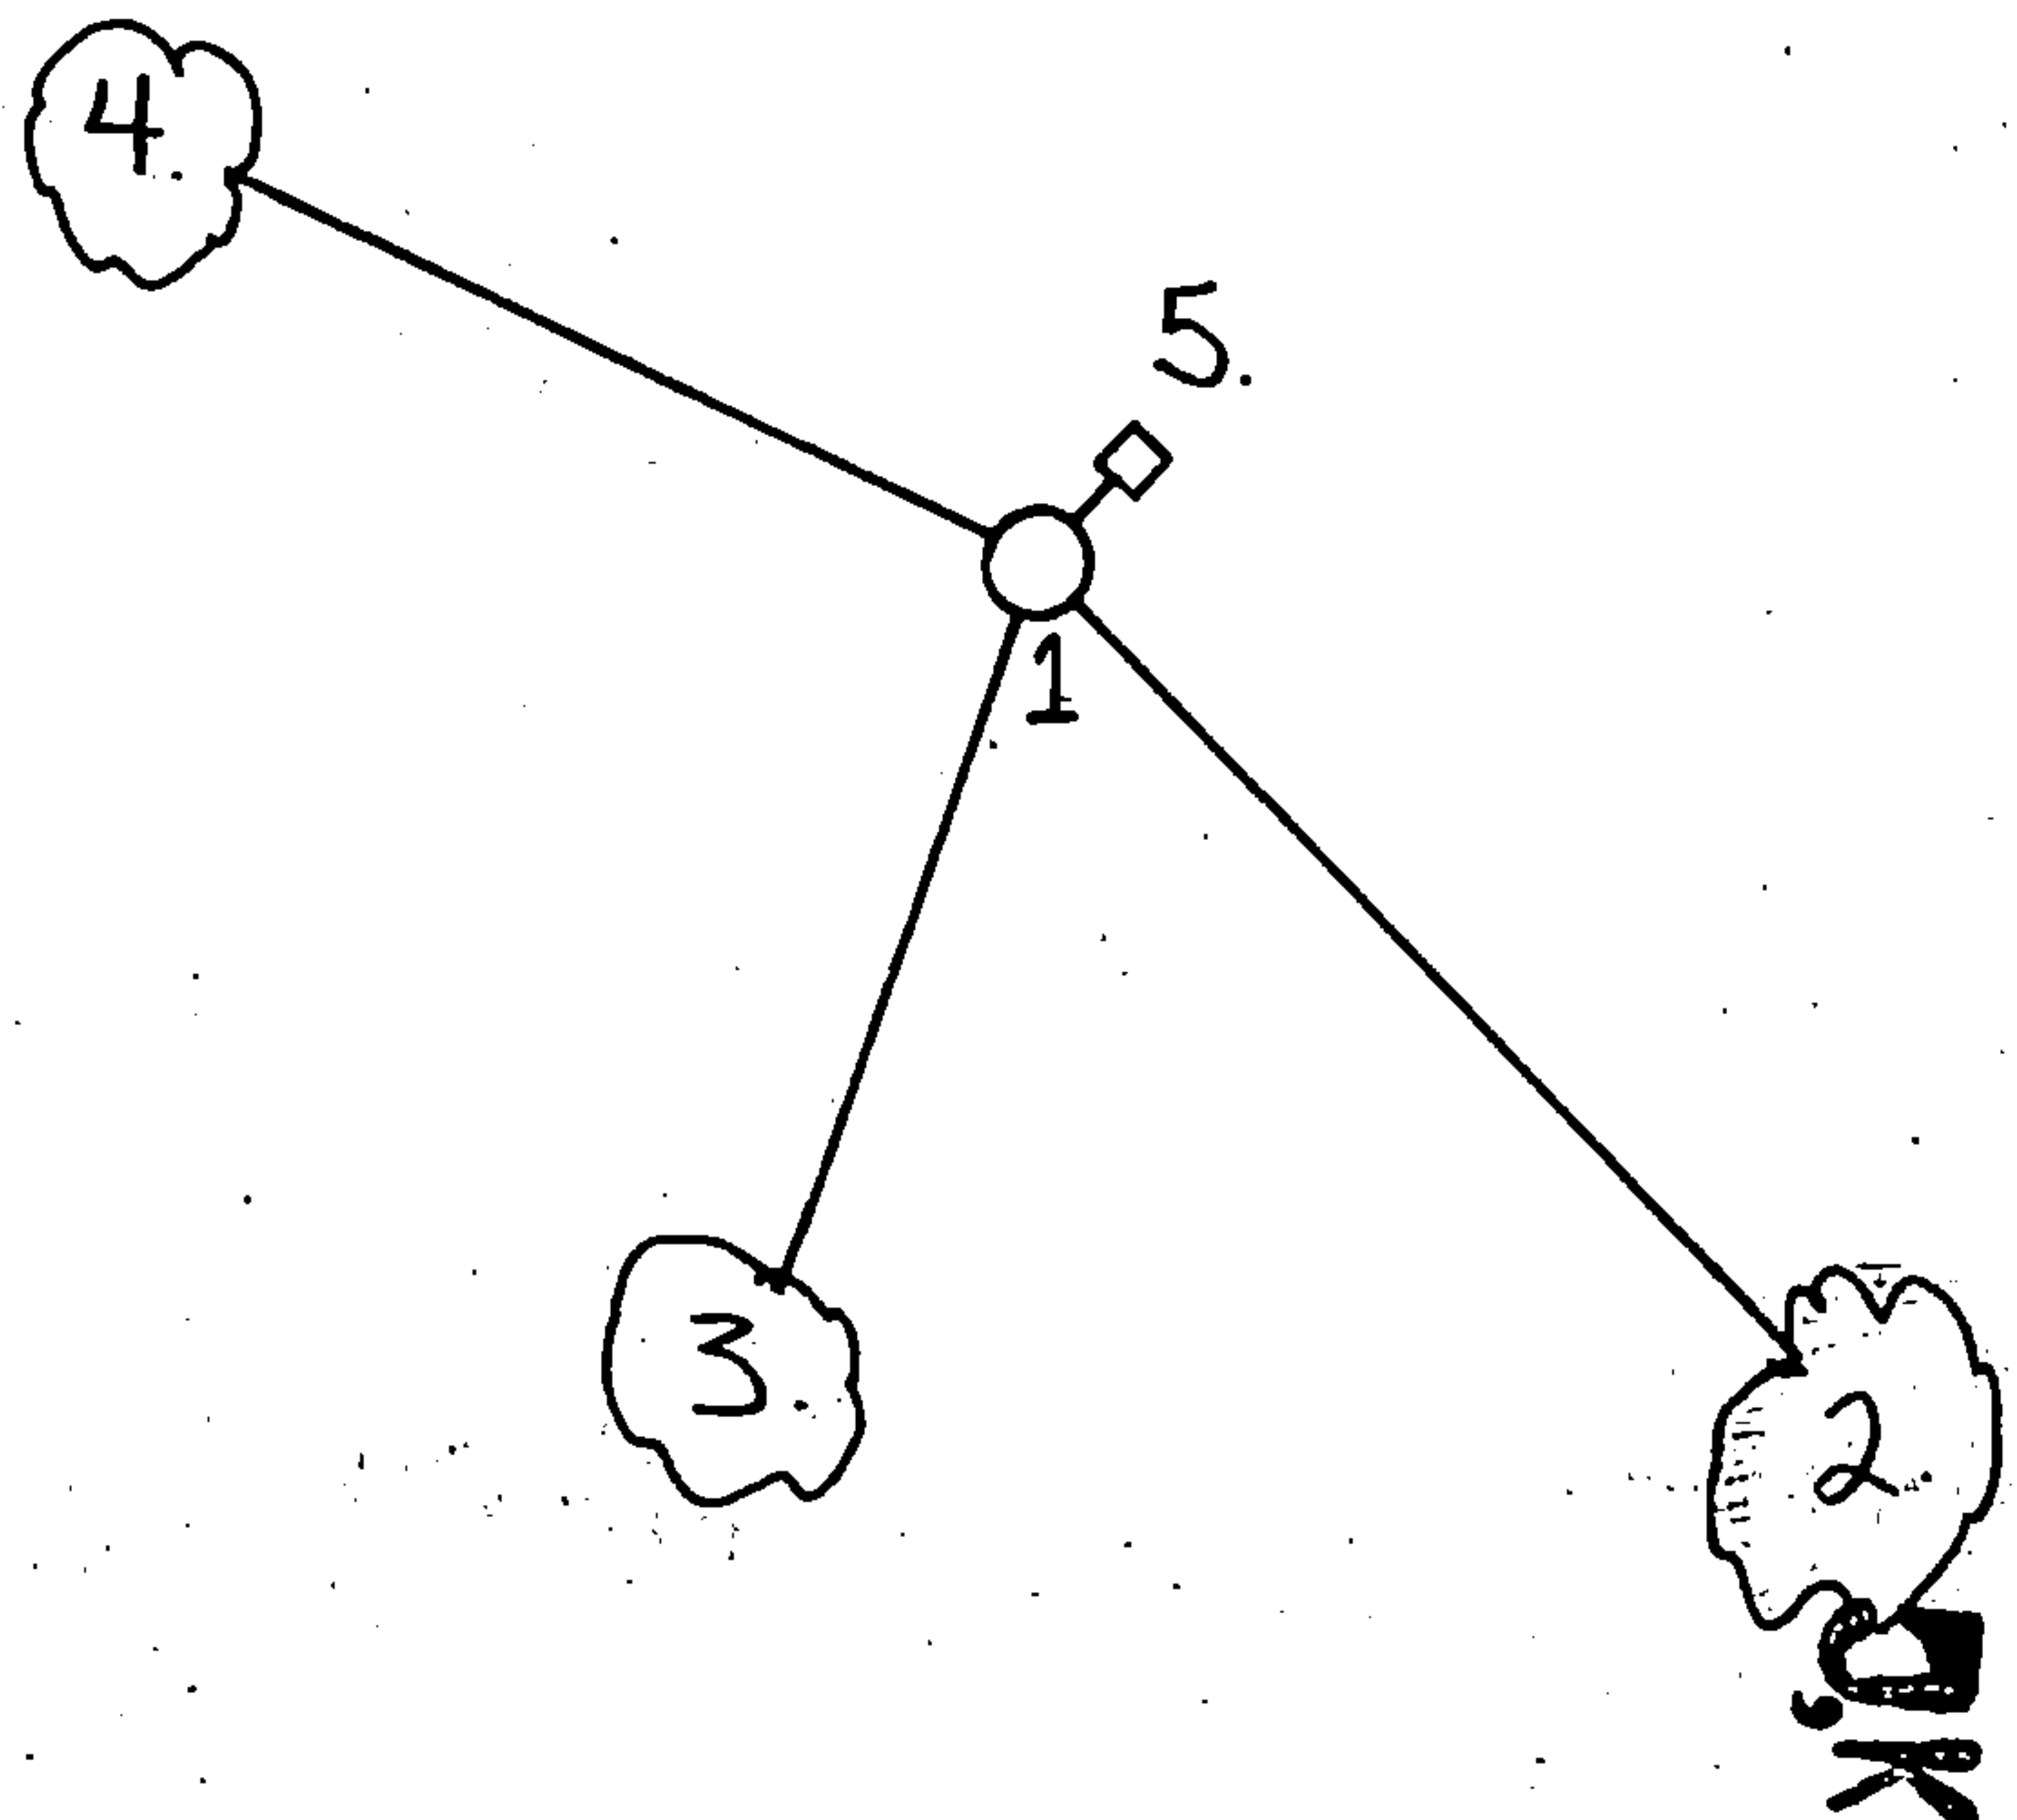

REGISTER'S OFFICE }
Forest County, Wis. }

Received for record this... day
of... A.D., 19... at
... o'clock... M. and

recorded in Vol. **CORNER RESTORATION**
on page **J, K-5**

Paul A. Schenck
REGISTER

- (e) Describe any material discrepancy between the location of the corner as restored or reestablished and the location of that corner as previously restored or reestablished by distance and direction. Show the discrepancy on the plan view drawing under (d), above. Show the distances between the corner as previously restored or reestablished and (1) the corner as restored or reestablished, and (2) to at least 2 of the witness monuments shown on the drawing in (d), above.

None.

- (f) Was the corner restored through acceptance of (1) an obliterated evidence location, or, (2) a found perpetuated location?

(2) a found perpetuated location.

- (g) Was the corner reestablished through lost corner proportionate methods? If so, show the method, including the directions and distances to other public land survey corners used as evidence or used for proportioning in determining the corner location?

No.

(1) Alan D. Harrison

(Type or print name) certify that the corner location shown on this record was determined by me or under my direction and control and that this U.S. Public Land Survey Monument Record is correct and complete to the best of my knowledge and belief.

Alan D. Harrison
Signature

12/13/84
Date

