


**U. S. PUBLIC LAND SURVEY MONUMENT RECORD**

**INSTRUCTIONS:** This record shall show the location of the corner and shall include all of the following nine elements (a through i).

(a) Identify the corner by reference to the U.S. public land survey system.

○ = Corner monument restored.

Section corner to Sections 22, 23, 26, and 27, T.34N., R.16E.

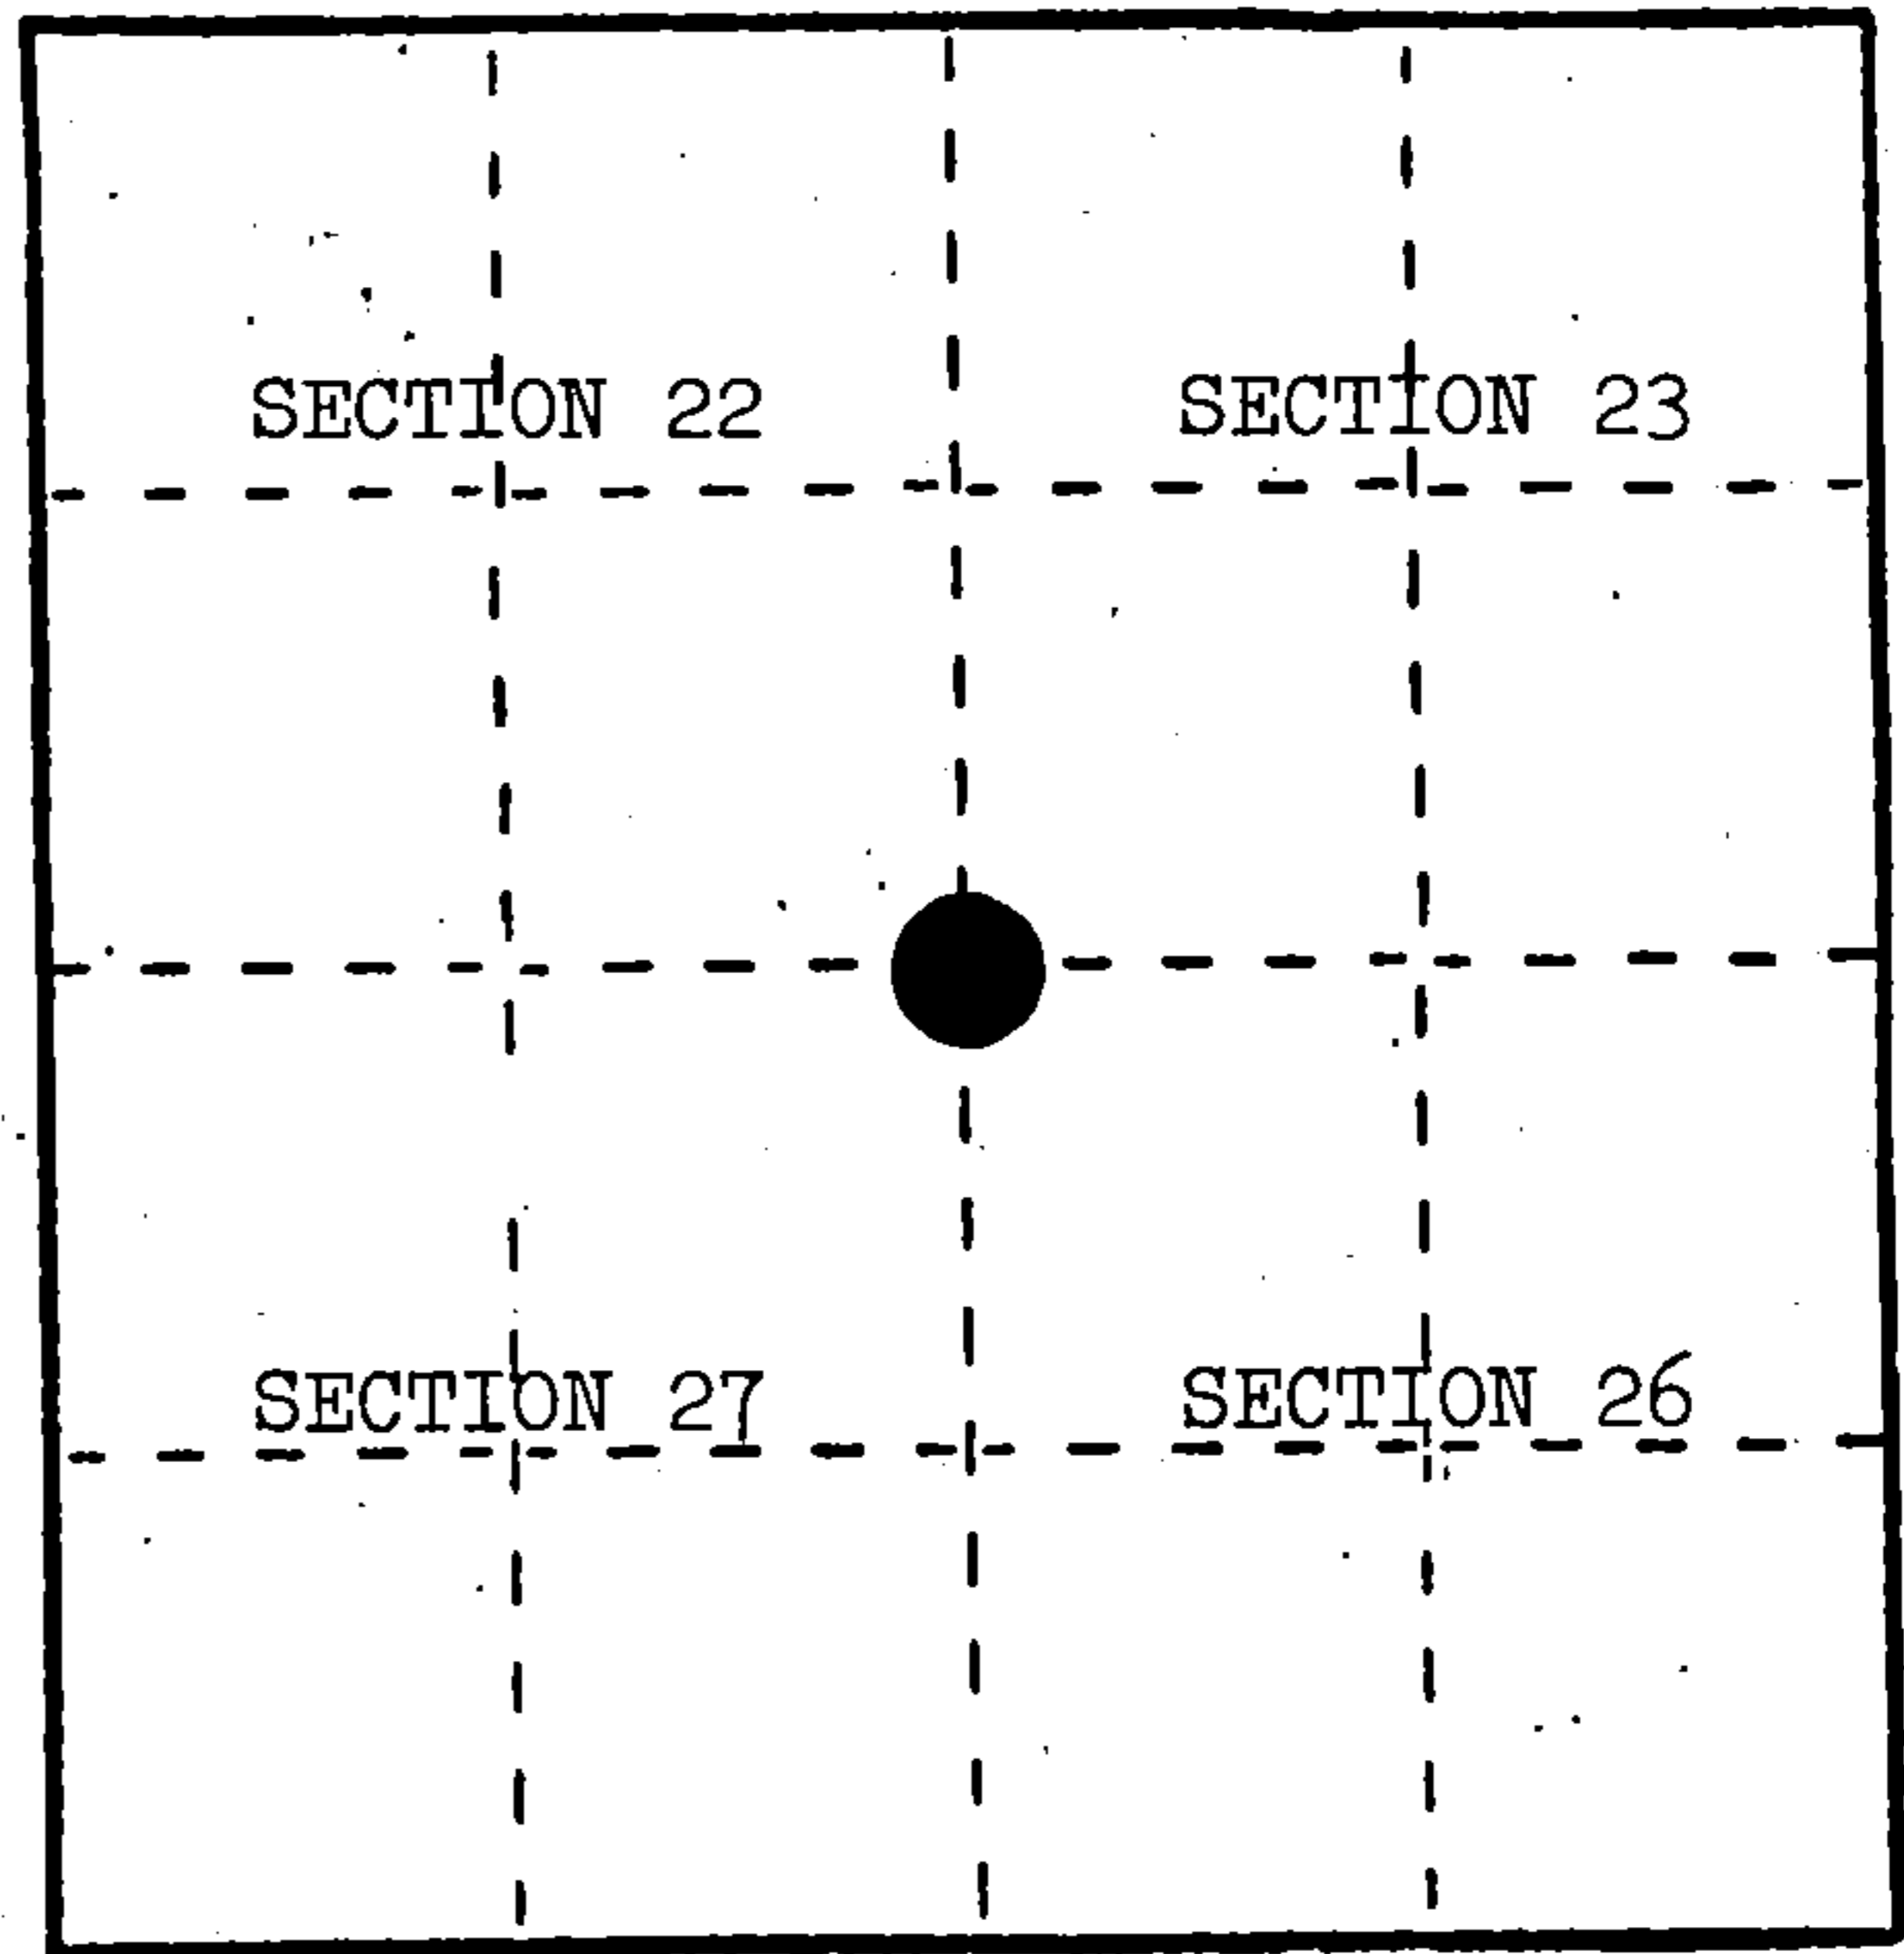

(b) Describe any record evidence, monument evidence, occupational evidence, testimonial evidence or any other material evidence you considered, and whether the monument was found or placed.


In 1858, James McBride set wood post with the following BTs: Hemlock, 8", N.63°W., 33 links; Lind, 10", N.35°E., 61 links; Lind, 12", S.8°E., 50 links; Sugar, 8", S.74°W., 15 links; 7.00 chains north enter Cedar swamp.

November 15, 1983, Alan Harrison set proportionate position--searched and found plantation post. Found Hemlock stump remains and pulled from same S.63°E., 21.78'. No post or point, falls in skid road. At N.35°E., 40.3', shallow stump hole; S.8°E., 33.0', west edge of shallow stump hole; S.74°W., 9.90', falls in old skid road. Swamp edge north pulled 455', hit Cedar swamp edge.

(c) In the plan view drawing below, provide reference ties to at least 4 witness monuments, or, if the location is within a municipality, to at least 2 witness monuments. (Witness monuments shall be made of concrete, natural stone, iron or other equally durable material.) Describe witness monuments.

(d) Show a plan view drawing depicting the relevant monuments and reference ties which is sufficient in detail to enable accurate relocation of the corner monument if the corner monument is disturbed. Indicate north.

1. 2" x 36" aluminum monument stamped to identify the corner.
2. Sugar, 4", N.23°E., 50.12'
3. Sugar, 5", S.45°E., 23.11'
4. Sugar, 7", S.29°W., 68.76'
5. Sugar, 8", N.69°W., 32.42'
6. Steel Sign Post, Southwest, 1.6'

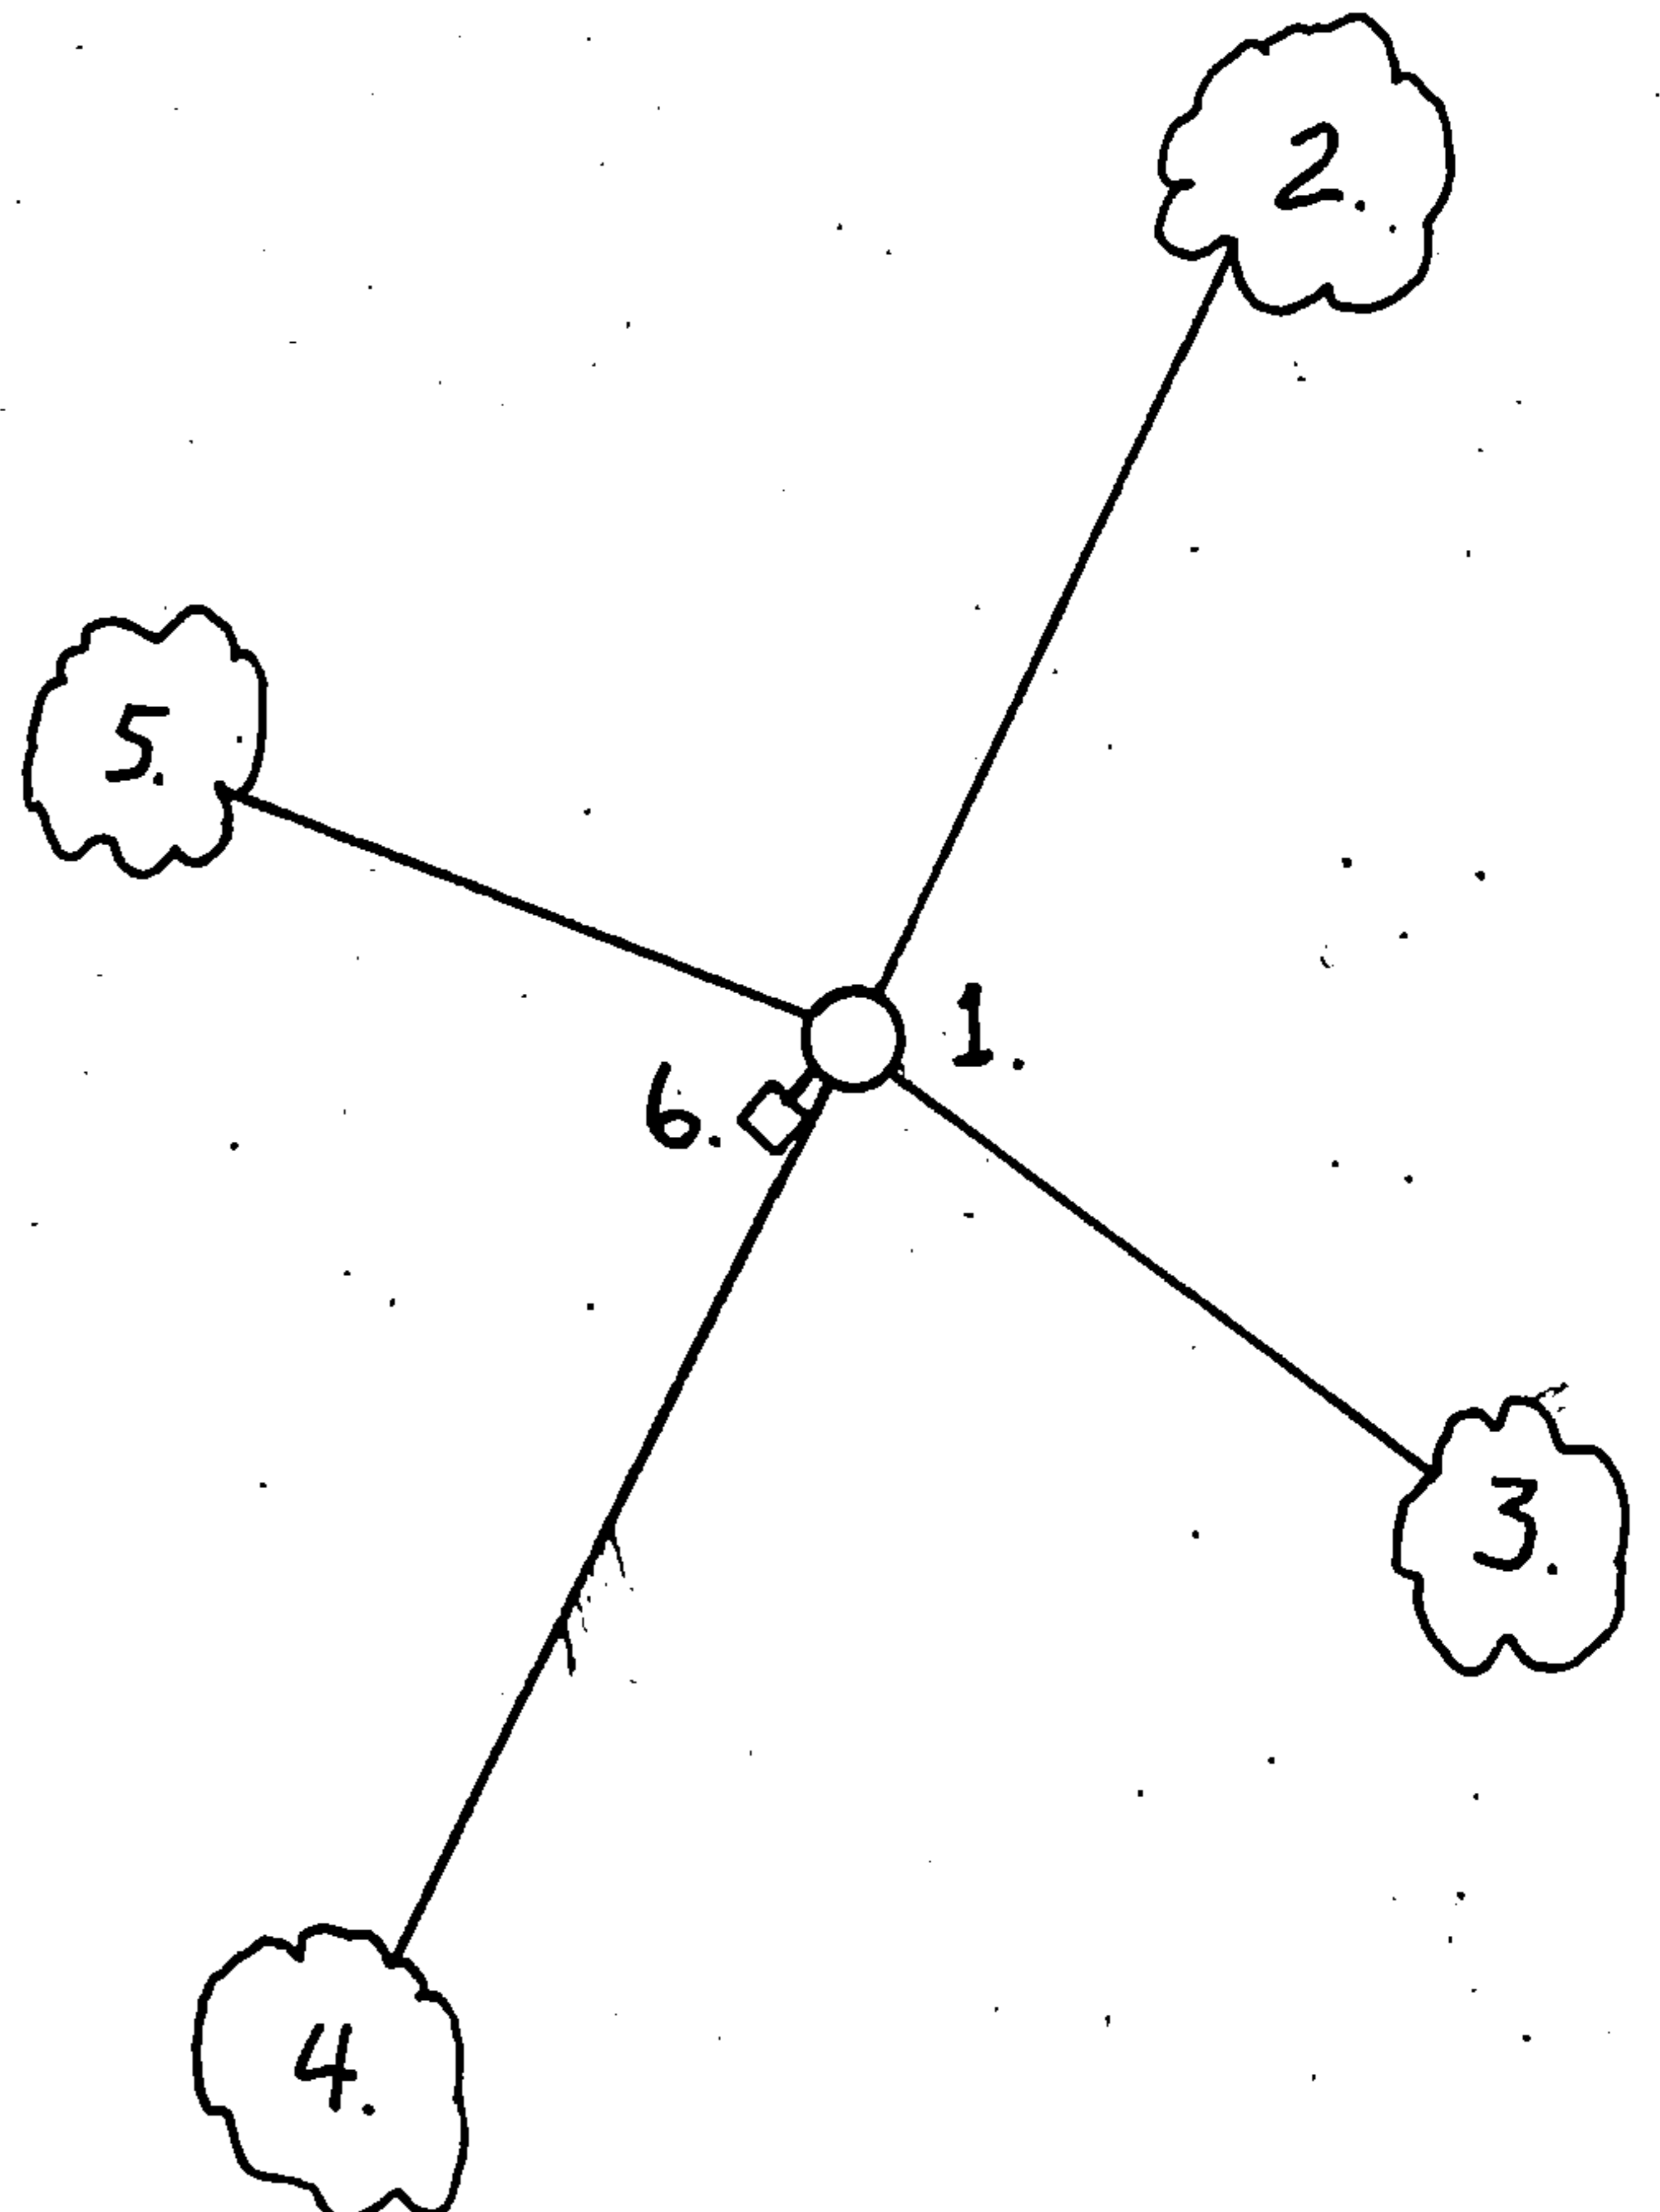

REGISTER'S OFFICE }  
 Forest County, Wis. }  
 Received for record this... 25th day  
 of... January... A. D., 1985 at  
 ... 8:30 o'clock... A... M. and  
 recorded in Vol. **CORNER RESTORATIONS**  
 on page **R-17**  
*Paul A. Schindler*  
 REGISTER

(e) Describe any material discrepancy between the location of the corner as restored or reestablished and the location of that corner as previously restored or reestablished by distance and direction. Show the discrepancy on the plan view drawing under (d), above. Show the distances between the corner as previously restored or reestablished and (1) the corner as restored or reestablished, and (2) to at least 2 of the witness monuments shown on the drawing in (d), above.

None.


(f) Was the corner restored through acceptance of (1) an obliterated evidence location, or, (2) a found perpetuated location?

(1) an obliterated evidence location.

(g&h) Was the corner reestablished through lost corner proportionate methods? If so, show the method, including the directions and distances to other public land survey corners used as evidence or used for proportioning in determining the corner location?

No.

Affix Land Surveyor Seal

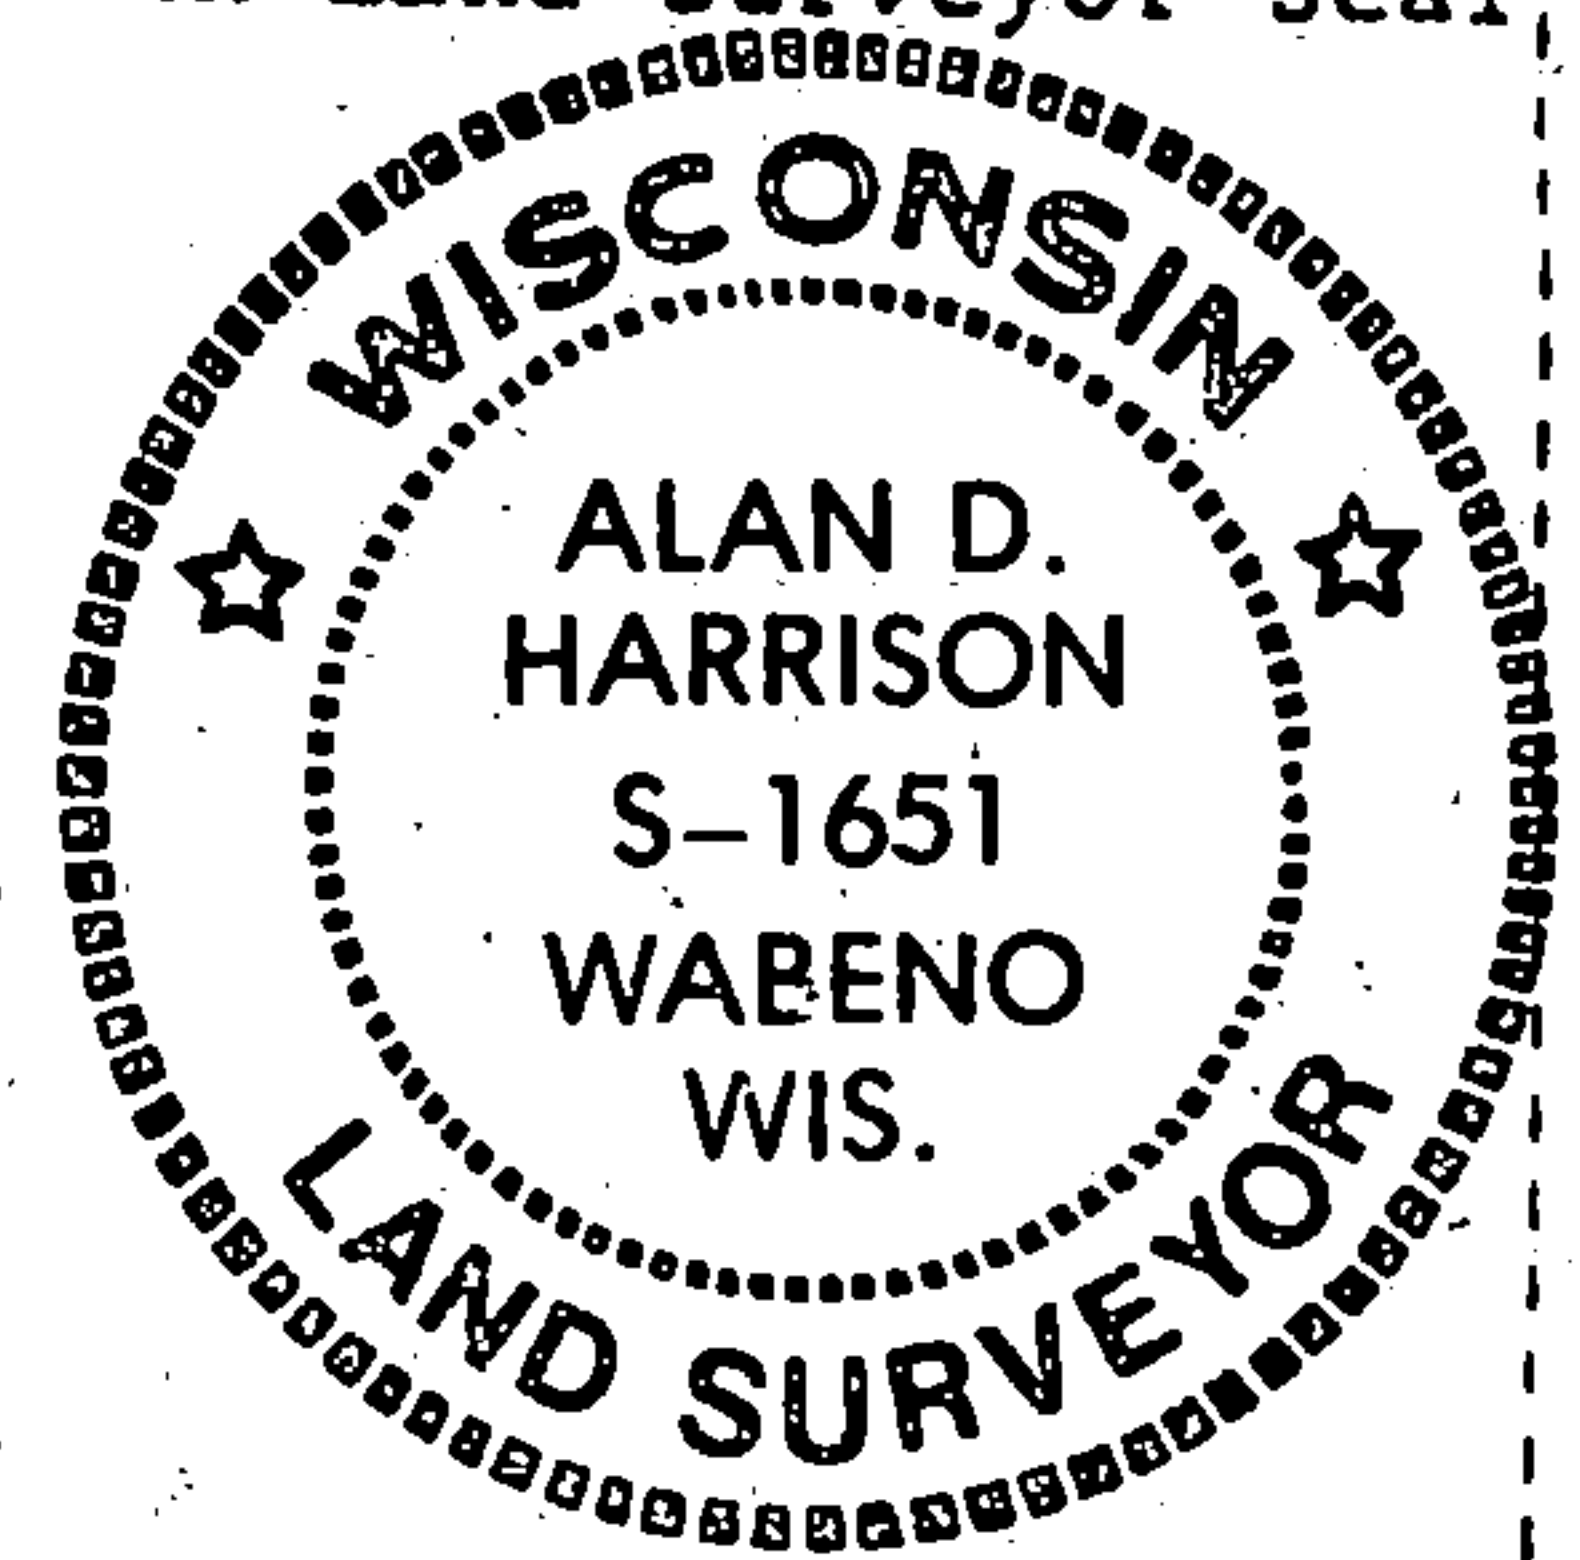

(i) I, Alan D. Harrison

(type or print name) certify that the corner location shown on this record was determined by me or under my direction and control and that this U.S. Public Land Survey Monument Record is correct and complete to the best of my knowledge and belief.

Alan D. Harrison  
Signature

12/4/84  
Date